

FED. ROAD DIST. NO.	STATE	PROJ. NO.	FISCAL YEAR	SHEET NO.	TOTAL SHEETS
HAWAII	HAW.	130B-02-94	1994	12	12

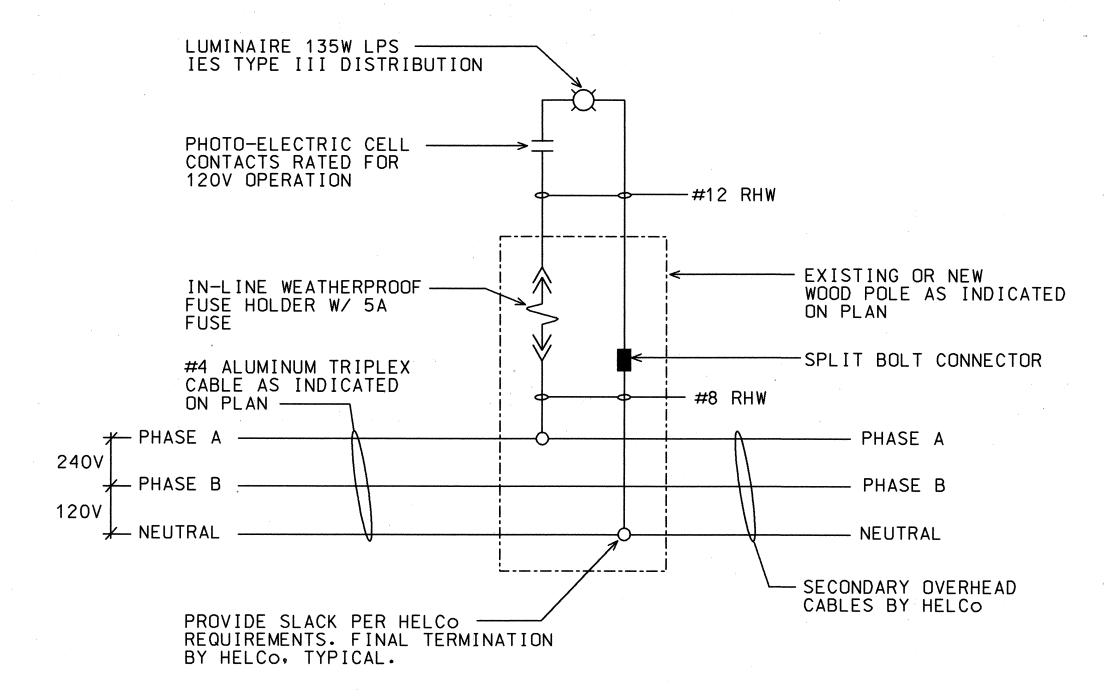

A TYPICAL STREET LIGHT WIRING DIAGRAM
E11 NO SCALE

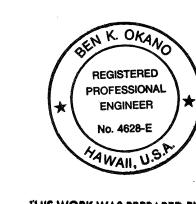

THIS WORK WAS PREPARED BY ME OR UNDER MY SUPERVISION.

MK ENGINEERS, LTD.

6/16/94	DELETED WIRING DIAGRAM	1
DATE	DESCRIPTION	e * · · ·

STATE OF HAWAII
DEPARTMENT OF TRANSPORTATION
HIGHWAYS DIVISION

STREET LIGHT DETAILS

KEAAU-PAHOA ROAD HIGHWAY LIGHTING,
BETWEEN HAWAII BELT ROAD AND PAHOA TOWN
PROJECT NO. 1308-02-94

SCALE: AS NOTED

DATE: JUNE 1994

SHEET No. E11 OF 11 SHEETS