
FED. ROAD DIST. NO.	STATE	PROJ. NO.	FISCAL YEAR	SHEET NO.	TOTAL SHEETS
HAWAII	HAW.	130B-01-92	1997	62	115

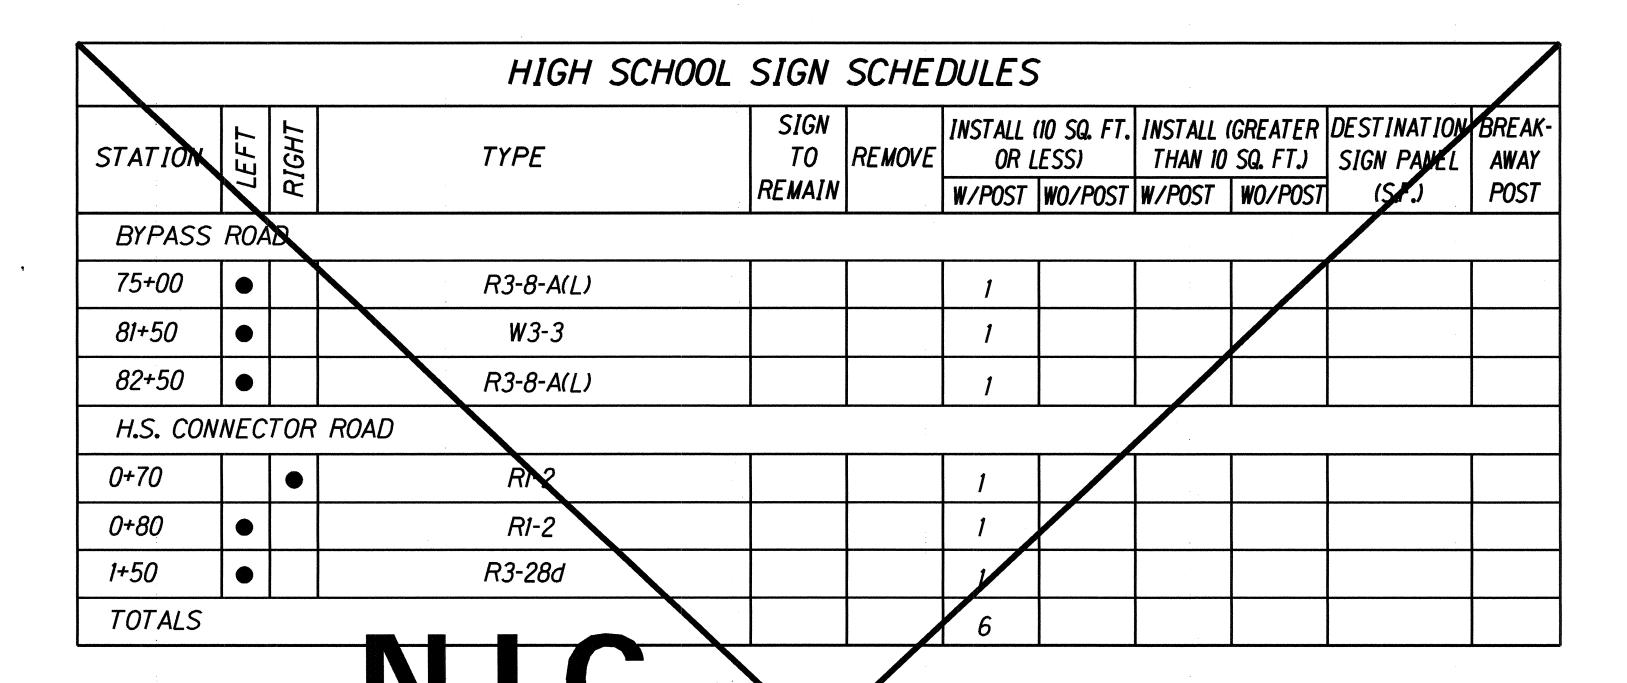

STATION*		LEFT RIGHT		RM-2BI	BI RM-2		RM-3 **		RM-	3BI	RM-4		
FROM	OM TO		RIGHT	FLEX POST	STEEL POST	STEEL STEEL POST PA		FLEX NO POST POST		STEEL FLEX POST POST		REMARKS	
BYPAS.	S ROAD										POST		
73+20		•						1			i.	Below M1-6(130)	
75+00		•					·	1	·	·		Below R3-8-A(L)	
76+50		•			,			1				Below M1-6(130)	
81+50	Managaman matasananan	•						1				Below W3-3	
82+50		9						1				Below R3-8-A(L)	
H.S. CC	DNNECTO	RO.	AD	٠									
0+70			•			١.		1				Below R1-2	
0+80		•		·				1				Below R1-2	
1+50		•		·	,	**		1				Below R3-28d	
TOTALS	3							8					

HIGH SCHOOL CENTERLINE AND REFERENCE SURVEY MONUMENT SCHEDULE								
PROJECT	STATION	MON. TYPE	# Reference Mon.	Adjust Centerline  Reference Mon. Item No. 613.0120		L or R	EXISTING DEPTH (FT.)	
H.S. CONNECTOR ROAD	0+00 P.O.B.	MON.	1	•.	0.0		_	
	TOTALS		1		·			

HIGH SCHOOL ROUTE MARKER SCHEDULE									
PROJECT	STATION	LEFT	ROUTE MARKER SIGN NO. (ROUTE NO.)	REMAIN	REMOVA	INSTALL TYPE A ASSEMBLY	INSTALL TYPE B ASSEMBLY		
BYPASS	73+20	سو	M1-6 (130)			1			
ROAD	76-50	•	M1-6 (130)			1			
	TOTALS					2			

## NOTES:

- 1. Reflector markers located behind guardrail shall be installed with steelposts. At all other locations reflector markers shall be installed with flexible delineator posts.
- 2. Remove all existing reflector markers, object markers, and posts unless otherwise directed by the Engineer.
- 3. Removal of existing reflector markers, object markers, and posts shall be considered incidental to the various signing items.
- \* Stations may vary in the field Final Marker locations are to be approved by the Engineer.
- \*\* RM-3 to be installed on Sign Posts, as directed by the Engineer



Many EBurn

DATE: 8/8/97

DEPARTMENT OF TRANSPORTATION

## H.S. MISCELLANEOUS **SCHEDULES**

SHEETS

62

KEA'AU-PAHOA ROAD VICINITY OF KEA'AU TOWN (KEA'AU BYPASS ROAD) THIS WORK WAS PREPARED BY ME OR UNDER MY SUPERVISION.

PROJECT NO. 130B-01-92, PHASE 1 Scale: NA Date: May, 1997

SHEET No. 1 OF 1

ADD.

