


FED. ROAD DIST. NO.	STATE	PROJ. NO.	FISCAL YEAR	SHEET NO.	TOTAL SHEETS
HAWAII	HAW.	130B-01-92	1997	58	115

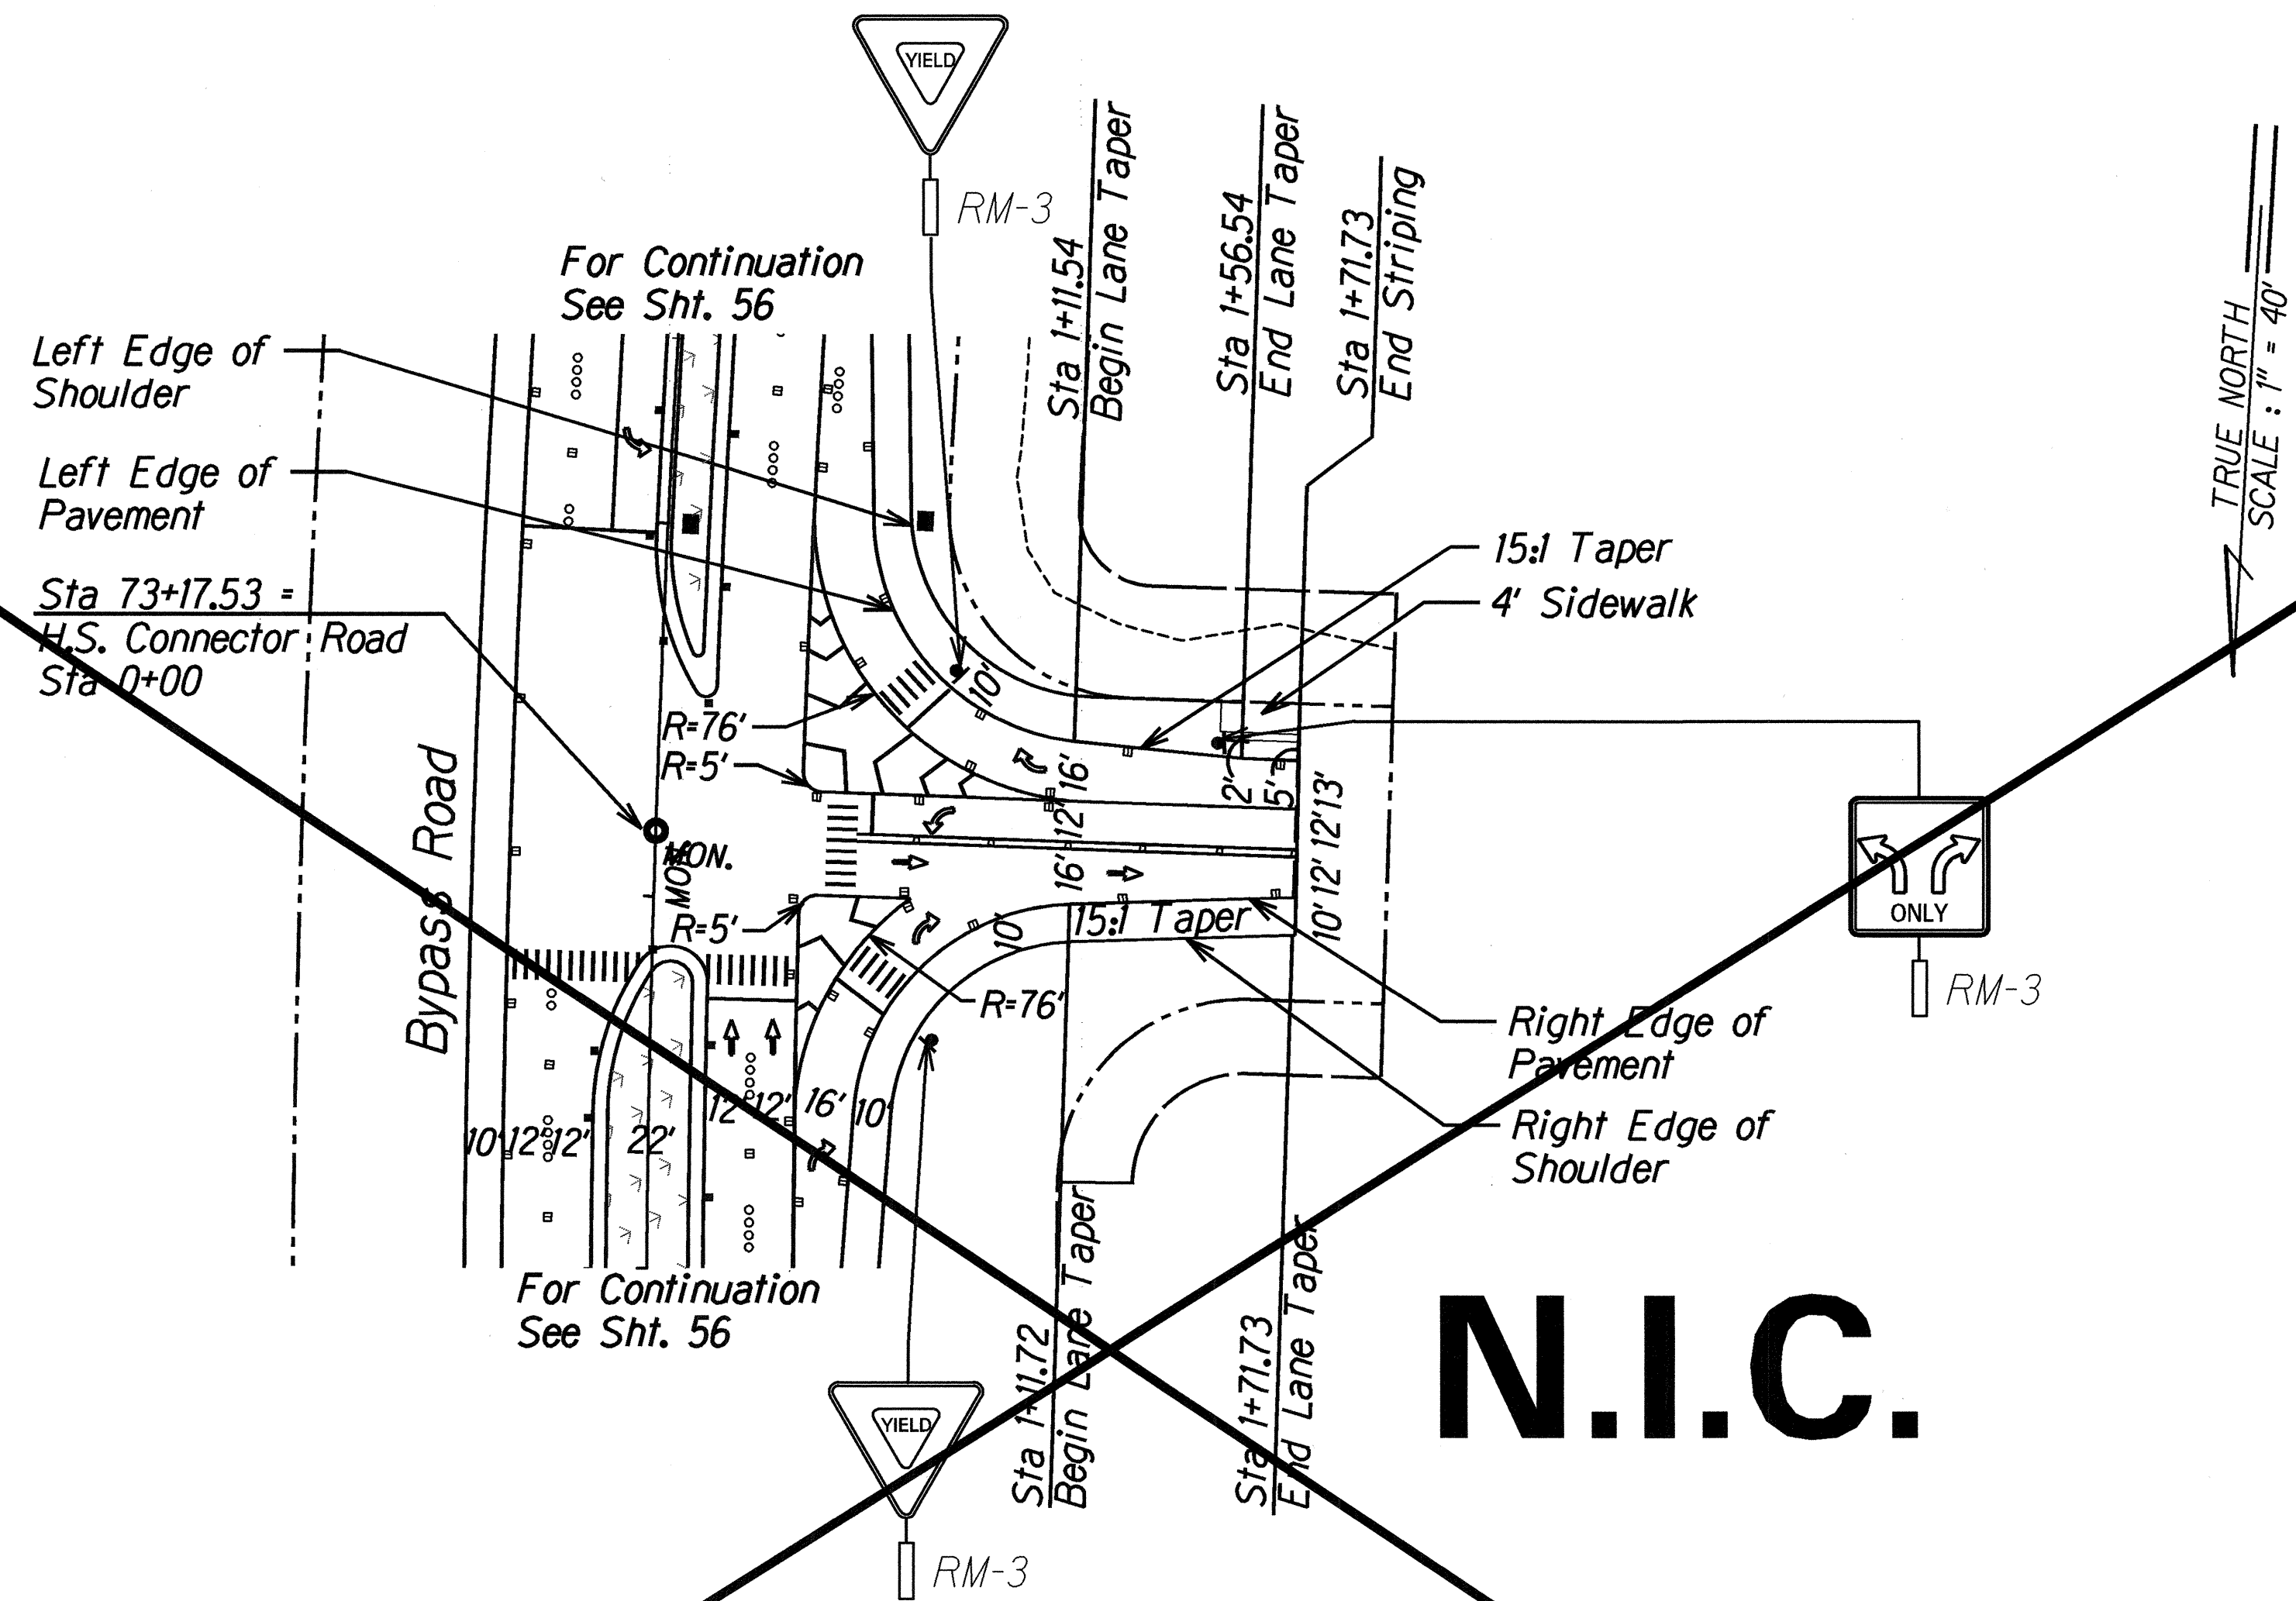

N.I.C.

HIGH SCHOOL CONNECTOR ROAD PLAN

SURVEY PLOTTED BY	DATE
DRAWN BY	
DESIGNED BY	
CHECKED BY	
NOTE BOOK	
H.S. 551469	



THIS WORK WAS PREPARED BY ME
OR UNDER MY SUPERVISION
DATE: 8/8/97

STATE OF HAWAII
DEPARTMENT OF TRANSPORTATION
HIGHWAYS DIVISION
SIGNING & STRIPING
H.S. CONNECTOR ROAD
KEA'AU-PAHOA ROAD VICINITY OF
KEA'AU TOWN (KEA'AU BYPASS ROAD)
PROJECT NO. 130B-01-92, PHASE 1
Scale: 1"=40' Date: May, 1997
SHEET No. 1 OF 1 SHEETS