


FED. ROAD DIST. NO.	STATE	PROJ. NO.	FISCAL YEAR	SHEET NO.	TOTAL SHEETS
HAWAII	HAW.	130A-01-99	2000	8	18

CONSTRUCTION SIGN SUMMARY

SIGN NO.	LOCATION	MESSAGE	W/POSTS	W/O POST
CW20-1Ad	# STA. 88+00 RT.	ROAD WORK AHEAD	1	
CG20-2A	# STA. 88+00 LT.	END ROAD WORK	1	
CW20-1Ad	# STA. 103+00 LT.	ROAD WORK AHEAD	1	
CG20-2A	# STA. 103+00 RT.	END ROAD WORK	1	
CW20-1Ad	PAHOA-KAPOHO RD # STA. 0+00 RT.	ROAD WORK AHEAD	1	
CW20-1Ad	PAHOA-KAPOHO RD # STA. 0+00 LT.	ROAD WORK AHEAD	1	
TOTAL			6	

*Note: Regulatory sign R10-12 shall not be paid for separately. It shall be considered incidental to Item 623.3064 Traffic Signal Assembly (One-way, 12-Inch, 1-4 Section Vertical with Mast Arm Mounting)

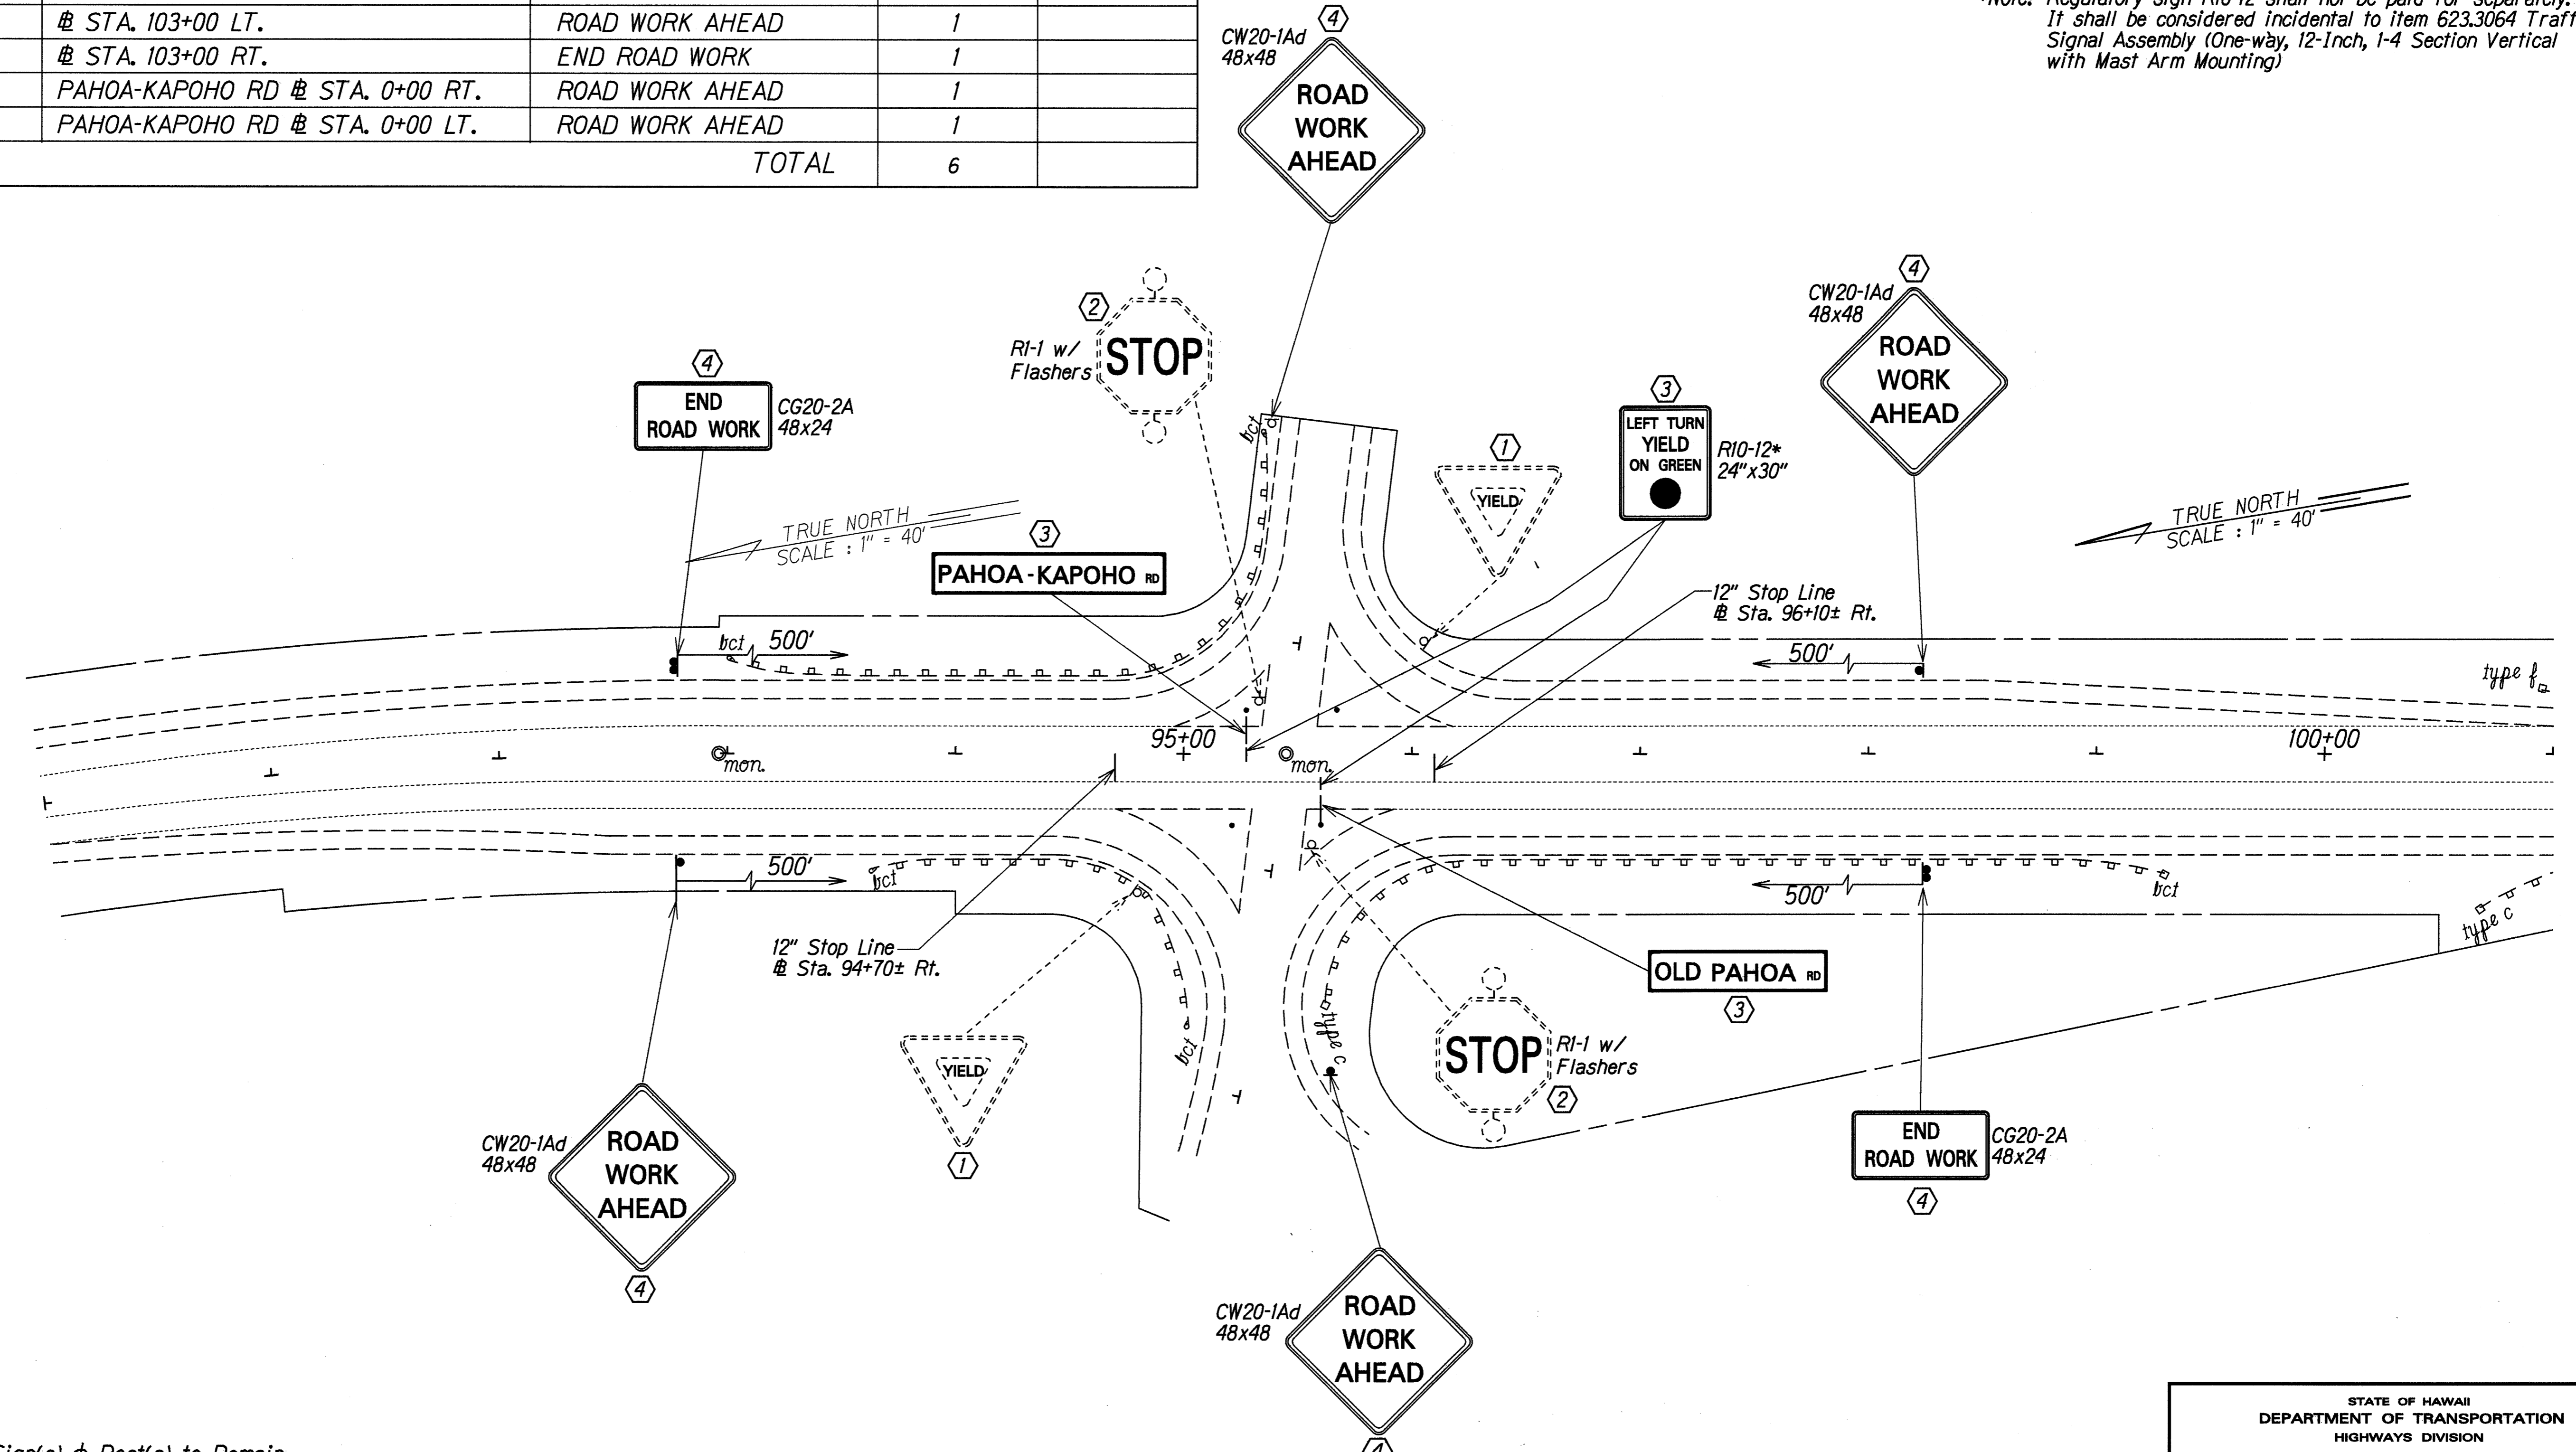

- KEY:
- ① Exist. Sign(s) & Post(s) to Remain
 - ② Remove Exist. Sign(s) w/Post(s)
 - ③ Install New Street Name Sign on New Traffic Signal Standard Mast Arm
 - ④ Install New Sign(s) w/Post(s)

NOTE:
REFER TO SHT NO. C.O. 11 FOR
RELOCATION OF SIGNAL STANDARDS.

SURVEY PLATTED BY: DATE: 1/12/98
 DRAWN BY: R. Achil
 DESIGNED BY: R. Achil
 CHECKED BY: N. Smith

STATE OF HAWAII
DEPARTMENT OF TRANSPORTATION
HIGHWAYS DIVISION

PAVEMENT MARKING & SIGNING PLAN

KEAAU-PAHOA ROAD
Installation of Traffic Signals at
Pahoa-Kapoho Road
Project No. 130A-01-99

Scale: 1"=40' Date: April, 2000

SHEET No. 1 OF 1 SHEETS

"AS-BUILT"