
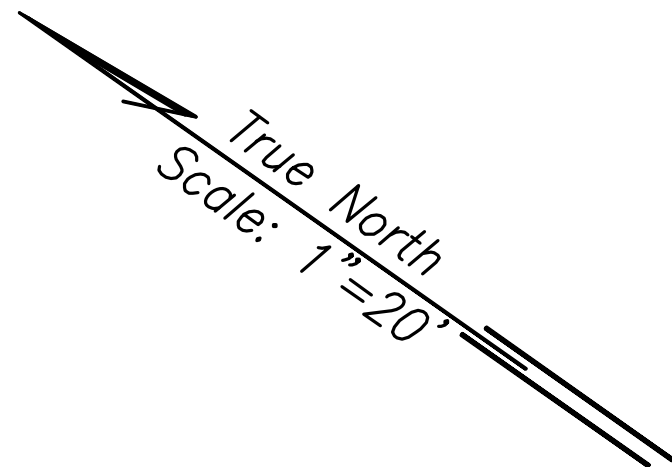


FED. ROAD DIST. NO.	STATE	FED. AID PROJ. NO.	FISCAL YEAR	SHEET NO.	TOTAL SHEETS
HAWAII	HAW.	STP-0130(33)	2016	37	99

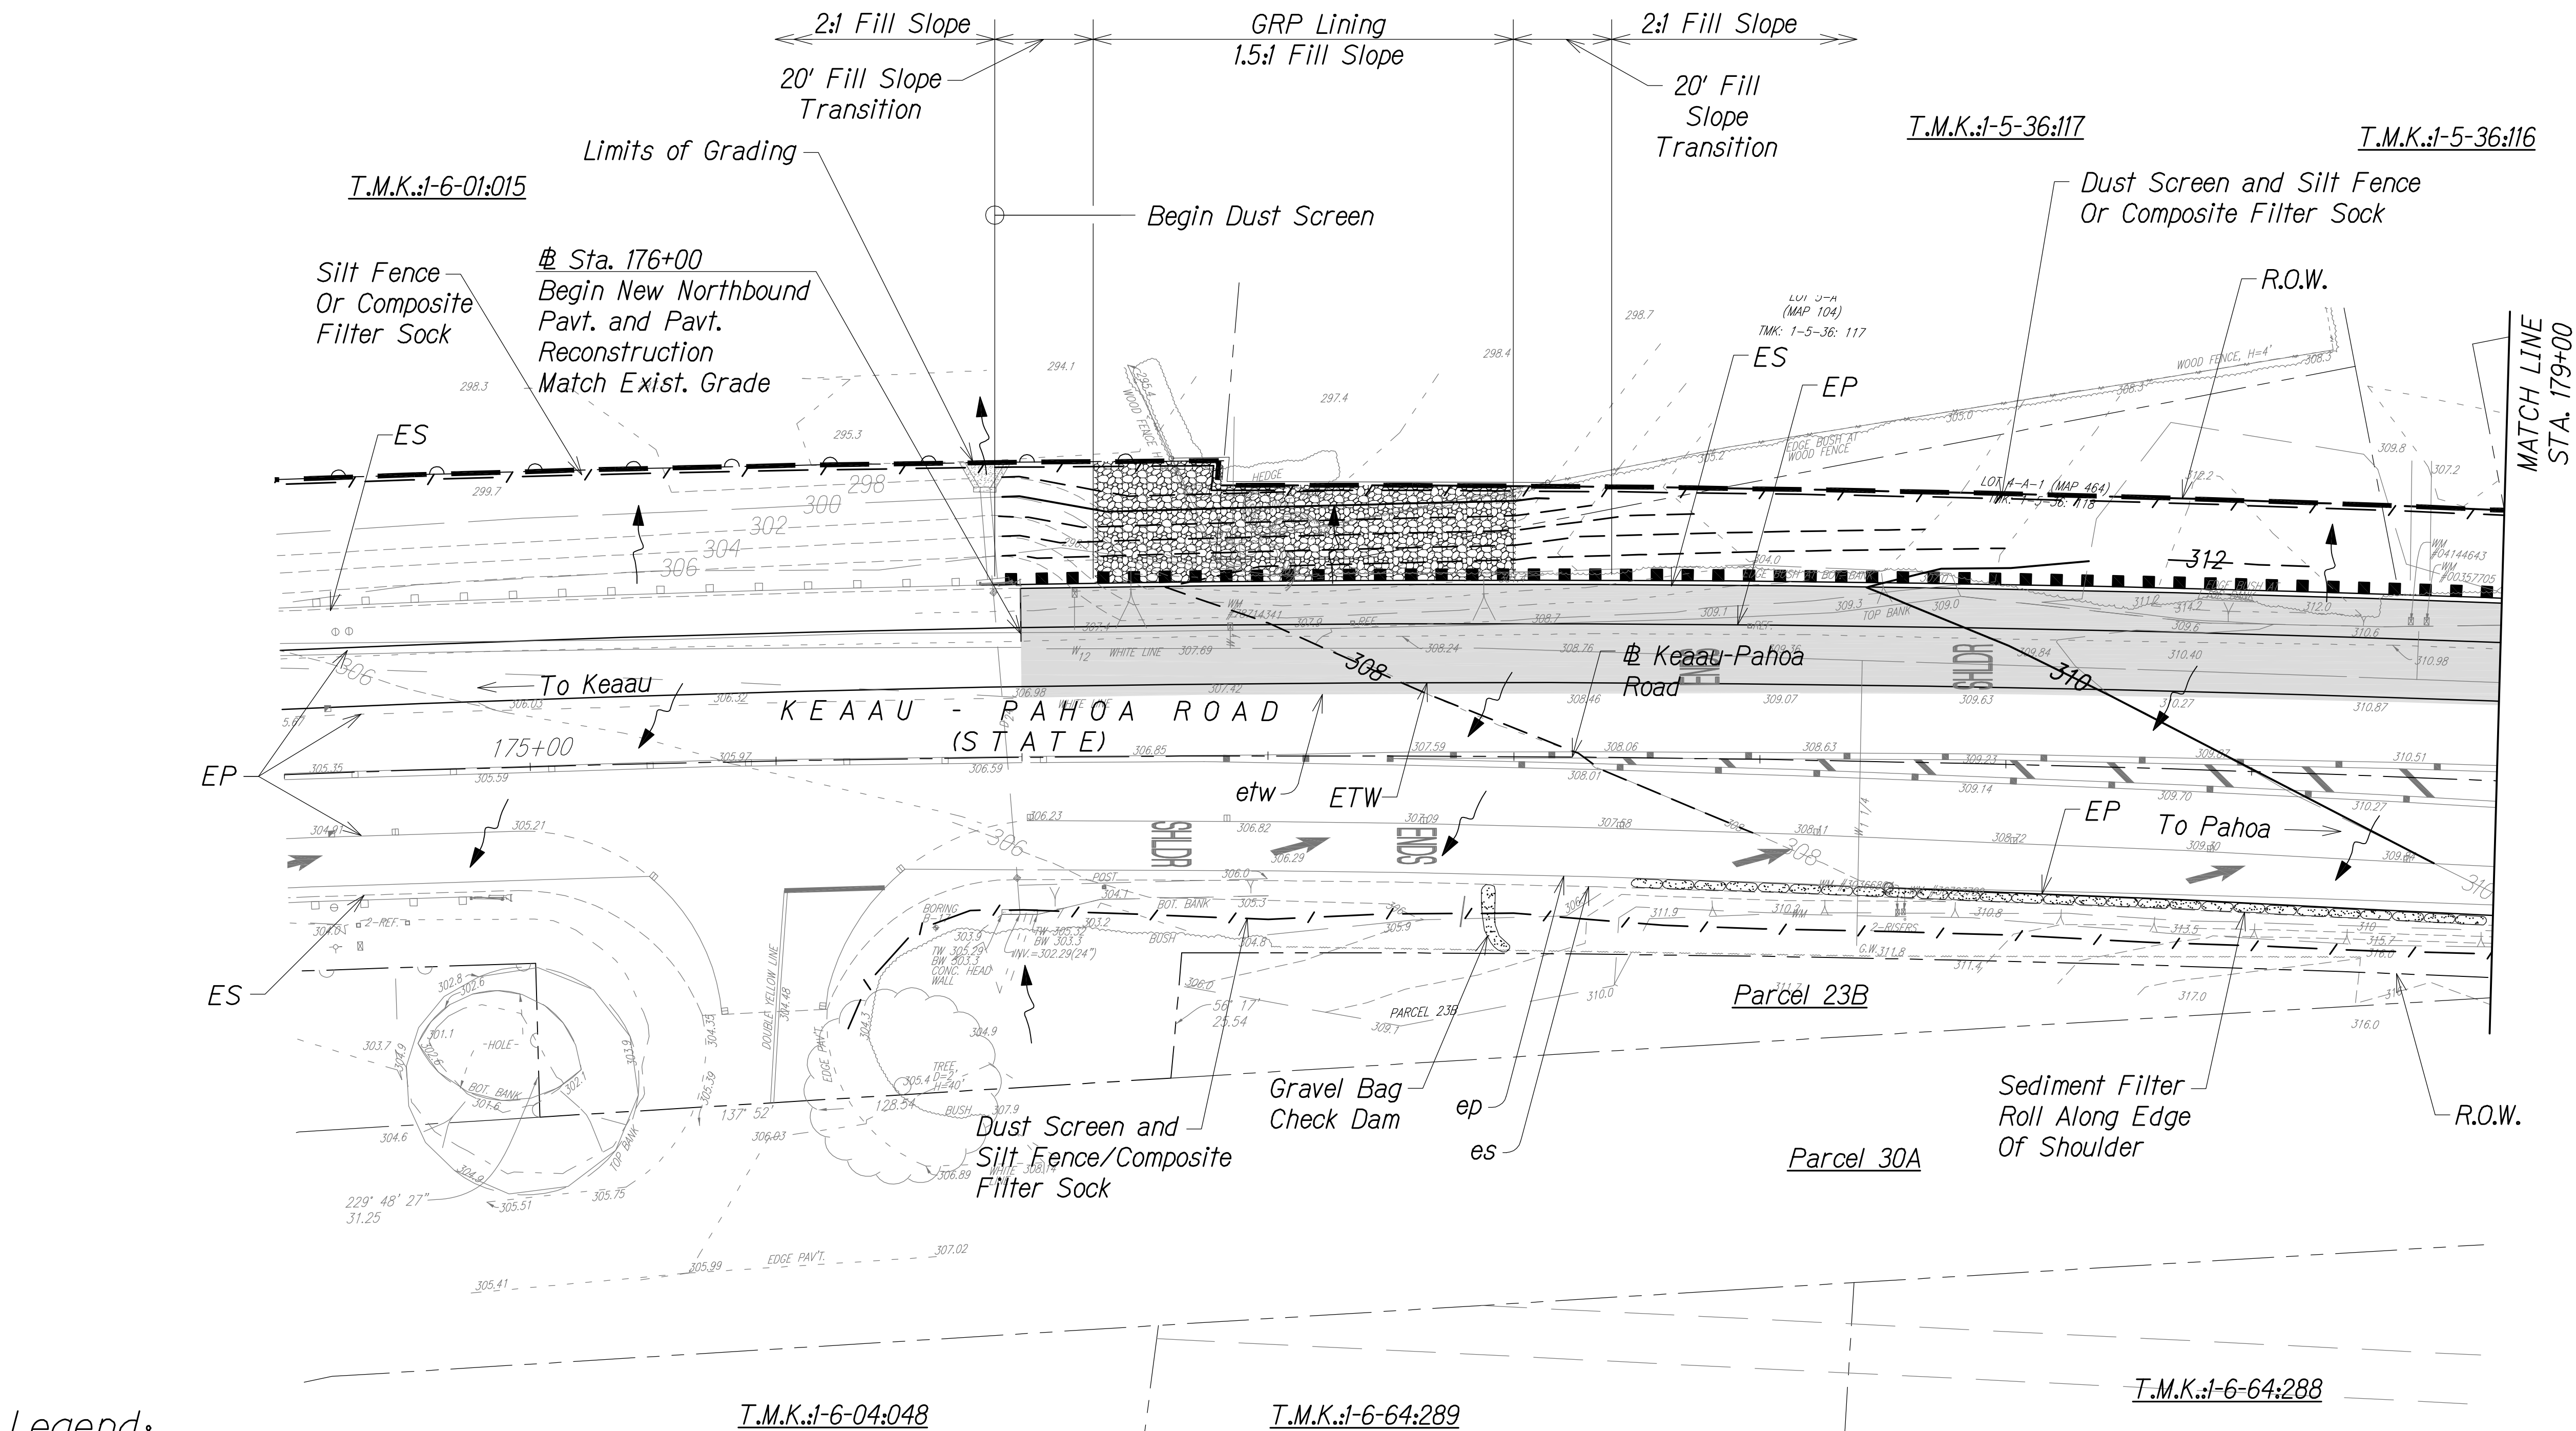


Legend:

- Dust Screen and Silt Fence or Compost Filter Sock
- Sediment Filter Roll
- Gravel Bag Check Dam
- Direction of Flow

LEGEND FOR AS-BUILT POSTINGS

- Squiggly line for as-built deletion
- Double line for as-built deletion
- Roadway
- Text for as-built posting


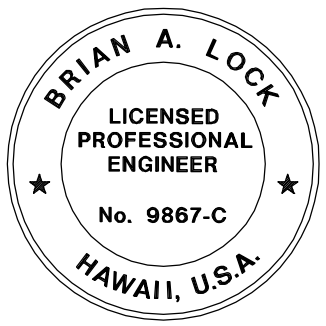


THIS WORK WAS PREPARED BY ME OR UNDER MY SUPERVISION.

APRIL 30, 2018
WILSON OKAMOTO CORPORATION LIC. EXP. DATE

STATE OF HAWAII
DEPARTMENT OF TRANSPORTATION
HIGHWAYS DIVISION
GRADING AND EROSION CONTROL PLAN
KEAAU-PAHOA ROAD, SHOULDER LANE CONVERSION, PHASE 2
Shower Drive Intersection Improvements
Fed. Aid Proj. No. STP-0130(33)
Scale: 1" = 20' Date: March 2016

SHEET No. GP-1 OF 5 SHEETS

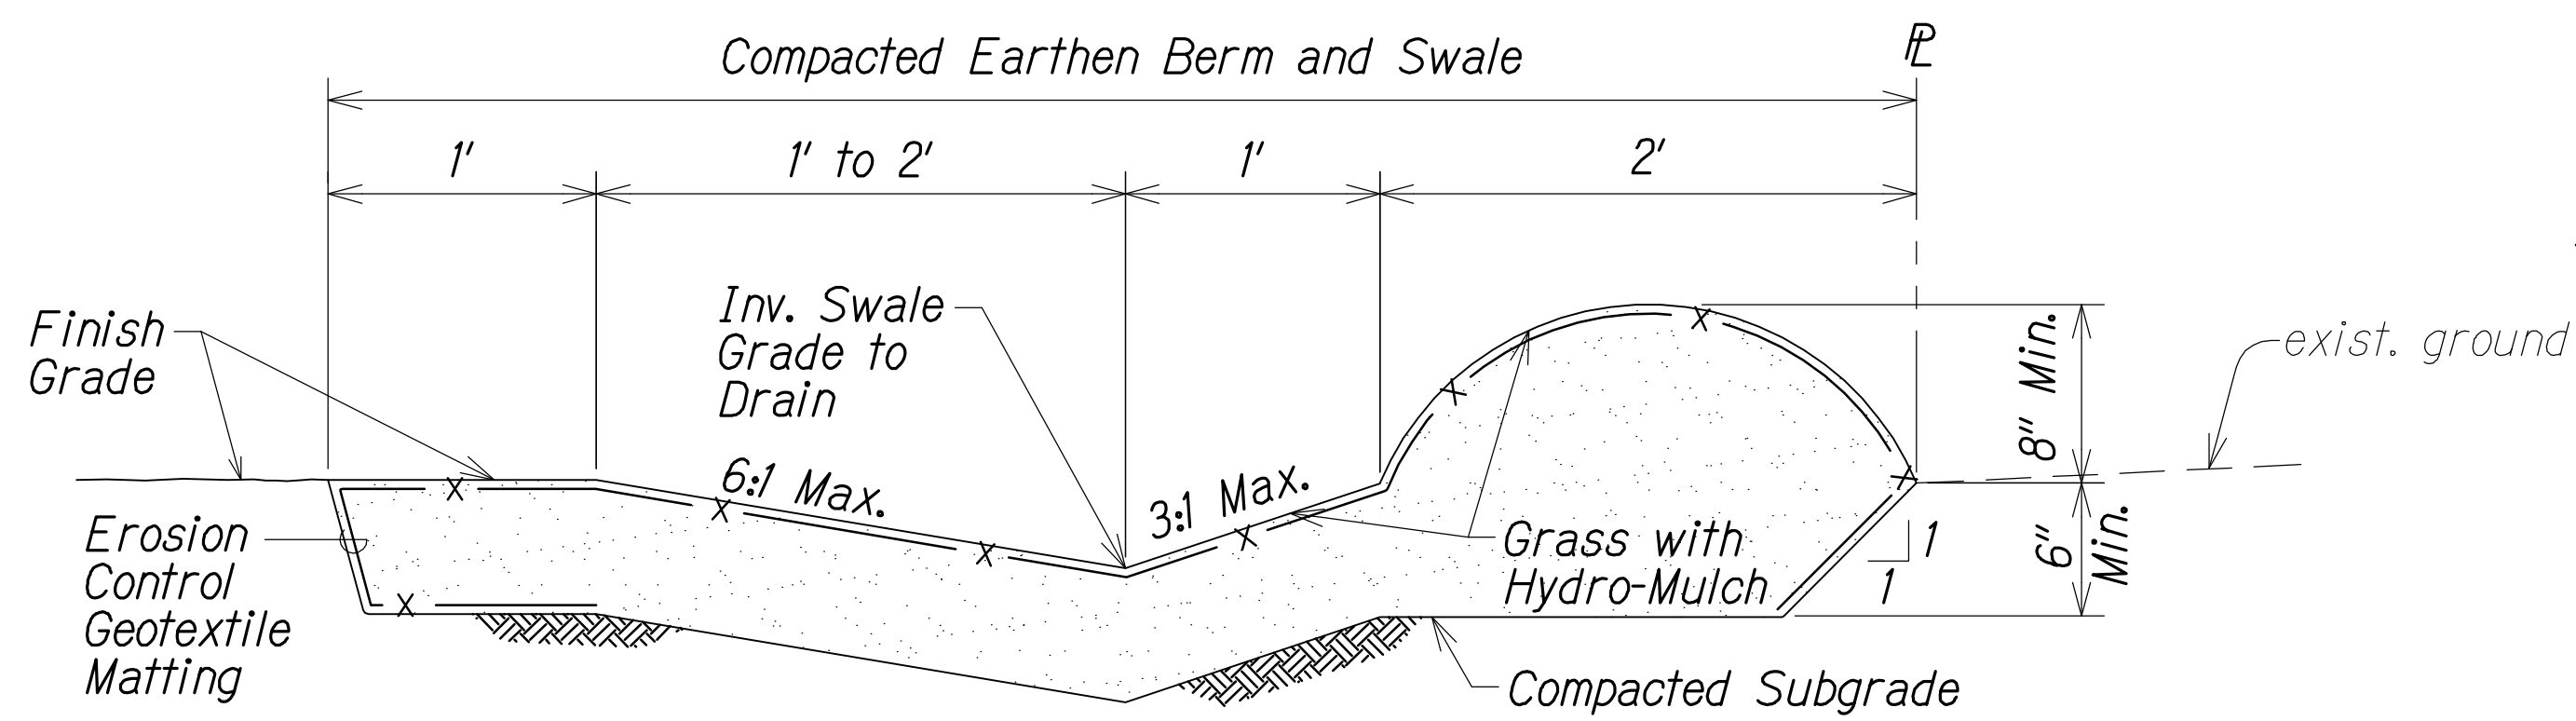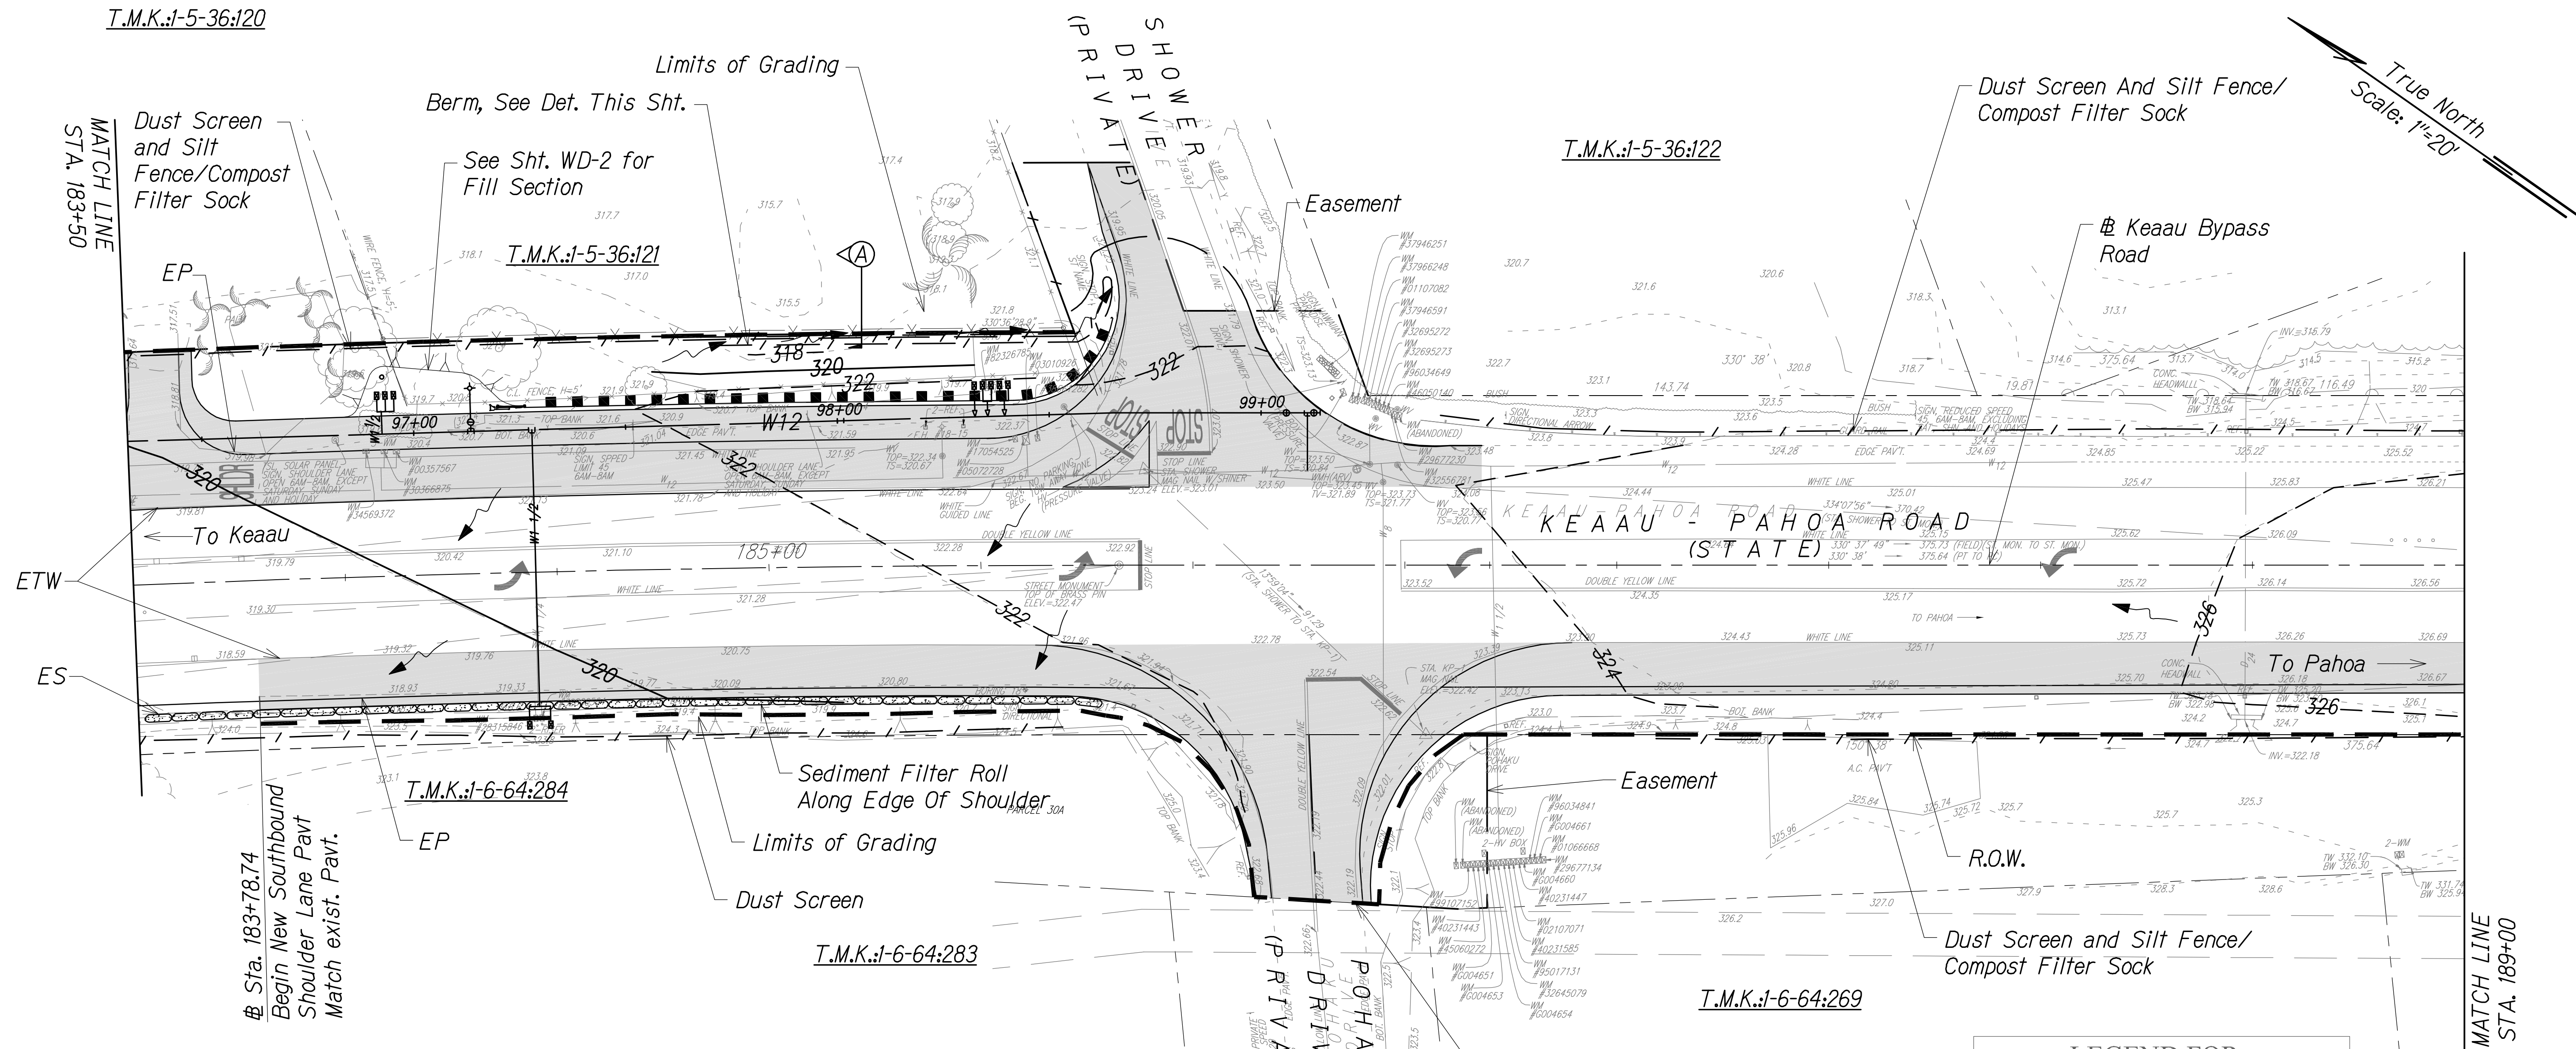


- NOTES:
- Berm and Swale Incidental to Section 210 Dressing of Shoulders.
 - Use Topsoil for Top 3", Use Select Borrow or Subbase for remaining.

LEGEND FOR AS-BUILT POSTINGS

	Squiggly line for as-built deletion
	Double line for as-built deletion
	Text for as-built posting


- Legend:**
- Dust Screen and Silt Fence or Compost Filter Sock
 - Sediment Filter Roll
 - Direction of Flow

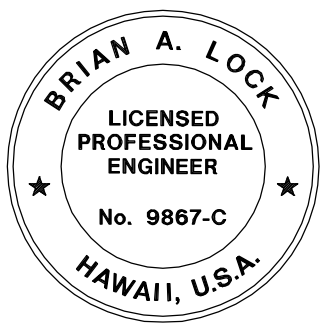

THIS WORK WAS PREPARED BY ME OR UNDER MY SUPERVISION.
APRIL 30, 2018
WILSON OKAMOTO CORPORATION LIC. EXP. DATE

STATE OF HAWAII
DEPARTMENT OF TRANSPORTATION
HIGHWAYS DIVISION
GRADING AND EROSION CONTROL PLAN
KEAAU-PAHOA ROAD, SHOULDER LANE CONVERSION, PHASE 2
Show Drive Intersection Improvements
Fed. Aid Proj. No. STP-0130(33)
Scale: 1" = 20' Date: March 2016

FED. ROAD DIST. NO.	STATE	FED. AID PROJ. NO.	FISCAL YEAR	SHEET NO.	TOTAL SHEETS
HAWAII	HAW.	STP-0130(33)	2016	40	99

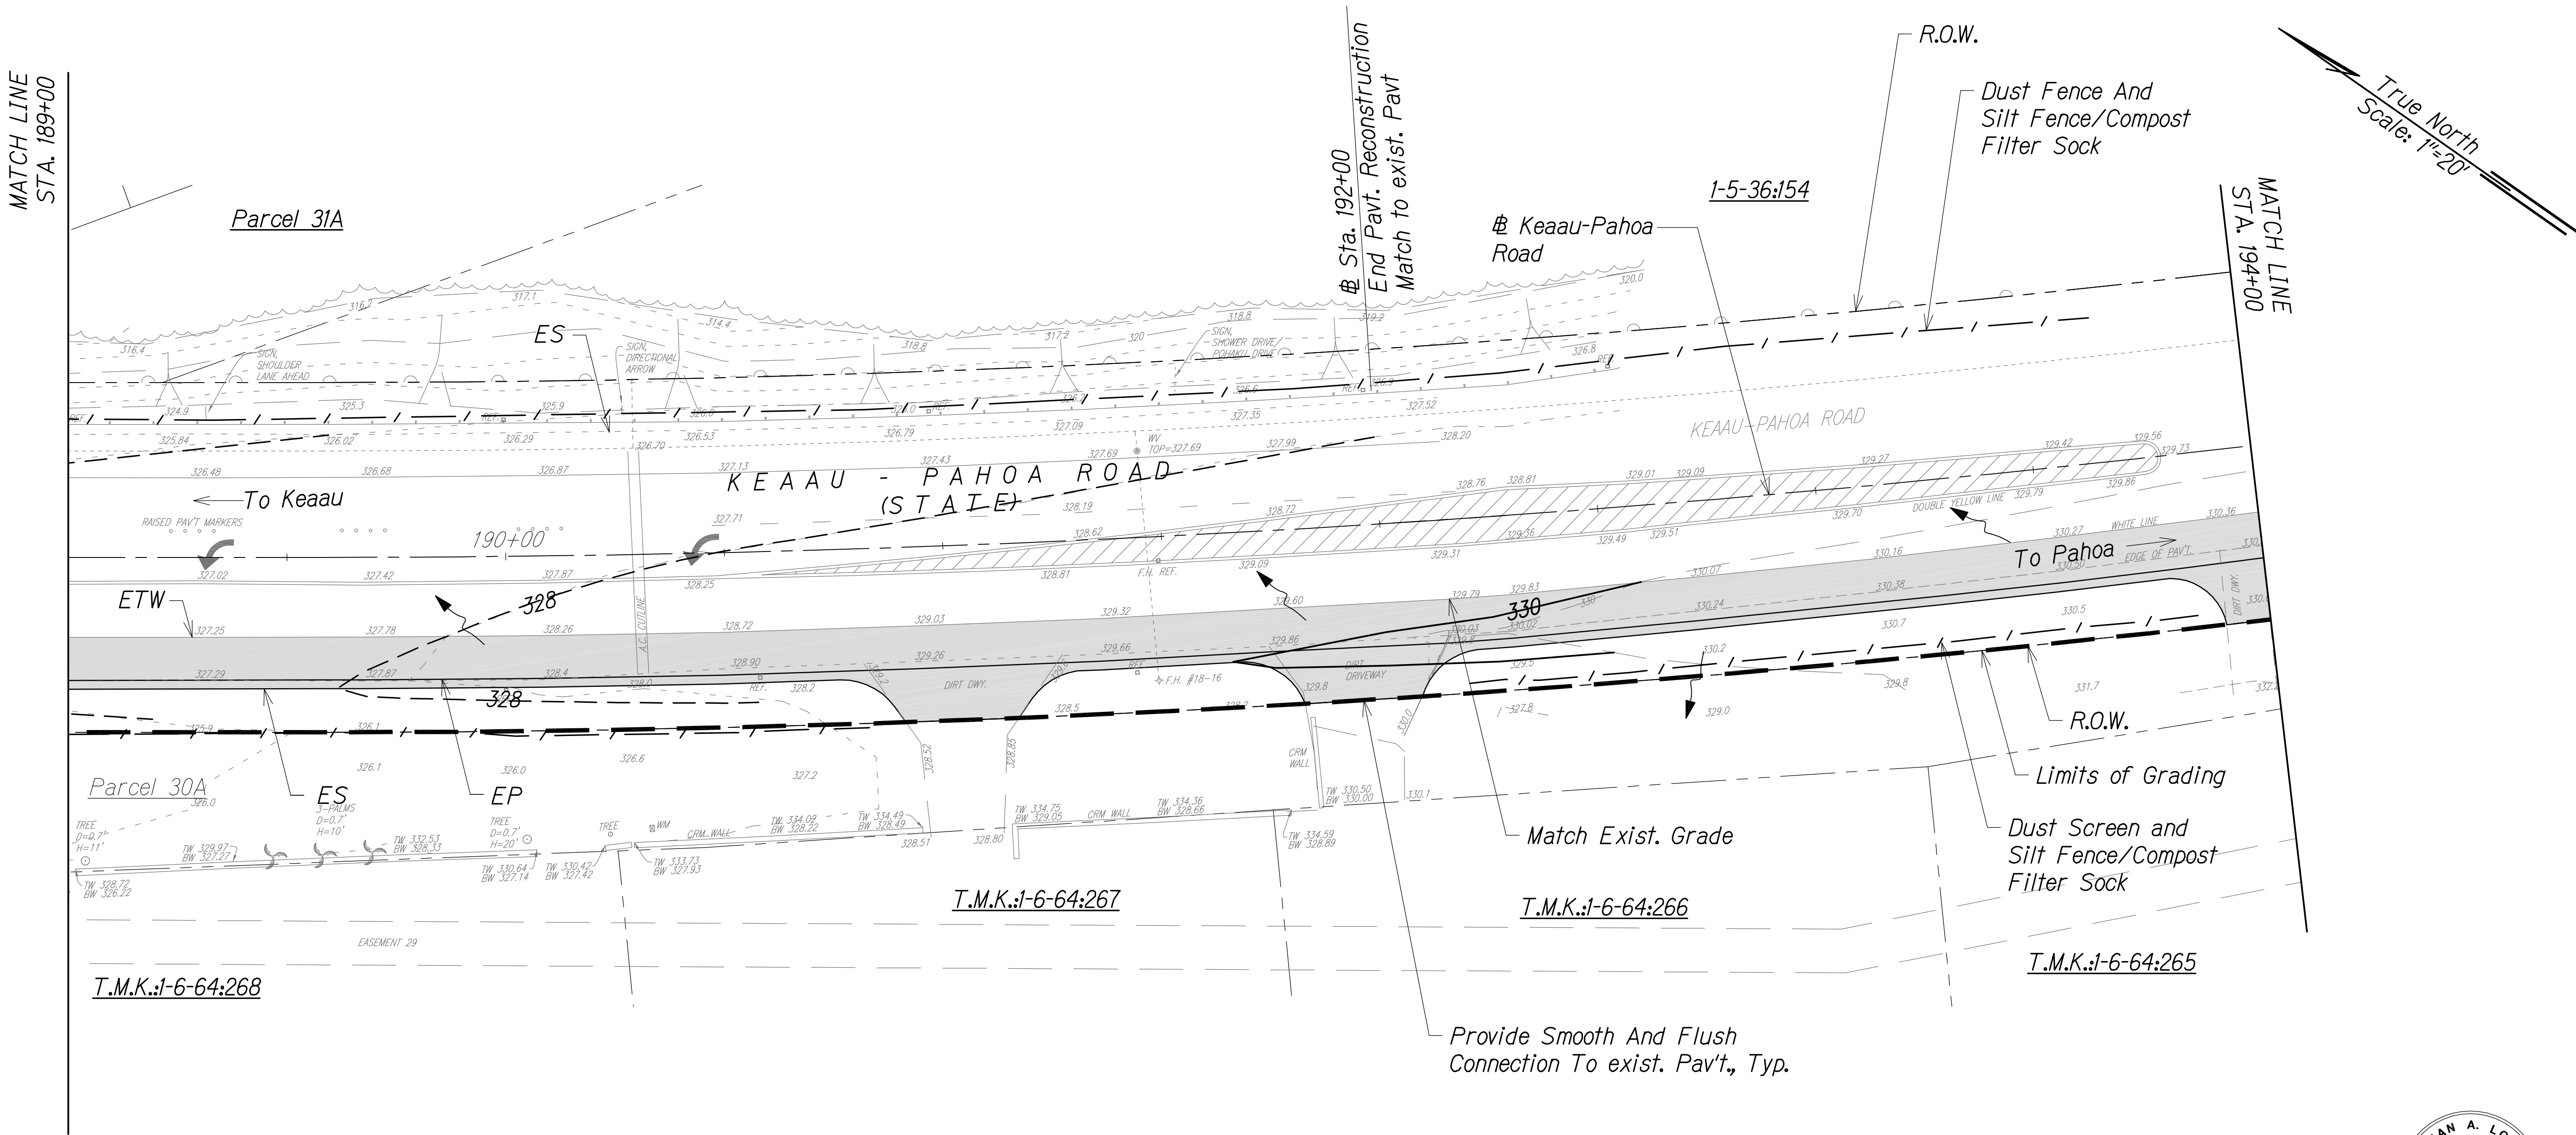


Legend:

- / — Dust Screen and Silt Fence or Compost Filter Sock
- ↖ Direction of Flow

LEGEND FOR AS-BUILT POSTINGS

- ~~~~~ Squiggly line for as-built deletion
- ±00.00 Double line for as-built deletion
- Roadway Text for as-built posting

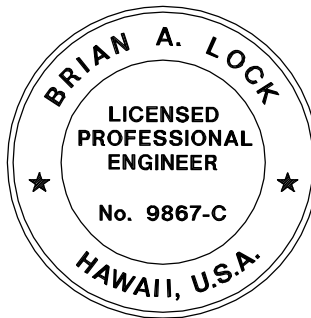

THIS WORK WAS PREPARED BY ME OR UNDER MY SUPERVISION.

APRIL 30, 2018
WILSON OKAMOTO CORPORATION LIC. EXP. DATE


STATE OF HAWAII
DEPARTMENT OF TRANSPORTATION
HIGHWAYS DIVISION
GRADING AND EROSION CONTROL PLAN
KEAAU-PAHOA ROAD, SHOULDER LANE CONVERSION, PHASE 2
Show Drive Intersection Improvements
Fed. Aid Proj. No. STP-0130(33)
Scale: 1" = 20' Date: March 2016

SHEET No. GP-4 OF 5 SHEETS

"AS-BUILT"

40

FED. ROAD DIST. NO.	STATE	FED. AID PROJ. NO.	FISCAL YEAR	SHEET NO.	TOTAL SHEETS
HAWAII	HAW.	STP-0130(33)	2016	41	99

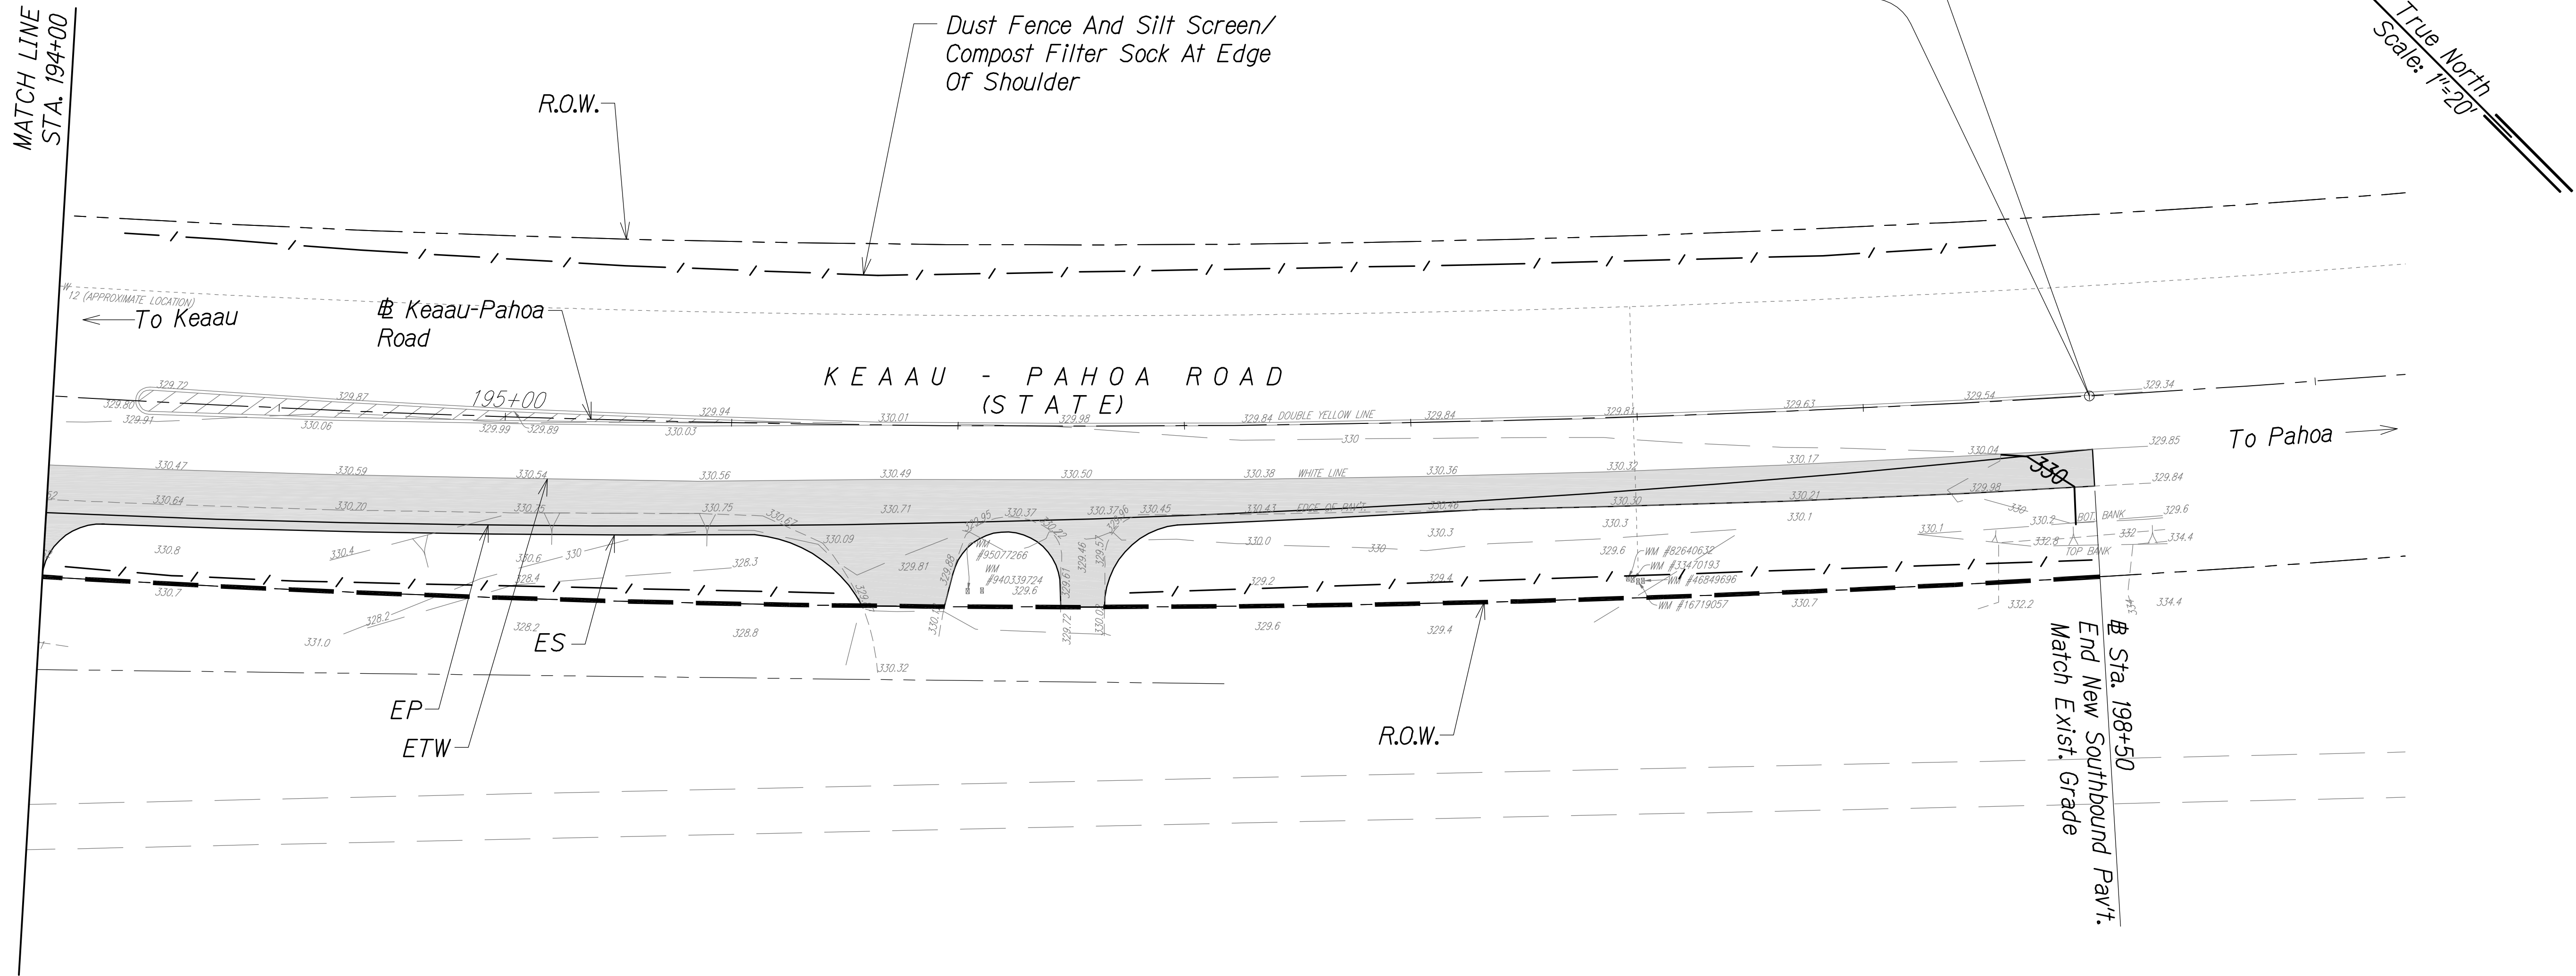


SURVEY PLOTTED BY	DATE
DRAWN BY	
TRACED BY	
CHECKED BY	
QUANTITIES BY	
CHECKED BY	
ORIGINAL PLAN	
NOTE BOOK	
No.	

Legend:

- / — Dust Screen and Silt Fence or Compost Filter Sock
- ← Direction of Flow

LEGEND FOR AS-BUILT POSTINGS

- Squiggly line for as-built deletion
- Double line for as-built deletion
- Roadway Text for as-built posting

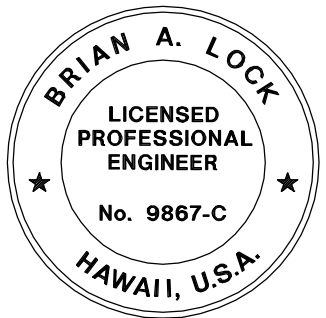

THIS WORK WAS PREPARED BY ME OR UNDER MY SUPERVISION.

APRIL 30, 2018
WILSON OKAMOTO CORPORATION LIC. EXP. DATE

STATE OF HAWAII
DEPARTMENT OF TRANSPORTATION
HIGHWAYS DIVISION
GRADING AND EROSION CONTROL PLAN
KEAAU-PAHOA ROAD, SHOULDER LANE CONVERSION, PHASE 2
Show Drive Intersection Improvements
Fed. Aid Proj. No. STP-0130(33)
Scale: 1" = 20' Date: March 2016

SHEET No. GP-5 OF 5 SHEETS

"AS-BUILT"