

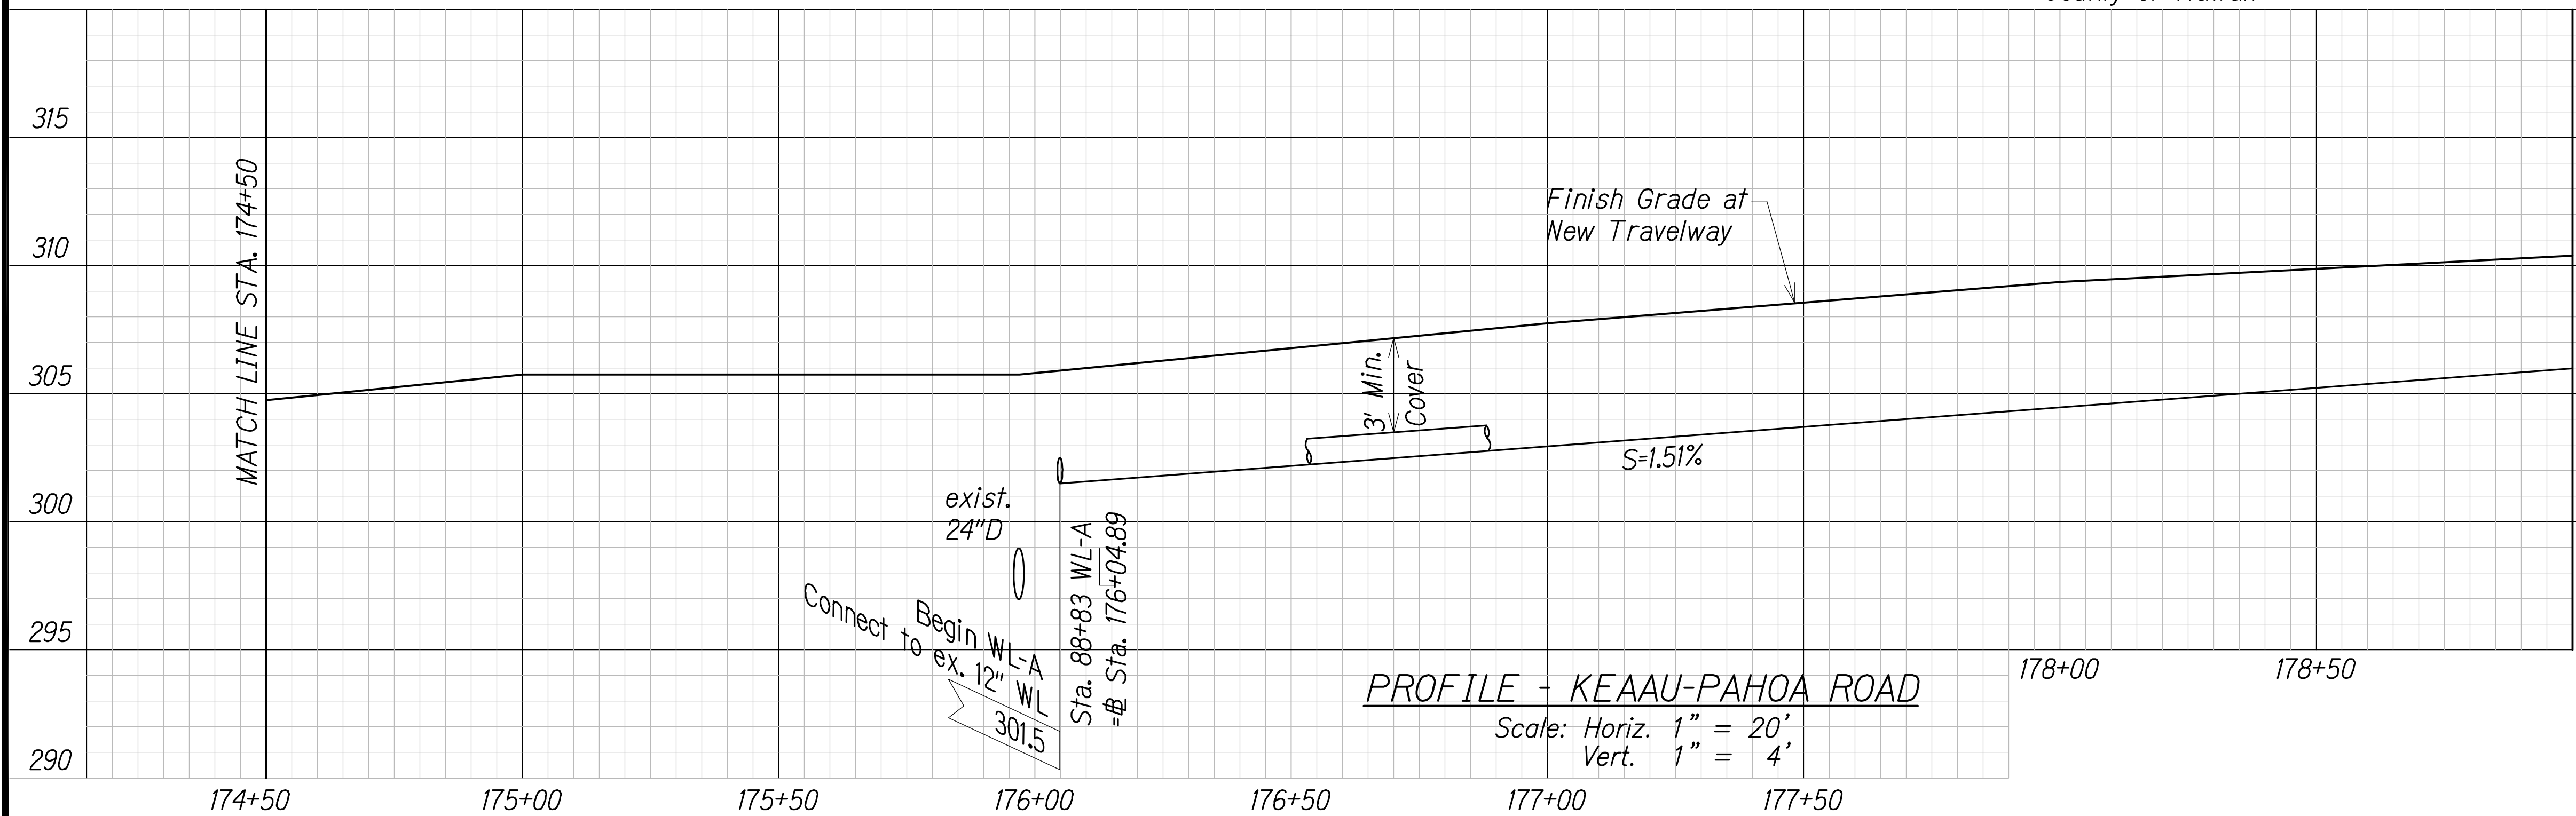


FED. ROAD DIST. NO.	STATE	FED. AID PROJ. NO.	FISCAL YEAR	SHEET NO.	TOTAL SHEETS
HAWAII	HAW.	STP-0130(33)	2016	47	99

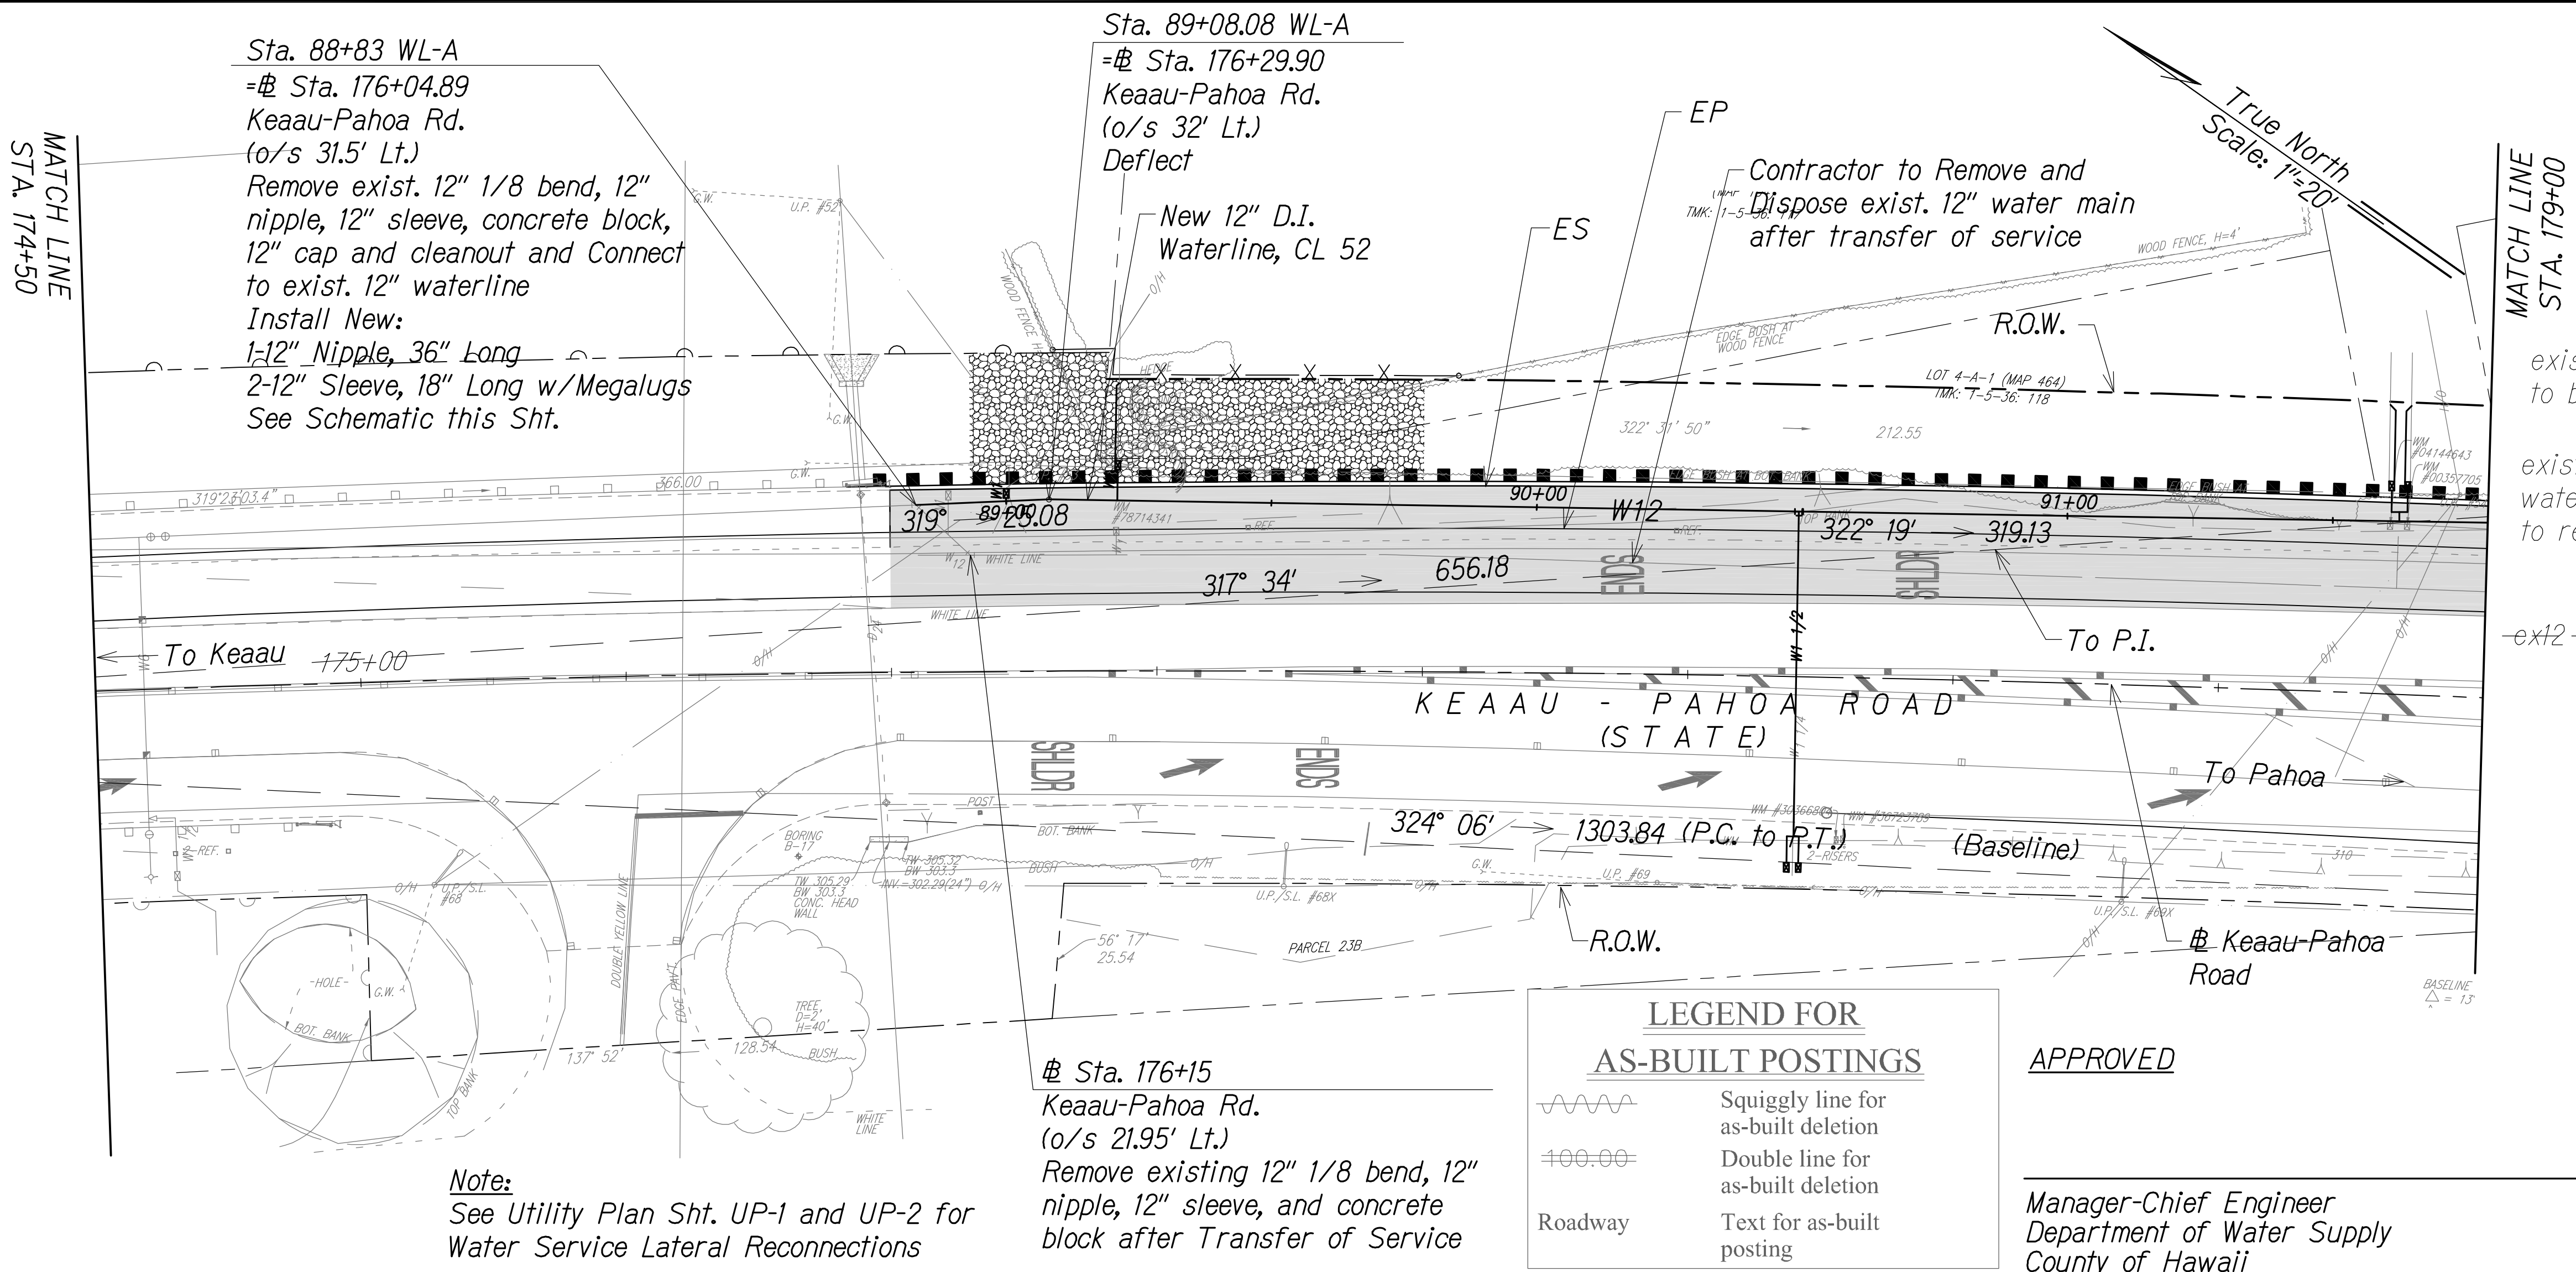

SURVEY PLOTTED BY	DATE
DRAWN BY	
CHECKED BY	
NOTED BY	
QUANTITIES BY	
CHECKED BY	

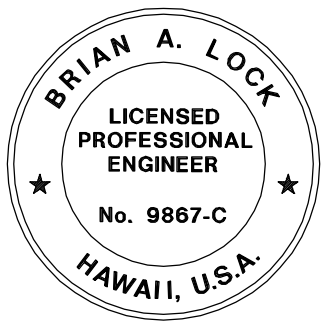

THIS WORK WAS PREPARED BY ME
OR UNDER MY SUPERVISION.

APRIL 30, 2018
WILSON OKAMOTO CORPORATION LIC. EXP. DATE


STATE OF HAWAII
DEPARTMENT OF TRANSPORTATION
HIGHWAYS DIVISION

WATERLINE PLAN

KEAAU-PAHOA ROAD, SHOULDER
LANE CONVERSION, PHASE 2
Shower Drive Intersection Improvements
Fed. Aid Proj. No. STP-0130(33)
Scale: 1" = 20' Date: March 2016

SHEET No. WP-1 OF 3 SHEETS



FED. ROAD DIST. NO.	STATE	FED. AID PROJ. NO.	FISCAL YEAR	SHEET NO.	TOTAL SHEETS
HAWAII	HAW.	STP-0130(33)	2016	49	99

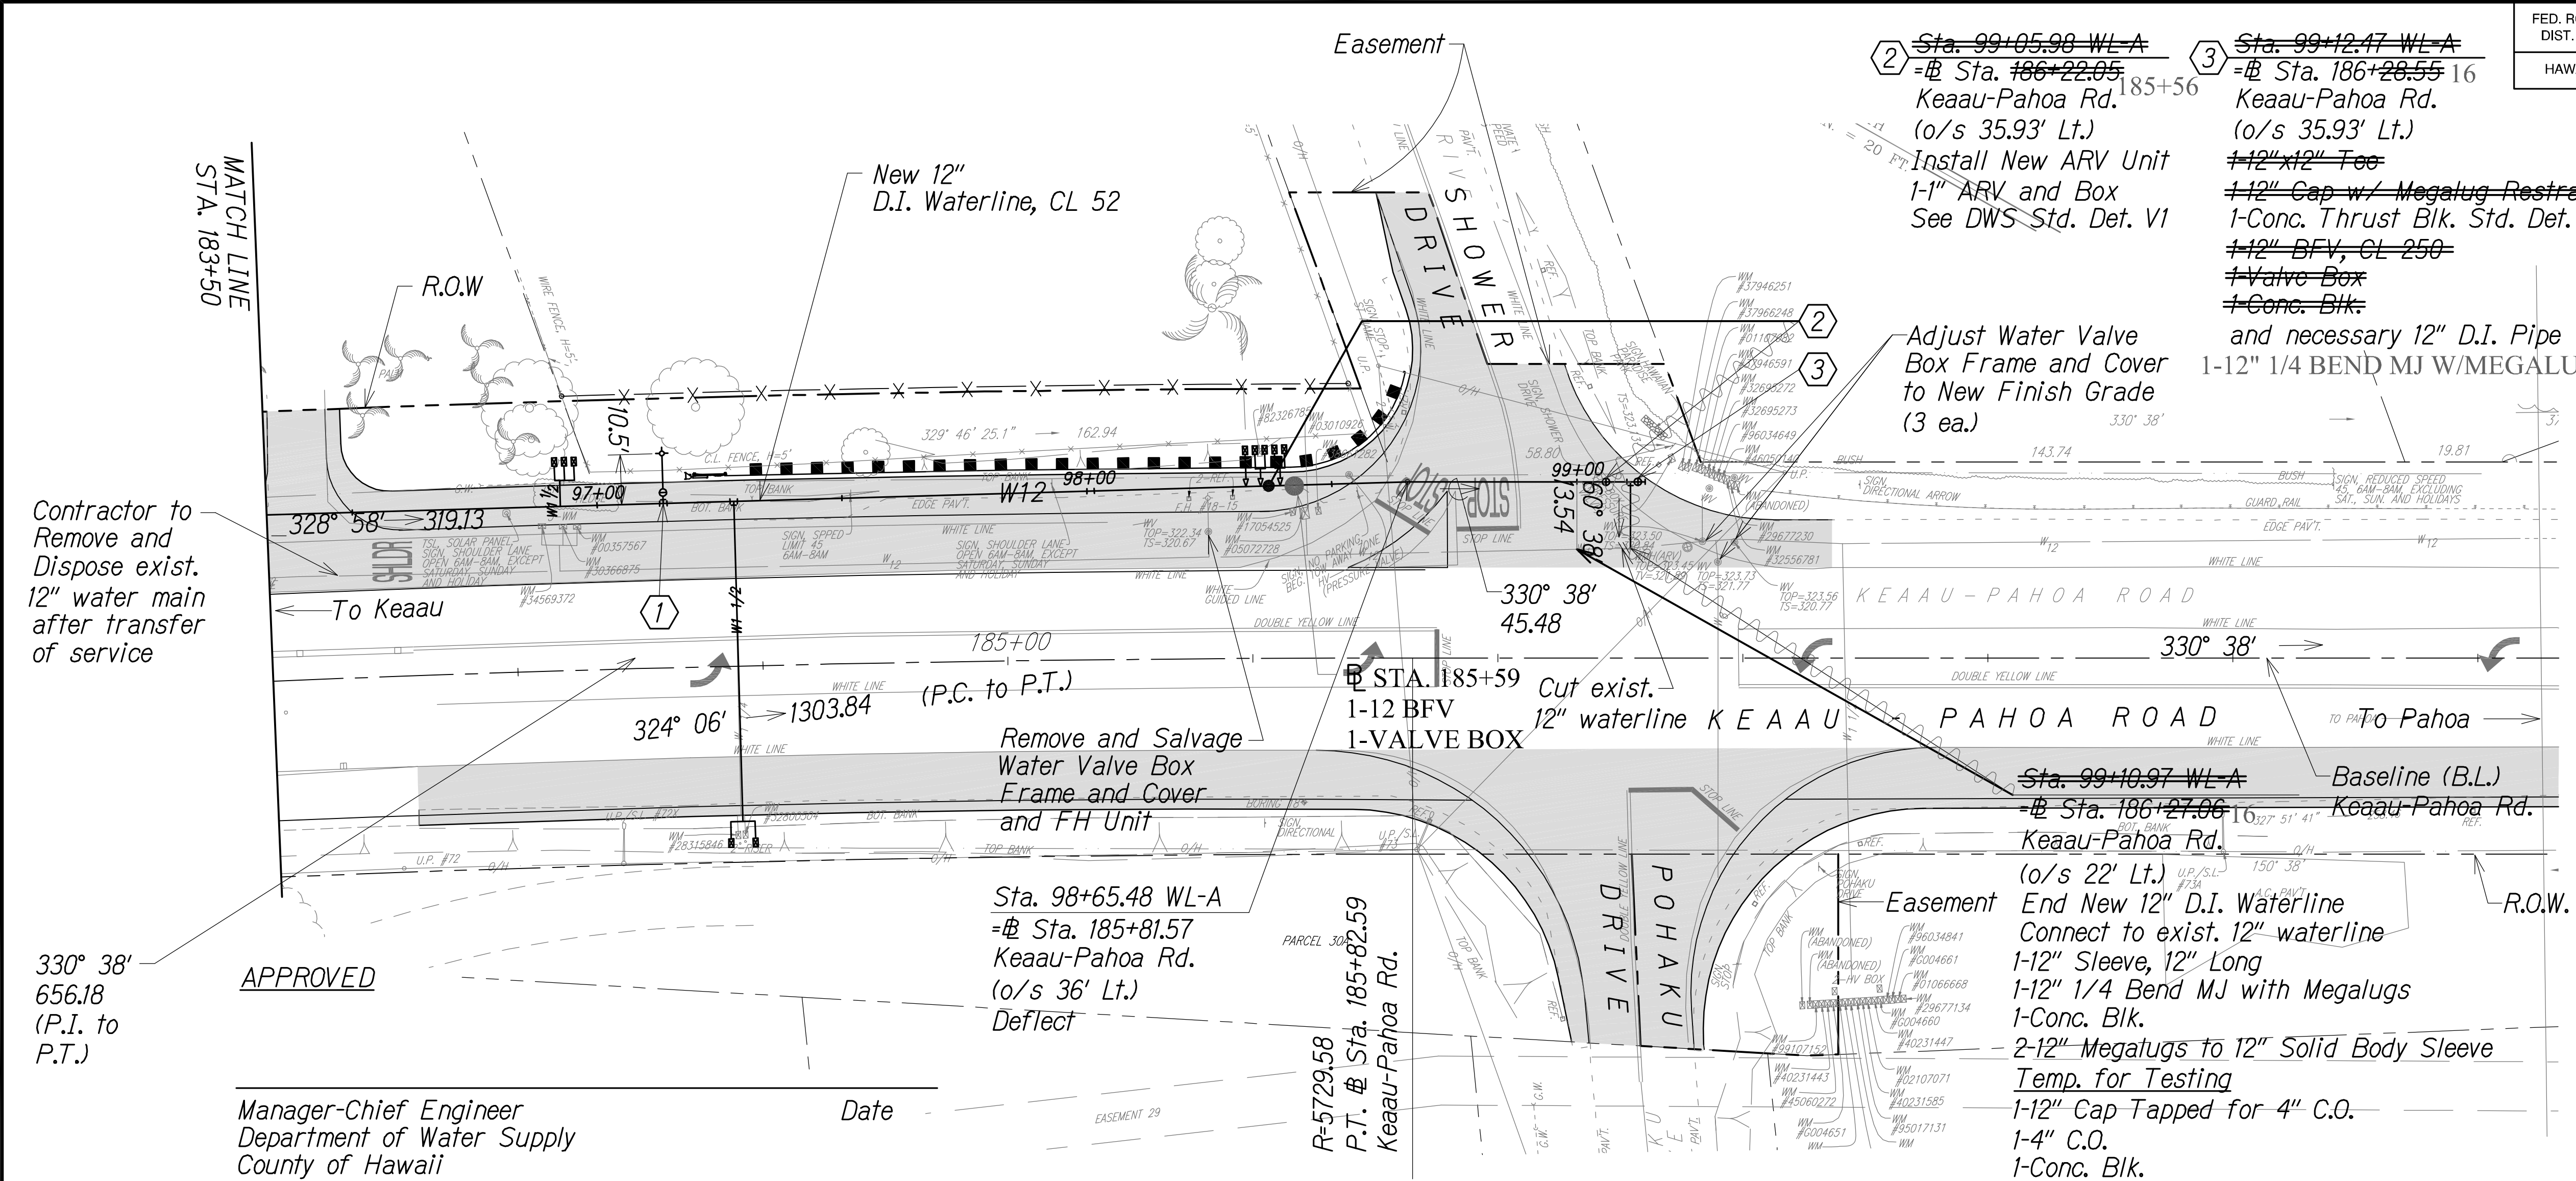

LEGEND FOR AS-BUILT POSTINGS

- Squiggly line for as-built deletion
- Double line for as-built deletion
- Roadway Text for as-built posting

Note:
See Utility Plan Sht. UP-4 for Water Service Lateral Reconnections

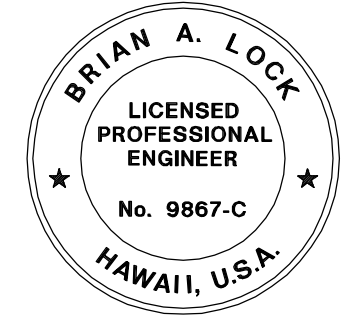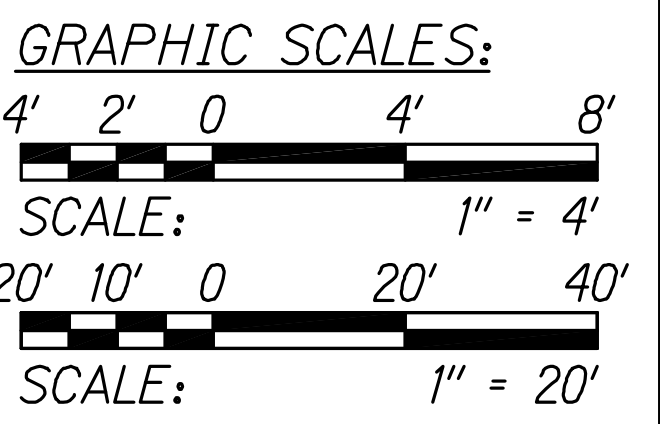

THIS WORK WAS PREPARED BY ME OR UNDER MY SUPERVISION.


APRIL 30, 2018
WILSON OKAMOTO CORPORATION LIC. EXP. DATE

STATE OF HAWAII
DEPARTMENT OF TRANSPORTATION
HIGHWAYS DIVISION

WATERLINE PLAN

KEAAU-PAHOA ROAD, SHOULDER
LANE CONVERSION, PHASE 2
Shower Drive Intersection Improvements
Fed. Aid Proj. No. STP-0130(33)
Scale: 1" = 20' Date: March 2016

SHEET No. WP-3 OF 3 SHEETS

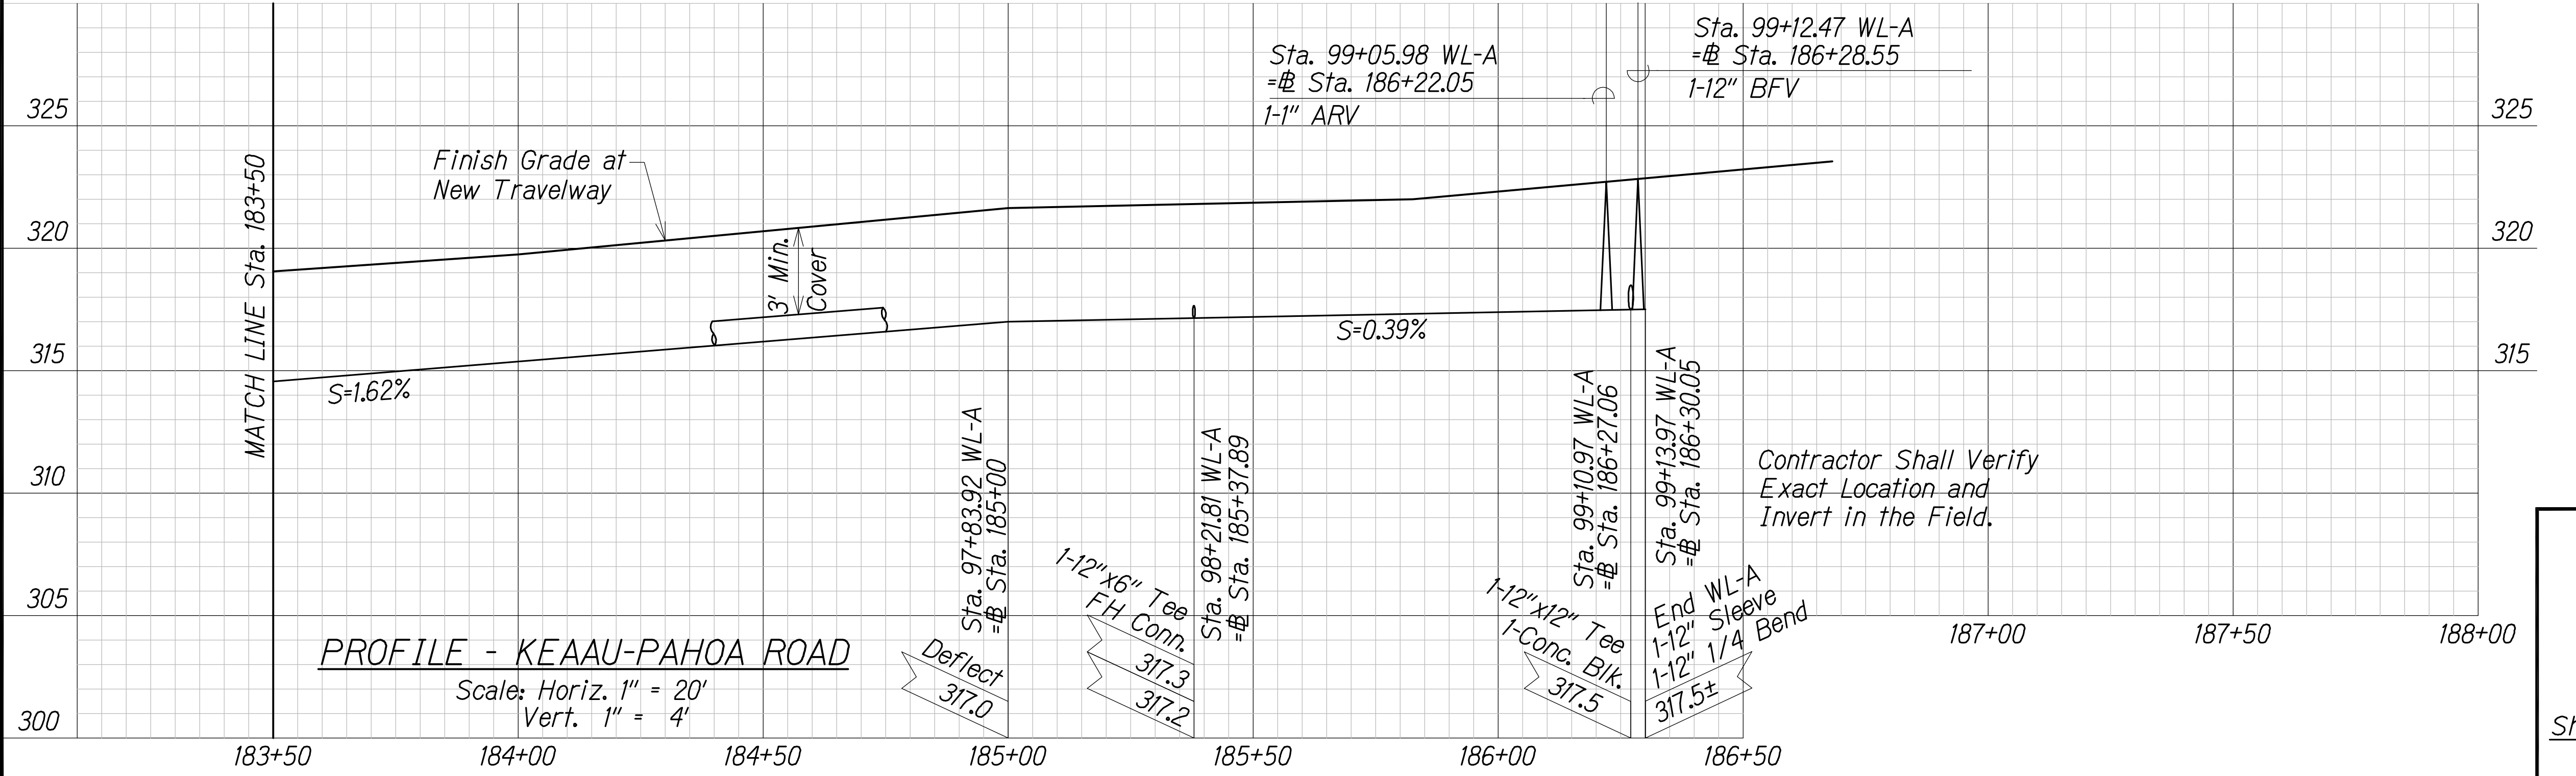

SURVEY PLOTTED BY	DATE
DRAWN BY	
TRACED BY	
CHECKED BY	
QUANTITIES BY	
NOTE BOOK	
NO.	