


FED. ROAD DIST. NO.	STATE	PROJ. NO.	FISCAL YEAR	SHEET NO.	TOTAL SHEETS
HAWAII	HAW.	130B-01-07	2007	18	29

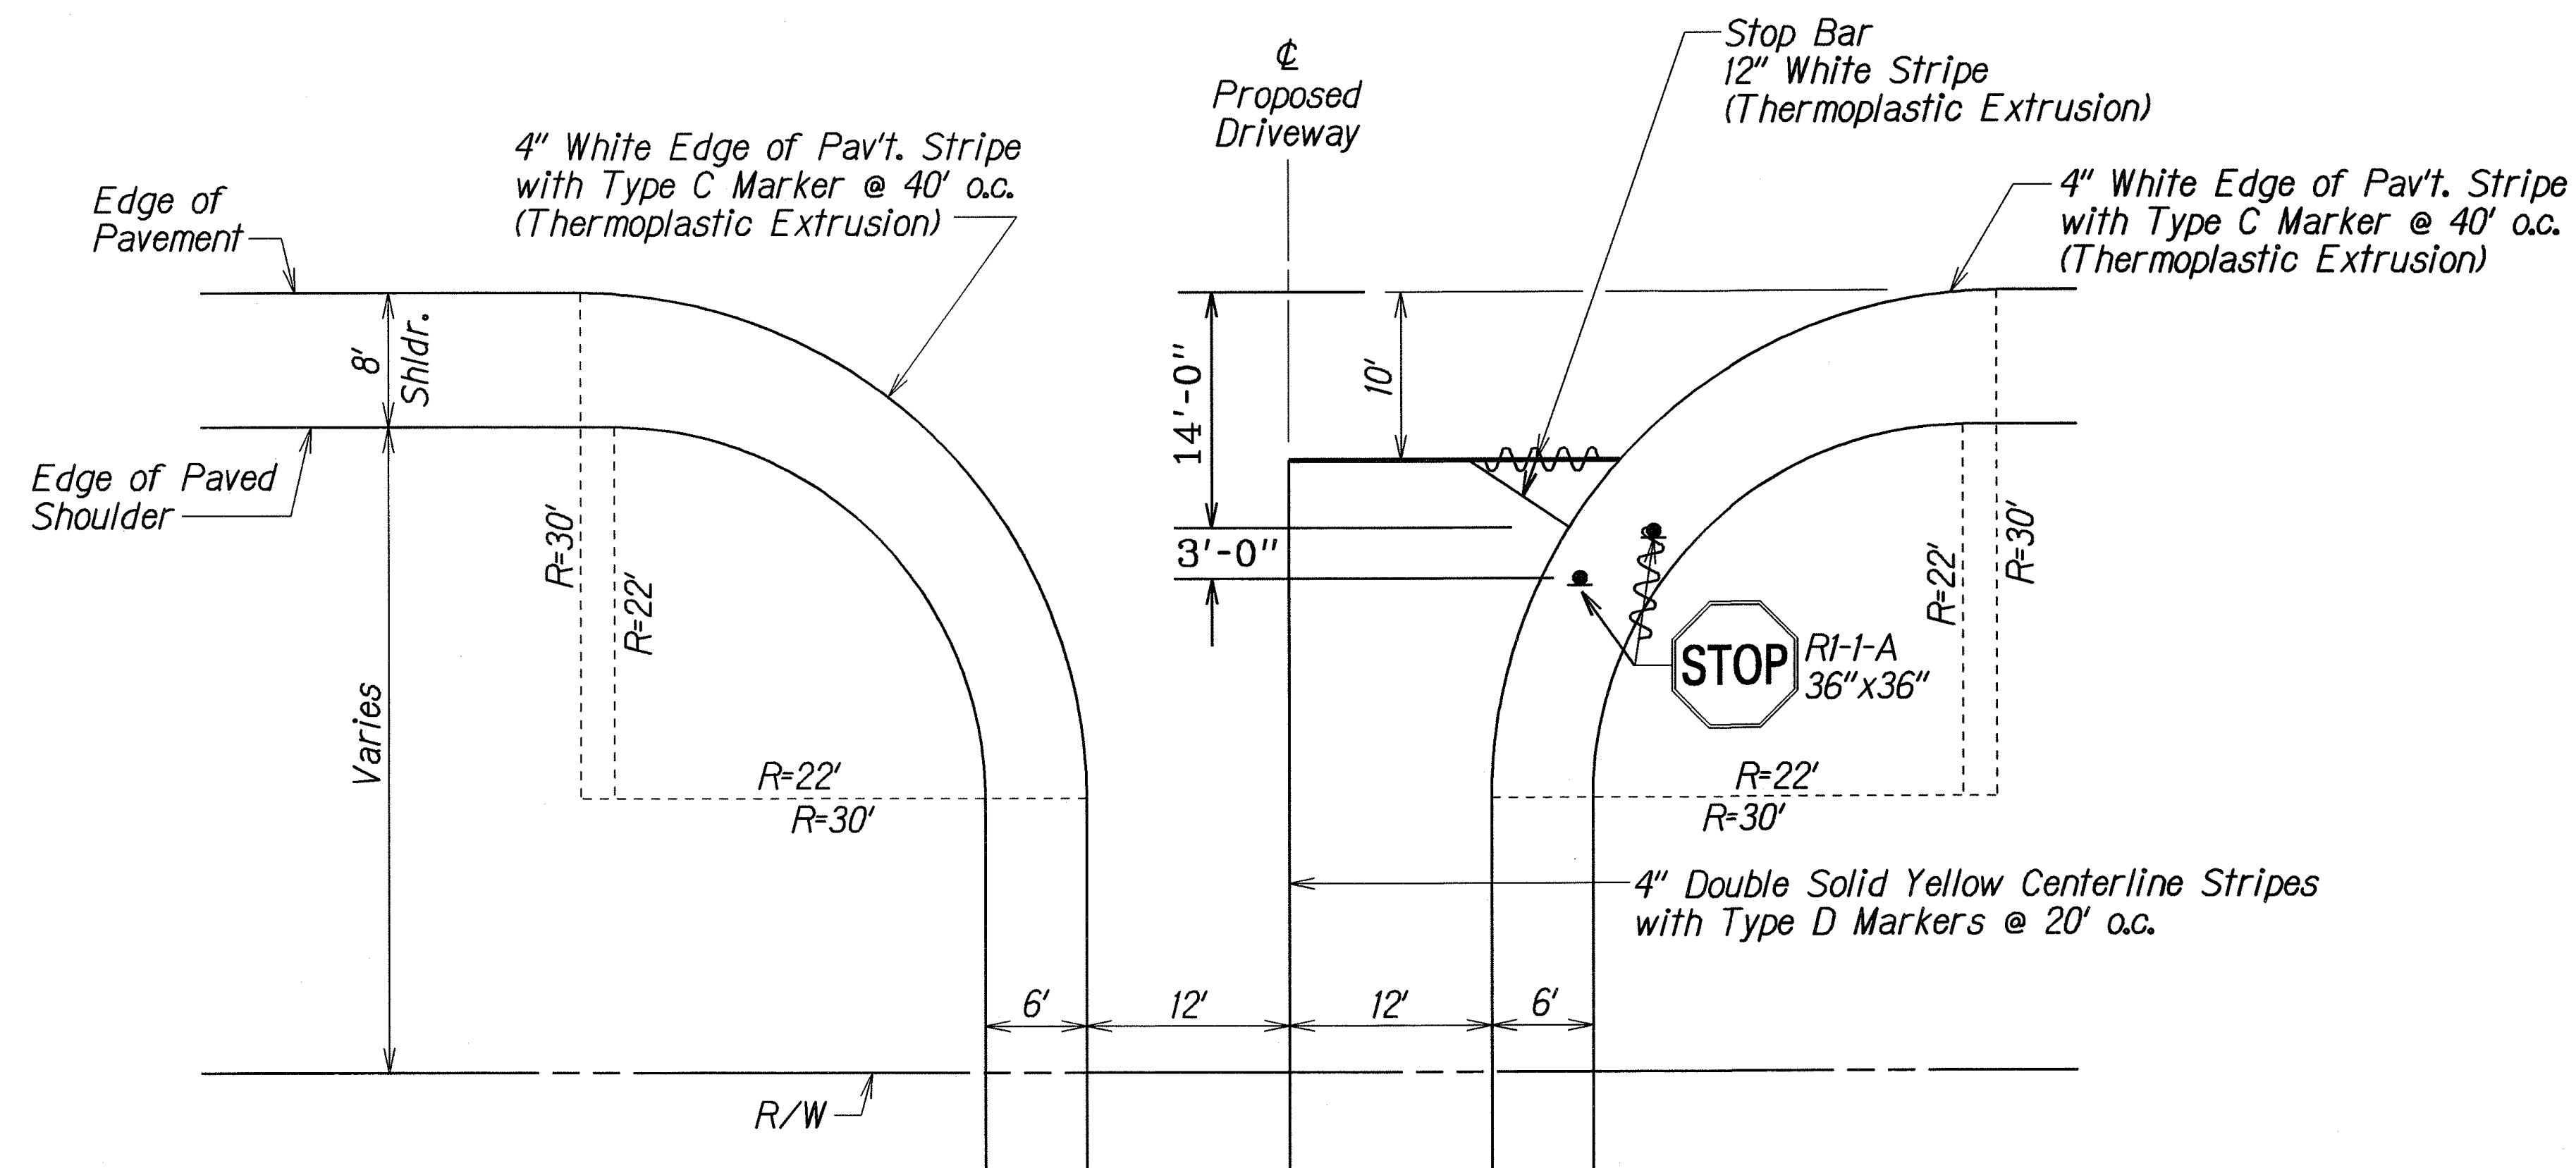

DRIVEWAY STRIPING & SIGNING PLAN

Scale: 1/8" = 1'-0"

LEGEND FOR AS-BUILT POSTINGS

	Squiggly line for as-built deletion
	Double line for as-built deletion
Roadway	Text for as-built posting

STATE OF HAWAII
DEPARTMENT OF TRANSPORTATION
HIGHWAYS DIVISION

DRIVEWAY STRIPING & SIGNING PLAN

KEA'AU-PĀHOA ROAD
HIGHWAY ACCESS IMPROVEMENTS
Vicinity of Ka Ohūwalu Street
Project No. 130B-01-07

Scale: As Shown Date: Oct. 2006

SHEET No. 1 OF 1 SHEETS

"AS-BUILT"