

INDEX TO DRAWINGS	
SHEET NO.	DESCRIPTION
1	TITLE SHEET
2	STANDARD PLANS
3	GENERAL NOTES & LEGEND
4 - 5	WATER POLLUTION & EROSION CONTROL NOTES
6 - 7	TYPICAL SECTIONS
8	ROADWAY PLANS
9	PAVEMENT MARKING, LEGEND, DETAILS & NOTES
10	HIGH SPEED UNDIVIDED HIGHWAY WORKZONE SIGNING PLAN, NOTES & DETAILS
11	PAVEMENT MARKING & STRIPING PLAN
12	SIGN DETAILS
13	SHOULDER MILLED RUMBLE STRIP DETAIL FOR SHOULDER 4.5' OR MORE

STATE OF HAWAII

DEPARTMENT OF TRANSPORTATION

HIGHWAYS DIVISION

HONOLULU, HAWAII

"AS-BUILT"

PLANS FOR

KEAAU-PAHOA ROAD


INTERSECTION IMPROVEMENTS

AT AINALOA BOULEVARD

FEDERAL AID PROJECT NO. HSIP-0130(30)

DISTRICT OF PUNA

ISLAND OF HAWAII


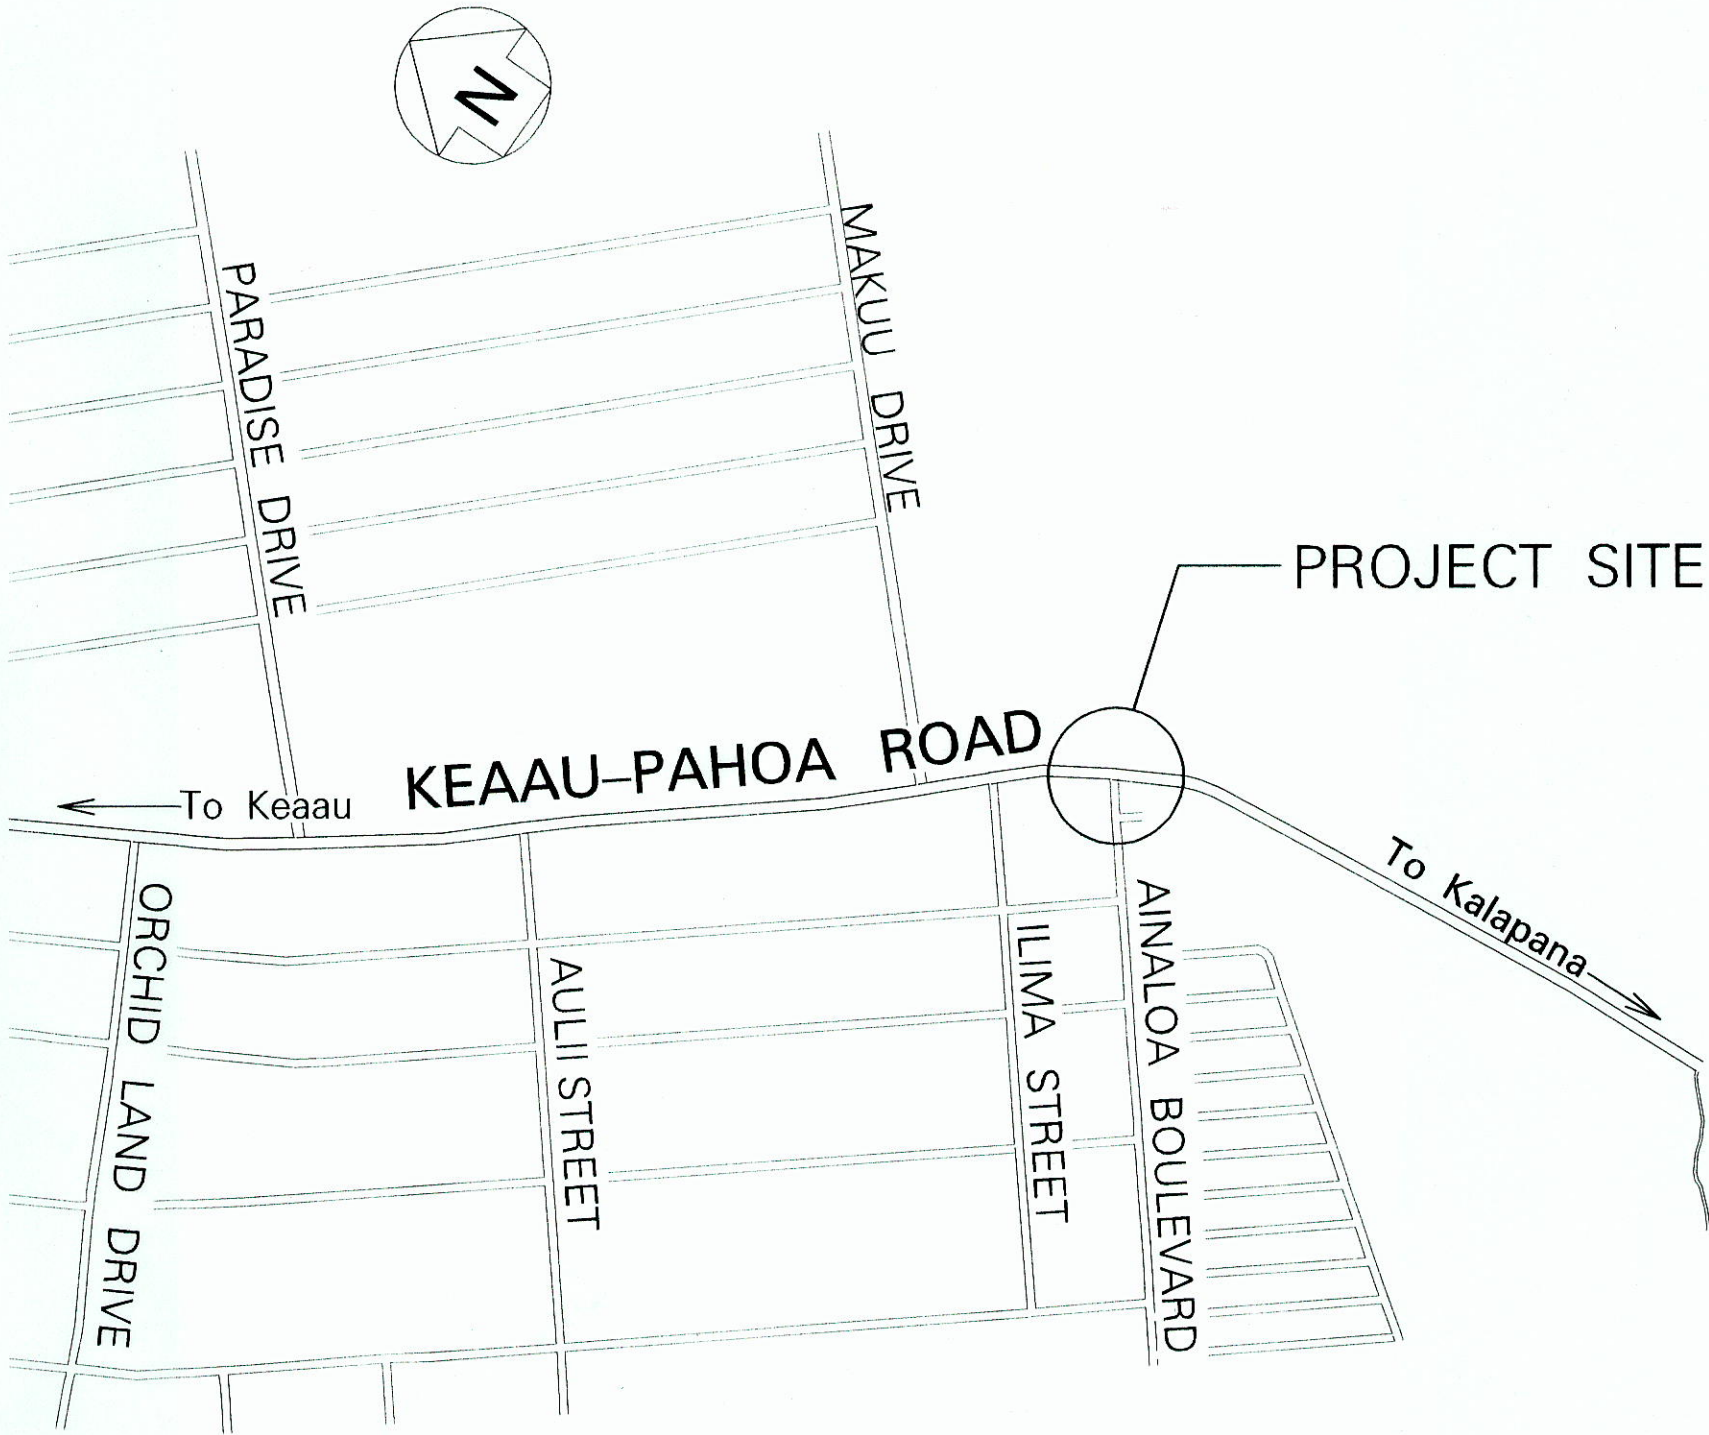


LAYOUT PLAN

GROSS LENGTH OF PROJECT..... 0.38 MILES

NET LENGTH OF PROJECT..... 0.38 MILES

FED. ROAD DIST. NO.	STATE	FED. AID PROJ. NO.	FISCAL YEAR	SHEET NO.	TOTAL SHEETS
HAWAII	HAW	HSIP-0130(30)	2011	ADD.1	13

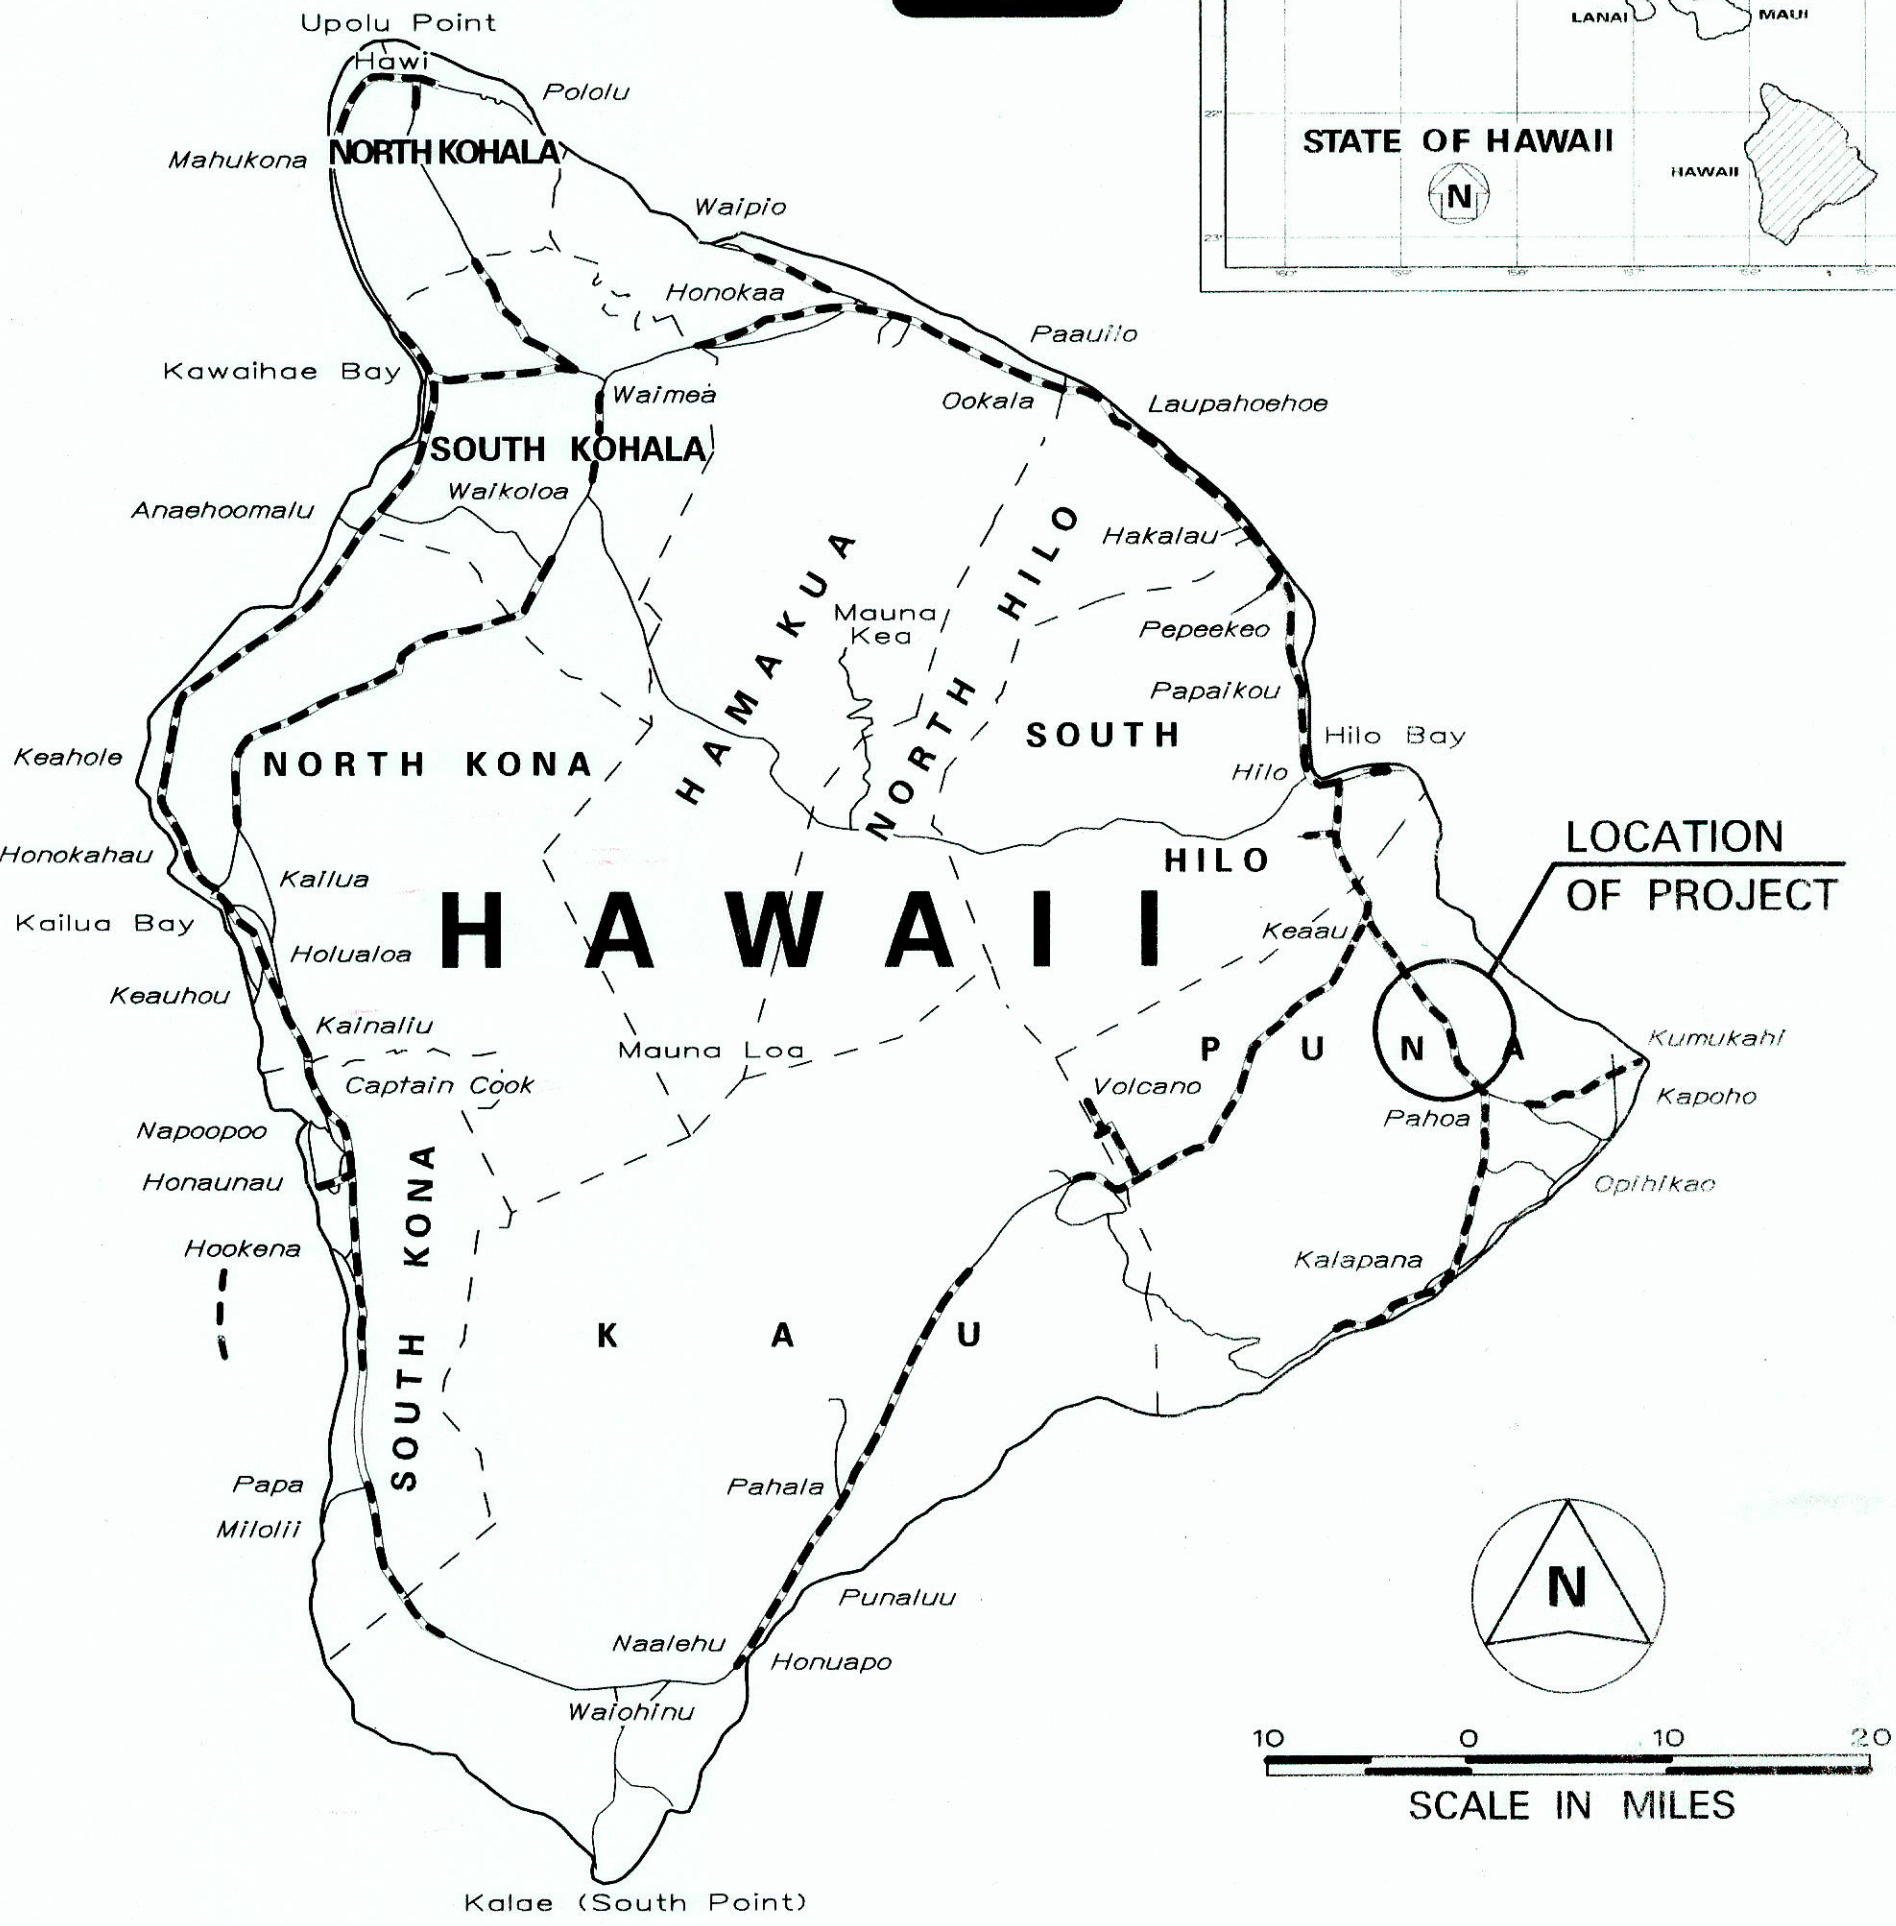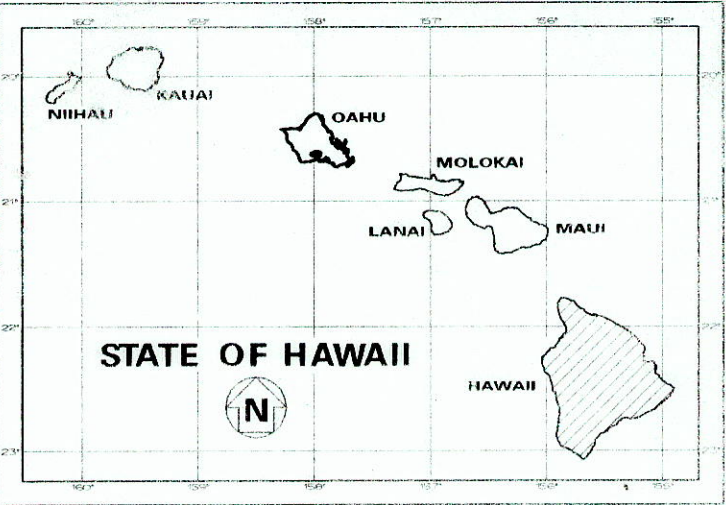

FEDERAL AID PROJECTS PREVIOUSLY CONSTRUCTED OR UNDER CONSTRUCTION

MILE POST 7.53 TO MILE POST 7.91

DESIGN DESIGNATION

ADT (2011).....20,300

ADT (2013).....23,100

DHV.....1,850

D.....65/35

T.....2.5%

V.....60 MPH

1/17/12	△ ADDED DESIGN DESIGNATION
DATE	REVISION
DEPARTMENT OF TRANSPORTATION STATE OF HAWAII	
APPROVED:	
<i>Ami A. J. J.</i>	12/16/11
for DIR. OF TRANSPORTATION	DATE

CHANGES MADE DURING CONSTRUCTION HAVE BEEN INCORPORATED ON THESE PLANS EXCEPT CHANGES IN THE ORIGINAL THEORETICAL QUANTITIES. FOR ACTUAL QUANTITIES, REFER TO PROJECT LEDGER AND/OR COMPUTATION BOOK.

Angie H. J. 9/10/13

RESIDENT ENGINEER DATE

MAR. 2011

DATE

692-7570

PHONE

HWY-DD

MANAGED BY:

HWY-D

DESIGNED BY