




FED. ROAD DIST. NO.	STATE	FED. AID PROJ. NO.	FISCAL YEAR	SHEET NO.	TOTAL SHEETS
HAWAII	HAW.	HSIP-0130(031)	2014	50	108

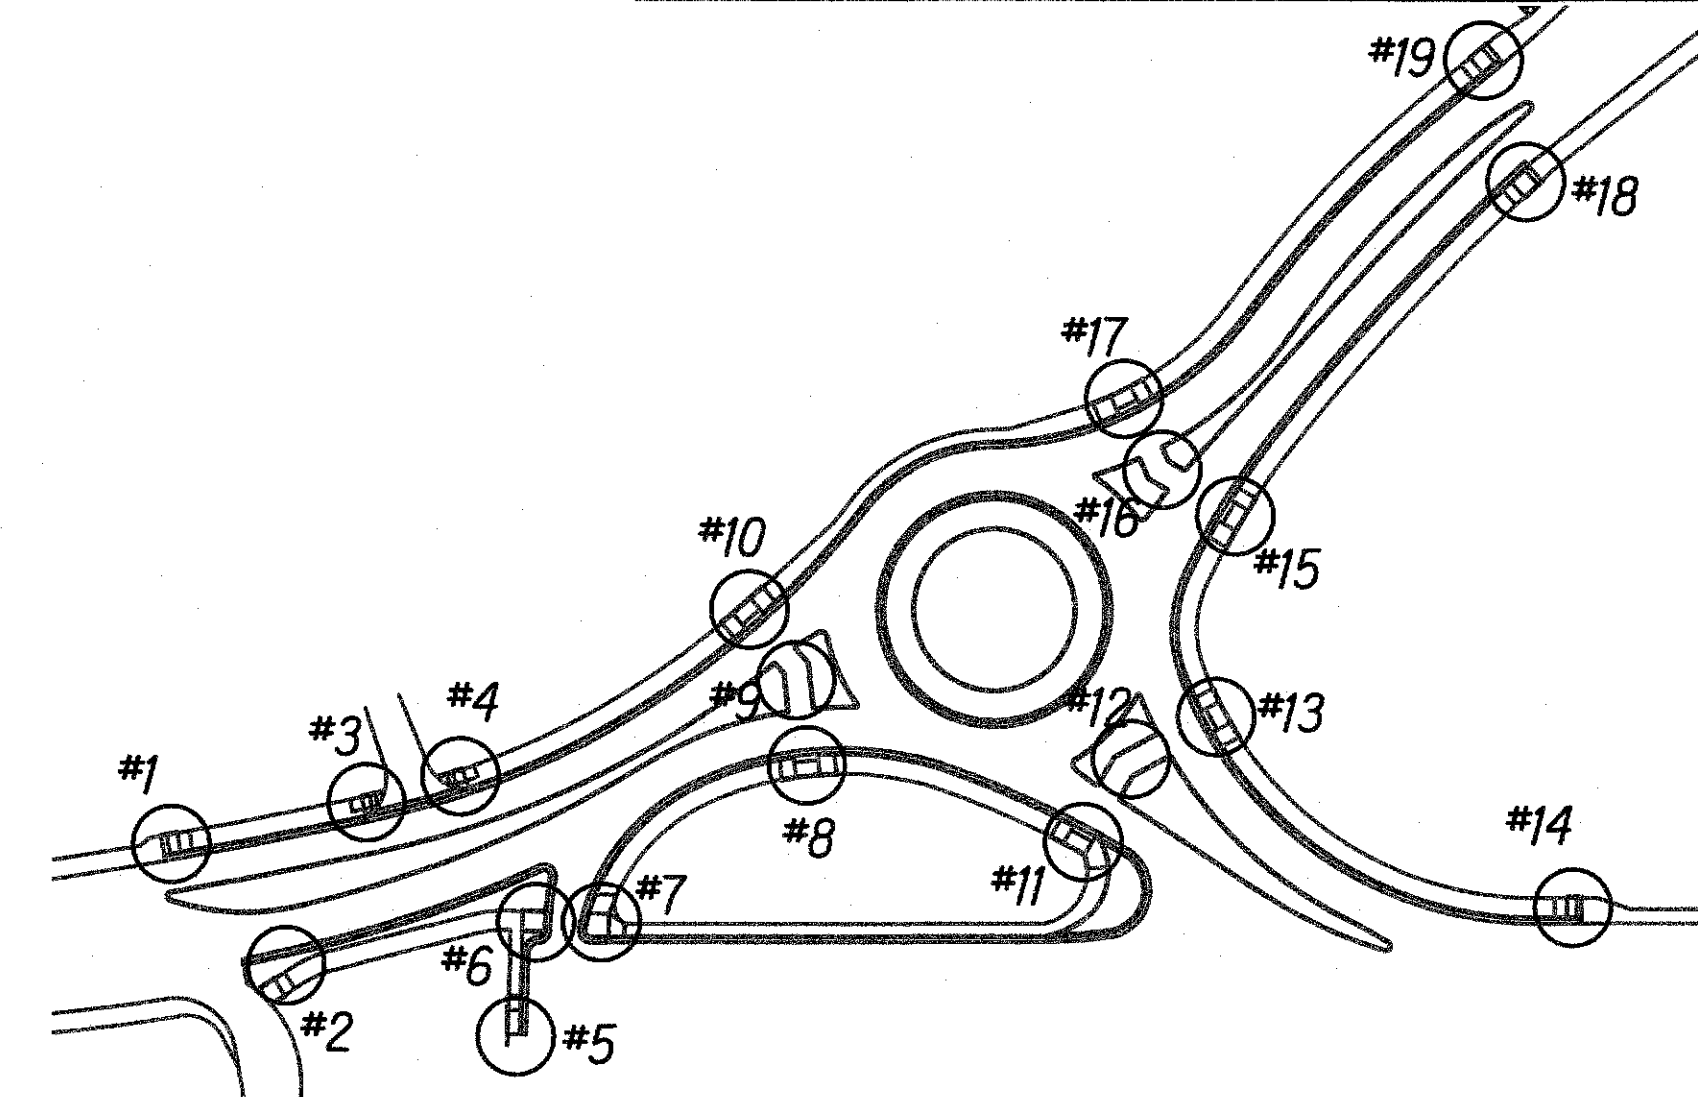


CURB RAMP NUMBER KEY MAP
Scale: 1" = 80'

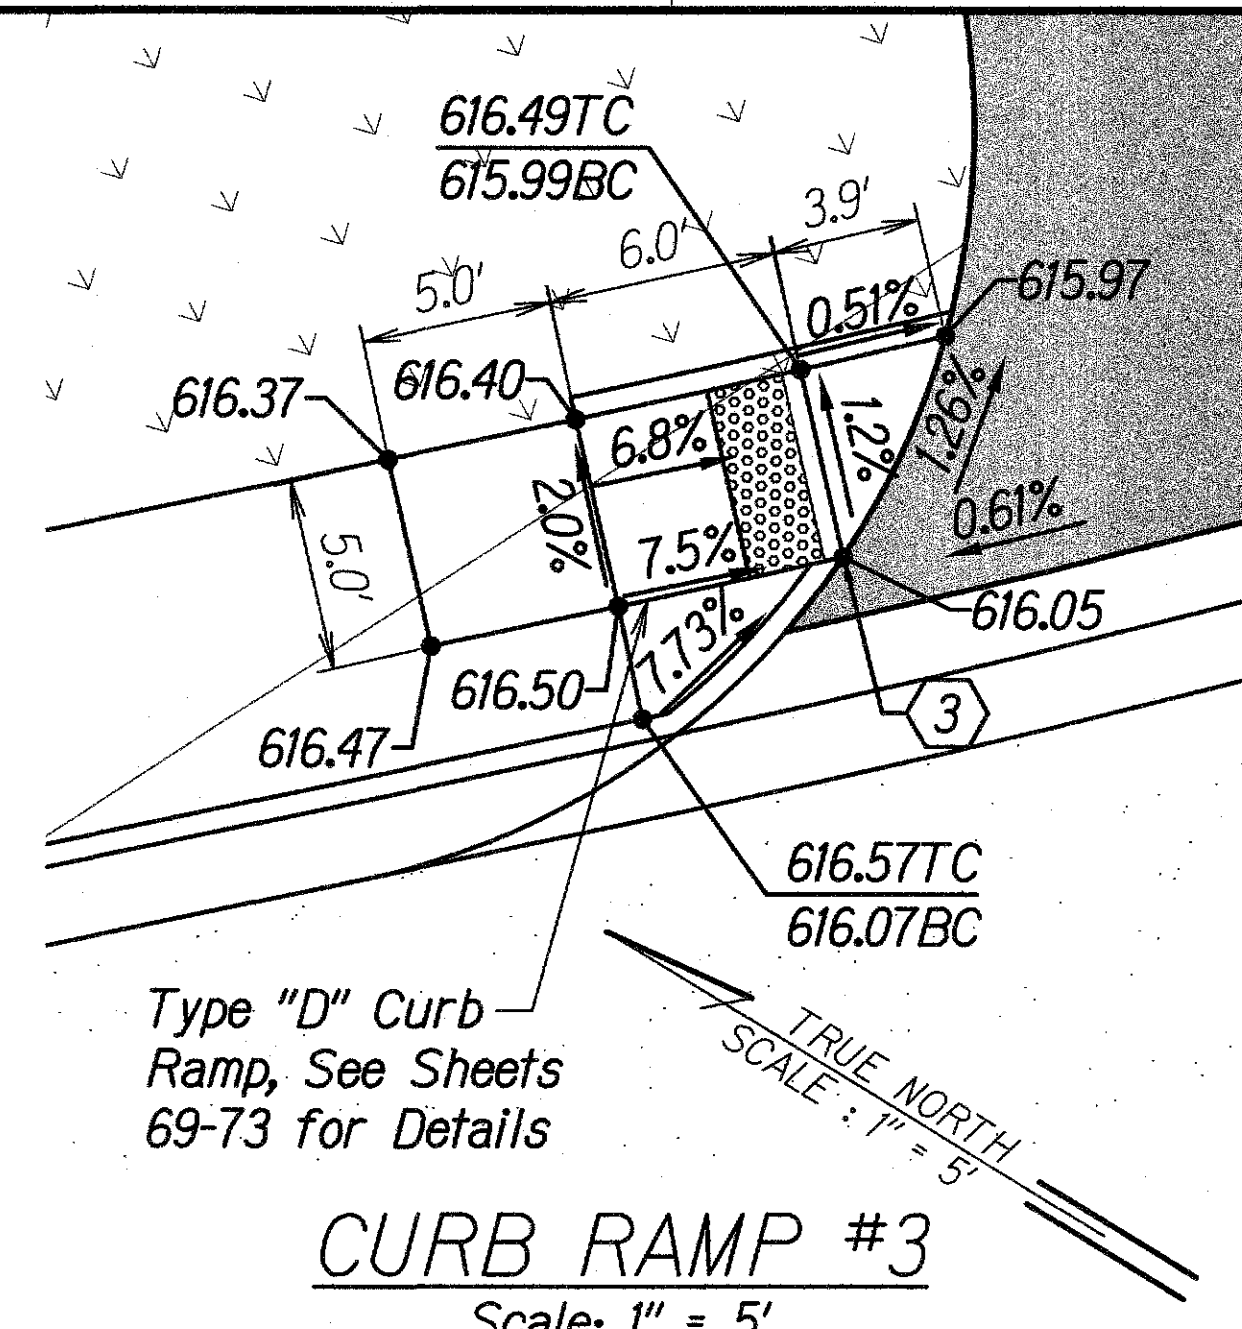


CURB RAMP #3
Scale: 1" = 5'

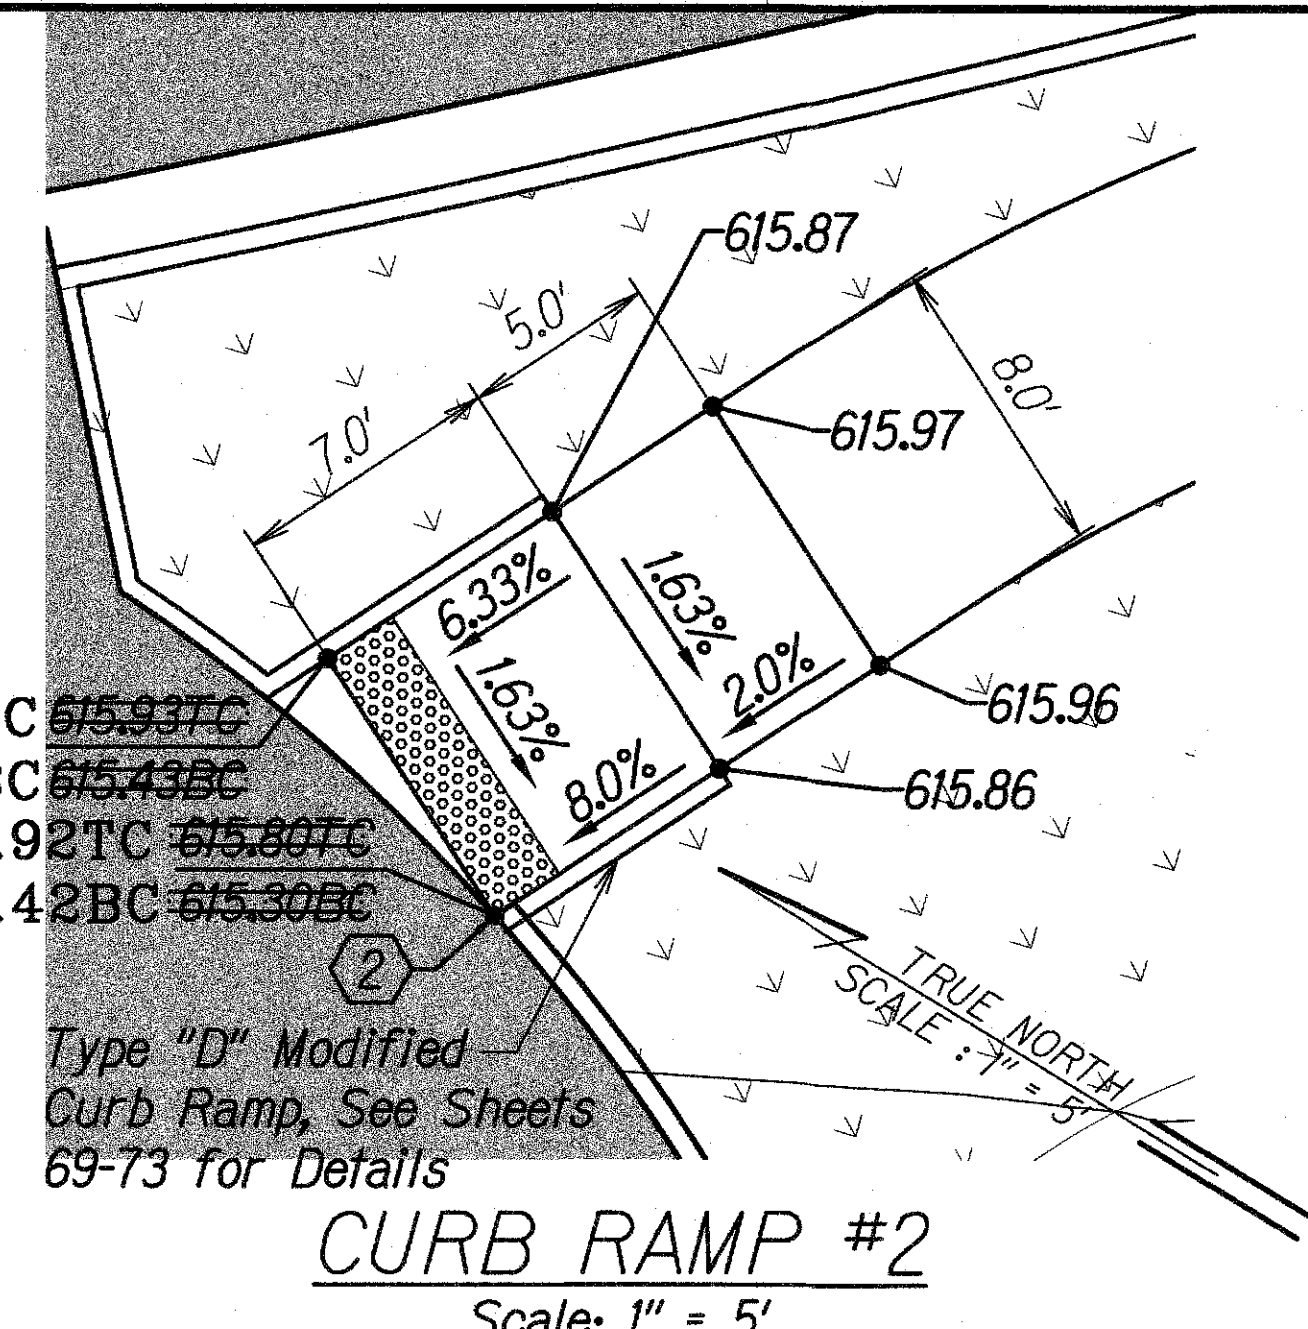


CURB RAMP #2
Scale: 1" = 5'

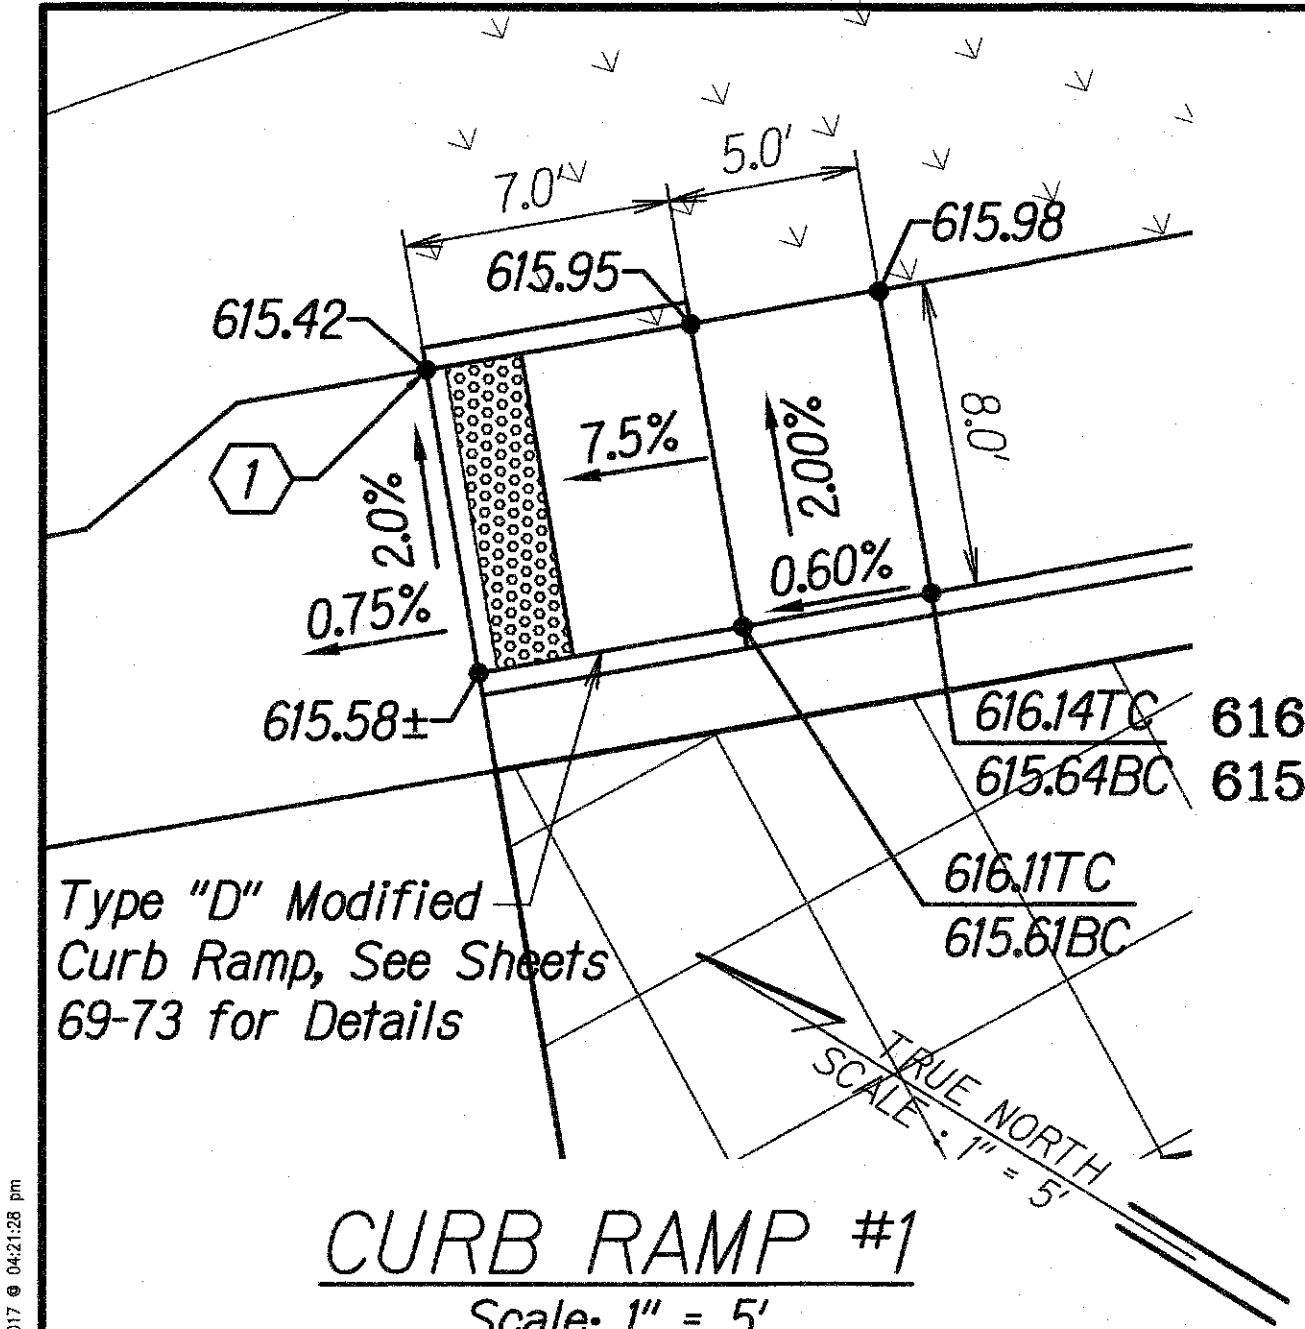


CURB RAMP #1
Scale: 1" = 5'

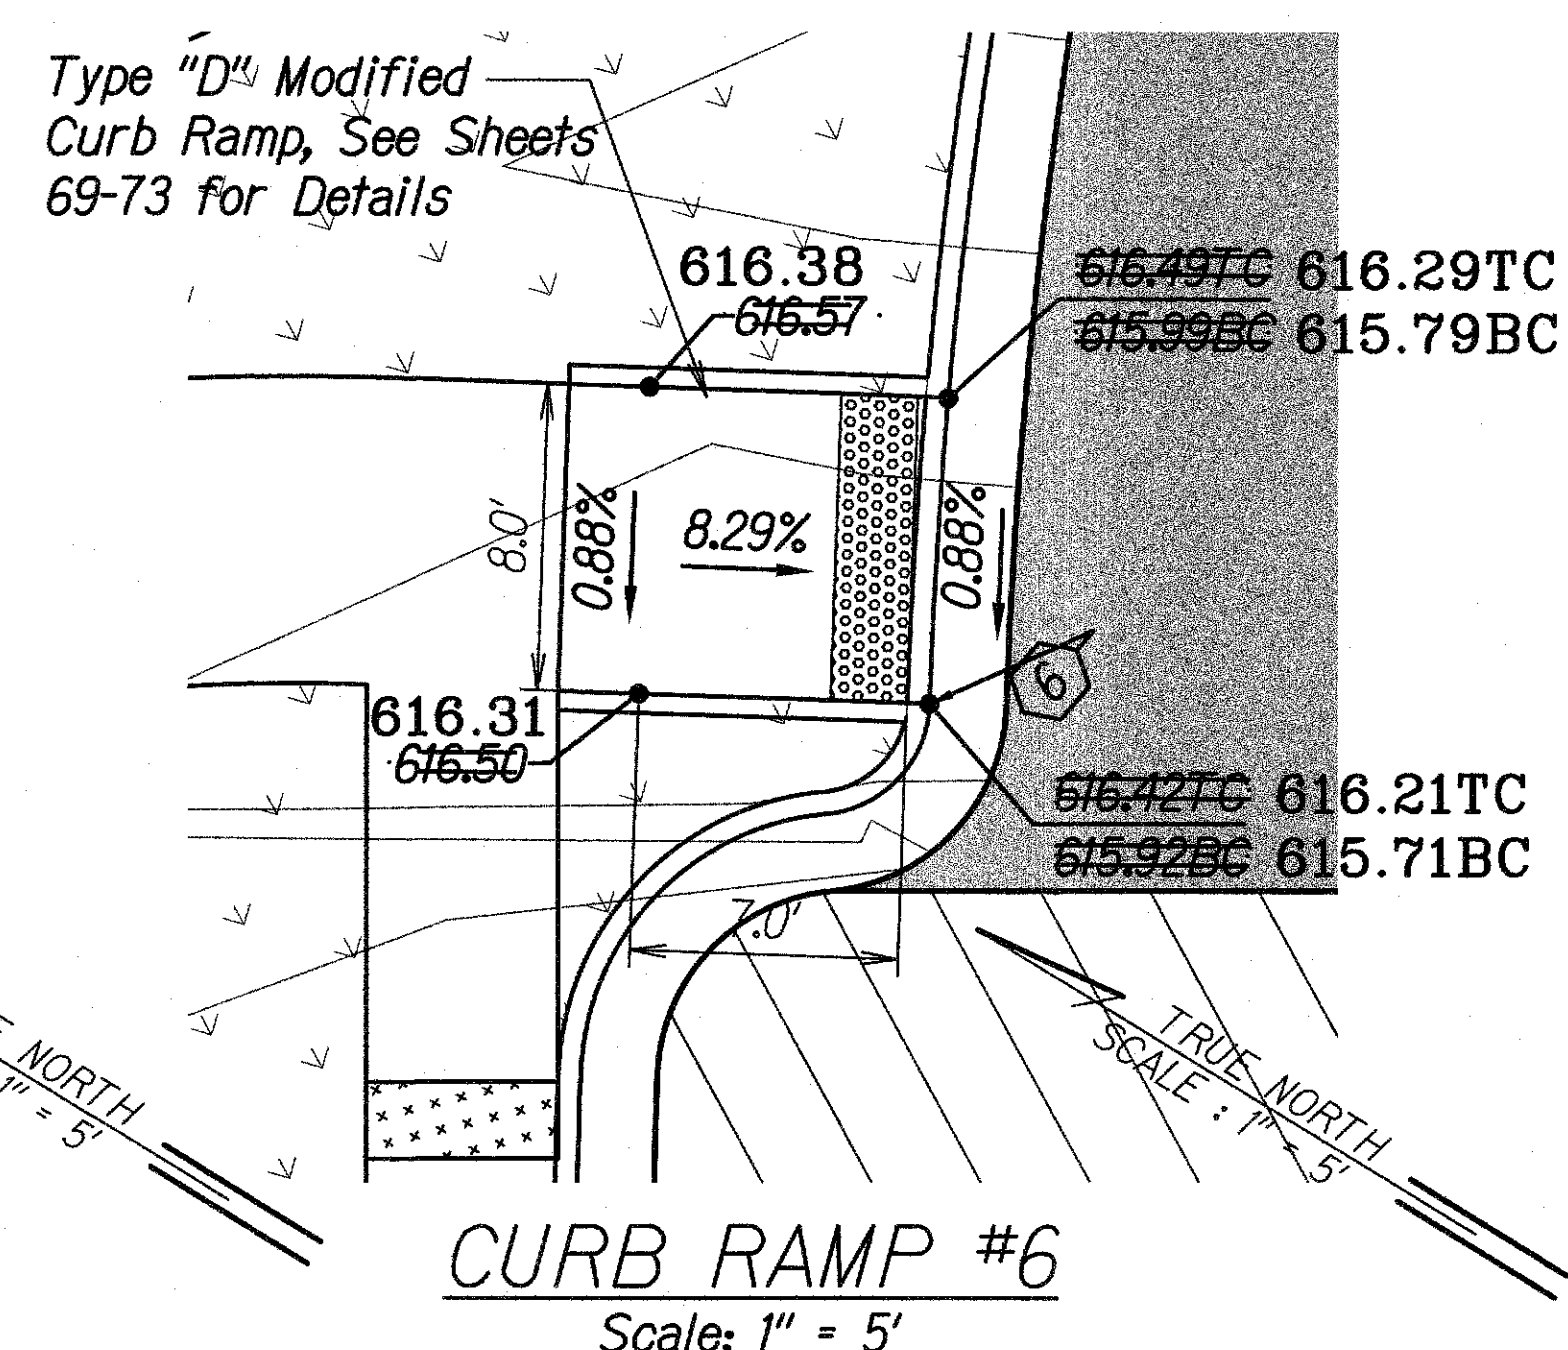

CURB RAMP #6
Scale: 1" = 5'

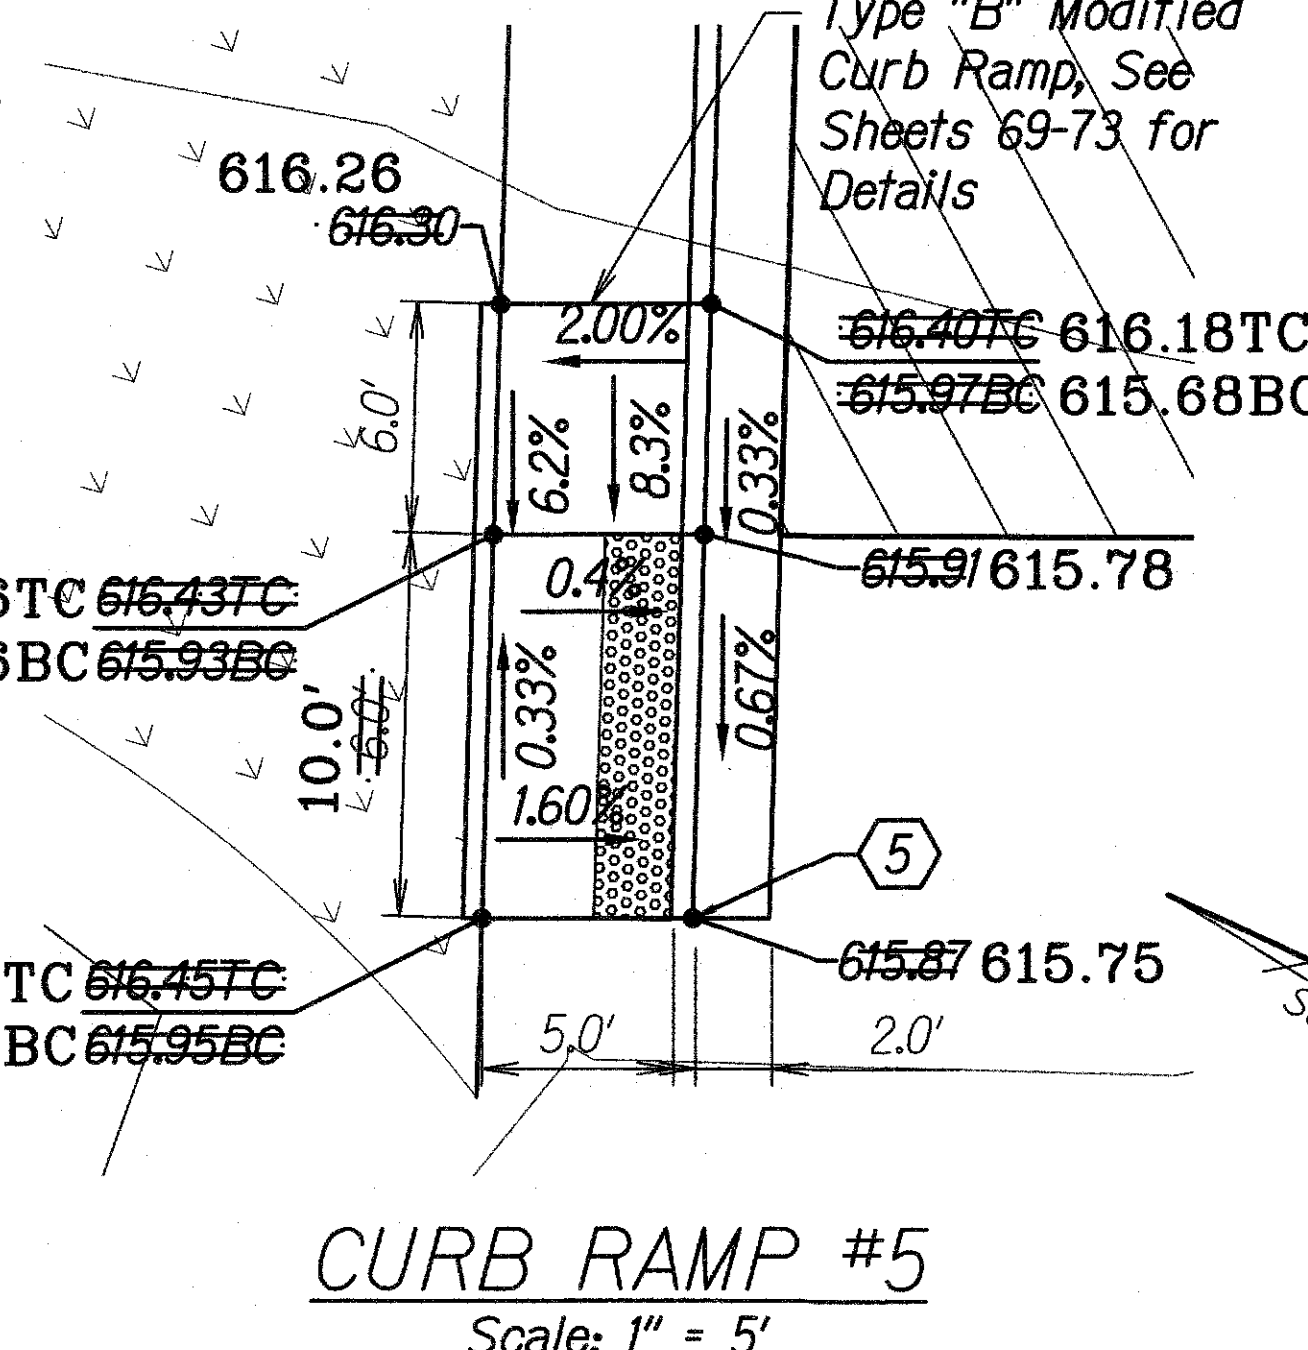

CURB RAMP #5
Scale: 1" = 5'

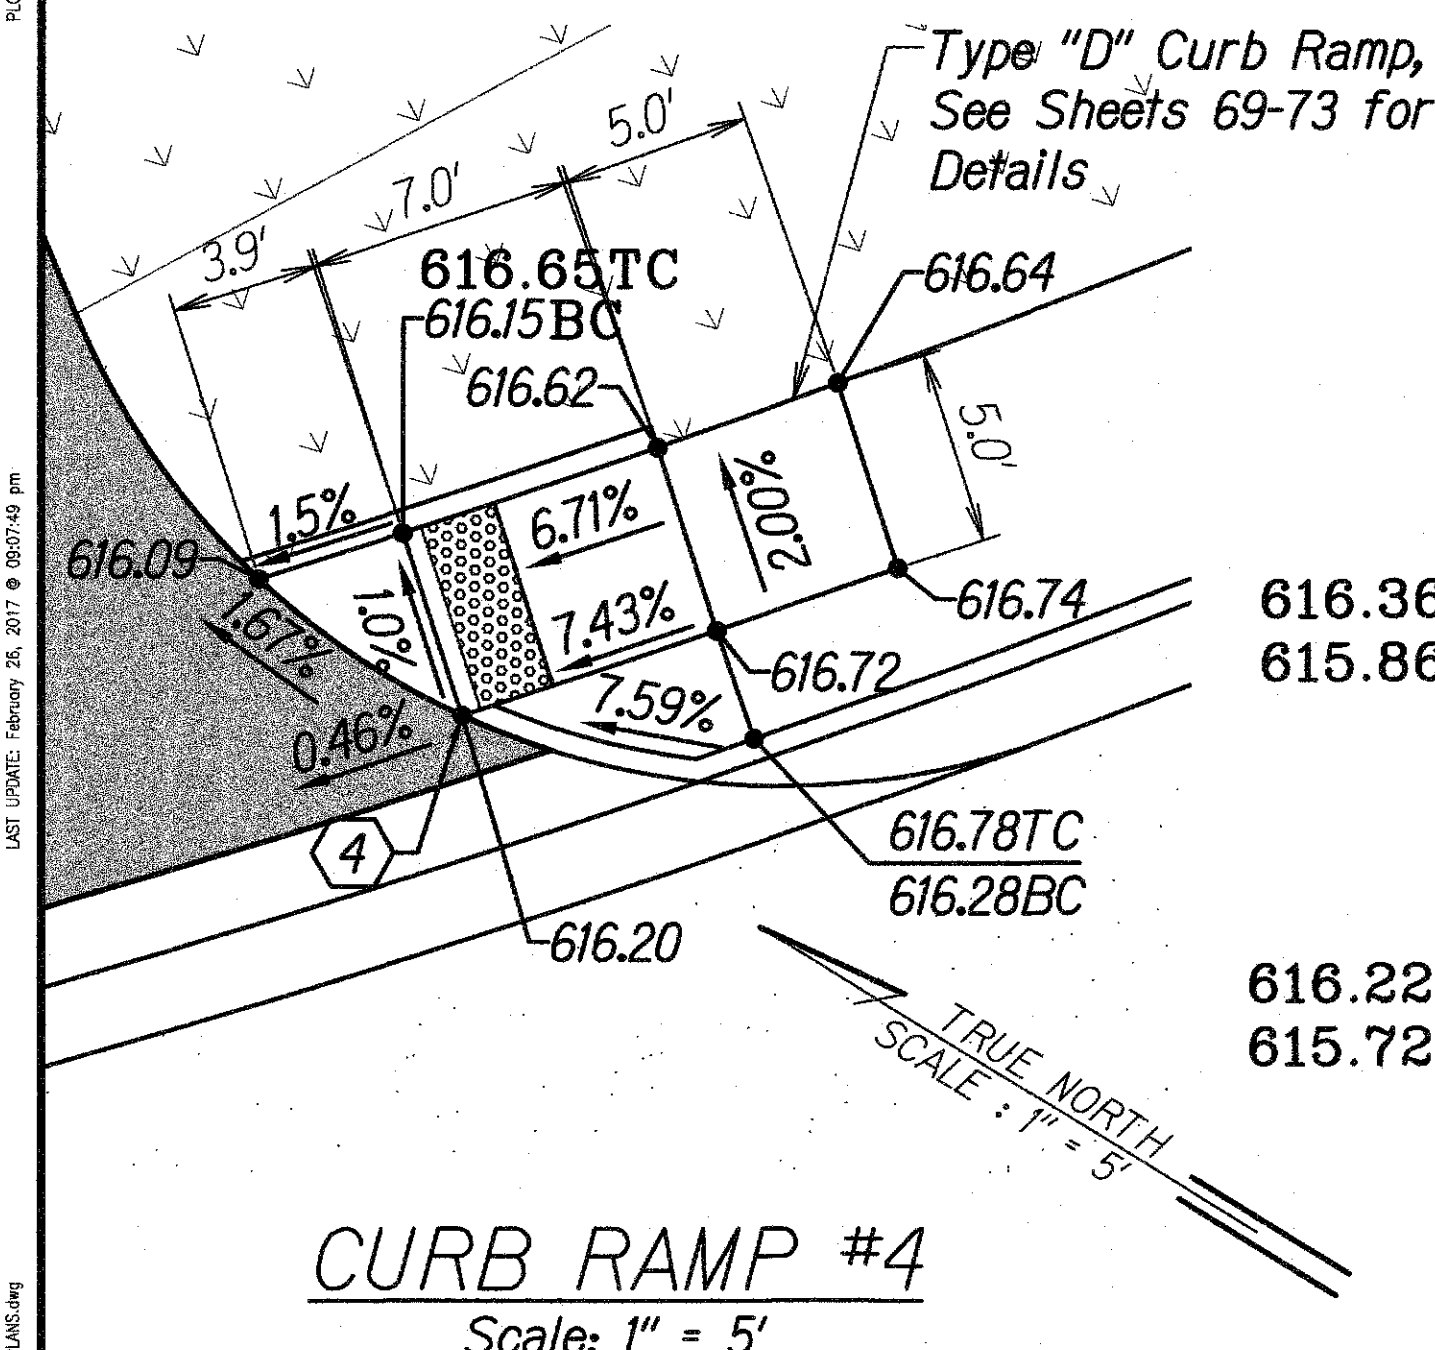

CURB RAMP #4
Scale: 1" = 5'

COORDINATE TABLE			
Point	Northing	Easting	Description
①	243595.34	1827464.37	North Corner, Bottom Curb
②	243519.65	1827428.40	West Corner, Bottom Curb
③	243524.66	1827522.37	South Corner, Bottom Curb
④	243503.21	1827545.28	West Corner, Bottom Curb
⑤	243424.23	1827472.52	West Corner, Bottom Curb
⑥	243437.94	1827514.24	South Corner, Bottom Curb

LEGEND FOR AS-BUILT POSTINGS

Squiggly line for as-built deletion
 Double line for as-built deletion
 Roadway
Text for as-built posting








ORIGINAL PLAN	DATE
SURVEY PLOTTED BY	
DRAWN BY	
DESIGNED BY	
NOTED BY	
CHECKED BY	
NO.	

LICENSE EXPIRES 4/30/18
 THIS WORK WAS PREPARED BY ME OR UNDER MY SUPERVISION

STATE OF HAWAII
 DEPARTMENT OF TRANSPORTATION
 HIGHWAYS DIVISION
ACCESSIBLE PLANS
 CURB RAMPS #1 - #6
 Keaau-Pahoa Road Intersection
 Improvements at Old Government Road
 Federal-Aid Project No. HSIP-0130(031)
 Scale: 1" = 5' Date: August 2013
 SHEET No. 1 OF 3 SHEETS

"AS-BUILT"

FED. ROAD DIST. NO.	STATE	FED. AID PROJ. NO.	FISCAL YEAR	SHEET NO.	TOTAL SHEETS
HAWAII	HAW.	HSIP-0130(031)	2014	51	108

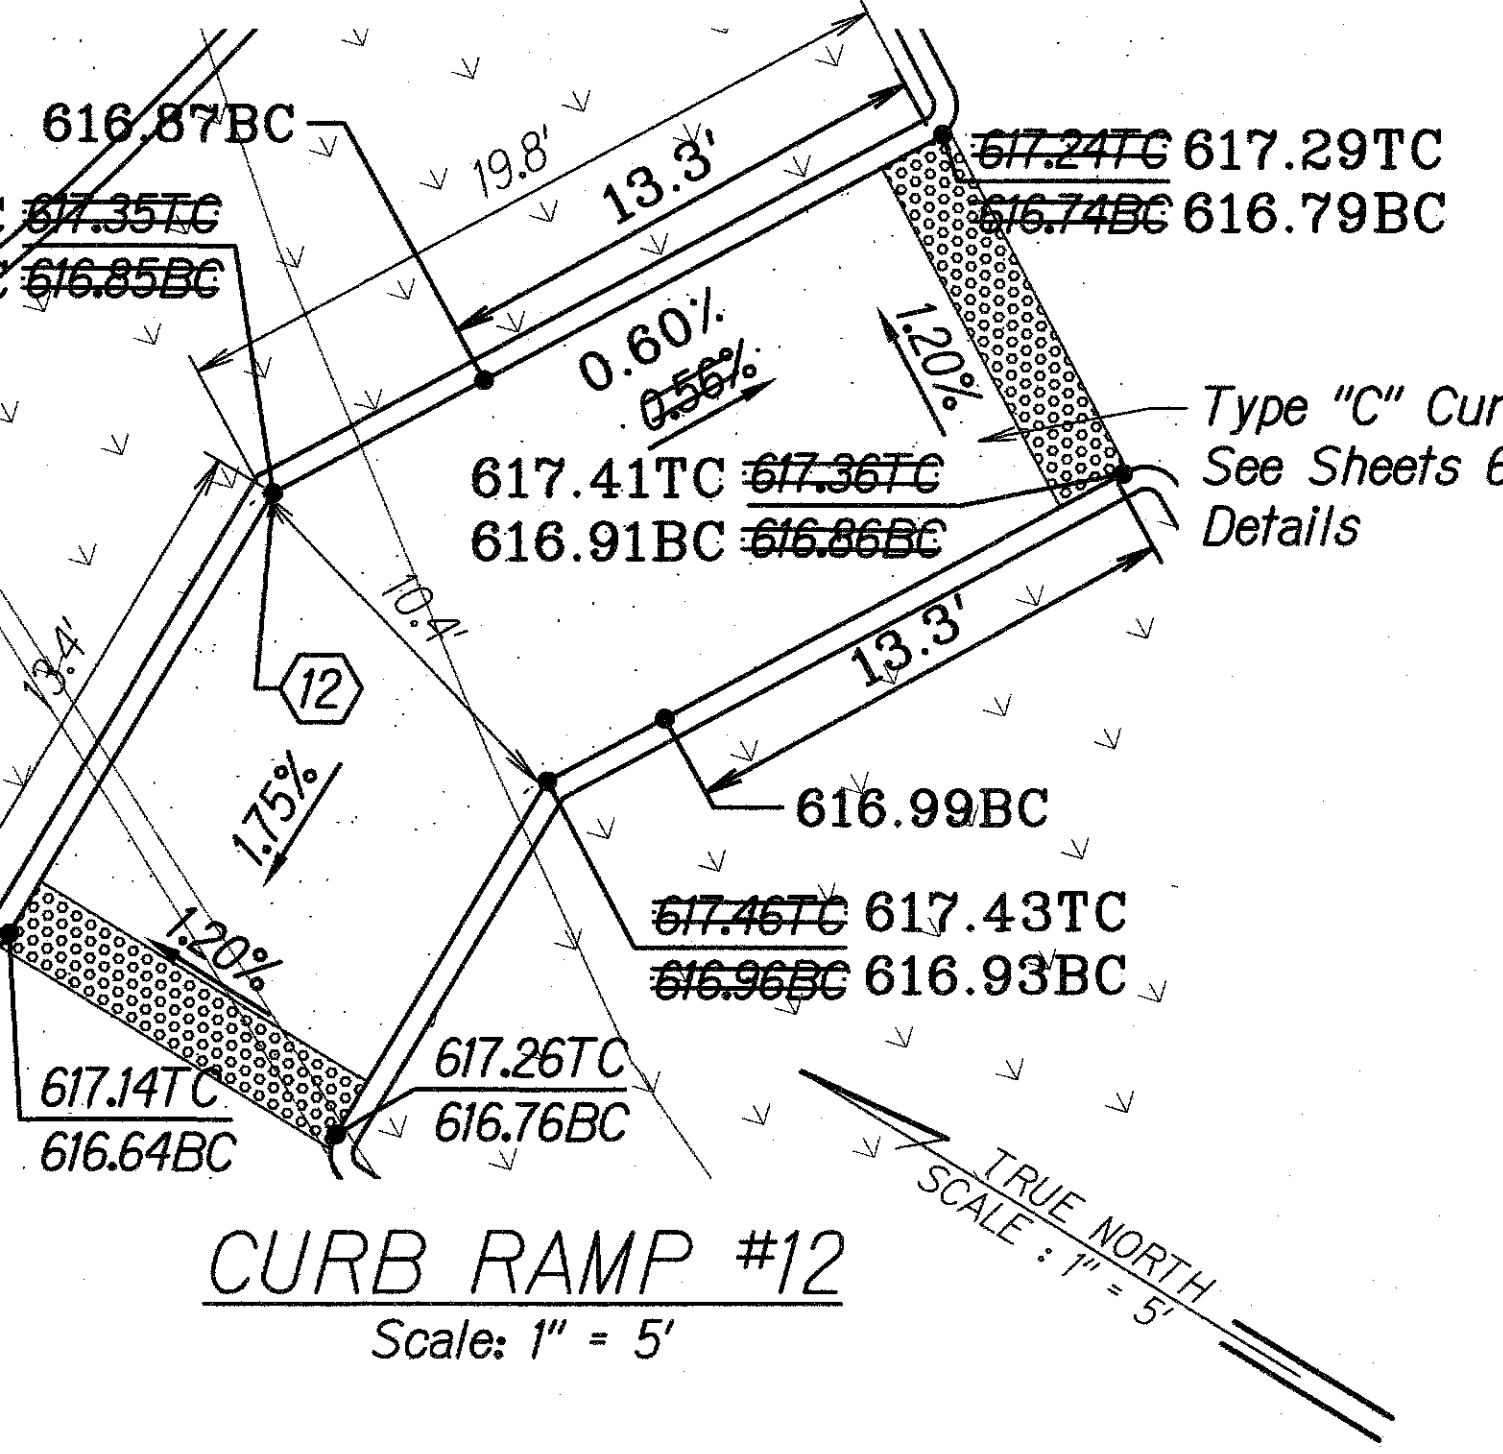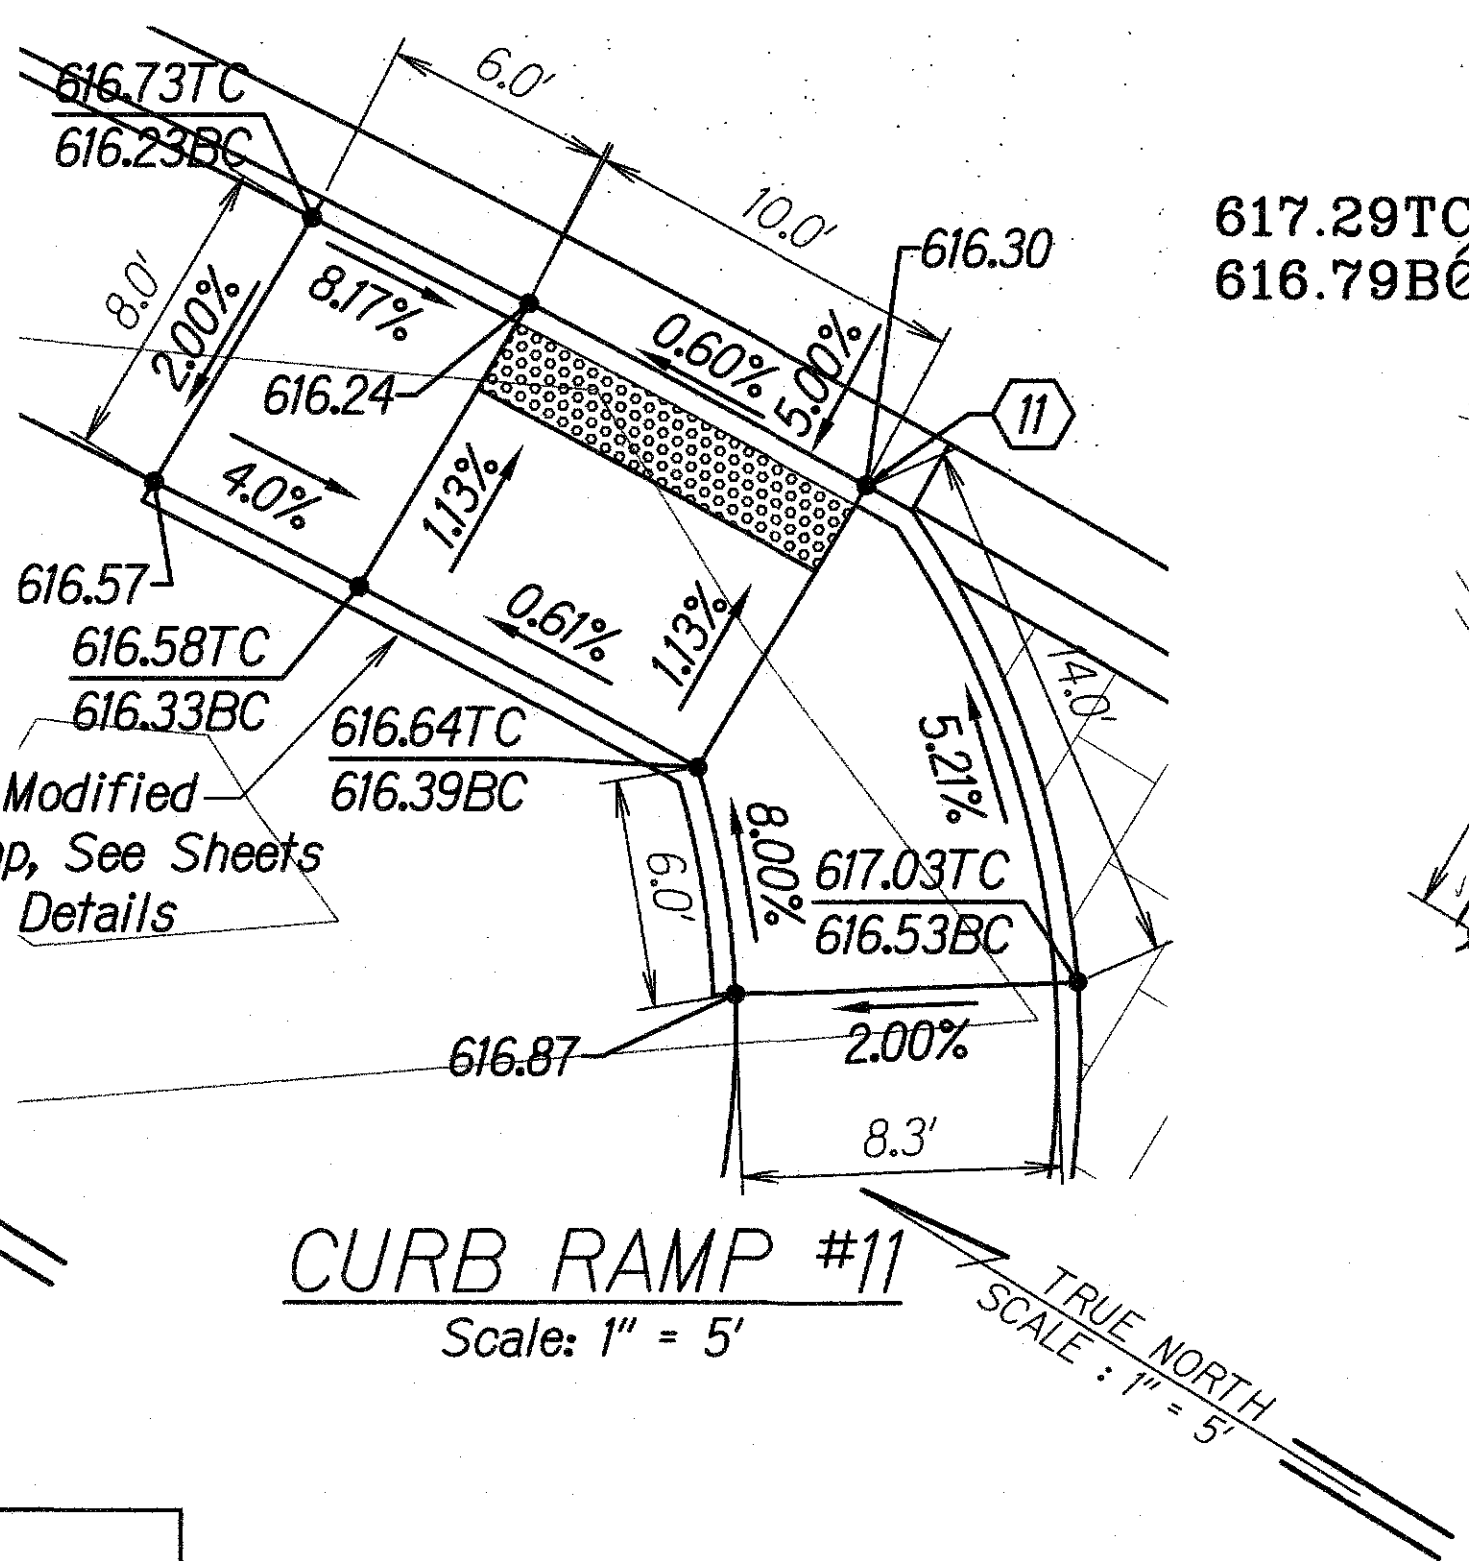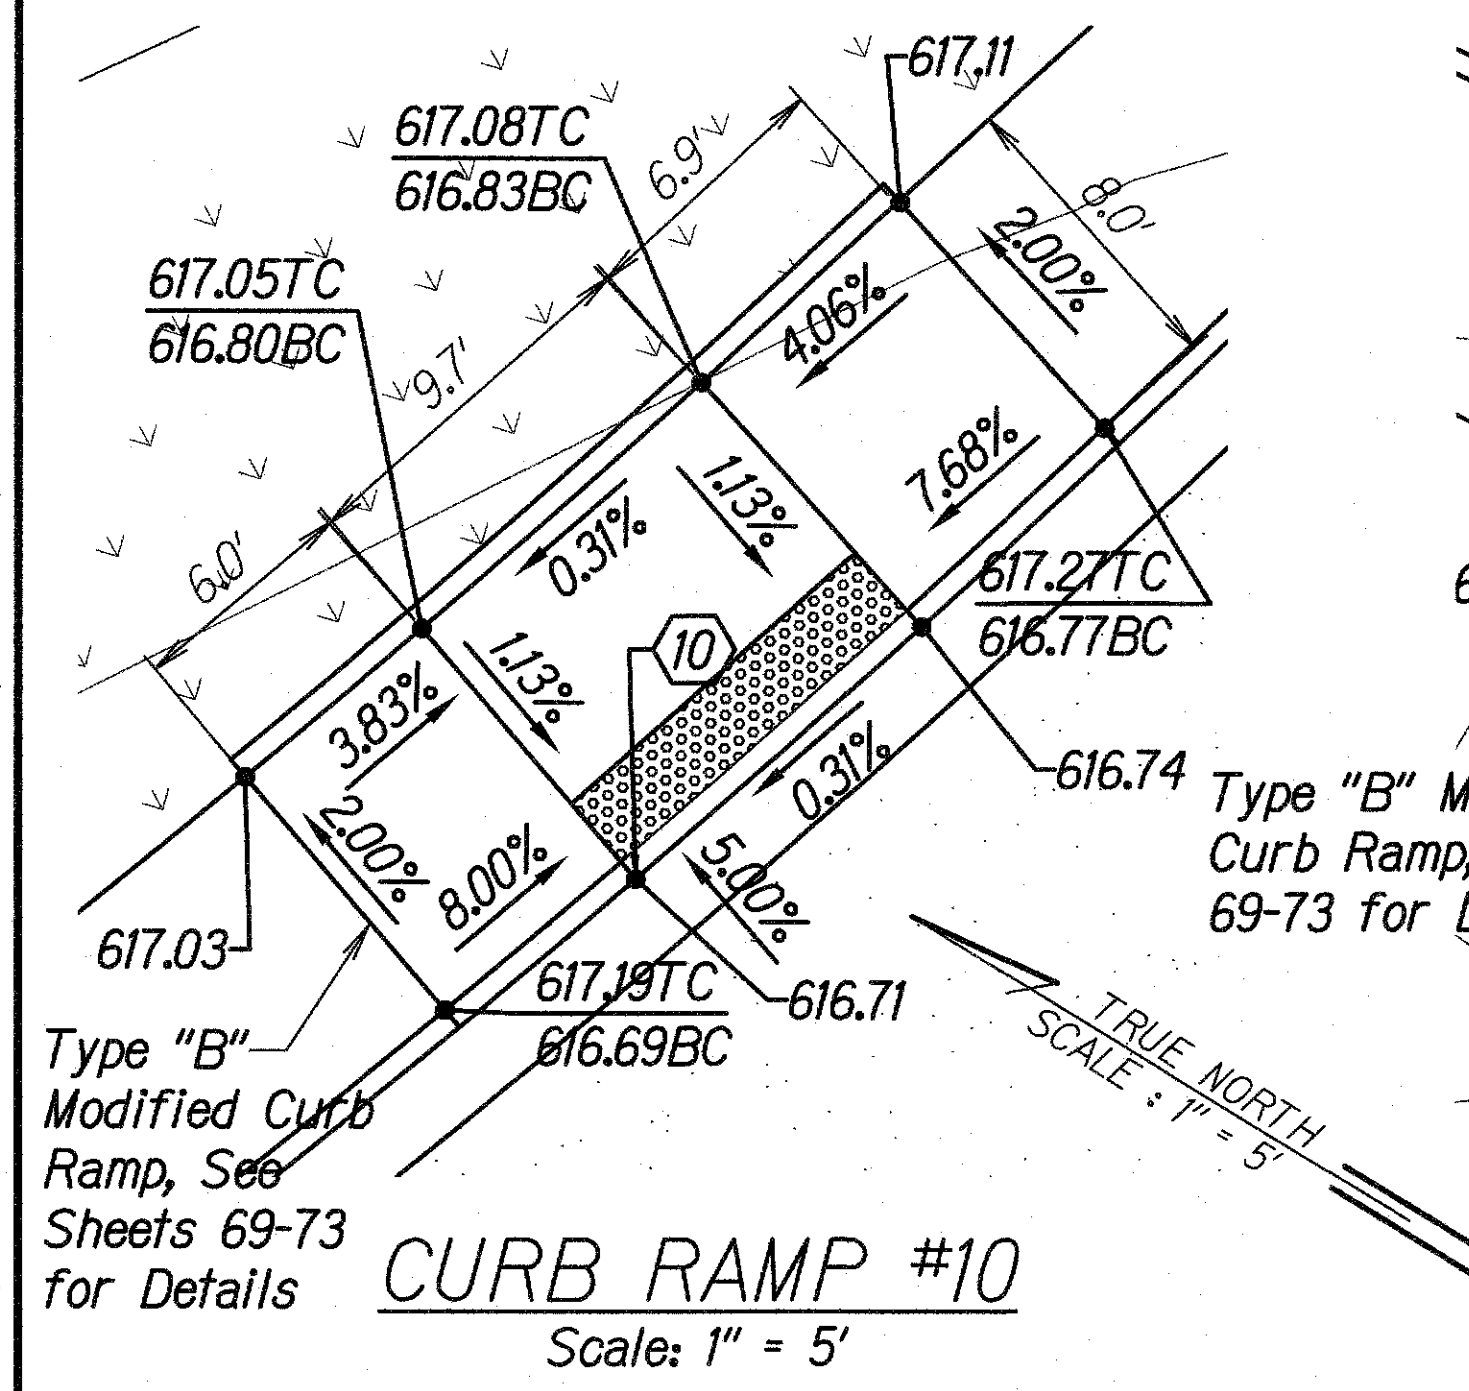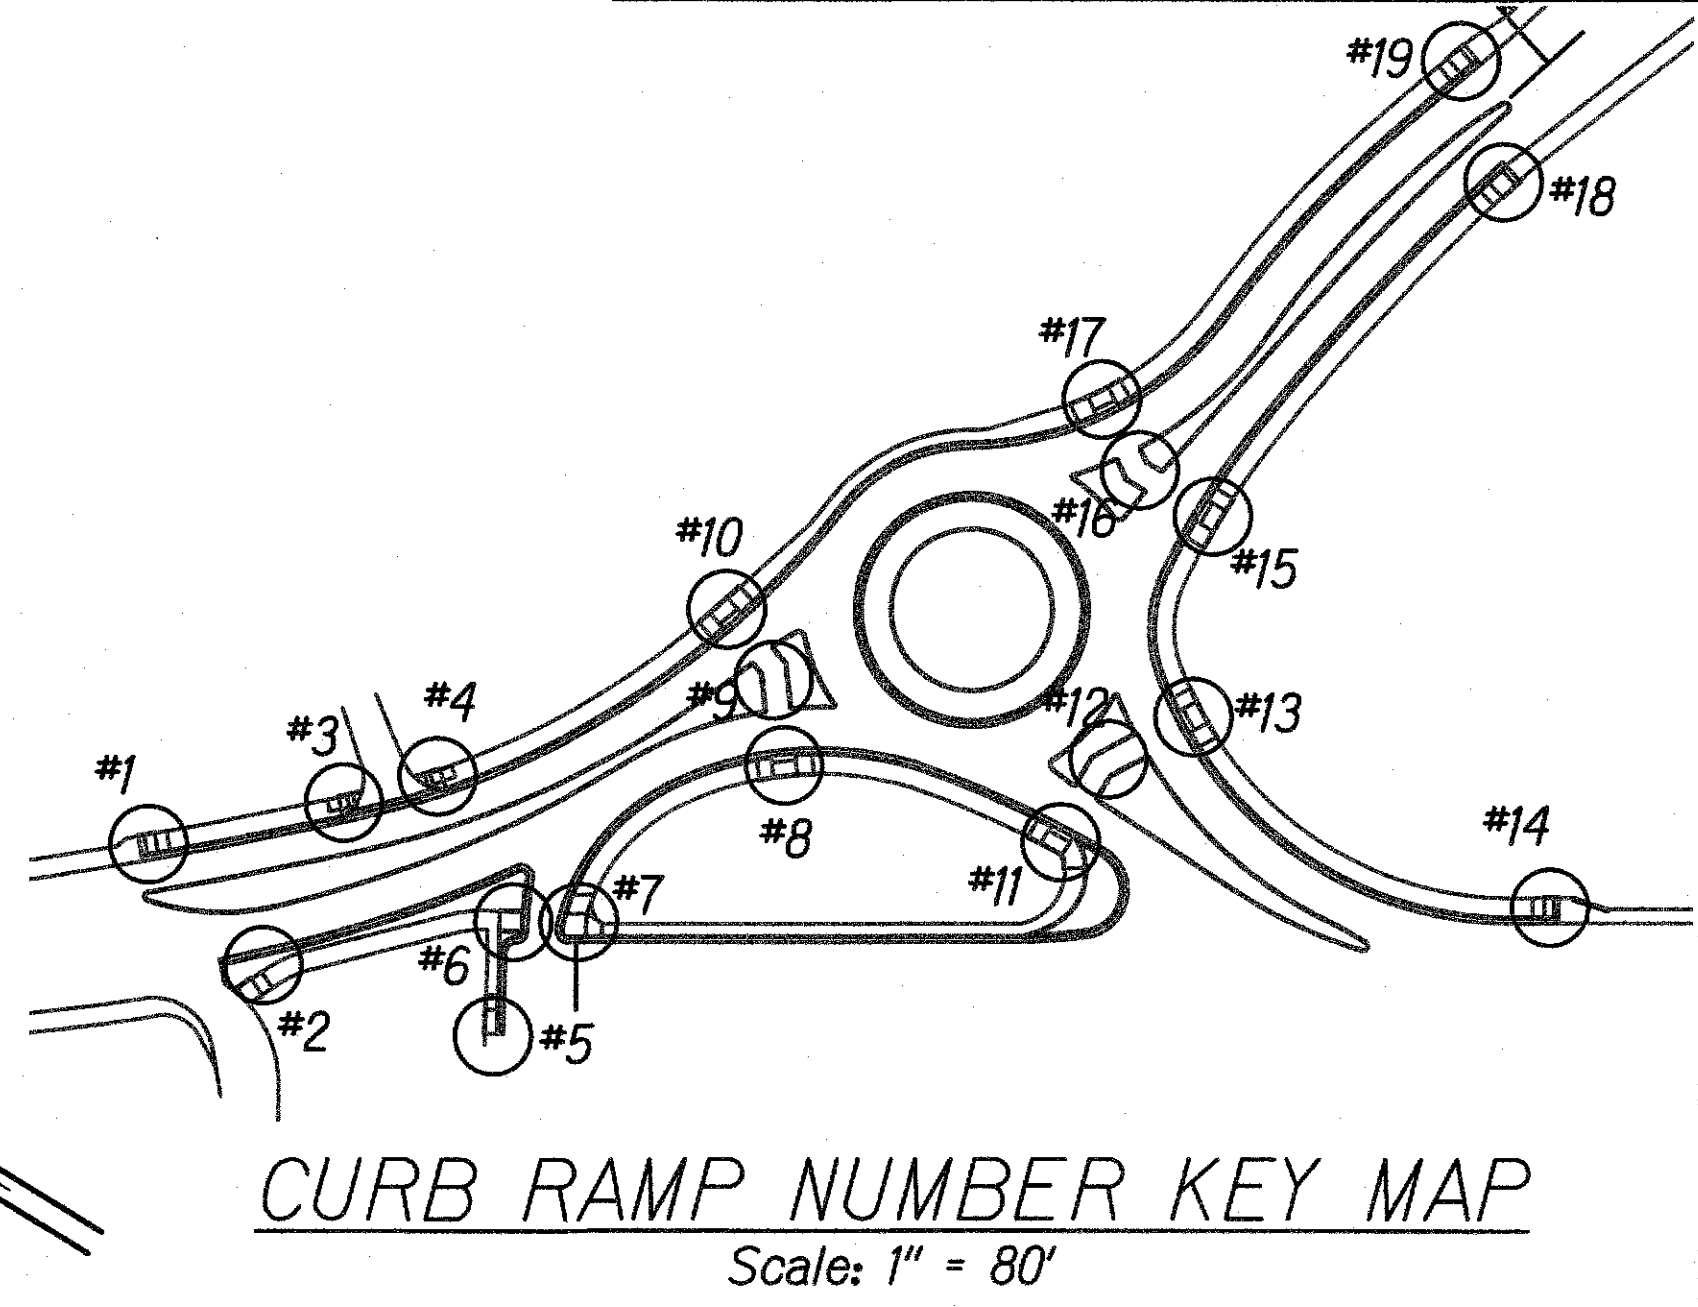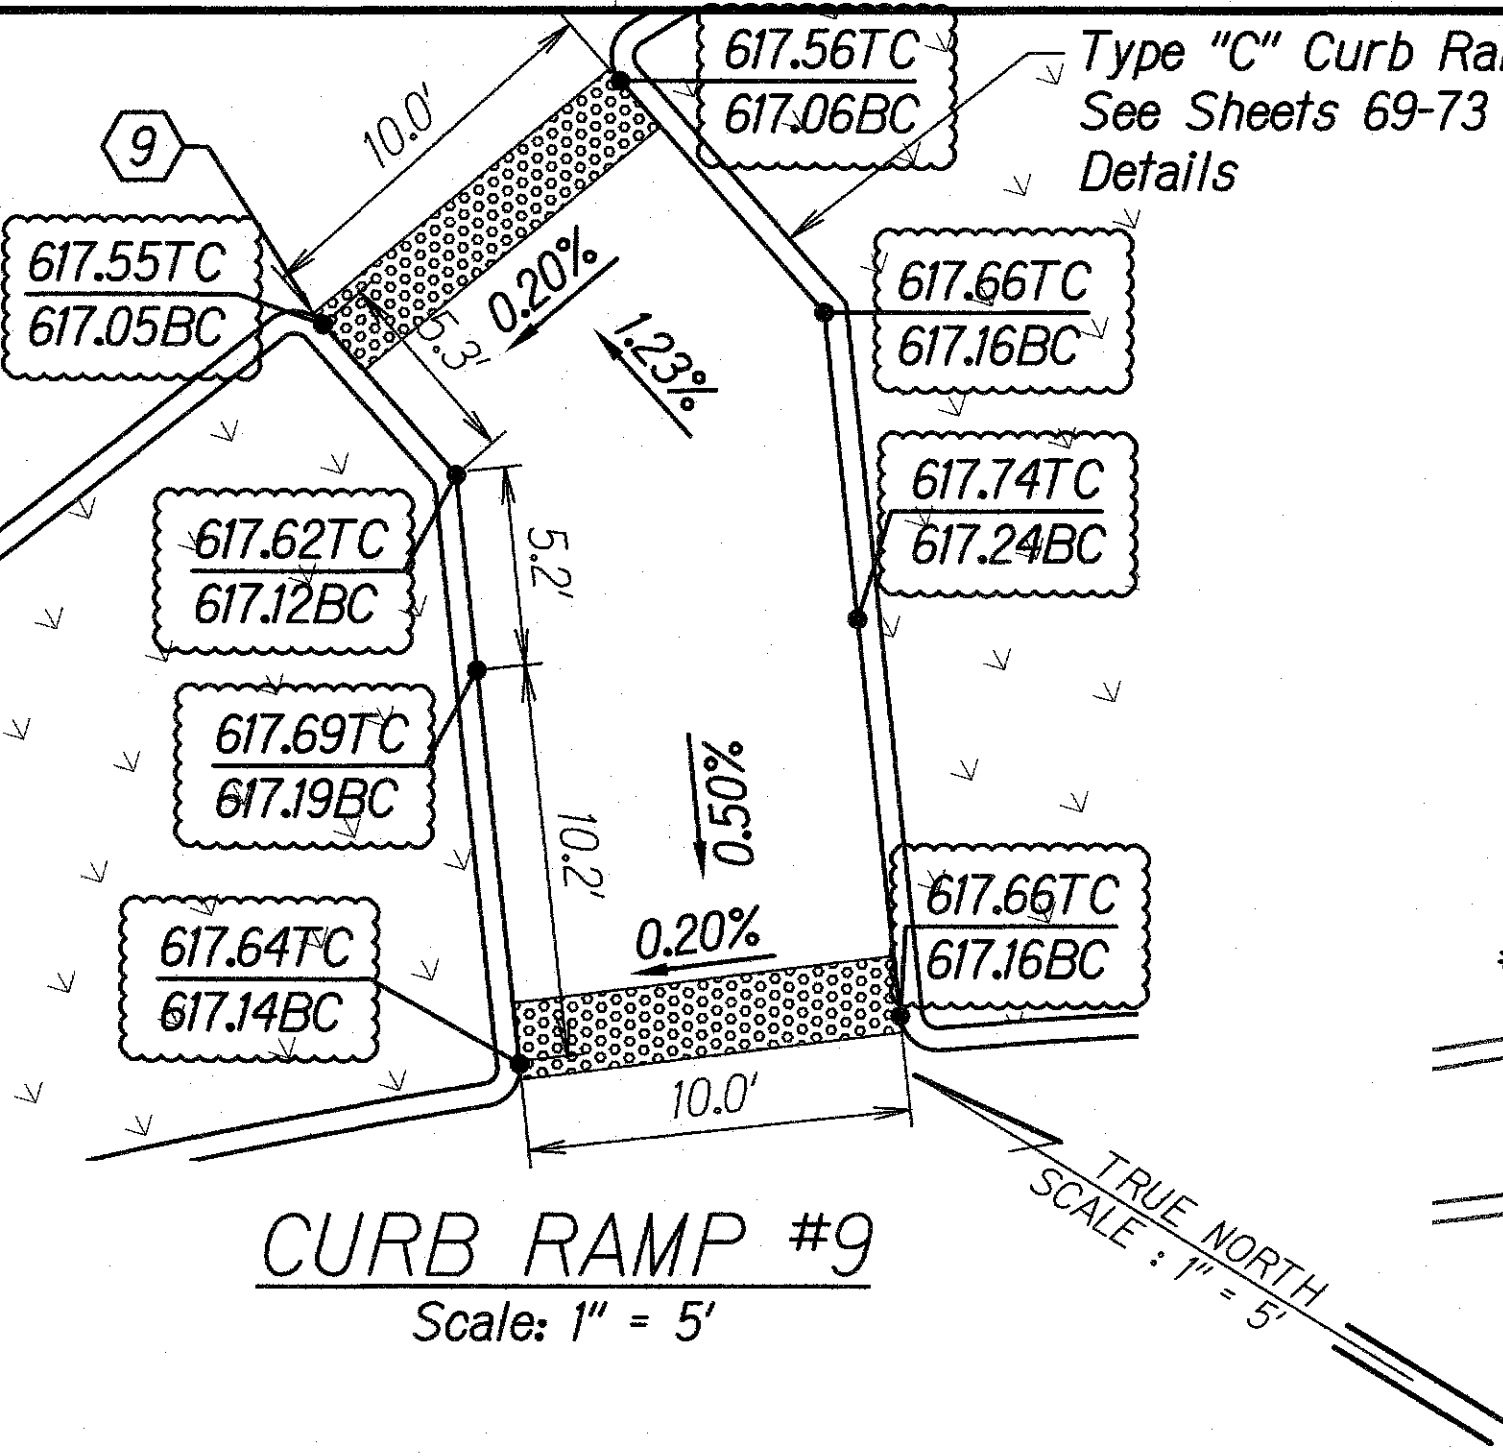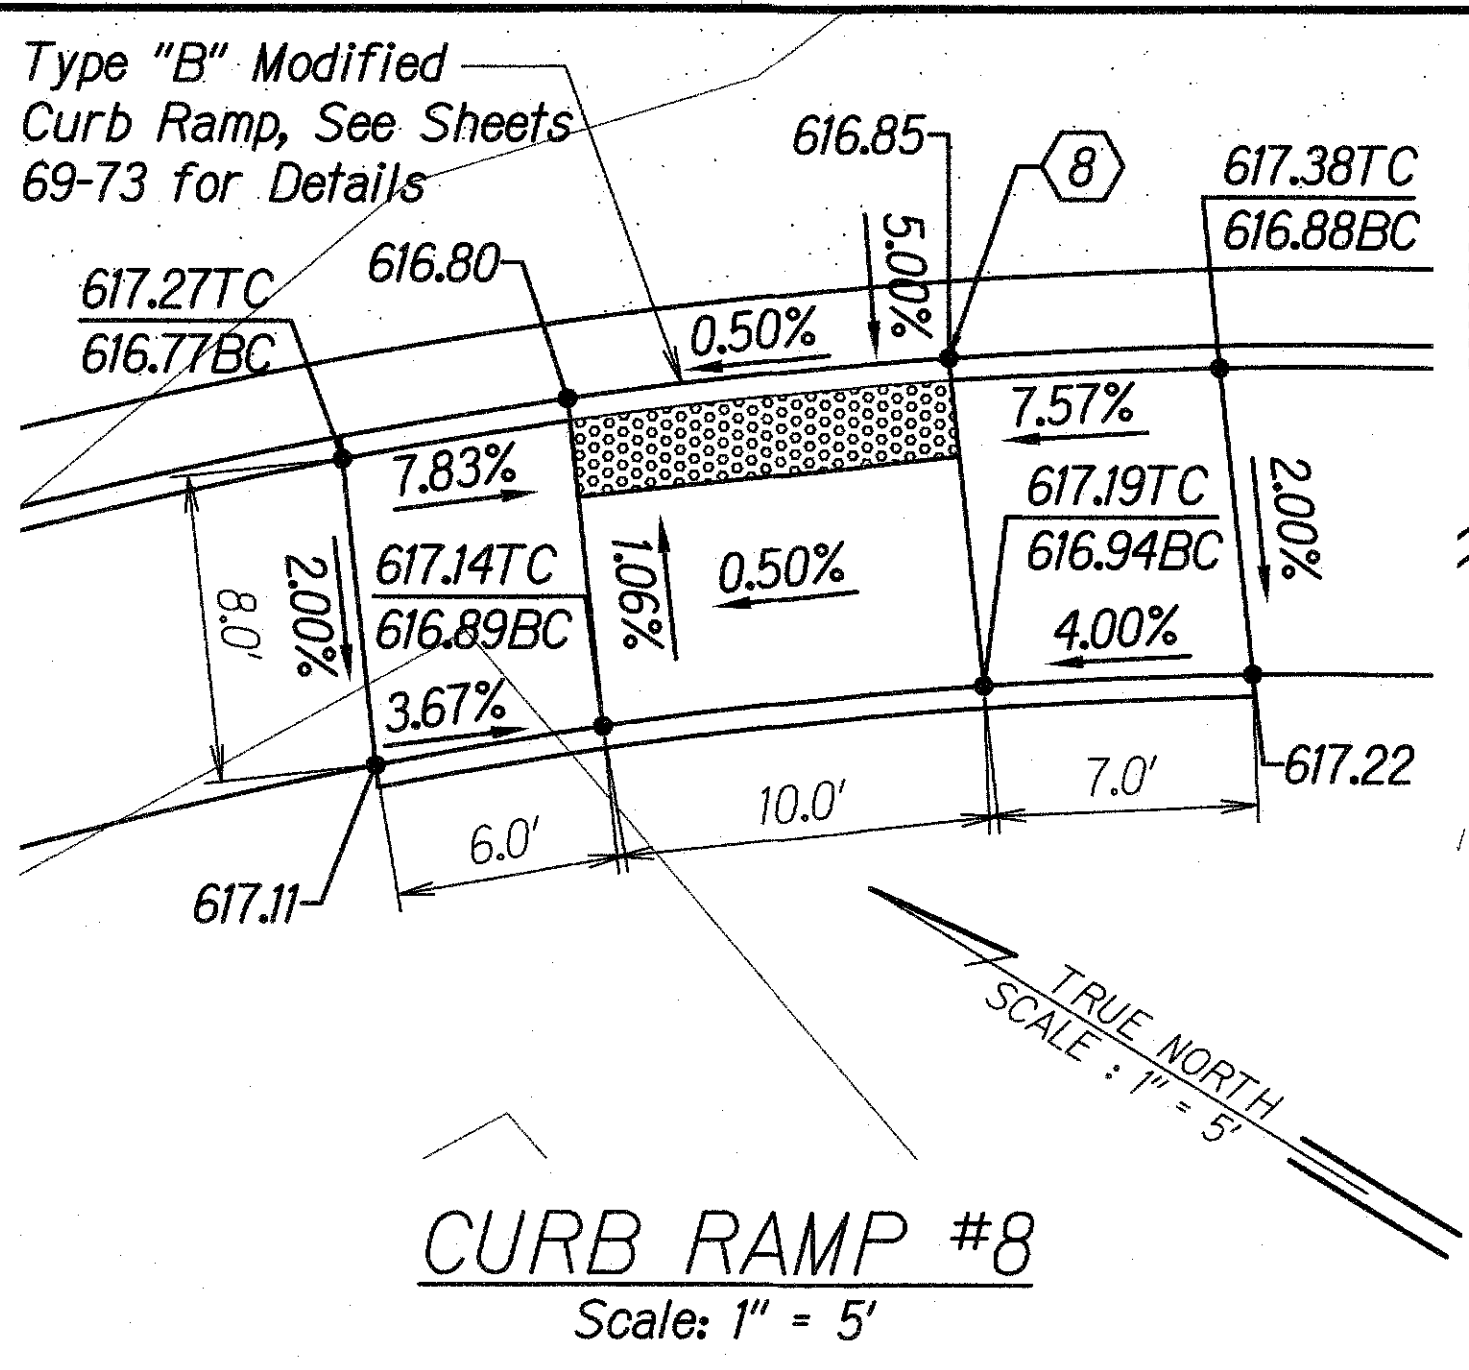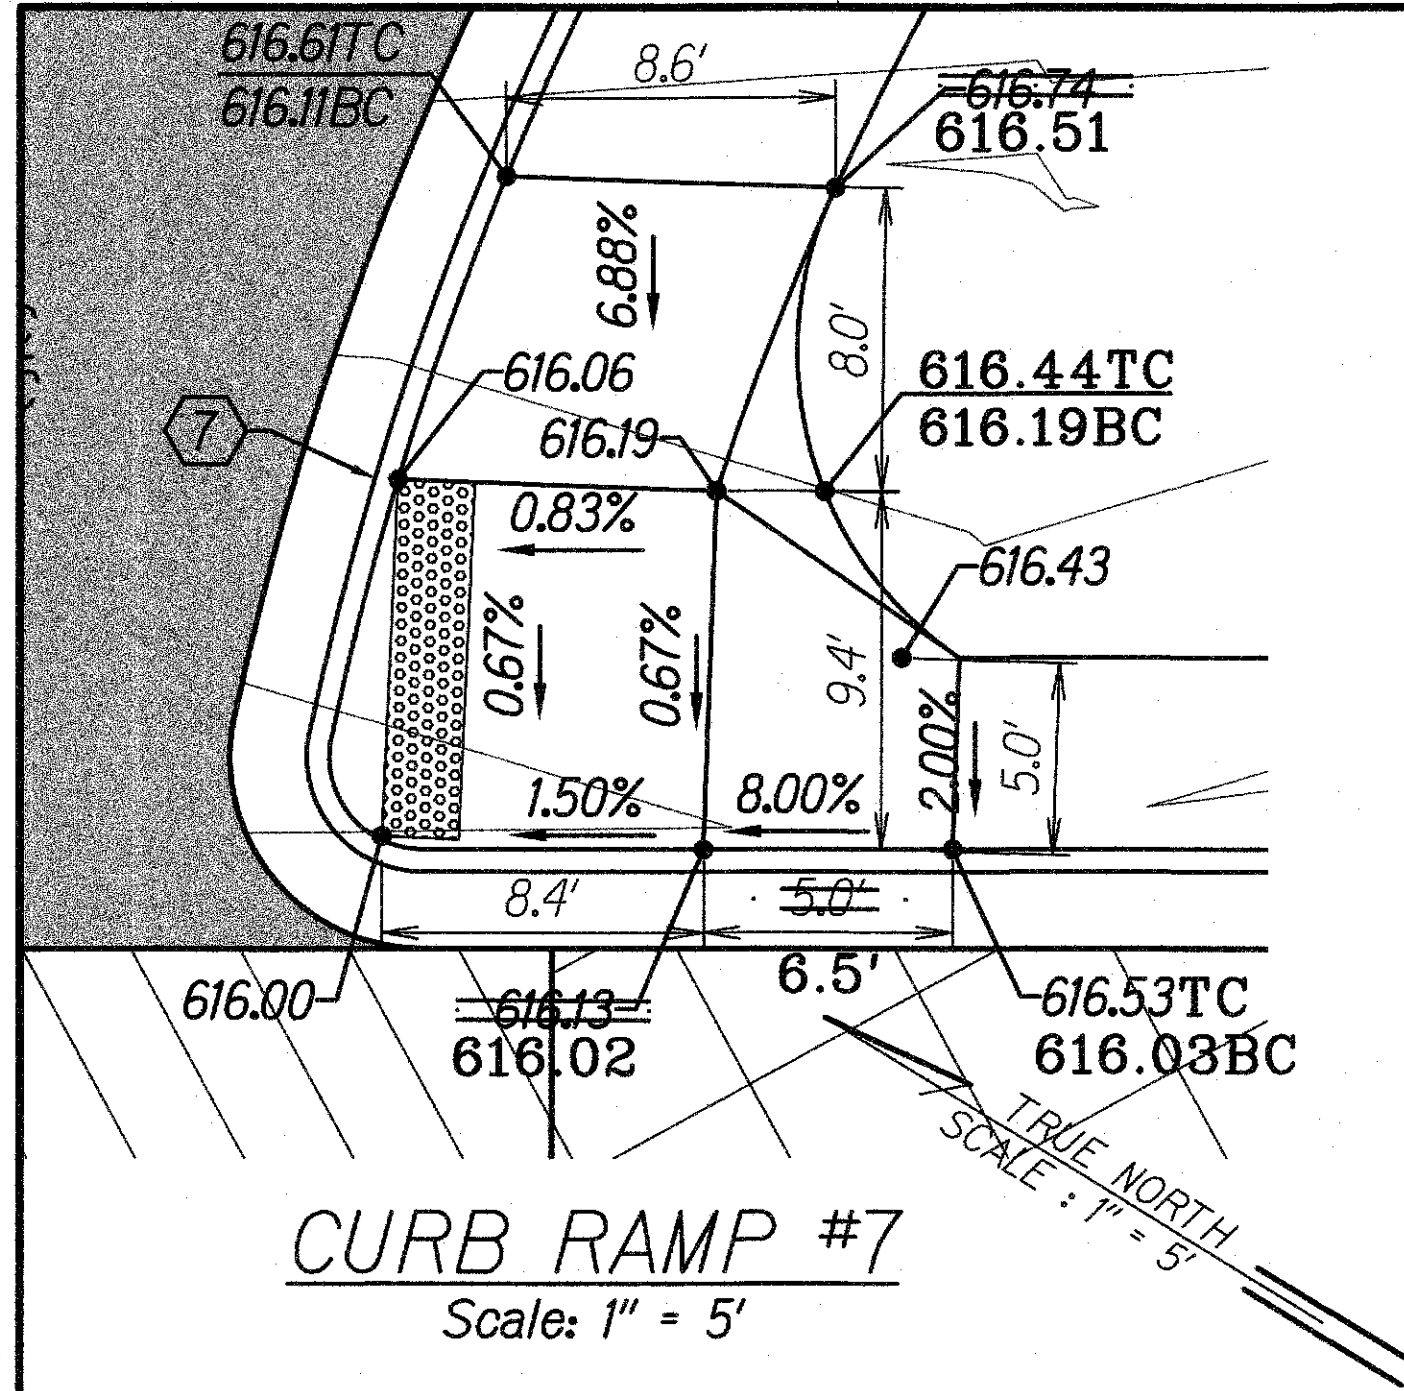

COORDINATE TABLE			
Point	Northing	Easting	Description
7	243426.61	1827529.81	North Corner, Bottom Curb
8	243379.58	1827636.44	East Corner, Bottom Curb
9	243414.15	1827659.57	North Corner, Bottom Curb
10	243431.94	1827665.12	West Corner, Bottom Curb
11	243262.48	1827667.48	Southeast Corner, Bottom Curb
12	243272.80	1827699.90	North Corner, Bottom Curb

LEGEND FOR AS-BUILT POSTINGS

Squiggly line for as-built deletion
 Double line for as-built deletion
 Text for as-built posting


LICENSE EXPIRES 4/30/18
 THIS WORK WAS PREPARED BY ME OR UNDER MY SUPERVISION

STATE OF HAWAII
 DEPARTMENT OF TRANSPORTATION
 HIGHWAYS DIVISION
ACCESSIBLE PLANS
 CURB RAMPS #7 - #12
 Keaau-Pahoa Road Intersection
 Improvements at Old Government Road
 Federal-Aid Project No. HSIP-0130(031)
 Scale: 1" = 5' Date: August 2013
 SHEET No. 2 OF 3 SHEETS


"AS-BUILT"

FED. ROAD DIST. NO.	STATE	FED. AID PROJ. NO.	FISCAL YEAR	SHEET NO.	TOTAL SHEETS
HAWAII	HAW.	HSIP-0130(031)	2014	52	108


CURB RAMP NUMBER KEY MAP
Scale: 1" = 80'

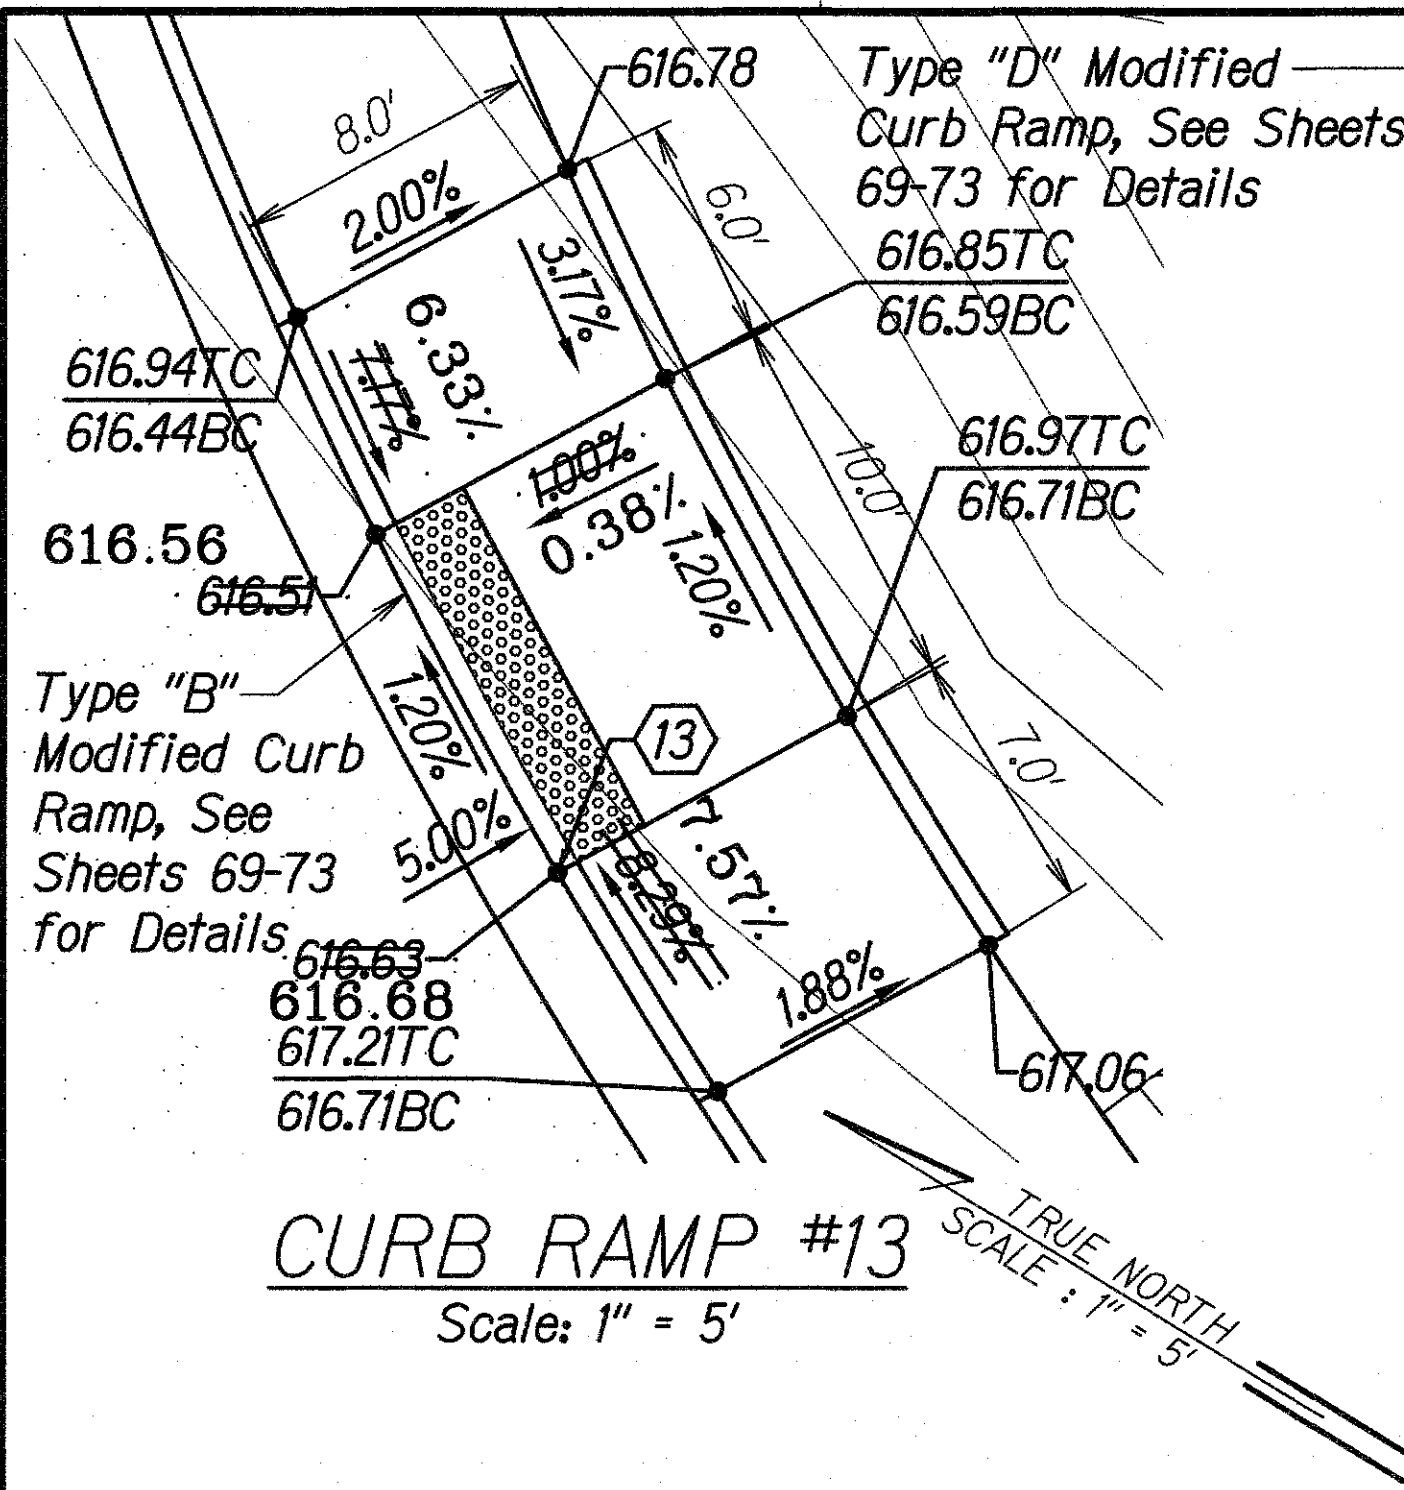


CURB RAMP #16
Scale: 1" = 5'

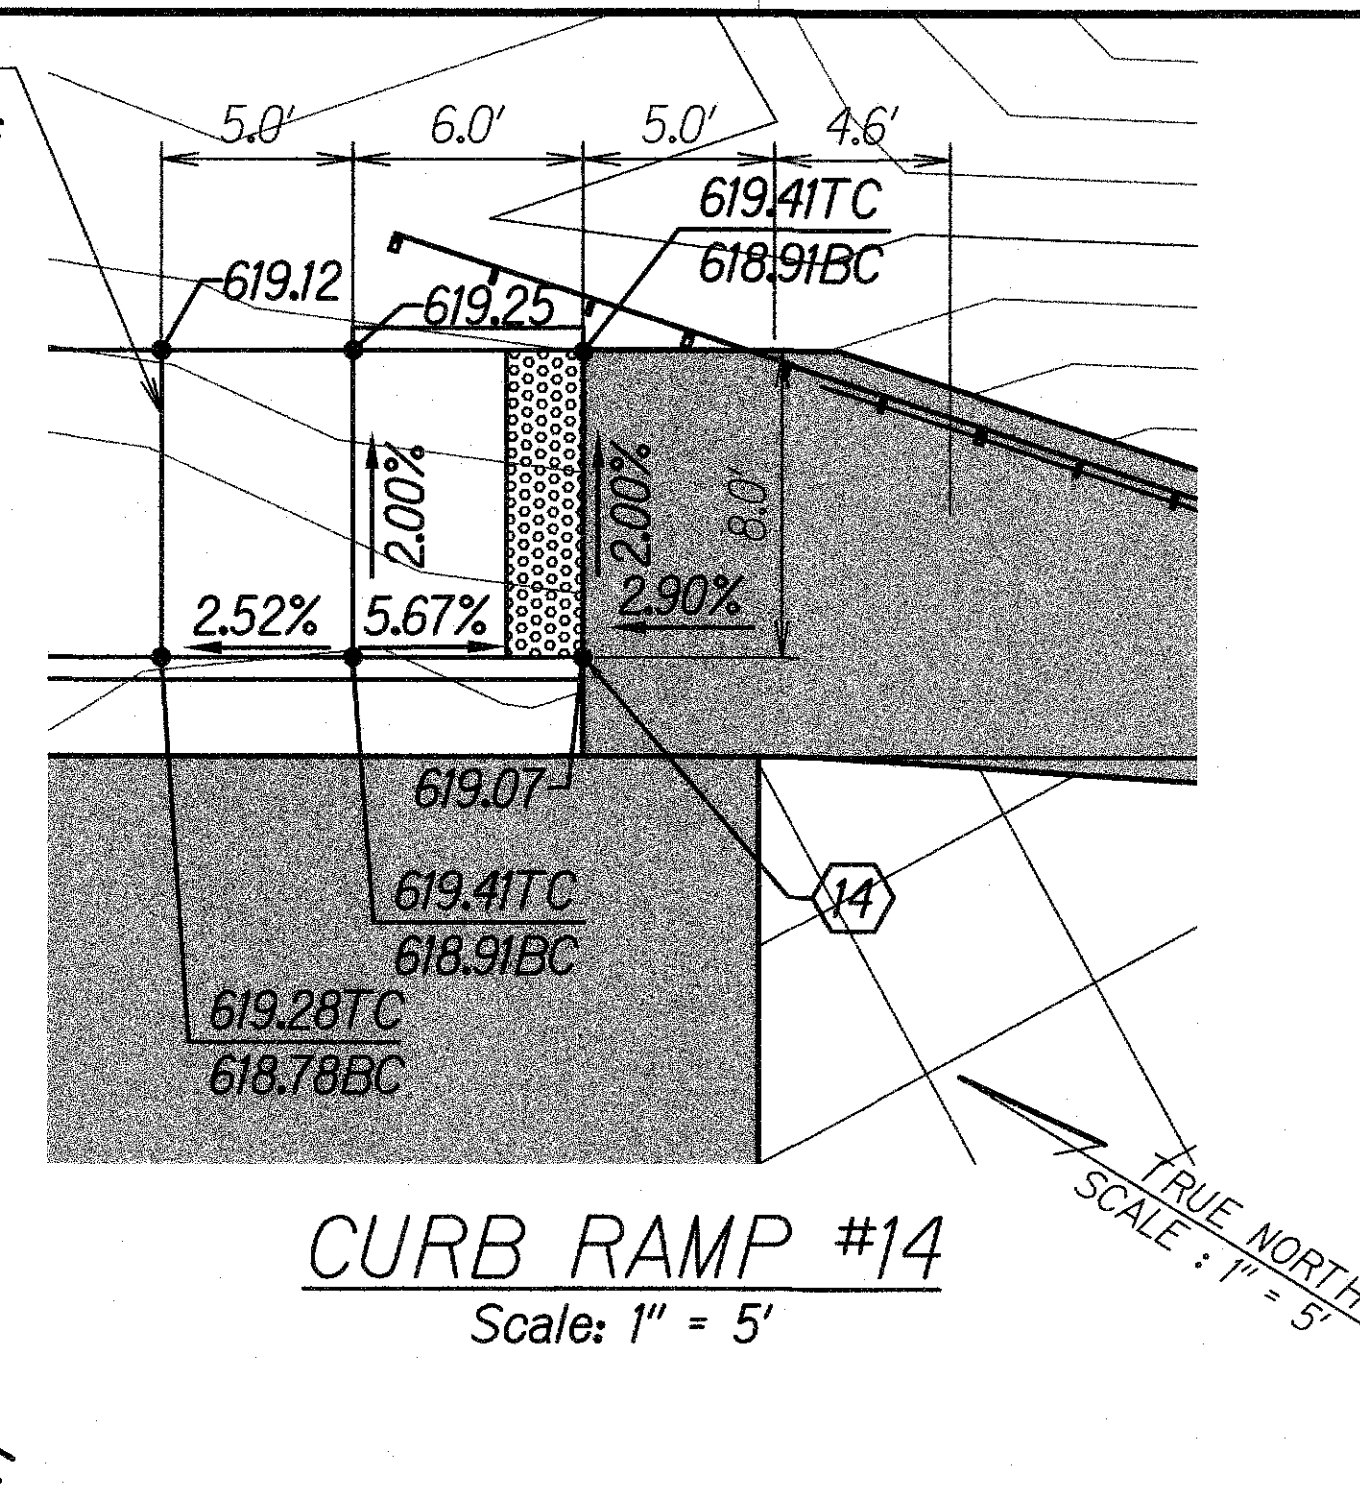

CURB RAMP #17
Scale: 1" = 5'

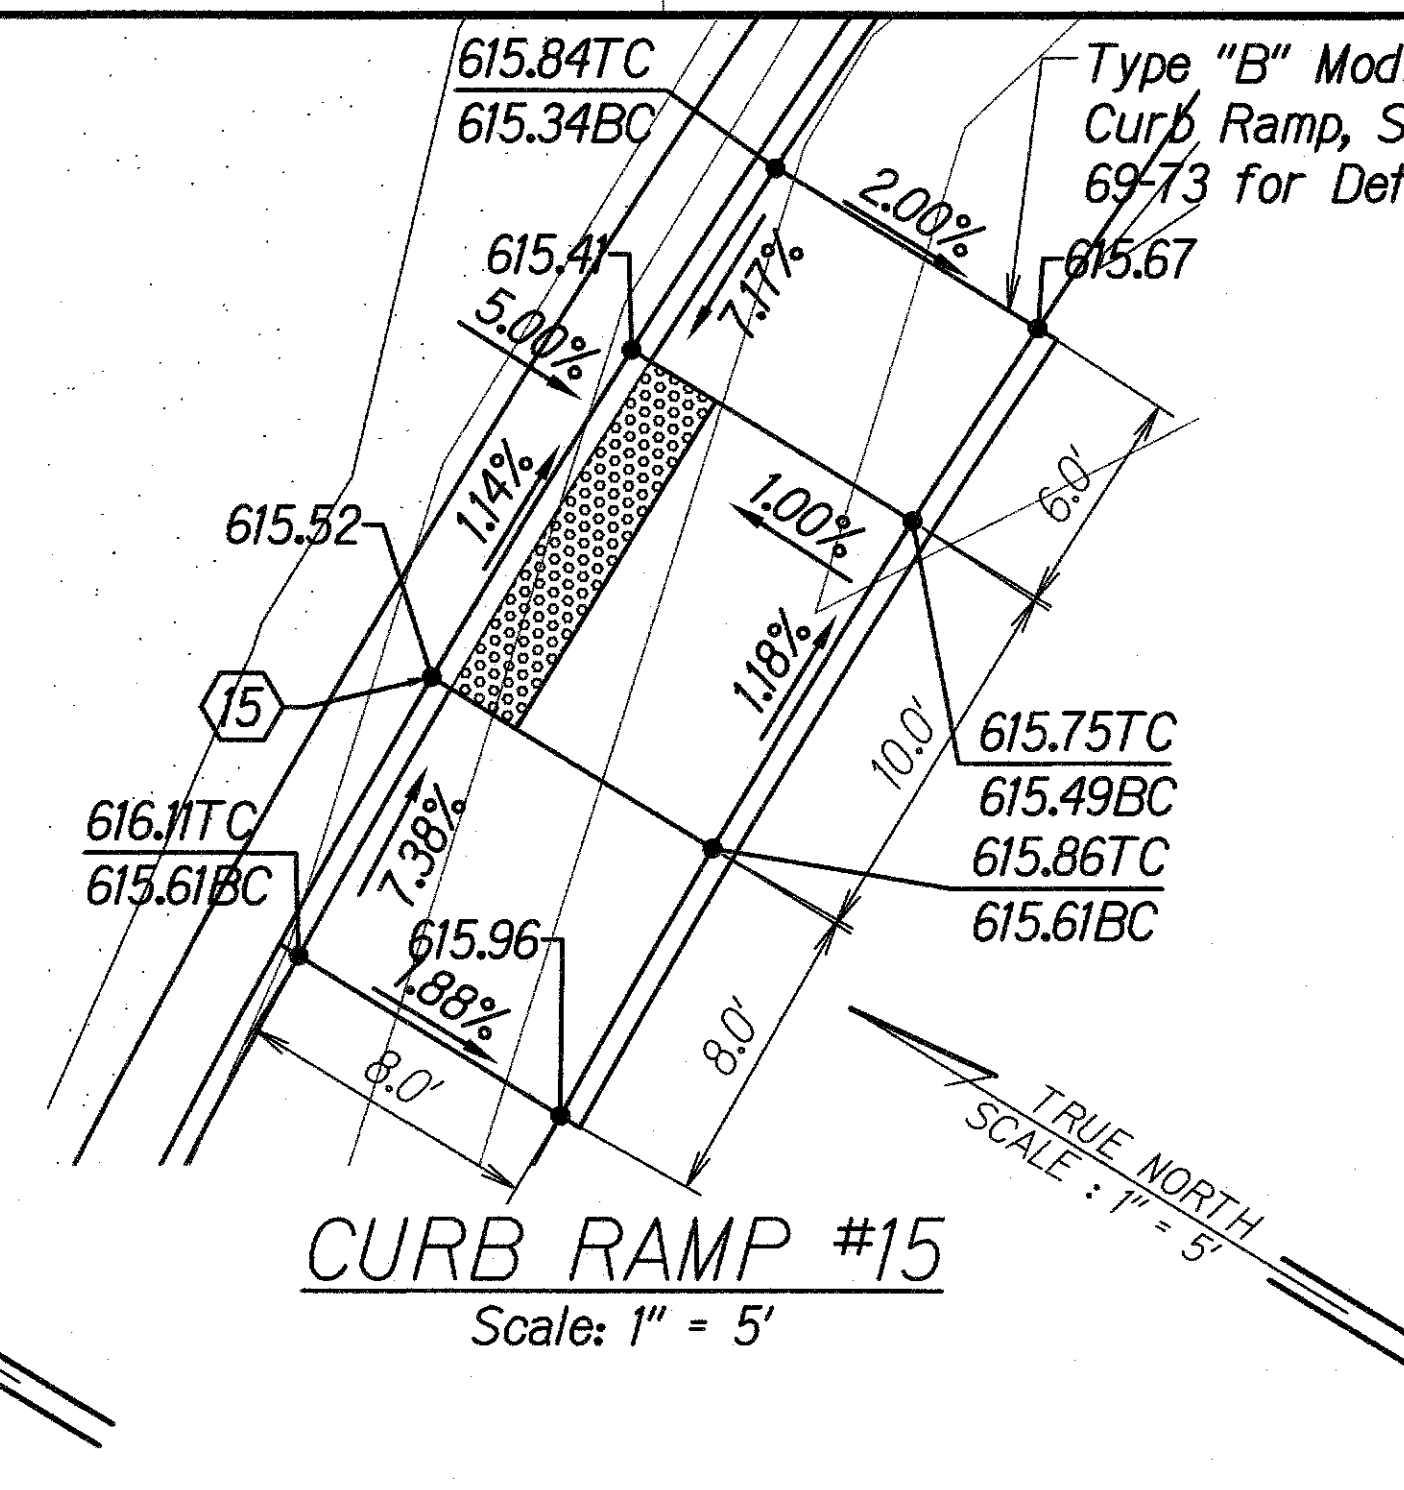


CURB RAMP #18
Scale: 1" = 5'

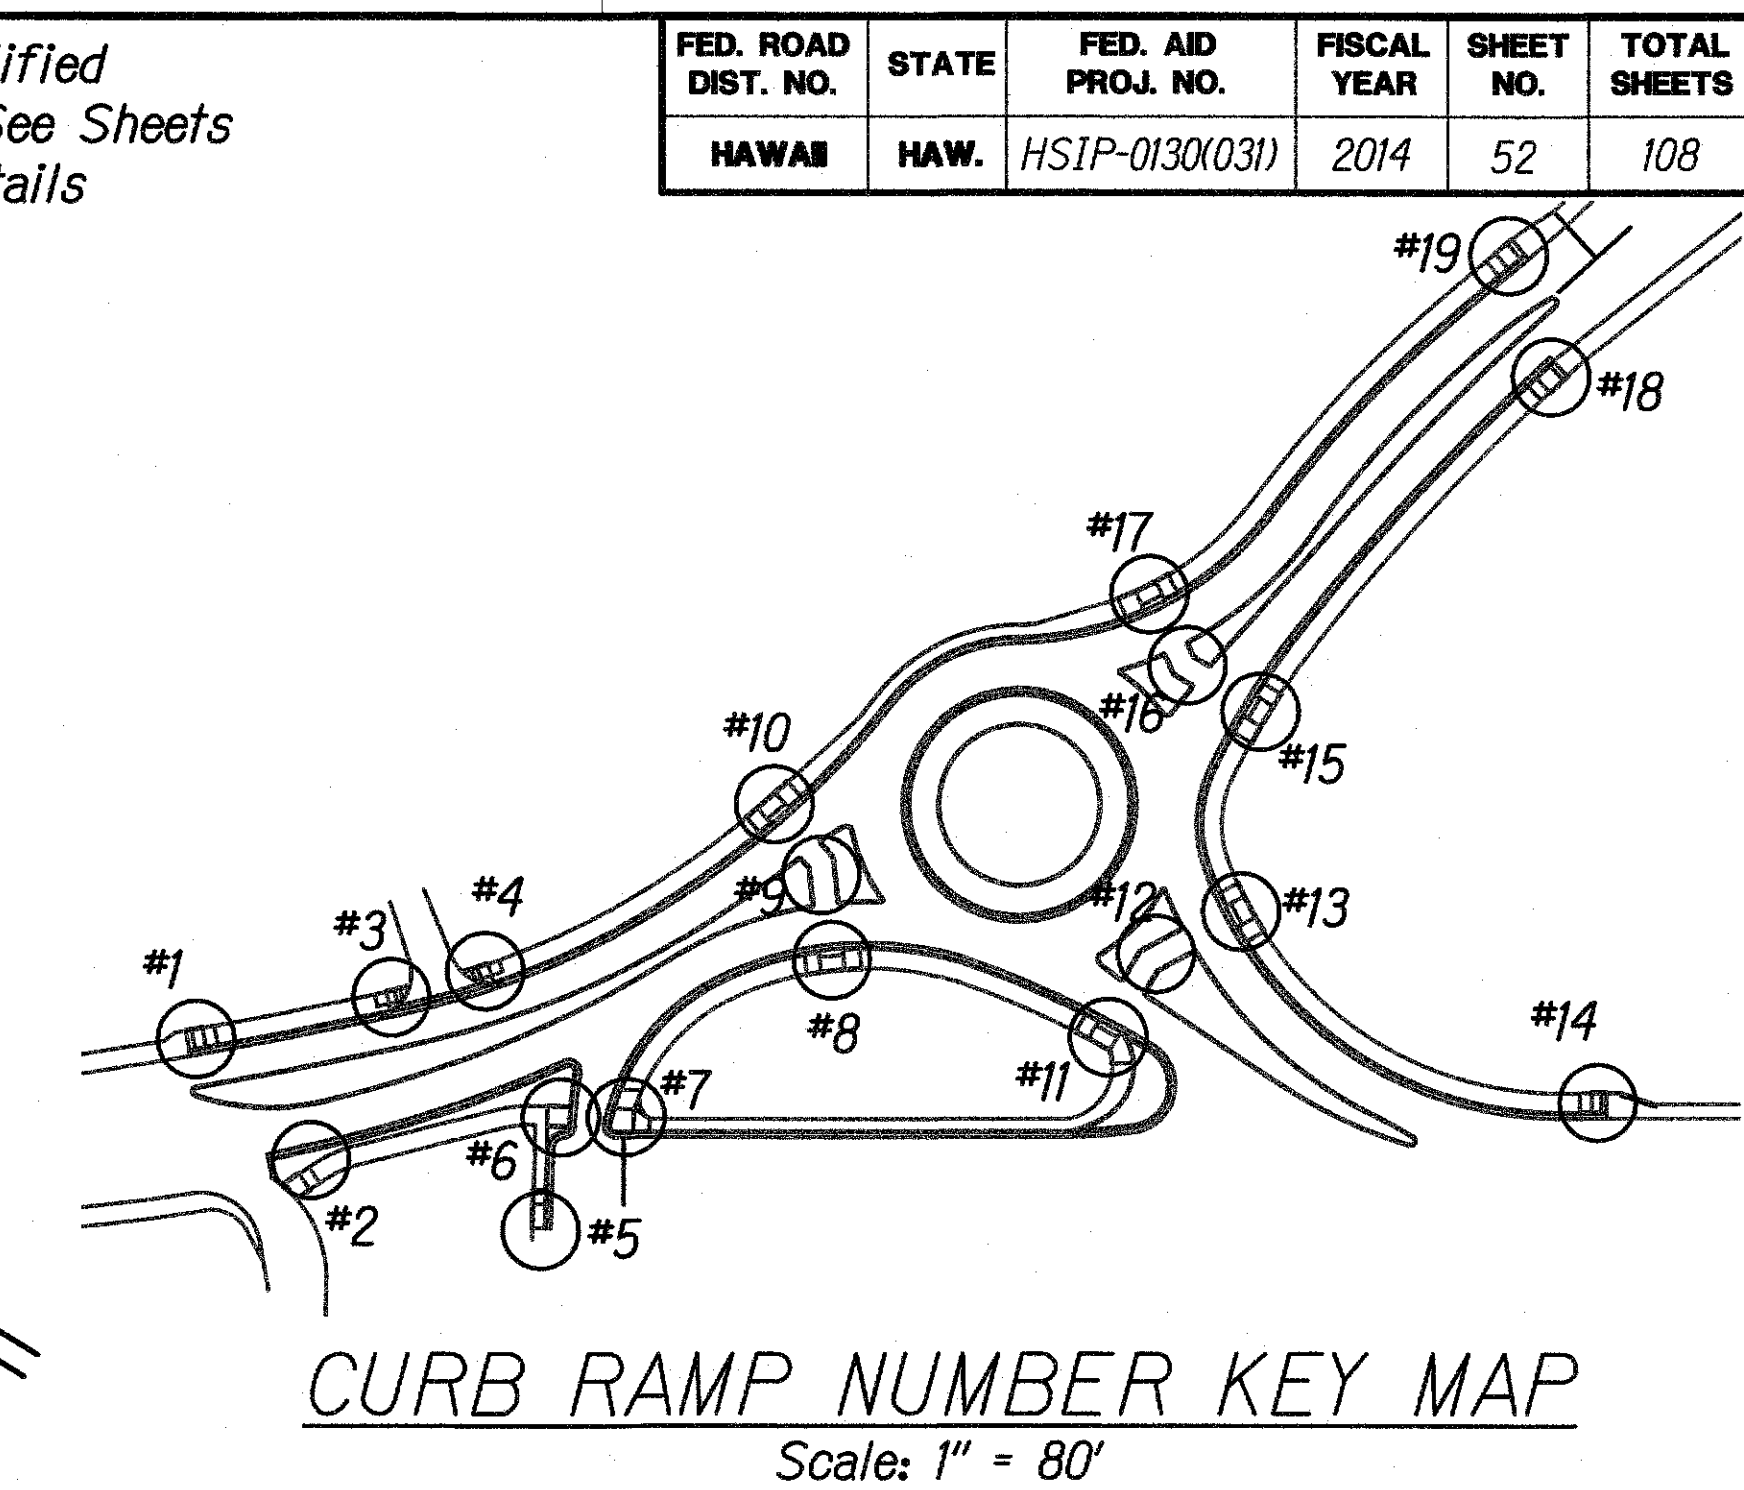

CURB RAMP #19
Scale: 1" = 5'

C O O R D I N A T E T A B L E			
<i>Point</i>	<i>Northing</i>	<i>Easting</i>	<i>Description</i>
13	243243.79	1827729.71	West Corner, Bottom Curb
14	243071.97	1827744.62	South Corner, Bottom Curb
15	243287.98	1827806.51	Northwest Corner, Bottom Curb
16	243321.34	1827806.47	West Corner, Bottom Curb
17	243345.75	1827822.25	West Corner, Bottom Curb
18	243254.04	1828000.45	East Corner, Bottom Curb
19	243287.96	1828032.21	South Corner, Bottom Curb

LEGEND FOR AS-BUILT POSTINGS

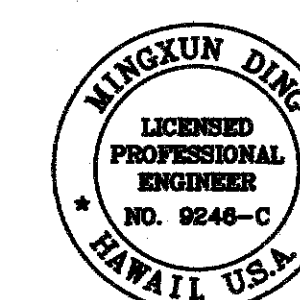

STATE OF HAWAII
DEPARTMENT OF TRANSPORTATION
HIGHWAYS DIVISION

Scale: 1" = 5' Date: August 2013

SHEET No. 3 OF 3 SHEETS