


FED. ROAD DIST. NO.	STATE	FED. AID PROJ. NO.	FISCAL YEAR	SHEET NO.	TOTAL SHEETS
HAWAII	HAW.	HSIP-0130(031)	2014	C.O. 18	108

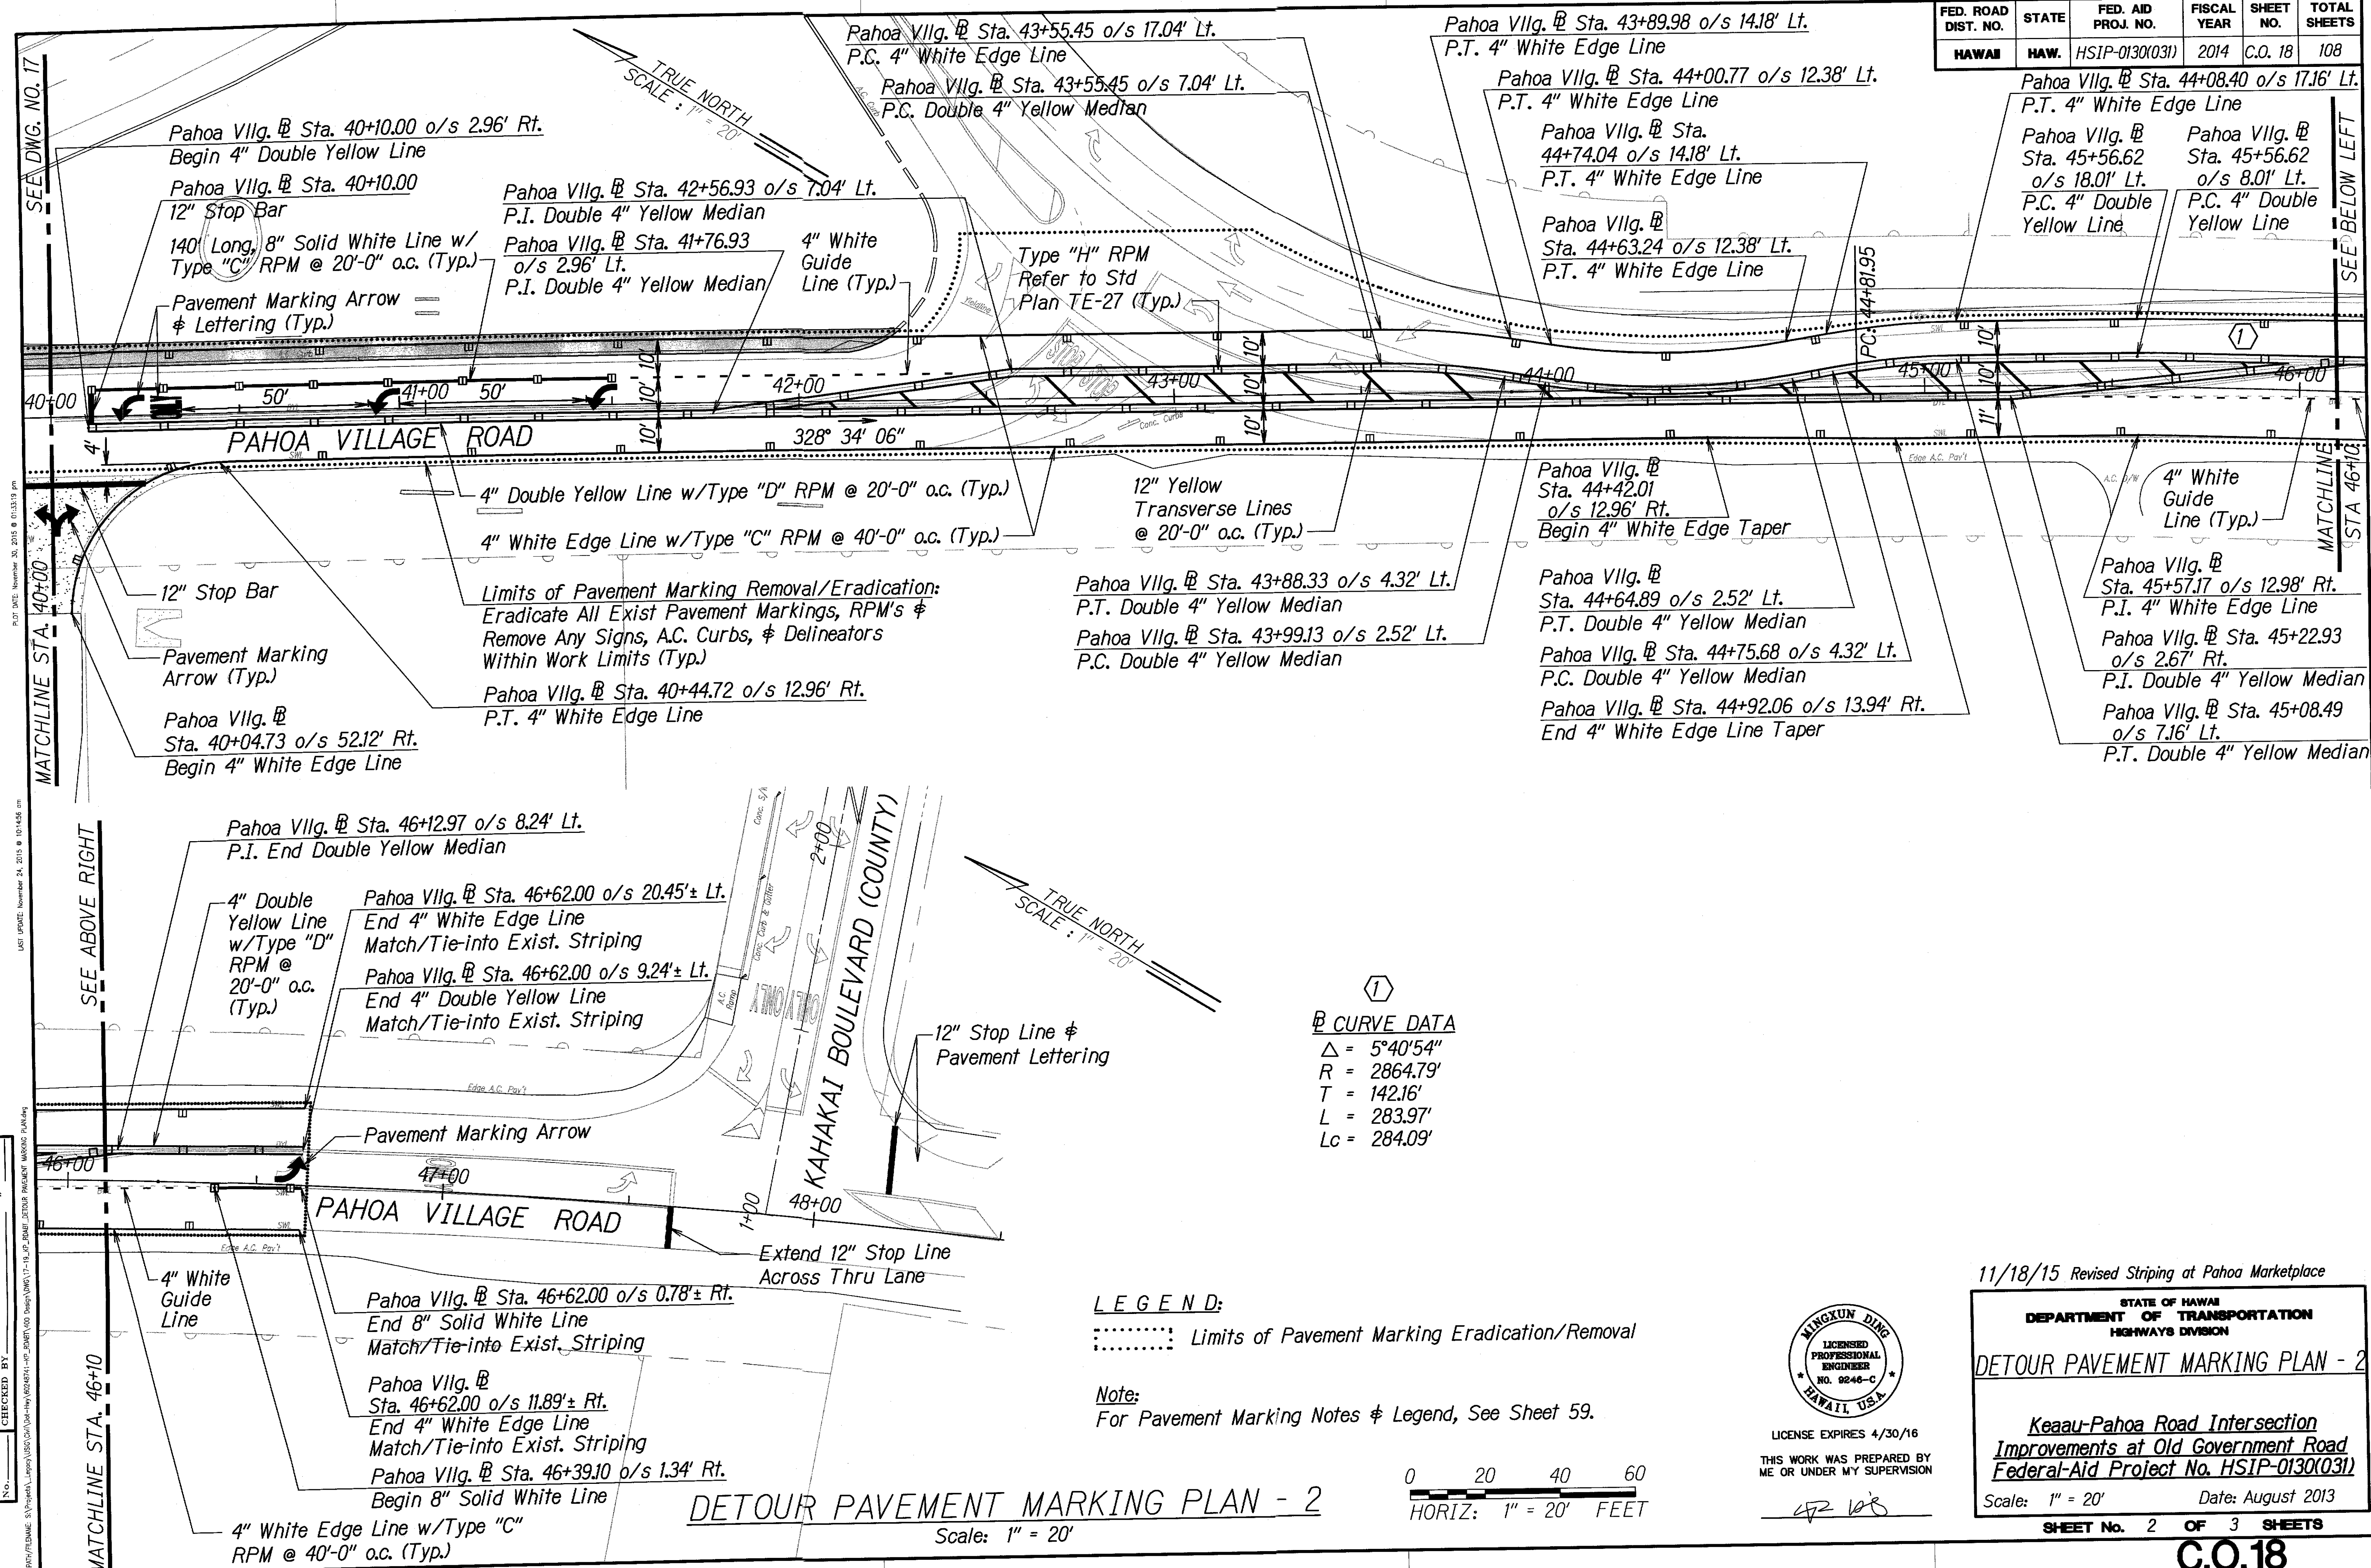

11/18/15 Revised Striping at Pahoa Marketplace

STATE OF HAWAII
DEPARTMENT OF TRANSPORTATION
HIGHWAYS DIVISION

DETOUR PAVEMENT MARKING PLAN - 2


Keaau-Pahoa Road Intersection
Improvements at Old Government Road
Federal-Aid Project No. HSIP-0130(031)

Scale: 1" = 20' Date: August 2013

SHEET No. 2 OF 3 SHEETS

C.O.18

FED. ROAD DIST. NO.	STATE	FED. AID PROJ. NO.	FISCAL YEAR	SHEET NO.	TOTAL SHEETS
HAWAII	HAW.	HSIP-0130(031)	2014	19	108

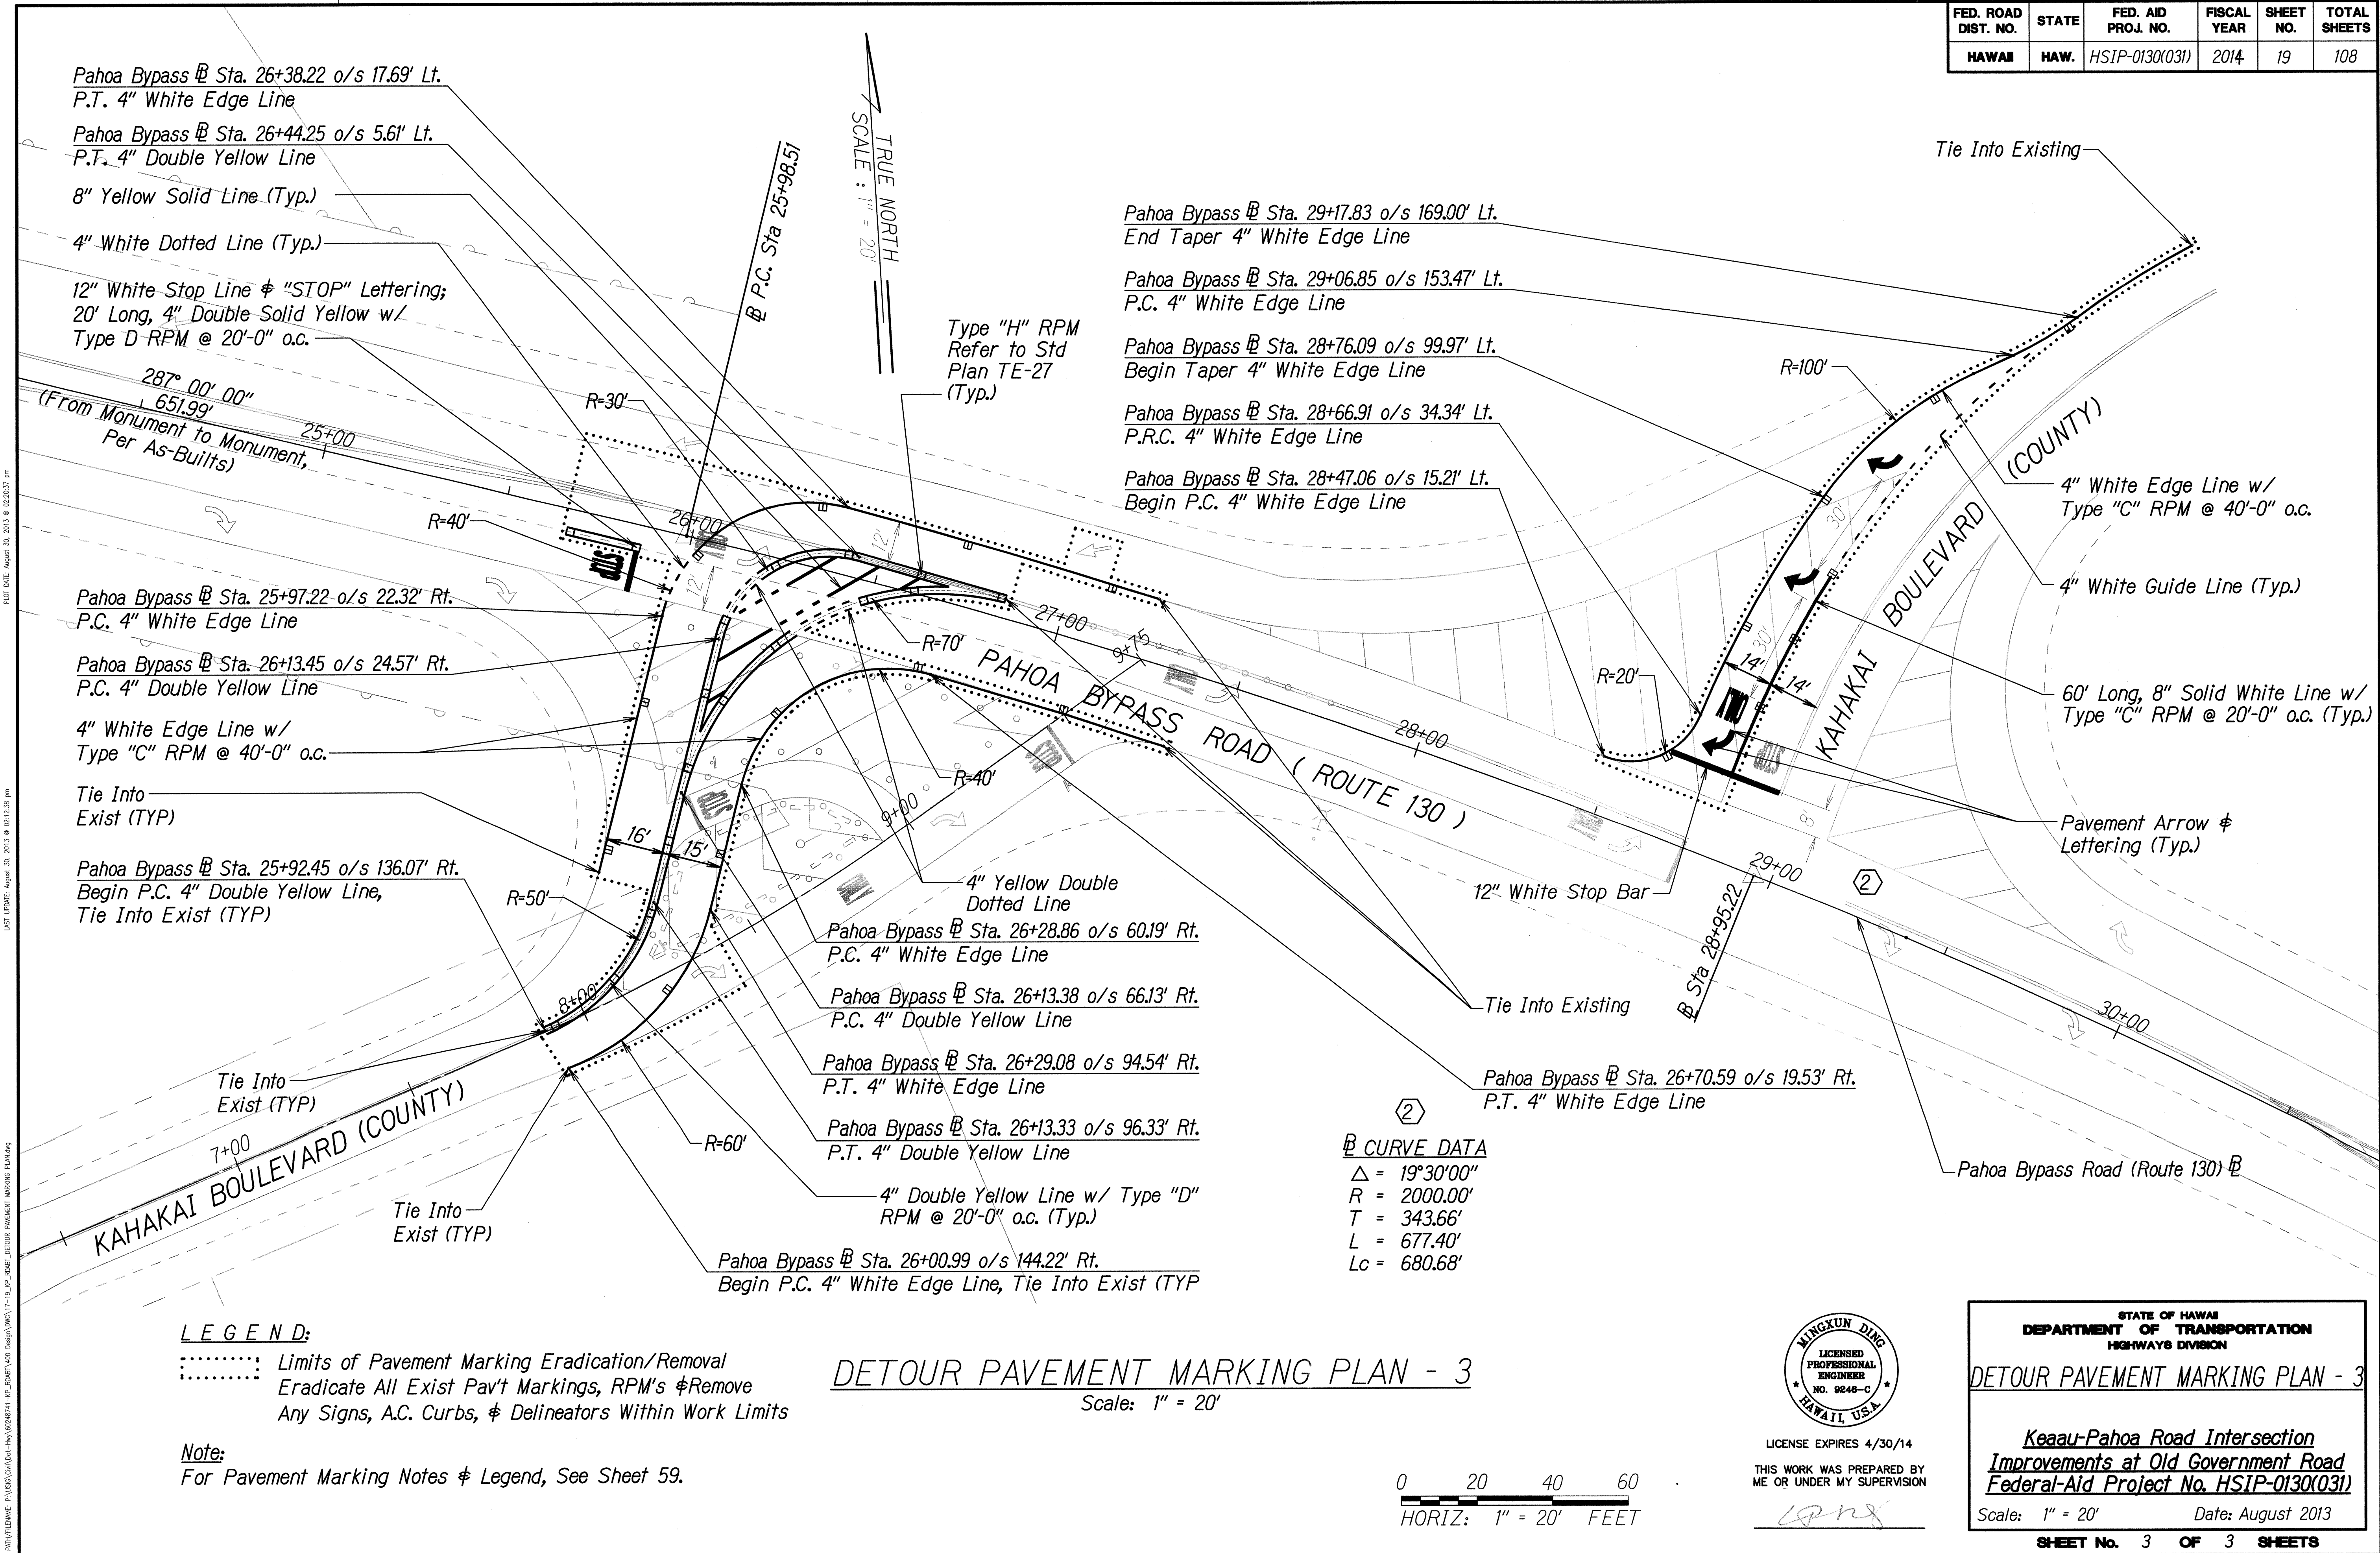

ORIGINAL PLAN	SURVEY PLOTTED BY	DATE
NOTE BOOK	DRAWN BY	
	DESIGNED BY	
	QUANTITIES BY	
	CHECKED BY	
	NO.	

P:\H\14561\14561-001\14561-001.dwg (17-18) 10/18/2013 10:11:38 AM



LEGEND:

- Limits of Pavement Marking Eradication/Removal
- Eradicate All Exist Pav't Markings, RPM's & Remove
- Any Signs, A.C. Curbs, & Delineators Within Work Limits

Note:
For Pavement Marking Notes & Legend, See Sheet 59.

DETOUR PAVEMENT MARKING PLAN - 3

Scale: 1" = 20'

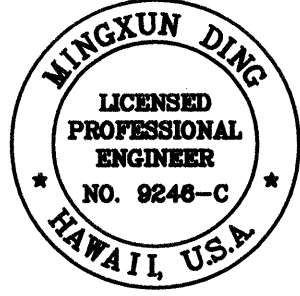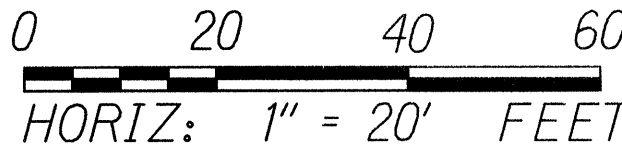

LICENSE EXPIRES 4/30/14
THIS WORK WAS PREPARED BY
ME OR UNDER MY SUPERVISION

Signature

STATE OF HAWAII
DEPARTMENT OF TRANSPORTATION
HIGHWAYS DIVISION

DETOUR PAVEMENT MARKING PLAN - 3

Kaaau-Pahoa Road Intersection
Improvements at Old Government Road
Federal-Aid Project No. HSIP-0130(031)

Scale: 1" = 20'

Date: August 2013

SHEET No. 3 OF 3 SHEETS