


FED. ROAD DIST. NO.	STATE	FED. AID PROJ. NO.	FISCAL YEAR	SHEET NO.	TOTAL SHEETS
HAWAII	HAW.	HSIP-0130(031)	2014	49	108

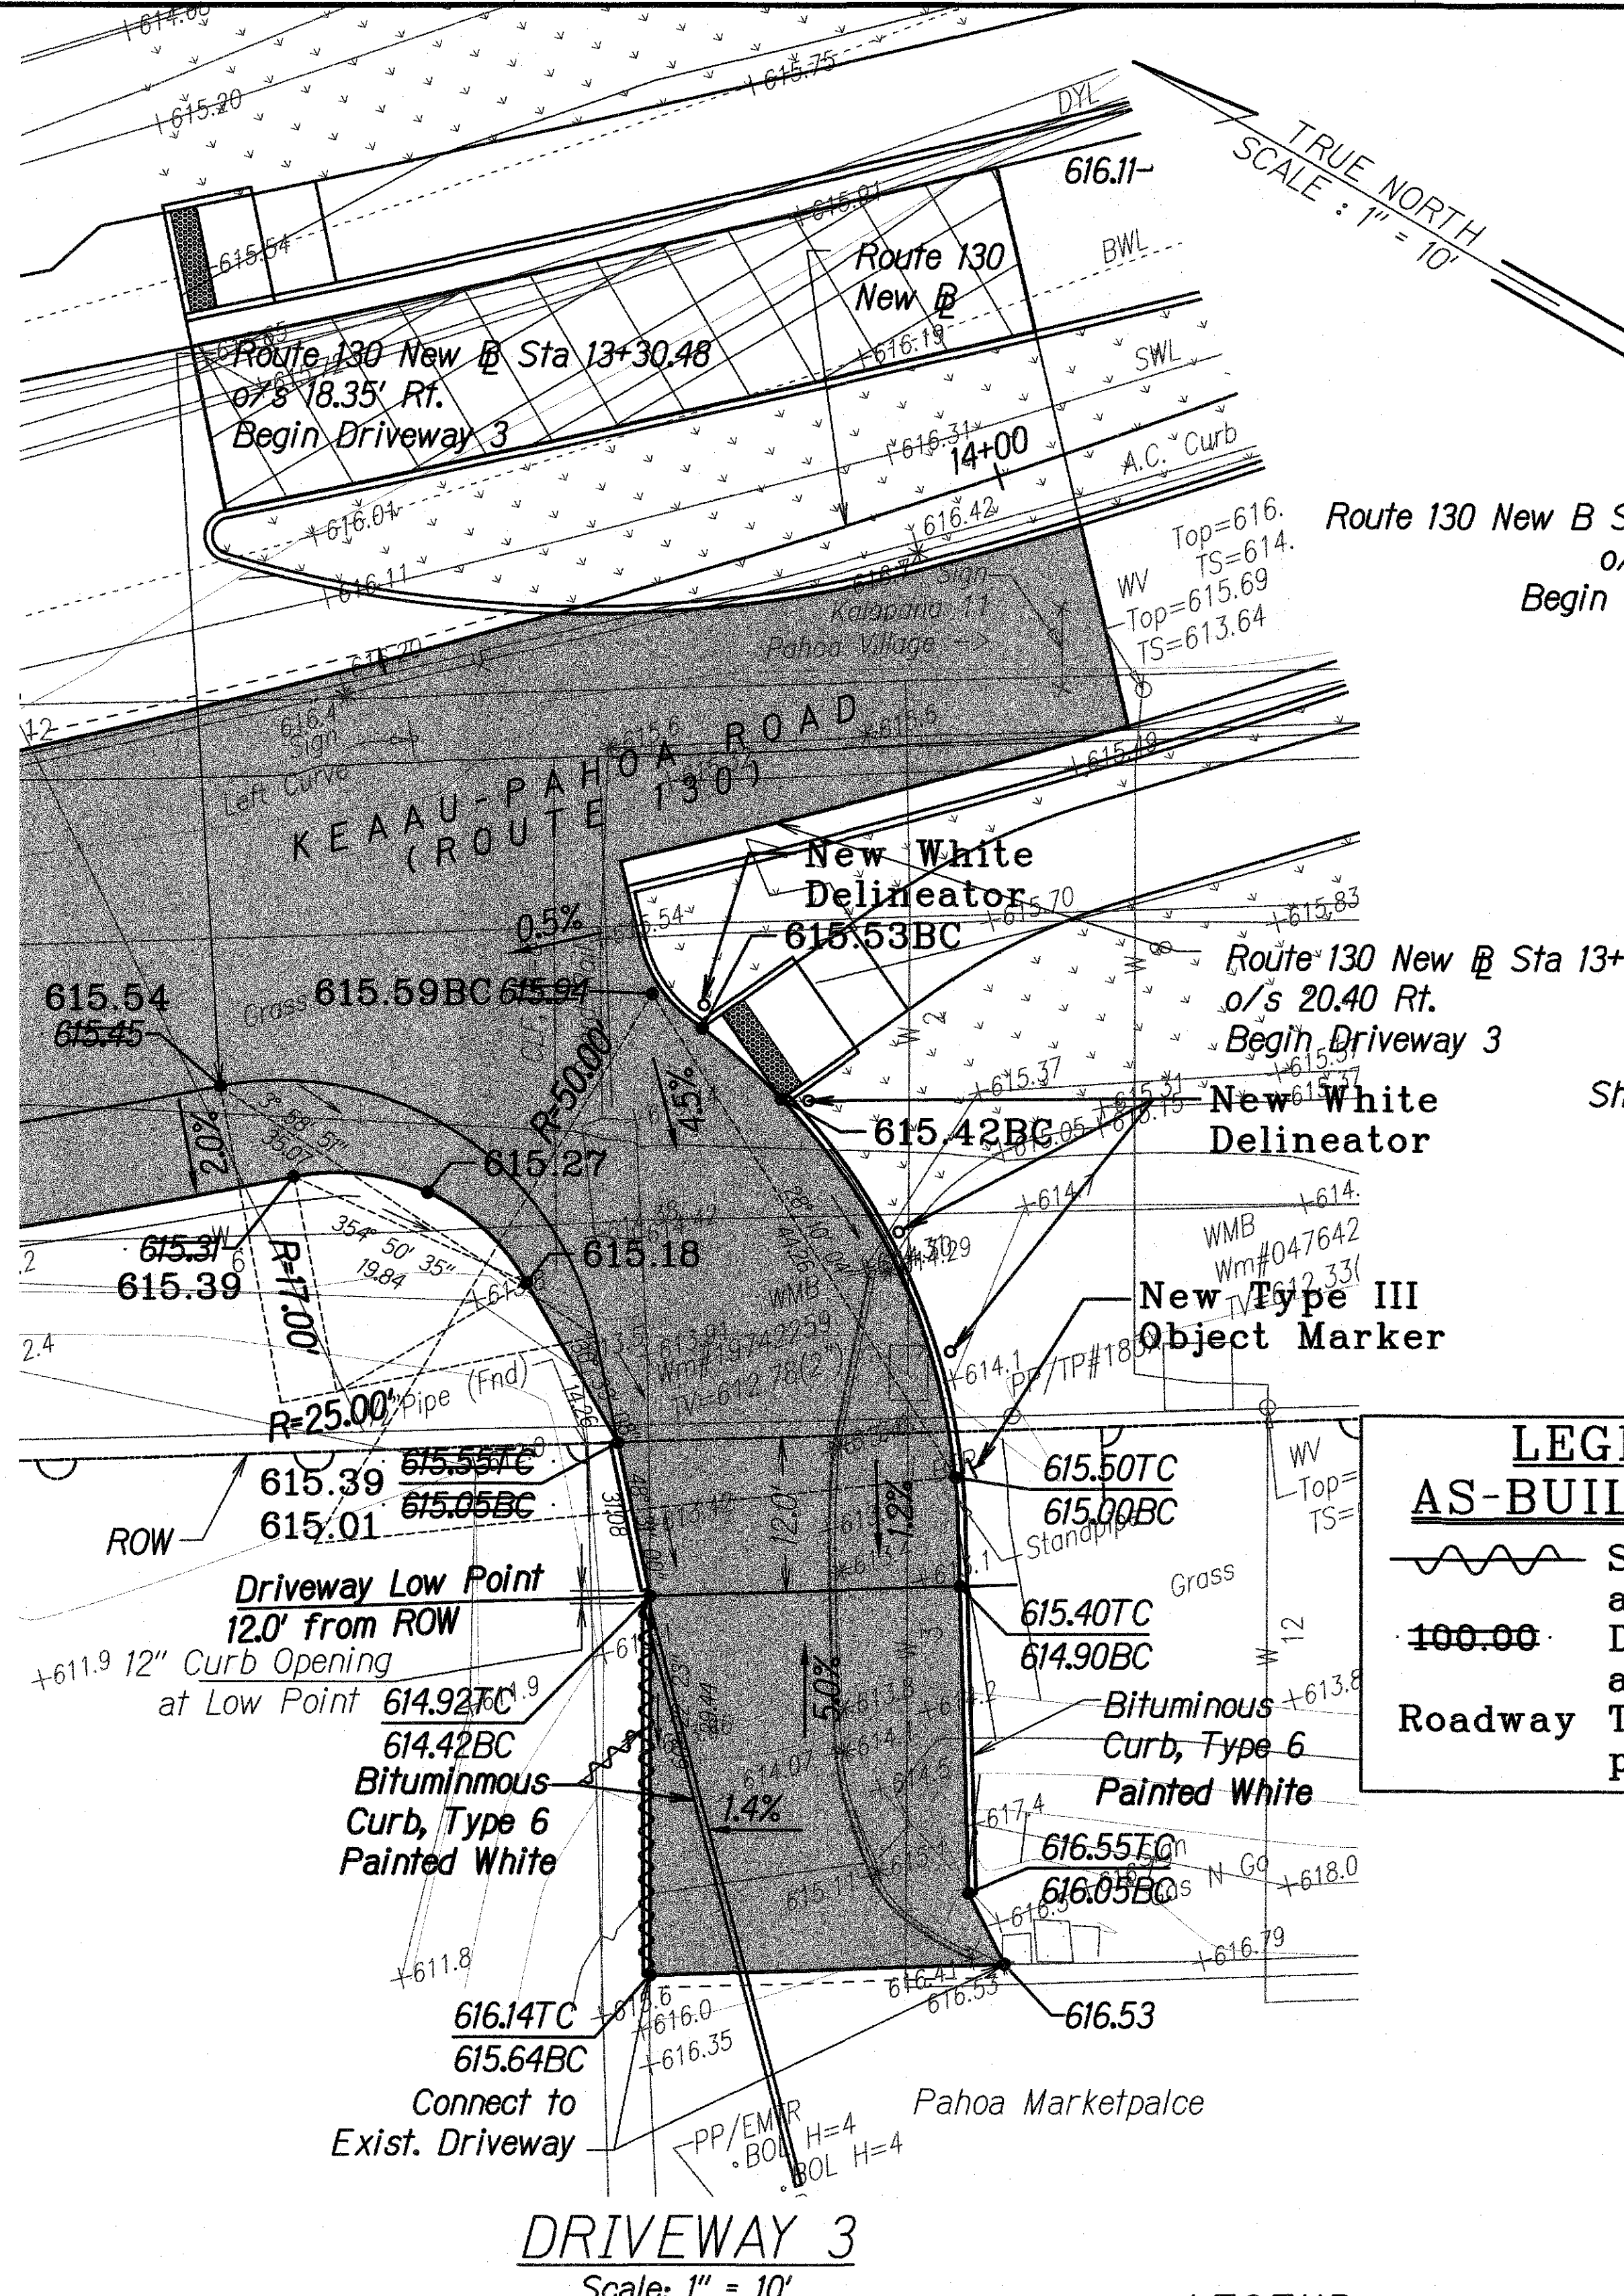

Route 130 New B Sta 14+21.52
o/s 21.30 Lt.
Begin Driveway 4

Route 130 New B Sta 13+75.68
o/s 20.40 Rt.
Begin Driveway 3

Thru Gutter, See
Sheet 77 for detail

LEGEND FOR AS-BUILT POSTINGS

Squiggly line for as-built deletion

Double line for as-built deletion


Roadway Text for as-built posting

LEGEND


4" Asphaltic Concrete, 7" Asphalt Concrete Base, 6" Aggregate Subbase

Saw Cut, Provide Smooth Transition to Existing Pavement

Right of Way

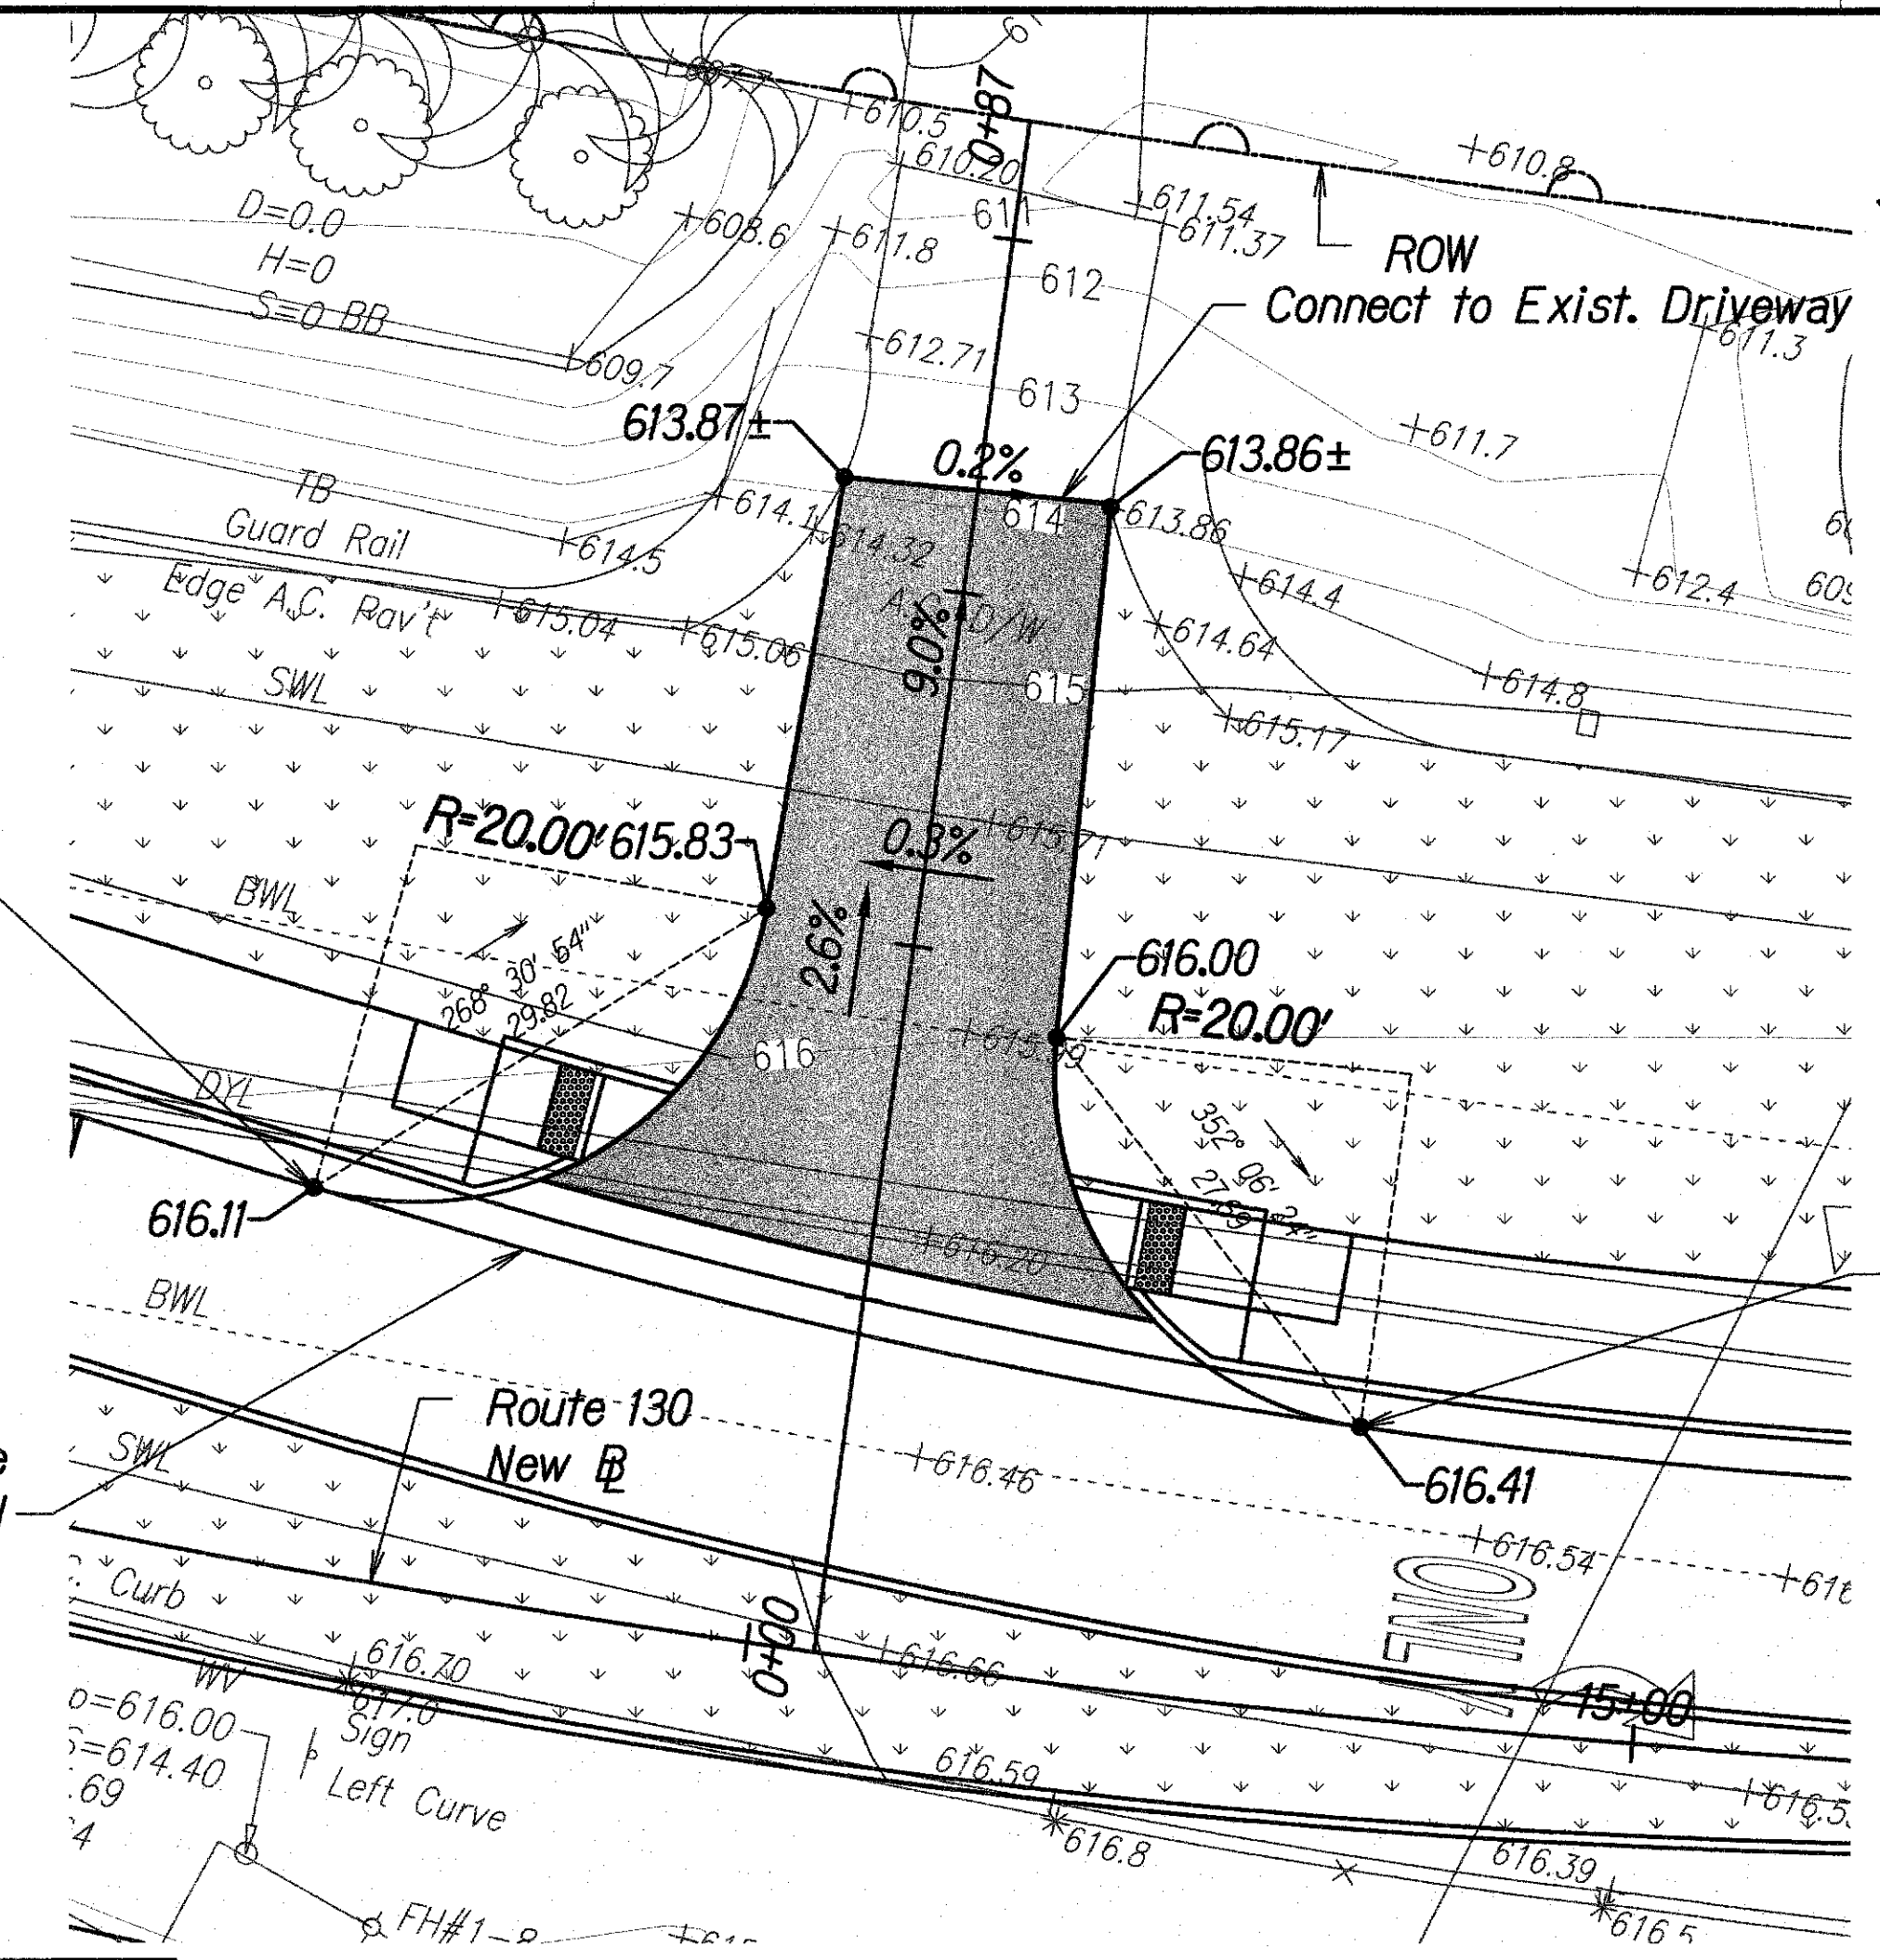

Route 130 New B Sta 14+82.99
o/s 16.28 Lt.
Begin Driveway 4

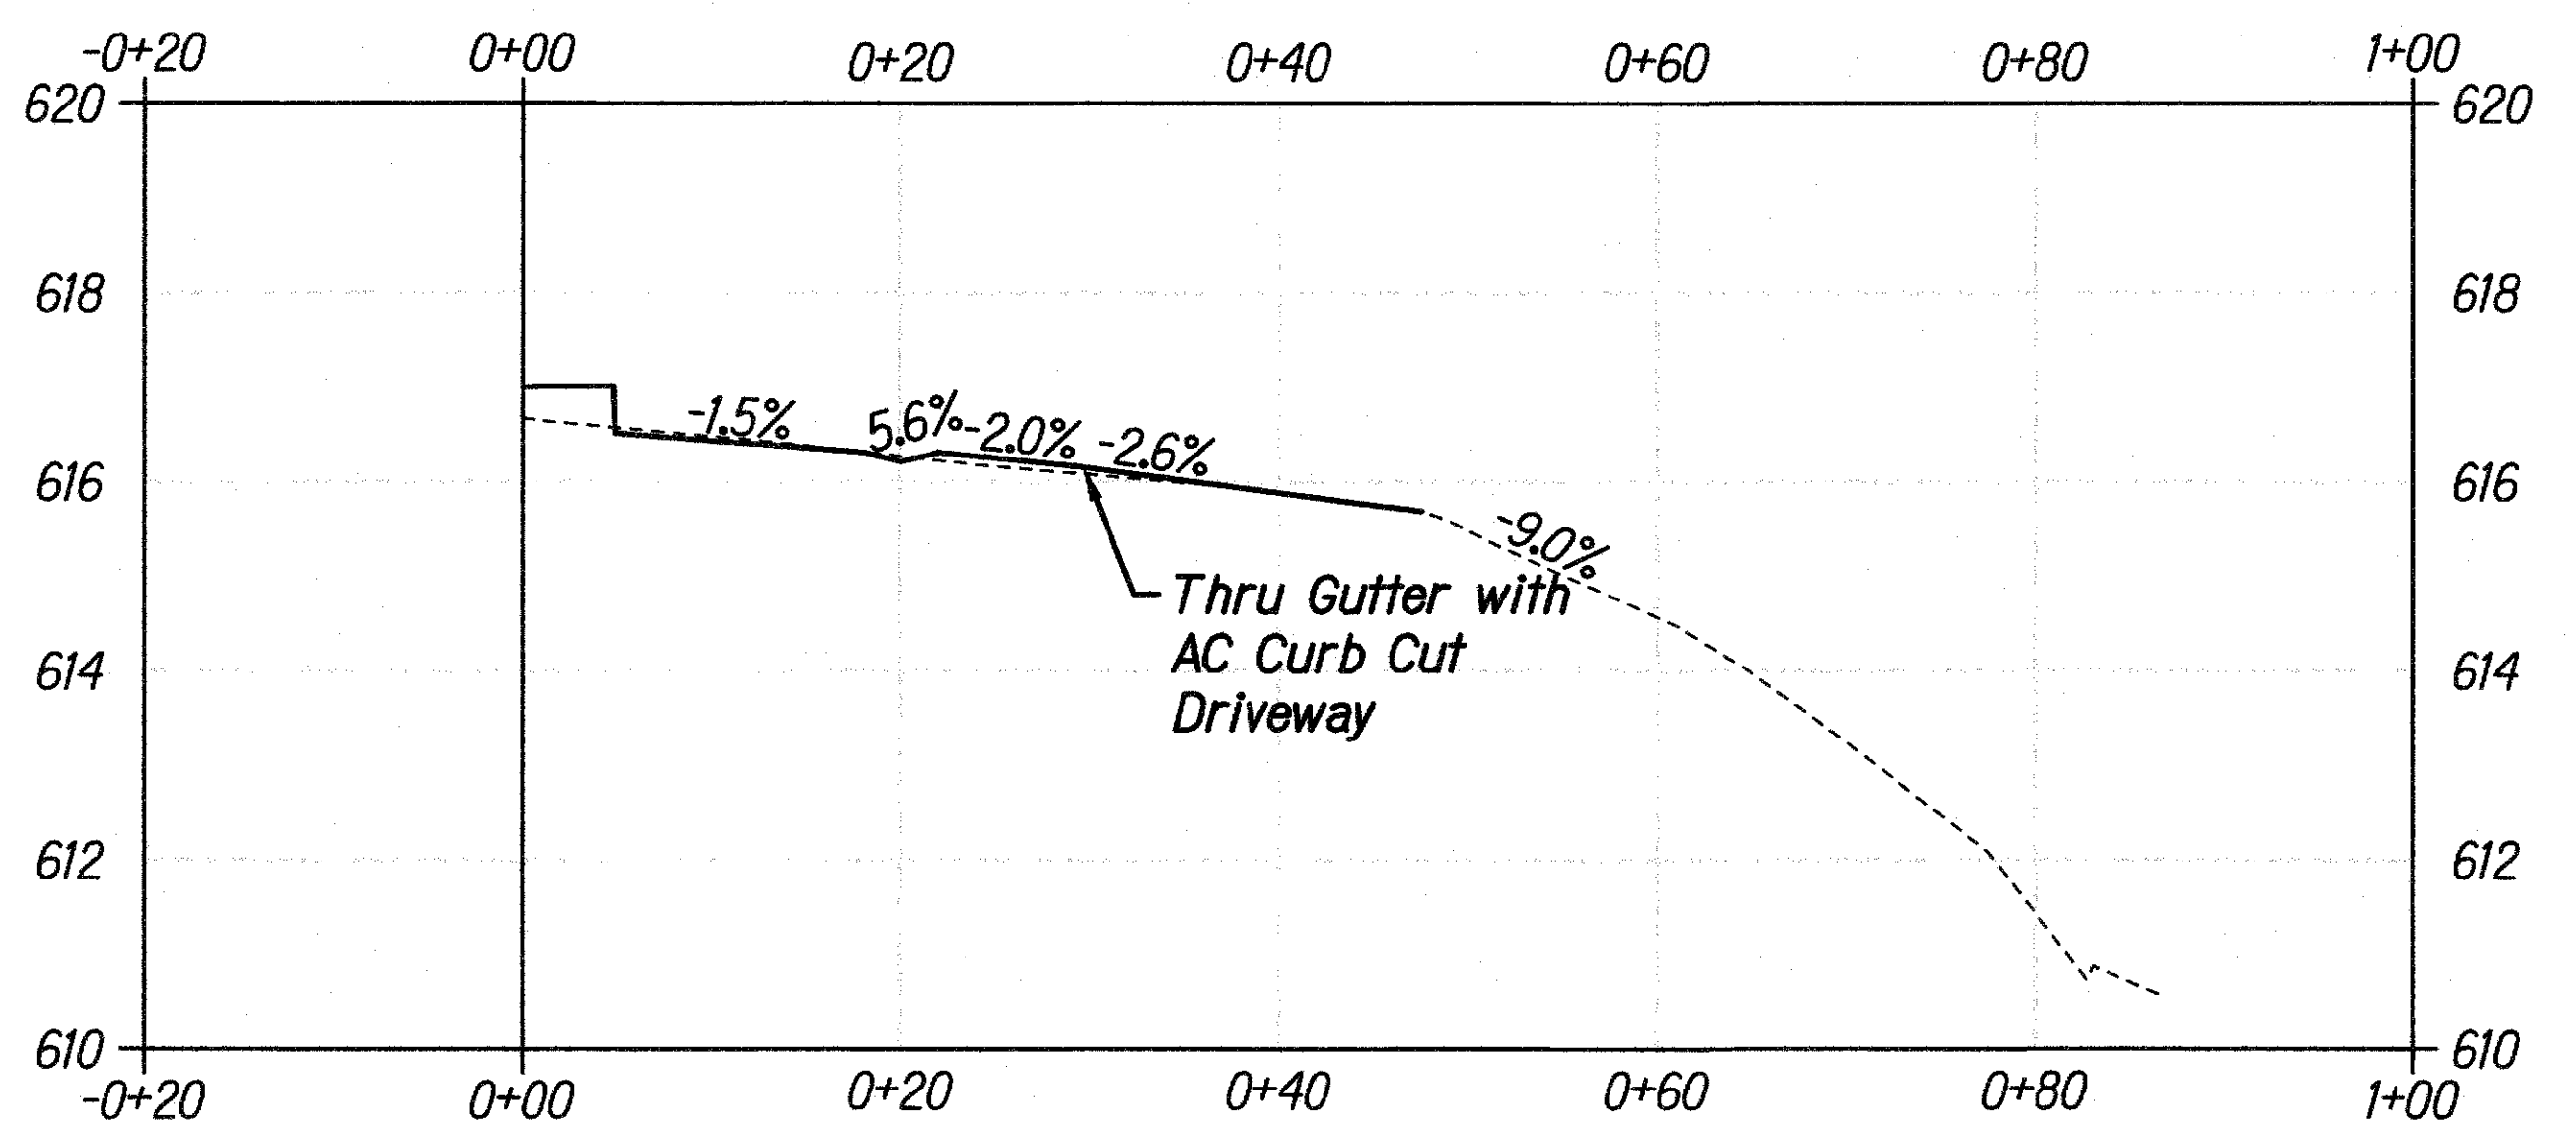

DRIVEWAY 4
Scale: 1" = 10'

0 10 20 30
HORIZ: 1" = 10' FEET



LICENSE EXPIRES 4/30/18
THIS WORK WAS PREPARED BY
ME OR UNDER MY SUPERVISION

STATE OF HAWAII
DEPARTMENT OF TRANSPORTATION
HIGHWAYS DIVISION

DRIVEWAY PLANS

*Keau-Pahoa Road Intersection
Improvements at Old Government Road
Federal-Aid Project No. HSIP-0130(031)*

Scale: None Date: August 2013

SHEET No. 1 OF 1 SHEETS

"AS-BUILT"