

STANDARD PLANS SUMMARY

FED. ROAD DIST. NO.	STATE	FED. AID PROJ. NO.	FISCAL YEAR	SHEET NO.	TOTAL SHEETS
HAWAII	HAW.	HSIP-0130(031)	2014	2	108

STANDARD PLAN NO.	TITLE	DATE
B-01	NOTES & MISCELLANEOUS DETAILS	05/31/07
B-03	BACKFILL DETAILS AT EARTH RETAINING STRUCTURES	05/31/07
B-12	PRESTRESSED CONCRETE PILES & COMPRESSION SPLICE CAN DETAILS	05/31/07
B-12A	PRESTRESSED CONCRETE PILES, PILE & COMPRESSION SPLICE CAN DETAILS & NOTES	05/31/07
B-12B	PILE INTERACTION DIAGRAM	05/31/07
B-13	PRESTRESSED CONCRETE PILE BUILD-UP DETAILS	05/31/07

D-01	CATTLE GATE	05/31/07
D-02	CHAIN LINK FENCE WITH TOPRAIL	05/31/07
D-03	CHAIN LINK FENCE WITHOUT TOPRAIL	05/31/07
D-04	WIRE FENCE WITH METAL POSTS	05/31/07
D-05	TYPICAL DETAILS OF CURBS AND/OR GUTTERS	05/31/07
D-06	TYPICAL DETAIL OF REINFORCED CONCRETE DROP DRIVEWAY	05/31/07
D-07	CENTERLINE AND REFERENCE SURVEY MONUMENTS	05/31/07
D-08	STREET SURVEY MONUMENT	05/31/07
D-15	CONCRETE SIDEWALK	05/31/07
D-16	P.C.C. BUS PAD	05/31/07
D-17	P.C.C. BUS PAD	05/31/07
D-18	P.C.C. PAVEMENT LAYOUT	05/31/07
D-19	P.C.C. PAVEMENT W/ PERMEABLE BASE JOINT DETAILS	05/31/07
D-20	P.C.C. PAVEMENT W/ PERMEABLE BASE JOINT DETAILS	05/31/07
D-21	P.C.C. LONGITUDINAL JOINT DETAILS	05/31/07
D-22	P.C.C. CONNECTION TO CURBS AND GUTTERS	05/31/07
D-23	JOINTS	05/31/07

L-01	TREE PLANTING	08/16/06
L-02	TREE PLANTING	08/16/06
L-03	TREE TRANSPLANTING	08/16/06
L-04	PALM PLANTING	08/16/06
L-05	SHRUB PLANTING	08/16/06
L-06	LANDSCAPE DETAILS	08/16/06
L-07	LANDSCAPE DETAILS	08/16/06
L-08	LANDSCAPE DETAILS	08/16/06
L-09	LANDSCAPE DETAILS	08/16/06
L-10	LANDSCAPE DETAILS	08/16/06
L-11	PLANTING NOTES	08/16/06
L-12	IRRIGATION DETAILS	08/16/06
L-13	IRRIGATION DETAILS	08/16/06
L-14	IRRIGATION DETAILS	08/16/06
L-15	IRRIGATION DETAILS	08/16/06
L-16	IRRIGATION DETAILS	08/16/06
L-17	IRRIGATION DETAILS	08/16/06
L-18	IRRIGATION DETAILS	08/16/06
L-19	IRRIGATION DETAILS	08/16/06
L-20	IRRIGATION DETAILS	08/16/06
L-21	IRRIGATION DETAILS	08/16/06
L-22	IRRIGATION DETAILS	08/16/06
L-23	IRRIGATION DETAILS	08/16/06
L-24	IRRIGATION NOTES	08/16/06

STANDARD PLAN NO.	TITLE	DATE
H-01A	TYPE A CATCH BASIN	05/31/07
H-01B	TYPE B CATCH BASIN	05/31/07
H-01C	TYPE C CATCH BASIN	05/31/07
H-01D	TYPE D CATCH BASIN	05/31/07
H-01E	CATCH BASIN SECTIONS	05/31/07
H-02A	TYPE A1 CATCH BASIN	05/31/07
H-02B	TYPE B2 CATCH BASIN	05/31/07
H-02C	TYPE C1 CATCH BASIN	05/31/07
H-02D	TYPE D1 CATCH BASIN	05/31/07
H-02E	CATCH BASIN SECTION	05/31/07
H-03	TYPE A, B, AND C STORM DRAIN MANHOLE	05/31/07
H-04	TYPE D STORM DRAIN MANHOLE	05/31/07
H-05	TYPICAL REINFORCING DETAILS FOR DRAINAGE STRUCTURES	05/31/07
H-06	TYPICAL REINFORCING DETAILS FOR DRAINAGE STRUCTURES	05/31/07
H-07	CATCH BASIN AND MANHOLE CASTINGS	05/31/07
H-08	TYPE 1A-9 AND 1A-9P GRATED DROP INLET	05/31/07
H-09	TYPE 2A-9 AND 2A-9P GRATED DROP INLET	05/31/07
H-10	TYPE A-9 OR A-9P STEEL FRAMES	05/31/07
H-11	TYPE A-9 AND A-9P STEEL GRATES	05/31/07
H-12	TYPE 6164P AND 1211214P GRATED DROP INLET	05/31/07
H-13	TYPE 61616P AND 1211216P GRATED DROP INLET	05/31/07
H-14	TYPE 61214P GRATED DROP INLET	05/31/07
H-15	TYPE 1211214, 1211216P, 1211216P STEEL FRAME AND GRATES	05/31/07
H-16	TYPE 61614, 61614P, 61616, 61616P STEEL FRAME AND GRATES	05/31/07
H-17	TYPE 61214 STEEL FRAMES AND GRATES	05/31/07
H-18	TYPE 61214P STEEL GRATES	05/31/07
H-19	TYPE 61614B STEEL FRAME AND GRATES	05/31/07
H-20	CEMENT RUBBLE MASONRY STRUCTURES	05/31/07
H-21	CONCRETE AND CEMENT RUBBLE MASONRY STRUCTURES	05/31/07
H-22	INLET/OUTLET STRUCTURE	05/31/07
H-23	INLET/OUTLET STRUCTURE	05/31/07
H-24	FLARED END SECTION FOR CULVERTS	05/31/07
H-25	FLARED END SECTION FOR CULVERTS	05/31/07
H-26	CONCRETE SPILLWAY INLET	05/31/07
H-27	CAP COUPLING DETAILS STANDARD JOINT	05/31/07
H-28	REINFORCED CONCRETE COLLAR & JACKET	05/31/07
H-29	UNDERDRAIN CLEANOUT STEEL FRAME AND COVER	05/31/07
H-30	UNDERDRAIN CONNECTION TO DRAINAGE STRUCTURE	05/31/07

TE-01	SIGN HEIGHT AND LOCATION	07/11/08
TE-1A	SIGN INSTALLATION	07/11/08
TE-02A	GALVANIZED FLANGED CHANNEL SIGN POST MOUNTING	05/31/07
TE-02B	GALVANIZED FLANGED CHANNEL SIGN POST MOUNTING	05/31/07
TE-02C	GALVANIZED FLANGED CHANNEL SIGN POST MOUNTING	05/31/07
TE-03A	GALVANIZED SQUARE TUBE SIGN POST MOUNTING	05/31/07
TE-03B	GALVANIZED SQUARE TUBE SIGN POST MOUNTING	05/31/07
TE-04	REGULATORY SIGNS	07/11/08
TE-05	WARNING SIGNS	07/11/08
TE-06	MISCELLANEOUS SIGNS	07/11/08
TE-07	CONSTRUCTION SIGNS	07/11/08
TE-08	MISCELLANEOUS INTERSECTION SIGNS	07/11/08

STANDARD PLAN NO.	TITLE	DATE
TE-09	BIKE ROUTE SIGN & SUPPLEMENTARY PLATES	07/11/08
TE-10	INTERSTATE ROUTE MARKER	07/11/08
TE-11	STATE ROUTE MARKER AND AUXILIARY MARKERS	07/11/08
TE-12	STATE ROUTE MARKER AND BORDER DETAIL FOR GUIDE SIGNS	07/11/08
TE-12A	ROUTE SIGN ASSEMBLIES	07/11/08
TE-13	STREET NAME SIGN ON MAST ARM	07/11/08
TE-14	MISCELLANEOUS REFLECTOR MARKERS	07/11/08
TE-15	OBJECT MARKERS	07/11/08
TE-16	MILE POSTS	07/11/08
TE-17A	CANTILEVER OVERHEAD SIGN ELEVATION & DETAILS	05/31/07
TE-17B	CANTILEVER SIGN FRAME DETAIL AND SECTION	05/31/07
TE-17C	CANTILEVER SIGN FRAME DETAIL	05/31/07
TE-17D	CANTILEVER SIGN FRAME SECTION	05/31/07
TE-17E	CANTILEVER SIGN FRAME DETAILS	05/31/07
TE-18A	TWO POST OVERHEAD SIGN FRAME ELEVATIONS	05/31/07
TE-18B	TWO POST SIGN FRAMING PLAN SECTION	05/31/07
TE-18C	TWO POST SIGN FRAMING SECTIONS AND DETAILS	05/31/07
TE-18D	TWO POST SIGN FRAME DETAILS	05/31/07
TE-18E	TWO POST SIGN FRAME DETAILS	05/31/07
TE-19A	OVERHEAD SIGN FRAMING SCHEDULE	05/31/07
TE-19B	SIGN POST DRILLED SHAFT FOUNDATION	05/31/07
TE-19C	SPREAD FOOTING	05/31/07
TE-19D	SIGN FRAME FOUNDATION SCHEDULE	05/31/07
TE-19D1	SIGN FRAME FOUNDATION SCHEDULE	05/31/07
TE-19D2	SIGN FRAME FOUNDATION SCHEDULE	05/31/07
TE-19D3	SIGN FRAME FOUNDATION SCHEDULE	05/31/07
TE-19D4	SIGN FRAME FOUNDATION SCHEDULE	05/31/07
TE-19D5	SIGN FRAME FOUNDATION SCHEDULE	05/31/07
TE-19E	ANCHORAGE DETAILS	05/31/07
TE-19F	ANCHORAGE DETAILS	05/31/07
TE-19G	MISCELLANEOUS SIGN FRAME DETAILS	05/31/07
TE-19H	LUMINAIRE WALKWAY SUPPORT	05/31/07
TE-19J	FIXED MESSAGE LUMINAIRE SUPPORT	05/31/07
TE-19K	MISCELLANEOUS SIGN DETAILS	05/31/07
TE-19L	MISCELLANEOUS SIGN DETAILS	05/31/07
TE-19M	MISCELLANEOUS SIGN FRAME DETAILS	05/31/07
TE-20	SUPPORTS FOR GROUND MOUNTED GUIDE SIGN	05/31/07
TE-20A	SUPPORTS FOR GROUND MOUNTED GUIDE SIGN	05/31/07
TE-20B	SUPPORTS FOR GROUND MOUNTED GUIDE SIGN	05/31/07
TE-20C	SUPPORTS FOR GROUND MOUNTED GUIDE SIGN	05/31/07
TE-21A	SIGN BREAKAWAY MOUNTS	05/31/07
TE-21B	SIGN BREAKAWAY MOUNTS	05/31/07
TE-22	LAMINATED ALUMINUM SIGN PANELS (OVERHEAD)	05/31/07
TE-23	LAMINATED ALUMINUM SIGN PANELS (GROUND MOUNTED)	07/11/08
TE-24	SOLID ALUMINUM EXTRUDED SIGN PANEL AND ACCESSORY DETAILS	05/31/07

STANDARD PLAN NO.	TITLE	DATE
TE-25	GUIDE SIGNS LUMINAIRE MOUNTINGS	05/31/07
TE-26	RAISED PAVEMENT MARKERS AND STRIPING	07/11/08
TE-27	RAISED PAVEMENT MARKERS AND STRIPING	07/11/08
TE-28	ENTRANCE AND EXIT PAVEMENT MARKINGS	07/11/08
TE-28A	MISCELLANEOUS PAVEMENT MARKINGS	07/11/08
TE-29	PAVEMENT ARROWS AND SYMBOLS	07/11/08
TE-30	PAVEMENT ALPHABETS, NUMBERS & SYMBOLS	07/11/08
TE-31	PAVEMENT ALPHABETS, NUMBERS & SYMBOLS	07/11/08
TE-32	TYPE I & II TRAFFIC SIGNAL SYSTEM MISC. DETAILS	05/31/07
TE-33	TYPE II TRAFFIC SIGNAL SYSTEM	08/16/06
TE-33A1	TYPE II TRAFFIC SIGNAL STANDARD	05/31/07
TE-33A2	TYPE II TRAFFIC SIGNAL STANDARD	05/31/07
TE-34	LOOP DETECTOR DETAILS	07/11/08
TE-35	LOOP DETECTORS & DUCT DETAILS	07/11/08
TE-36	TRAFFIC SIGNAL DETAILS	07/11/08
TE-37	PULLBOX & COVER DETAILS	07/11/08
TE-37A	TYPE "A" TRAFFIC PULLBOX	05/31/07
TE-37B	TYPE "A" TRAFFIC PULLBOX REINFORCING	05/31/07
TE-37C	TYPE "B" TRAFFIC PULLBOX	05/31/07
TE-37D	TYPE "B" TRAFFIC PULLBOX REINFORCING	05/31/07
TE-37E	TYPE "B" TRAFFIC PULLBOX FOUNDATION	05/31/07
TE-37F	TYPE "C" TRAFFIC PULLBOX	05/31/07
TE-37G	TYPE "C" TRAFFIC PULLBOX REINFORCING	05/31/07
TE-37H	TYPE "C" TRAFFIC PULLBOX FOUNDATION	05/31/07
TE-37J	TRAFFIC PULLBOX COVER AND DETAILS	05/31/07
TE-38	TYPE III TRAFFIC SIGNAL STANDARD	05/31/07
TE-38A1	TYPE III TRAFFIC SIGNAL STANDARD	05/31/07
TE-38A2	TYPE III TRAFFIC SIGNAL STANDARD	05/31/07
TE-39	METAL GUARDRAIL CONNECTION TO CONCRETE BARRIER	07/11/08
TE-40	CONCRETE BARRIER TRANSITION	05/31/07
TE-40A	CONCRETE BARRIER TRANSITION SECTIONS	05/31/07
TE-41	GUARDRAIL TYPE 4 (RIGID BARRIER)	05/31/07
TE-42	PORTABLE CONCRETE BARRIER	05/31/07
TE-43	PORTABLE CONCRETE BARRIER	05/31/07
TE-44	GUARDRAIL TYPE 4 MISCELLANEOUS DETAILS	07/11/08
TE-45	BARRICADES	07/11/08
TE-46	DELINEATION & PAVEMENT MARKINGS AT NARROW BRIDGES	07/11/08
TE-47	HIGHWAY LIGHT STANDARD	05/31/07

NOTE:
STANDARD PLANS APPLICABLE TO THIS PROJECT ARE INDICATED BY A "●" NEXT TO THE STANDARD PLAN NO. (For Example: D-07 ●).



LICENSE EXPIRES 4/30/14
THIS WORK WAS PREPARED BY ME OR UNDER MY SUPERVISION

CP28

02/07/14
Deleted Standard Plans TE-02A, TE-02B, and TE-02C

STATE OF HAWAII
DEPARTMENT OF TRANSPORTATION
HIGHWAYS DIVISION

STANDARD PLANS SUMMARY

Kaau-Pahoa Road Intersection
Improvements at Old Government Road
Federal-Aid Project No. HSIP-0130(031)

Scale: None Date: August 2013

SHEET No. 1 OF 1 SHEETS

NOTES FOR CONSTRUCTION WITHIN STATE RIGHT-OF-WAY

PUBLIC HEALTH, SAFETY, AND CONVENIENCE NOTES

FED. ROAD DIST. NO.	STATE	FED. AID PROJ. NO.	FISCAL YEAR	SHEET NO.	TOTAL SHEETS
HAWAII	HAW.	HSIP-0130(031)	2014	4	108

- The Contractor shall obtain a Permit to Perform Work Upon State Highway from the Hawaii District, State Highways, at 50 Makaala Street, Hilo, prior to commencement of work within the State highway right-of-way.
- Construction and restoration of all existing highway facilities within State right-of-way shall be done in accordance with all applicable sections of the 2005 Standard Specifications for Road and Bridge Construction, and the Specifications for Installation of Miscellaneous Improvements within State Highways, of the State Highways Division.
- Work may be performed only between the hours of 8:30 a.m. and 3:00 p.m., Monday through Friday, except holidays, unless otherwise permitted by the Engineer.
- The Contractor shall provide, install, and maintain all necessary signs, lights, flares, barricades, markers, cones, and other protective items, and shall take necessary precautions for the protection, convenience, and safety of public traffic. All such protective facilities and precautions to be taken shall conform with the "Administrative Rules of Hawaii Governing the Use of Traffic Control Devices at Work Sites on or Adjacent to Public Streets and Highways", adopted by the Director of Transportation, and the current U.S. Federal Highway Administration "Manual on Uniform Traffic Control Devices for Streets and Highways, Part VI - Standards and Guides for Traffic Controls for Street and Highway Construction, Maintenance, Utility and Incident Management Operations" and NCHRP 350.
- No material and/or equipment shall be stockpiled or otherwise stored within the highway right-of-way, except at locations designated in writing and approved by the Engineer.
- The Contractor shall be required to provide adequate, safe, non-skid bridging material over the trench, including shoring, when trenching in pavement areas to handle all types of vehicular traffic. Smooth riding tapers shall be provided for pavement transitions and advanced warning signs shall be posted. Prior to installing such bridging material, the Contractor shall submit drawings stamped by a licensed structural engineer to the Engineer for acceptance.
- No trench shall be opened more than 200 feet in advance of the installed and tested pipe and/or ductline. No jumps or spaces will be permitted unless approved in writing by the Engineer.
- Drainage within the project limits shall be maintained at all times to allow freeflow.

- All regulatory, guide and construction signs and barricades shall be high intensity reflective sheeting.
- All fill slopes that do not meet the clear zone requirements set forth by the latest edition of the AASHTO Roadside Design Guide shall be shielded by NCHRP Report 350 and HDOT approved devices.
- The Contractor shall inform the State DOT Highway Hawaii District Permit Office at 933-8866 at least five (5) working days prior to any lane closures or changes to lane closures.

COLD PLANING NOTES

- All saw cutting work shall be considered incidental to Cold Planing.
- The Contractor shall compact the existing aggregate base in accordance with Section 304 - Aggregate Base Course. This preparation work shall be considered incidental to the new Asphalt Concrete Base Course, and will not be paid for separately.
- If a vertical pavement drop-off exists at the end of each day's cold planing and paving, the Contractor shall provide a wedge with a 48:1 transition taper for transverse drop-off and no steeper than 6:1 for longitudinal drop-off, as approved by the Engineer. This work shall be considered incidental to Cold Planing.
- The Contractor shall lower manholes prior to Cold Planing, backfill with hot mix and re-adjust after final paving. This work shall be considered incidental to Manhole Adjustments.
- Unless otherwise shown on plans, the Contractor shall remove asphalt concrete from existing gutters and swales and shall exercise caution in doing so. The Contractor shall be held liable for any damage caused to the gutters and swales by this removal. This work shall be considered incidental to Cold Planing.

- The Contractor shall observe and comply with all Federal, State, and Local laws required for the protection of public health and safety and environmental quality.
- The Contractor, at his own expense, shall keep the project and its surrounding areas free from dust nuisance. The work shall be in conformance with the air pollution control standards and regulations of the State Department of Health. The County may require supplementary measures as necessary.
- No Contractor shall perform any trenching operation so as to cause falling rocks, soil or debris in any form to fall, slide or flow onto adjoining properties, streets or natural water-courses. Should such violations occur, the cost incurred for any remedial action by the Director, DOT shall be payable by the Contractor.
- The Contractor shall provide, install and maintain all necessary signs, lights, flares, barricades, markers, cones, and other protective facilities and shall take all necessary precautions for the protection, convenience, and safety of the public. The Contractor shall apply for a construction permit with a noise pollution control plan if work should extend beyond permitted working hours.

ARCHAEOLOGICAL NOTES:

- In the event that an archaeological or historic structure within the work area is inadvertently damaged during construction, cease work in the vicinity of the site and notify the Engineer and the State Historic Preservation Division (SHPD) of the Department of Land and Natural Resources of the damage. SHPD will determine the appropriate mitigation measures.
- In the event that a previously unknown archaeological feature is exposed by construction, cease work in the vicinity of the new feature and notify the Engineer, the SHPD, and the Hawaii County Planning Department of the new discovery.
- In the event that previously unknown human remains are exposed by construction, cease all work in the area of the remains, and protect the area with an appropriate material. Notify HDOT and the SHPD at 692-8015.
- If any lava tube is uncovered during earthwork operations, the Contractor shall cease all ground work in the area and immediately notify the Archaeological Monitor and the Engineer. With or without the help of the Archaeological Monitor, the Engineer will assess the situation. If the Engineer has any doubts as to the extent and/or significance of the discovery, the Engineer will contact the appropriate regulatory agency (e.g., State Historic Preservation Division).



LICENSE EXPIRES 4/30/14
THIS WORK WAS PREPARED BY
ME OR UNDER MY SUPERVISION

[Signature]

02/07/14	Added note 4 to Archaeological Notes
02/07/14	Amended note 6 of Notes for Construction Within State Right-of-Way
STATE OF HAWAII DEPARTMENT OF TRANSPORTATION HIGHWAYS DIVISION	
CONSTRUCTION NOTES - 1	
Keaau-Pahoa Road Intersection Improvements at Old Government Road Federal-Aid Project No. HSIP-0130(031)	
Scale: None	Date: August 2013
SHEET No. 2 OF 3 SHEETS	

GENERAL NOTES FOR TRAFFIC CONTROL PLAN

1. The Permittee Shall Make Minor Adjustments At Intersections, Driveways, Bridges, Structures, Etc., To Fit Field Conditions.
2. Cones Or Delineators Shall Be Extended To A Point Where They Are Visible To Approaching Traffic.
3. Traffic Control Devices Shall Be Installed Such That The Sign Or Device Farthest From The Work Area Is Placed First. The Others Shall Then Be Placed Progressively Toward The Work Area.
4. Regulatory And Warning Signs Within The Construction Zone That Are In Conflict With The Traffic Control Plans Shall Be Removed Or Covered.
5. Flaggers And/Or Police Officers Shall Be In Sight Of Each Other Or In Direct Communication At All Times.
6. When Required By The Issuing Office, The Permittee Shall Install A Flashing Arrow Signal As Shown On The Traffic Control Plans.
7. Sign Spacing (D), Taper Lengths (T) And Spacing Of Cones Or Delineators Shall Be As Shown In Table 1, Unless Otherwise Noted On The Traffic Control Plans.
8. All Traffic Lanes Shall Be A Minimum Of 10-Feet Wide.
9. All Construction Warning Signs Shall Be Promptly Removed Or Covered Whenever The Message Is Not Applicable Or Not In Use.
10. The Backs Of All Signs Used For Traffic Control Shall Be Appropriately Covered To Preclude The Display Of Inapplicable Sign Messages (I.E., When Signs Have Messages On Both Faces).
13. Driveways Shall Be Kept Open Unless The Owners Of The Property Using The Right-Of-Way Are Otherwise Provided For Satisfactorily. Further, The Permittee Shall Control Traffic Going In And Out Of Driveways.
14. Buffer And Taper Areas On Approach To Any Work Area Shall Be Kept Clear Of Vehicles And Equipment.
15. At The End Of Each Day's Work, Or As Soon As The Work Is Completed, The Permittee Shall Remove All Traffic Control Devices No Longer Needed To Permit Free And Safe Passage Of Public Traffic. Removal Shall be In The Reverse Order Of Installation.
16. Replace Existing Faded Or Obliterated Pavement Markings That Are Necessary For Safe Traffic Flow In The Construction Area, With Temporary Or Permanent Markings Before Opening The Roadway To Public Traffic Each Day.
17. All Work Zone Traffic Control Devices Shall Comply With The "Statewide Guideline For Work Zone Traffic Control Devices," Dated September 13, 2000.
18. Construction Lasting Three (3) Days Or Longer Throughout The Project Corridor Shall Require Long-Term Construction Warning Signs And Regulatory Speed Limit Signs, See The HDOT Work Zone Signing Plan, Notes & Details.

GENERAL NOTES FOR TRAFFIC CONTROL PLAN (Cont'd.)

19. Work May Be Performed Only Between The Hours Of 8:30 a.m. And 3:00 p.m., Monday Through Friday, Except State Holidays, Unless When Otherwise Approved In Writing By The HDOT Director.
During Work Hours, Written Approval By The HDOT Director Shall Be Required For Any Of The Following:
 - Street Closures
 - Ramp Closures
 - Lane Closures Of More Than One (1) Lane.
20. The Contractor Shall Submit The Site-Specific Traffic Control Plan(s) Intended For Use During Construction To The State Of Hawaii Department Of Transportation's District Engineer, With The Traffic Notification, A Minimum Of Three (3) Weeks Prior To The Scheduled Start Of The Associated Construction Activities For Review And Approval. Construction May Not Proceed Until The District Engineer Has Approved The Site-Specified Traffic Control Plan(s).
21. Include A Signed Certification Statement Affirming That The Site-Specific Traffic Control Plan(s) Submitted To HDOT Has Been Prepared Under The Direction Or Supervision Of A Licensed Professional Engineer, Is In Compliance With The Current HDOT And FHWA Standards, And Is An Appropriate Application Of Traffic Control Measures For The Construction Work To Be Performed.

TABLE 1 FOR TRAFFIC CONTROL PLAN							
POSTED SPEED LIMIT (M.P.H.)	SIGN SPACING (L) (FEET)	TAPER LENGTH (T) (FEET)		LONGITUDINAL BUFFER SPACE (B) (FEET)	SPACING OF CONES OR DELINEATORS (FEET)		
		W = 12' OR LESS *	W = GREATER THAN 12' *		TAPER	TANGENT	WORK AREA
20	250	200	W X 17	35	20	20	10
25	250	200	W X 17	55	25	25	10
30	250	250	W X 20	85	30	30	10
35	250	250	W X 20	120	35	35	10
40	500	350	W X 30	170	40	40	10
45	500	550	W X 45	220	45	45	10
50	1000	600	W X 50	280	50	50	10
55	1000	700	W X 55	335	55	55	10

* W = WIDTH OF LANE OR OFFSET

FED. ROAD DIST. NO.	STATE	FED. AID PROJ. NO.	FISCAL YEAR	SHEET NO.	TOTAL SHEETS
HAWAII	HAW.	HSIP-0130(031)	2014	20	108

DATE	_____
SURVEY PLOTTED BY	_____
ORIGINAL PLAN	_____
DESIGNED BY	_____
NOTED BY	_____
CHECKED BY	_____
NO.	_____




LICENSE EXPIRES 4/30/14
THIS WORK WAS PREPARED BY
ME OR UNDER MY SUPERVISION

[Signature]

02/07/14	Amended note 20 of General Notes for Traffic Control Plan
STATE OF HAWAII DEPARTMENT OF TRANSPORTATION HIGHWAYS DIVISION	
GENERAL NOTES FOR TRAFFIC CONTROL	
Kaaau-Pahoa Road Intersection Improvements at Old Government Road Federal-Aid Project No. HSIP-0130(031)	
Scale: None	Date: August 2013
SHEET No. 1 OF 1 SHEETS	

LAST UPDATE: February 07, 2014 @ 11:34:15 am

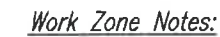

- TYPICAL DETAIL FOR CONSTRUCTION SIGNS
ON TWO LANE OR MULTILANE UNDIVIDED LOW SPEED HIGHWAY




THIS WORK WAS PREPARED BY
ME OR UNDER MY SUPERVISION

4928

SHEET No. 1 OF 1 SHEETS

FED. ROAD DIST. NO.	STATE	FED. AID PROJ. NO.	FISCAL YEAR	SHEET NO.	TOTAL SHEETS
HAWAII	HAW.	HSIP-0130(031)	2014	22	108

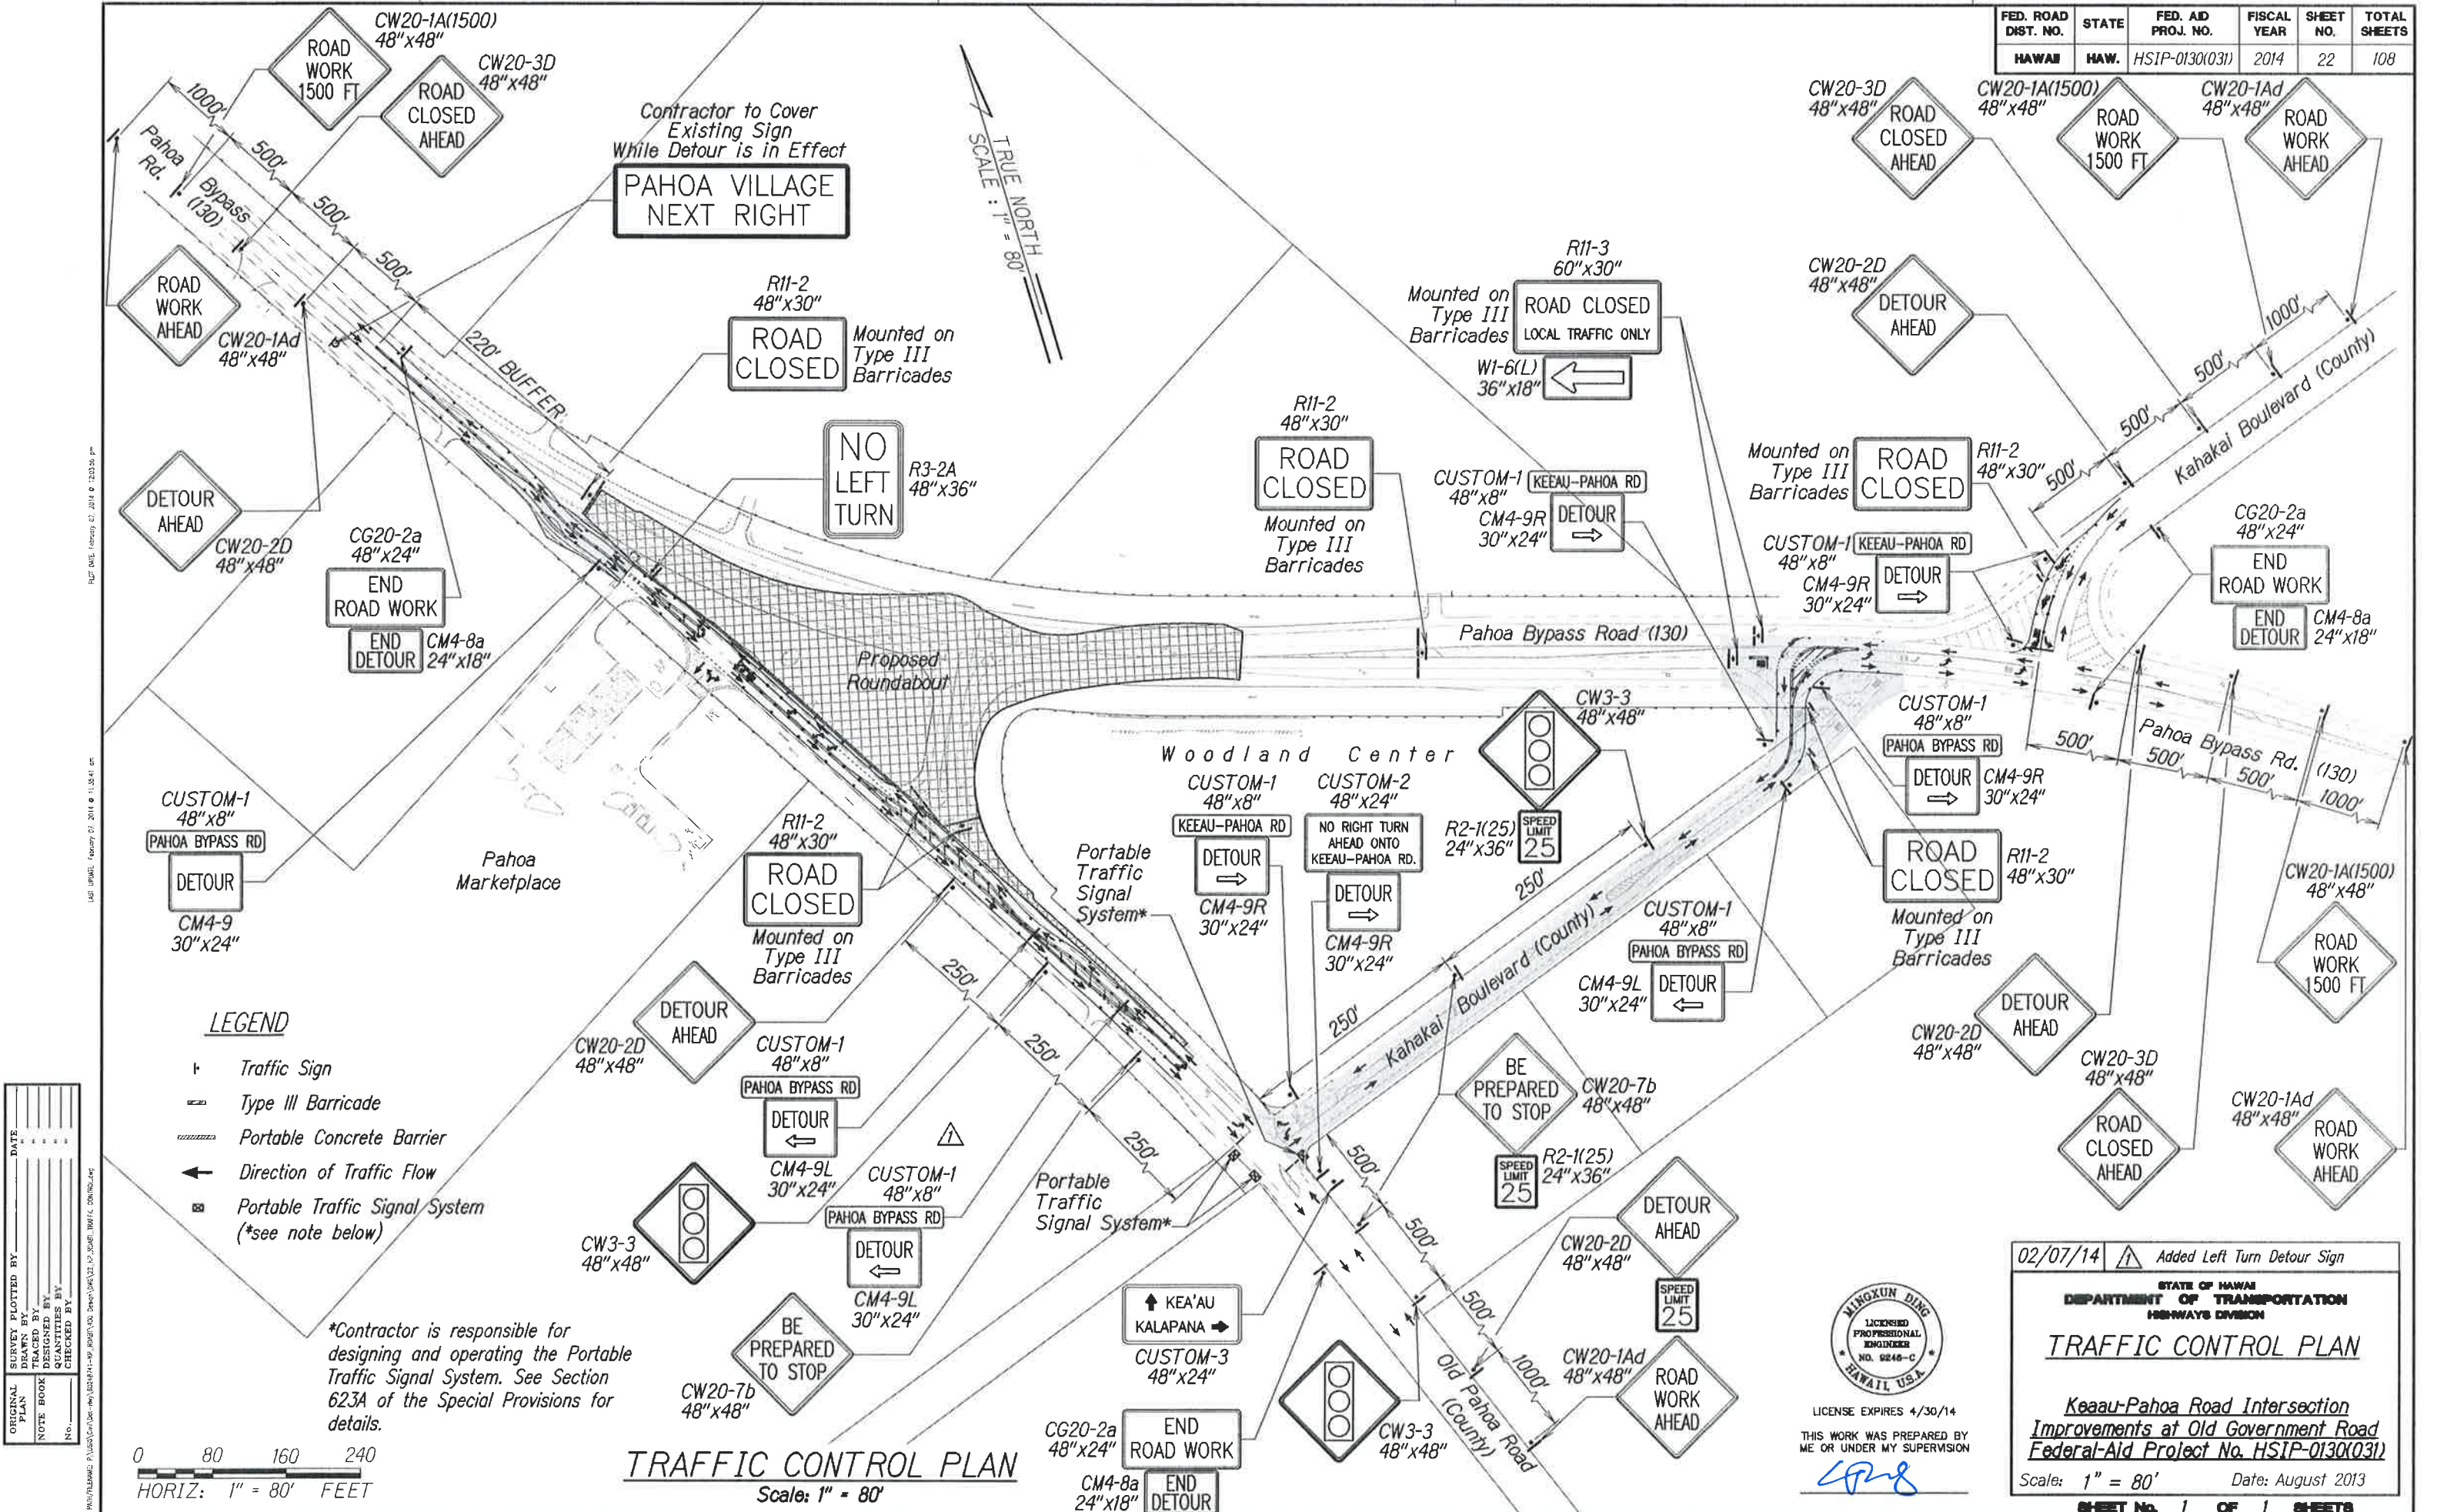

DATE	02/07/14
SURVEY PLOTTED BY	W. DING
DRAWN BY	W. DING
DESIGNED BY	W. DING
CHECKED BY	W. DING
ORIGINAL PLAN	NO.
NOTE BOOK	NO.
QUANTITIES BY	NO.
CHECKED BY	NO.

*Contractor is responsible for designing and operating the Portable Traffic Signal System. See Section 623A of the Special Provisions for details.







LICENSE EXPIRES 4/30/14
THIS WORK WAS PREPARED BY ME OR UNDER MY SUPERVISION

02/07/14
Added Left Turn Detour Sign




STATE OF HAWAII
DEPARTMENT OF TRANSPORTATION
HIGHWAYS DIVISION
TRAFFIC CONTROL PLAN

Kaaau-Pahoa Road Intersection
Improvements at Old Government Road
Federal-Aid Project No. HSIP-0130(031)
Scale: 1" = 80' Date: August 2013
SHEET No. 1 OF 1 SHEETS

FED. ROAD DIST. NO.	STATE	FED. AID PROJ. NO.	FISCAL YEAR	SHEET NO.	TOTAL SHEETS
HAWAII	HAW.	HSIP-0130(031)	2014	25	108

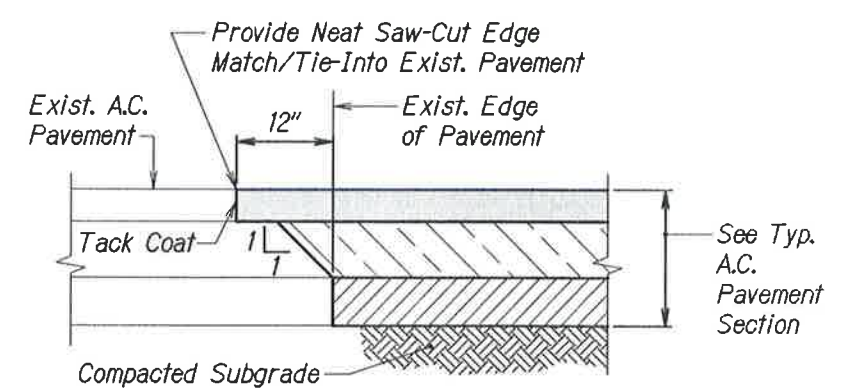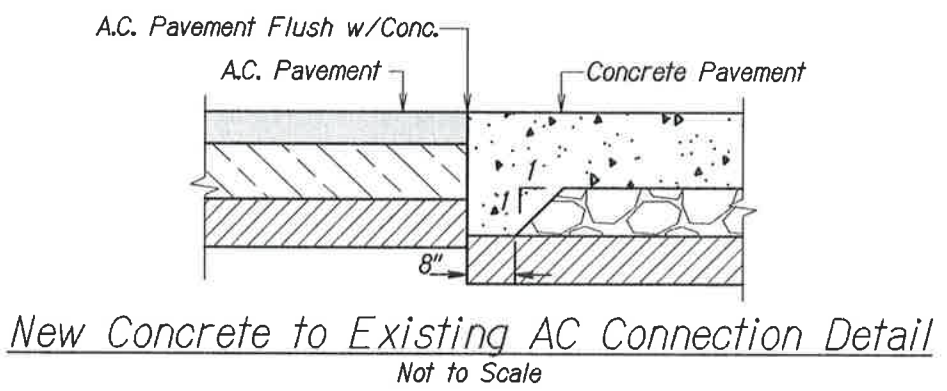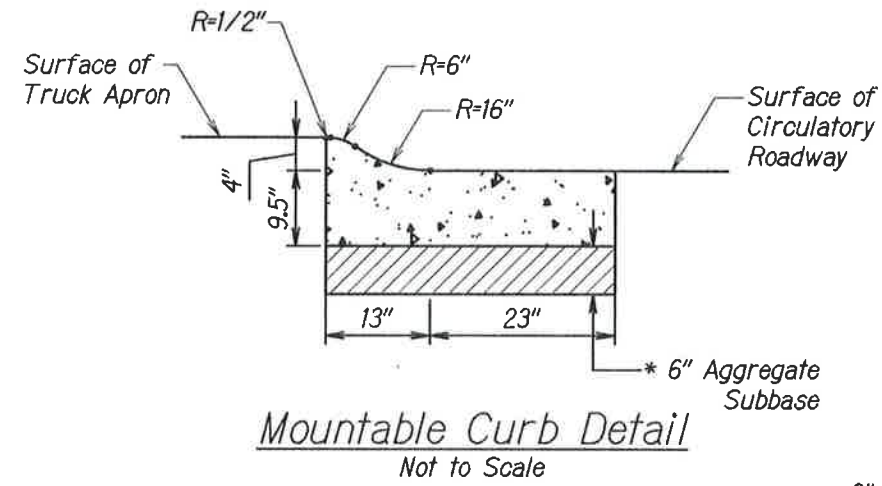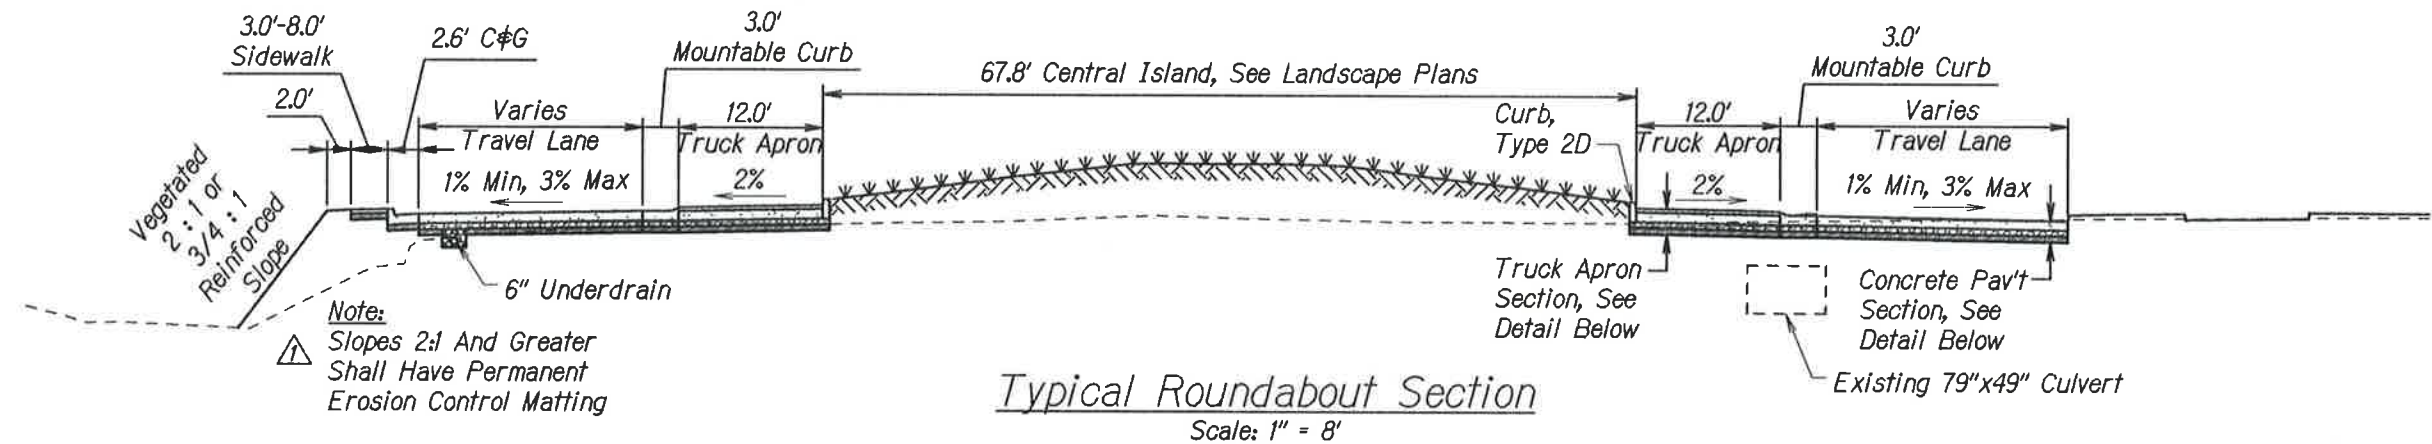

- Notes:**
1. New Construction Shall Be Equal Or Better Than Existing In Thickness & In Quality.
 2. Pavement Slope Shall Match Existing Pavement Slope So As To Provide Smooth Riding Connection.

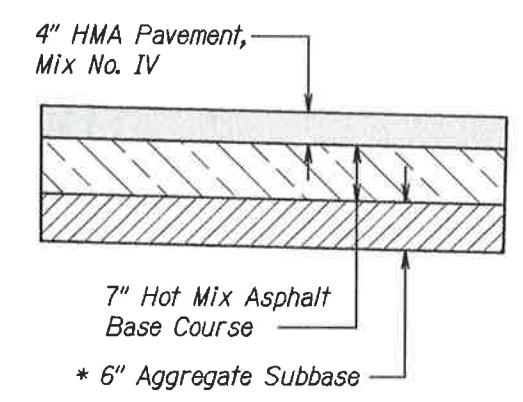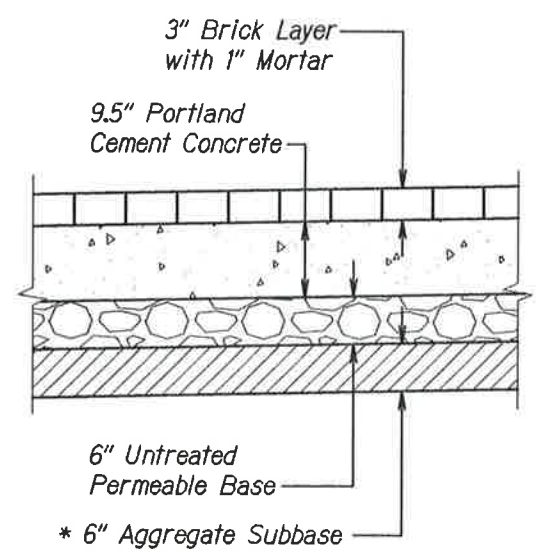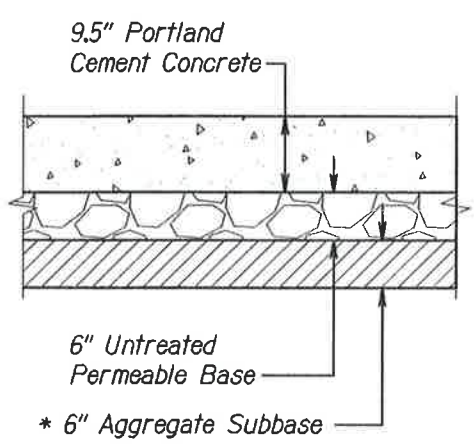



New AC to Existing AC Connection Detail
Not to Scale

Concrete Pavement Section Detail
Not to Scale

Truck Apron Section Detail
Not to Scale

AC Pavement Section Detail
Not to Scale

* The 6" Subbase Layer can be Eliminated in Areas where Hard Basalt Rock is Encountered at the depth where the Aggregate Subbase should be placed. However, the Untreated Permeable Base and Asphalt Concrete Base are still required. Refer to Boring Locations and Logs on Sheets B-1 to B-4 for Approximate Locations of Rock.

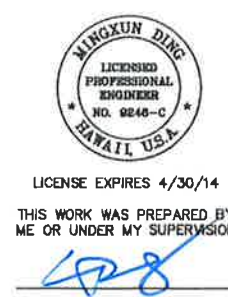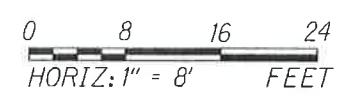

02/07/14

Revised Note

STATE OF HAWAII
DEPARTMENT OF TRANSPORTATION
HIGHWAYS DIVISION

TYPICAL SECTIONS
ROUNDBOUT & PAVEMENT STRUCTURE


Keaau-Pahoa Road Intersection
Improvements at Old Government Road
Federal-Aid Project No. HSIP-0130(031)

Scale: 1" = 8', NTS


Date: August 2013

SHEET No. 1 OF 5 SHEETS


FED. ROAD DIST. NO.	STATE	FED. AID PROJ. NO.	FISCAL YEAR	SHEET NO.	TOTAL SHEETS
HAWAII	HAW.	HSIP-0130(031)	2014	26	108

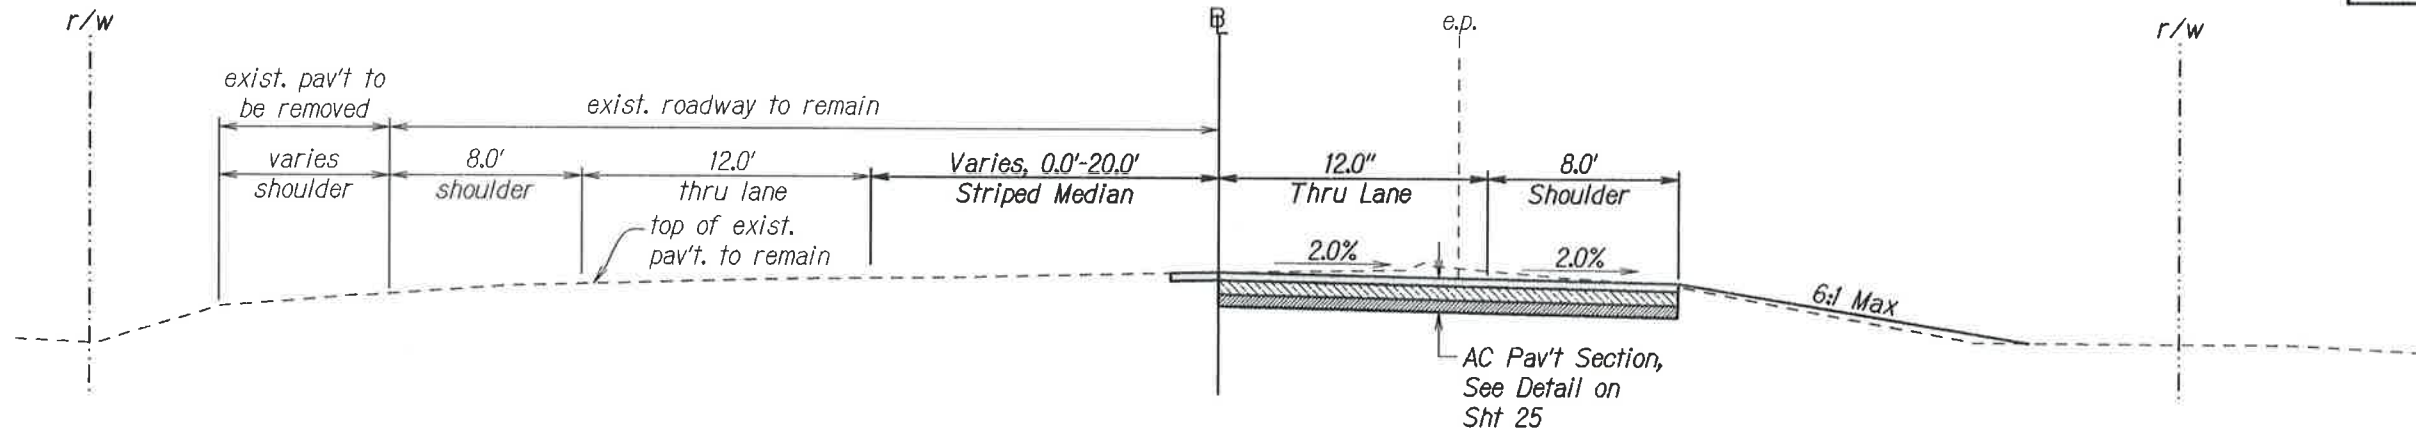

Route 130 New B
Sta 9+00 to Sta 13+38.96
Scale: 1" = 4'

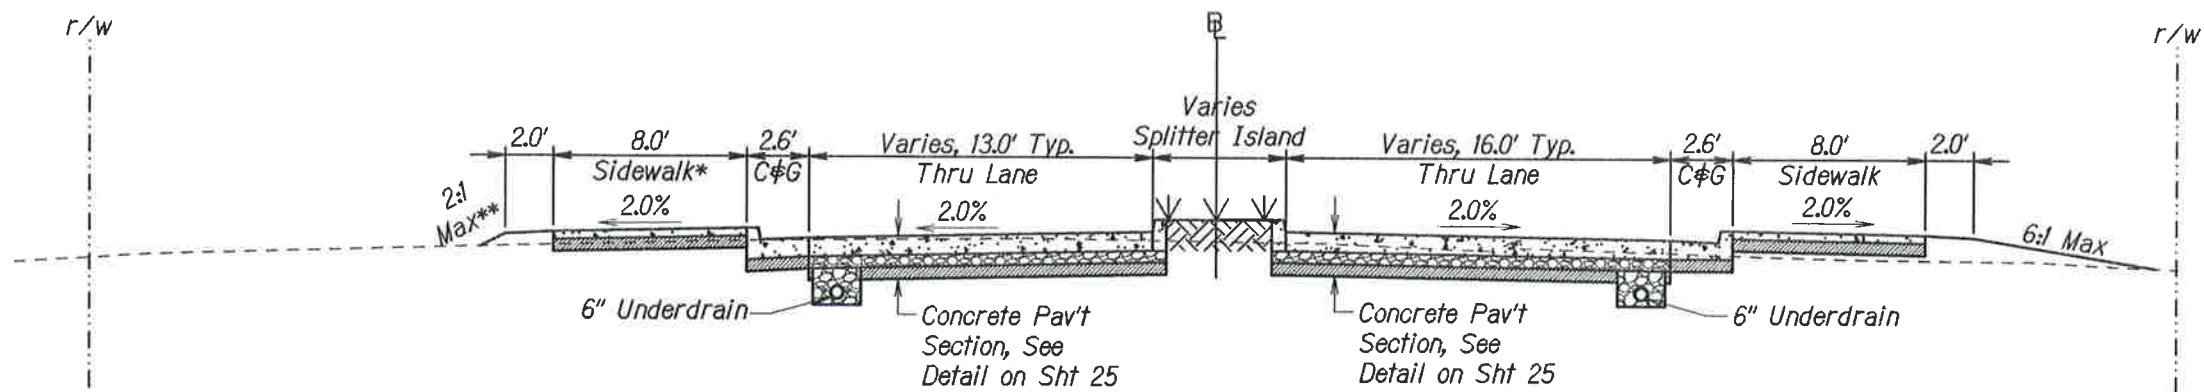

Route 130 New B
Sta 13+38.96 to Sta 16+37.36
Scale: 1" = 4'

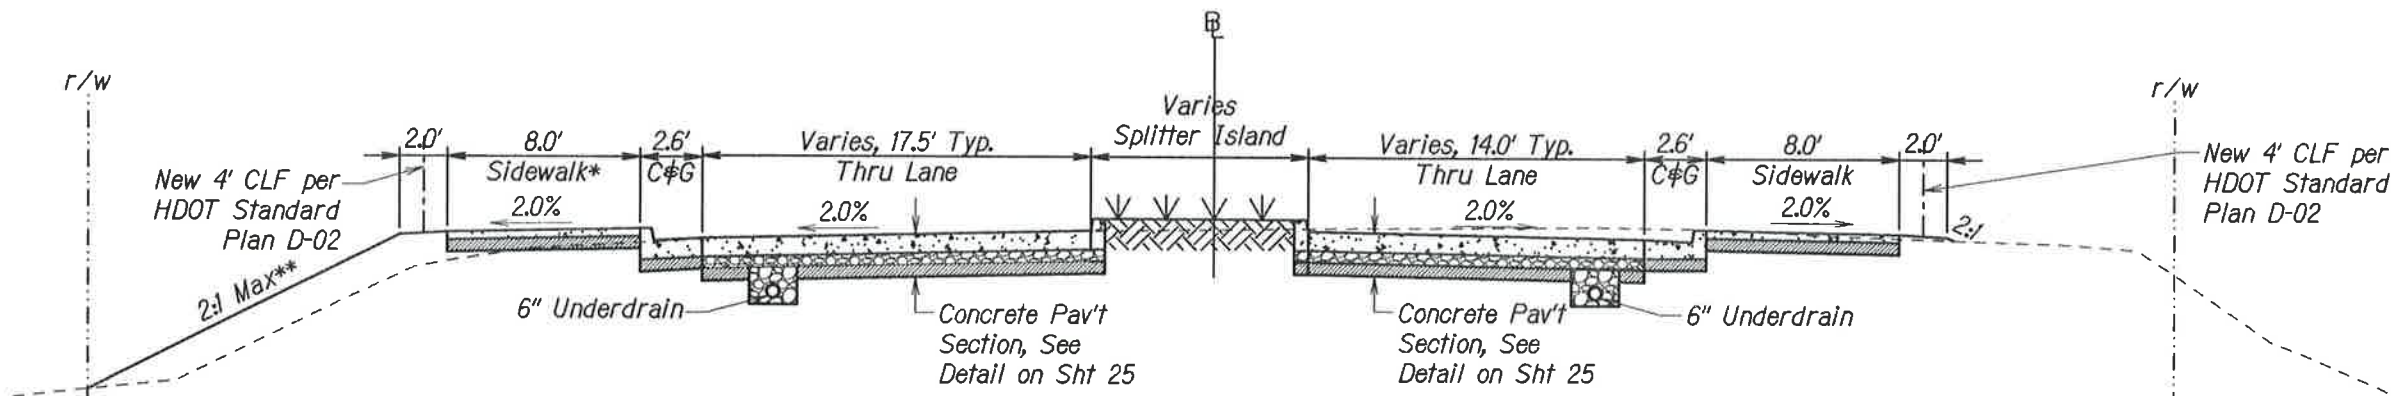

Route 130 New B
Sta 17+77.43 to Sta 20+16.45
Scale: 1" = 4'

* 3.0' Sidewalk from Sta 16+72.67 to Sta 17+49.79
** 3/4:1 Reinforced Slope from Sta 16+55.46 to Sta 17+51.72,
See Sheet 22 for Typical Reinforced Slope Section.

Note:
Slopes 2:1 And Greater
Shall Have Permanent
Erosion Control Matting



XINGUN DING
LICENSED PROFESSIONAL ENGINEER
NO. 8246-C
HAWAII, U.S.A.
LICENSE EXPIRES 4/30/14
THIS WORK WAS PREPARED BY
ME OR UNDER MY SUPERVISION

02/07/14 Revised Note

STATE OF HAWAII
DEPARTMENT OF TRANSPORTATION
HIGHWAYS DIVISION

TYPICAL SECTIONS

PAHOA BYPASS ROAD ROUTE 130

Keaau-Paho Road Intersection


Improvements at Old Government Road

Federal-Aid Project No. HSIP-0130(031)


Scale: 1" = 4' Date: August 2013

SHEET No. 2 OF 5 SHEETS


FED. ROAD DIST. NO.	STATE	FED. AID PROJ. NO.	FISCAL YEAR	SHEET NO.	TOTAL SHEETS
HAWAII	HAW.	HSIP-0130(031)	2014	27	108

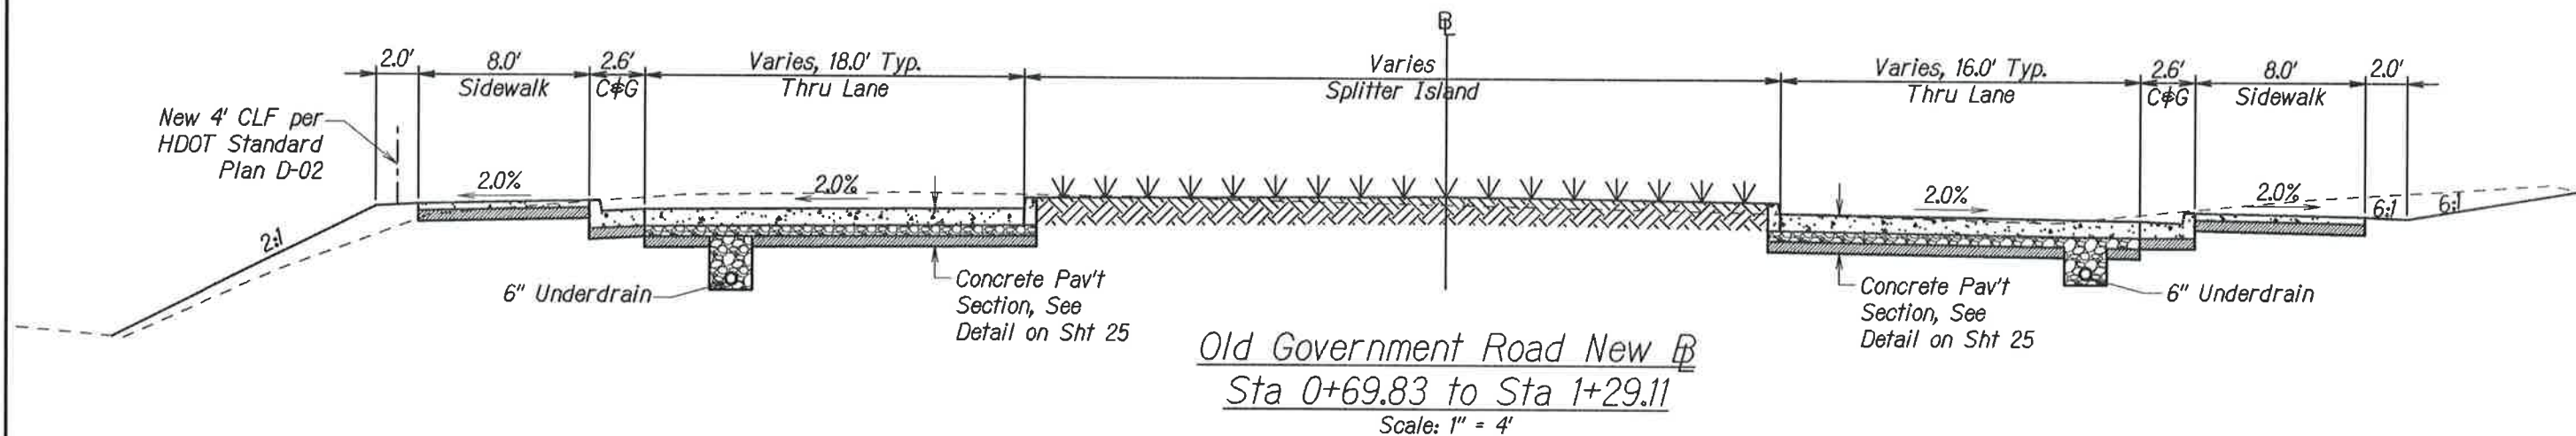

Old Government Road New B
Sta 0+69.83 to Sta 1+29.11
Scale: 1" = 4'

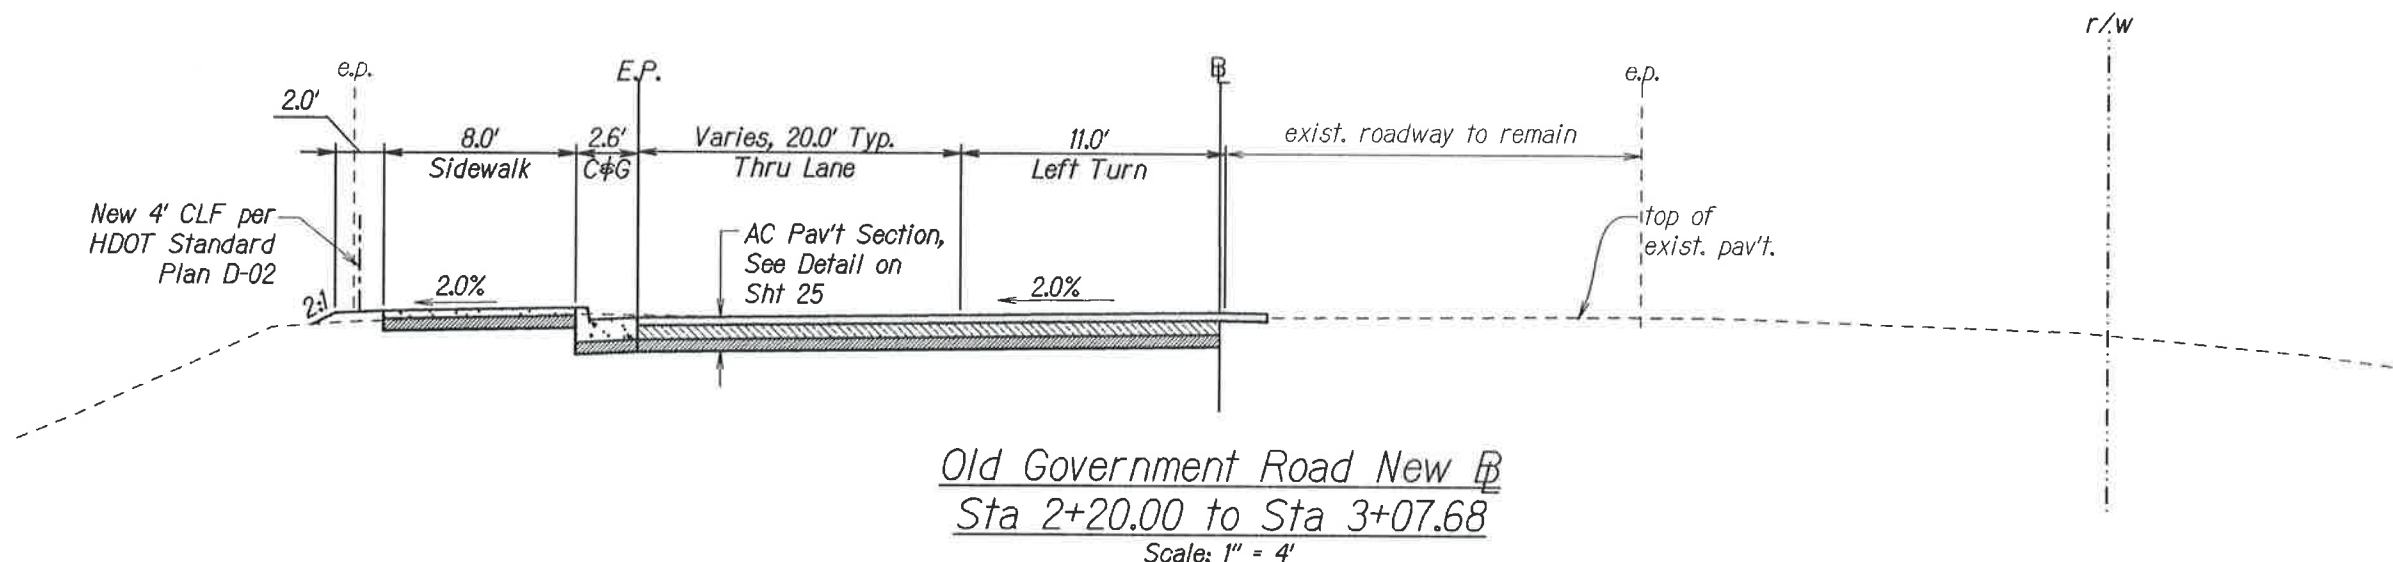


Old Government Road New B
Sta 2+20.00 to Sta 3+07.68
Scale: 1" = 4'

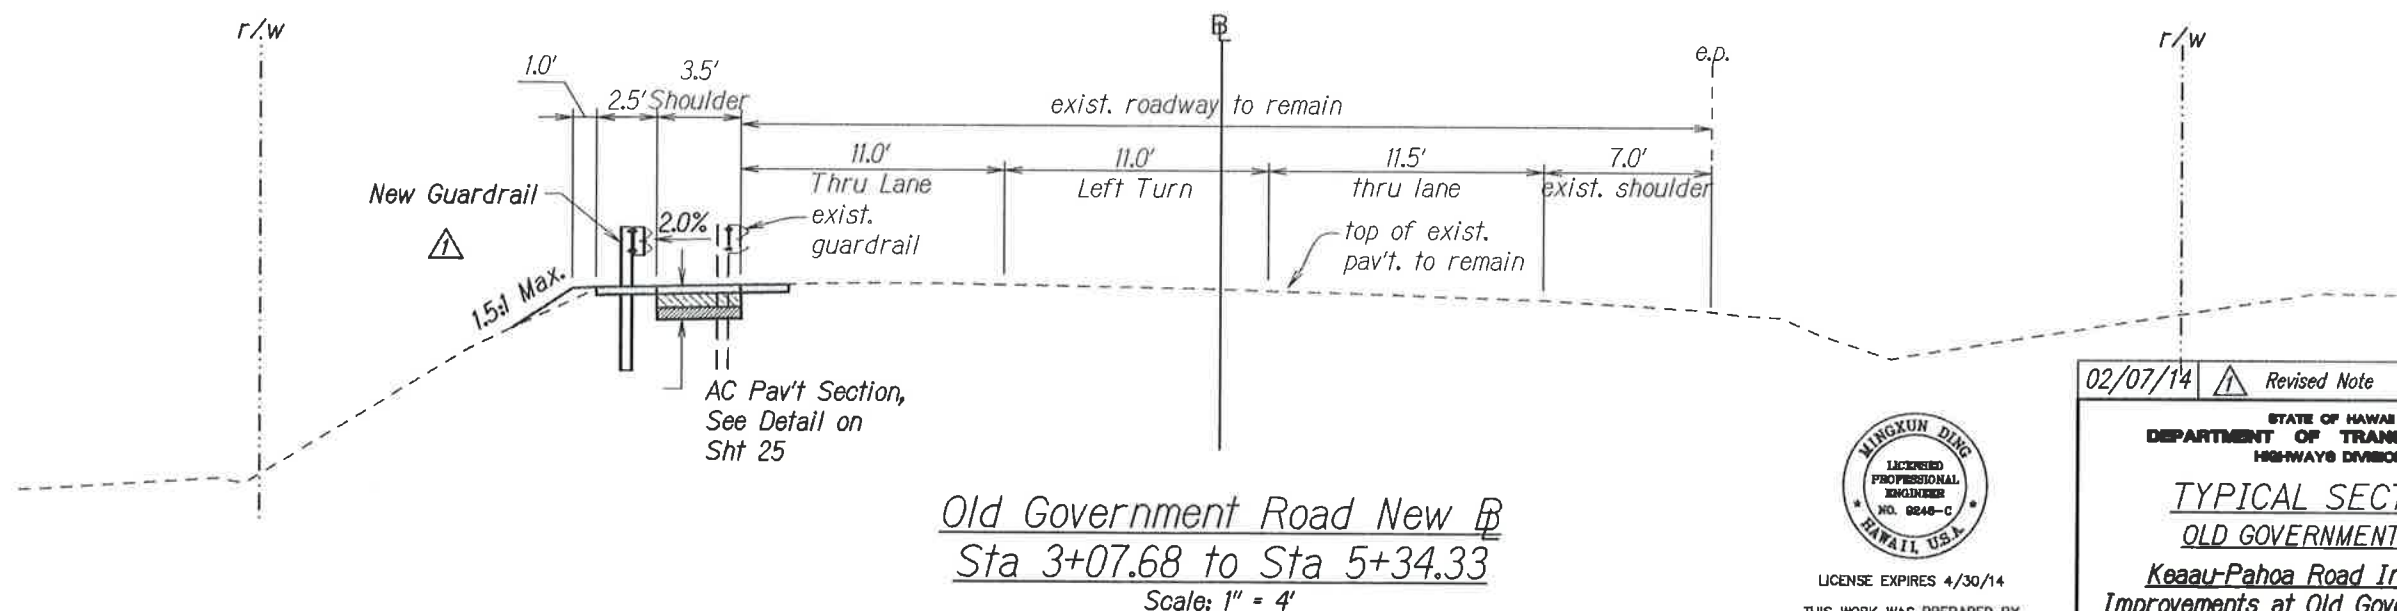

Old Government Road New B
Sta 3+07.68 to Sta 5+34.33
Scale: 1" = 4'

Note:
Slopes 2:1 And Greater
Shall Have Permanent
Erosion Control Matting

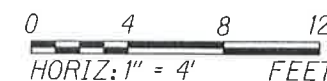

LICENSE EXPIRES 4/30/14
THIS WORK WAS PREPARED BY
ME OR UNDER MY SUPERVISION

[Signature]

02/07/14 Revised Note

STATE OF HAWAII
DEPARTMENT OF TRANSPORTATION
HIGHWAYS DIVISION

TYPICAL SECTIONS
OLD GOVERNMENT ROAD
Kaau-Paho Road Intersection
Improvements at Old Government Road
Federal Aid Project No. HSIP-0130(031)


Scale: 1" = 4' Date: August 2013

SHEET No. 3 OF 5 SHEETS

FED. ROAD DIST. NO.	STATE	FED. AID PROJ. NO.	FISCAL YEAR	SHEET NO.	TOTAL SHEETS
HAWAII	HAW.	HSIP-0130(031)	2014	35	108

NOTES:

1. See Staking Data Sheets 30-34 for Coordinate and Elevation Information.
2. All Alignments, Points and Curves on Curb and Gutter are at Lip of Gutter. Barrier Curb Points are at Bottom Face of Curb.
3. Contours Shown are Half-Foot (0.5') Contours.

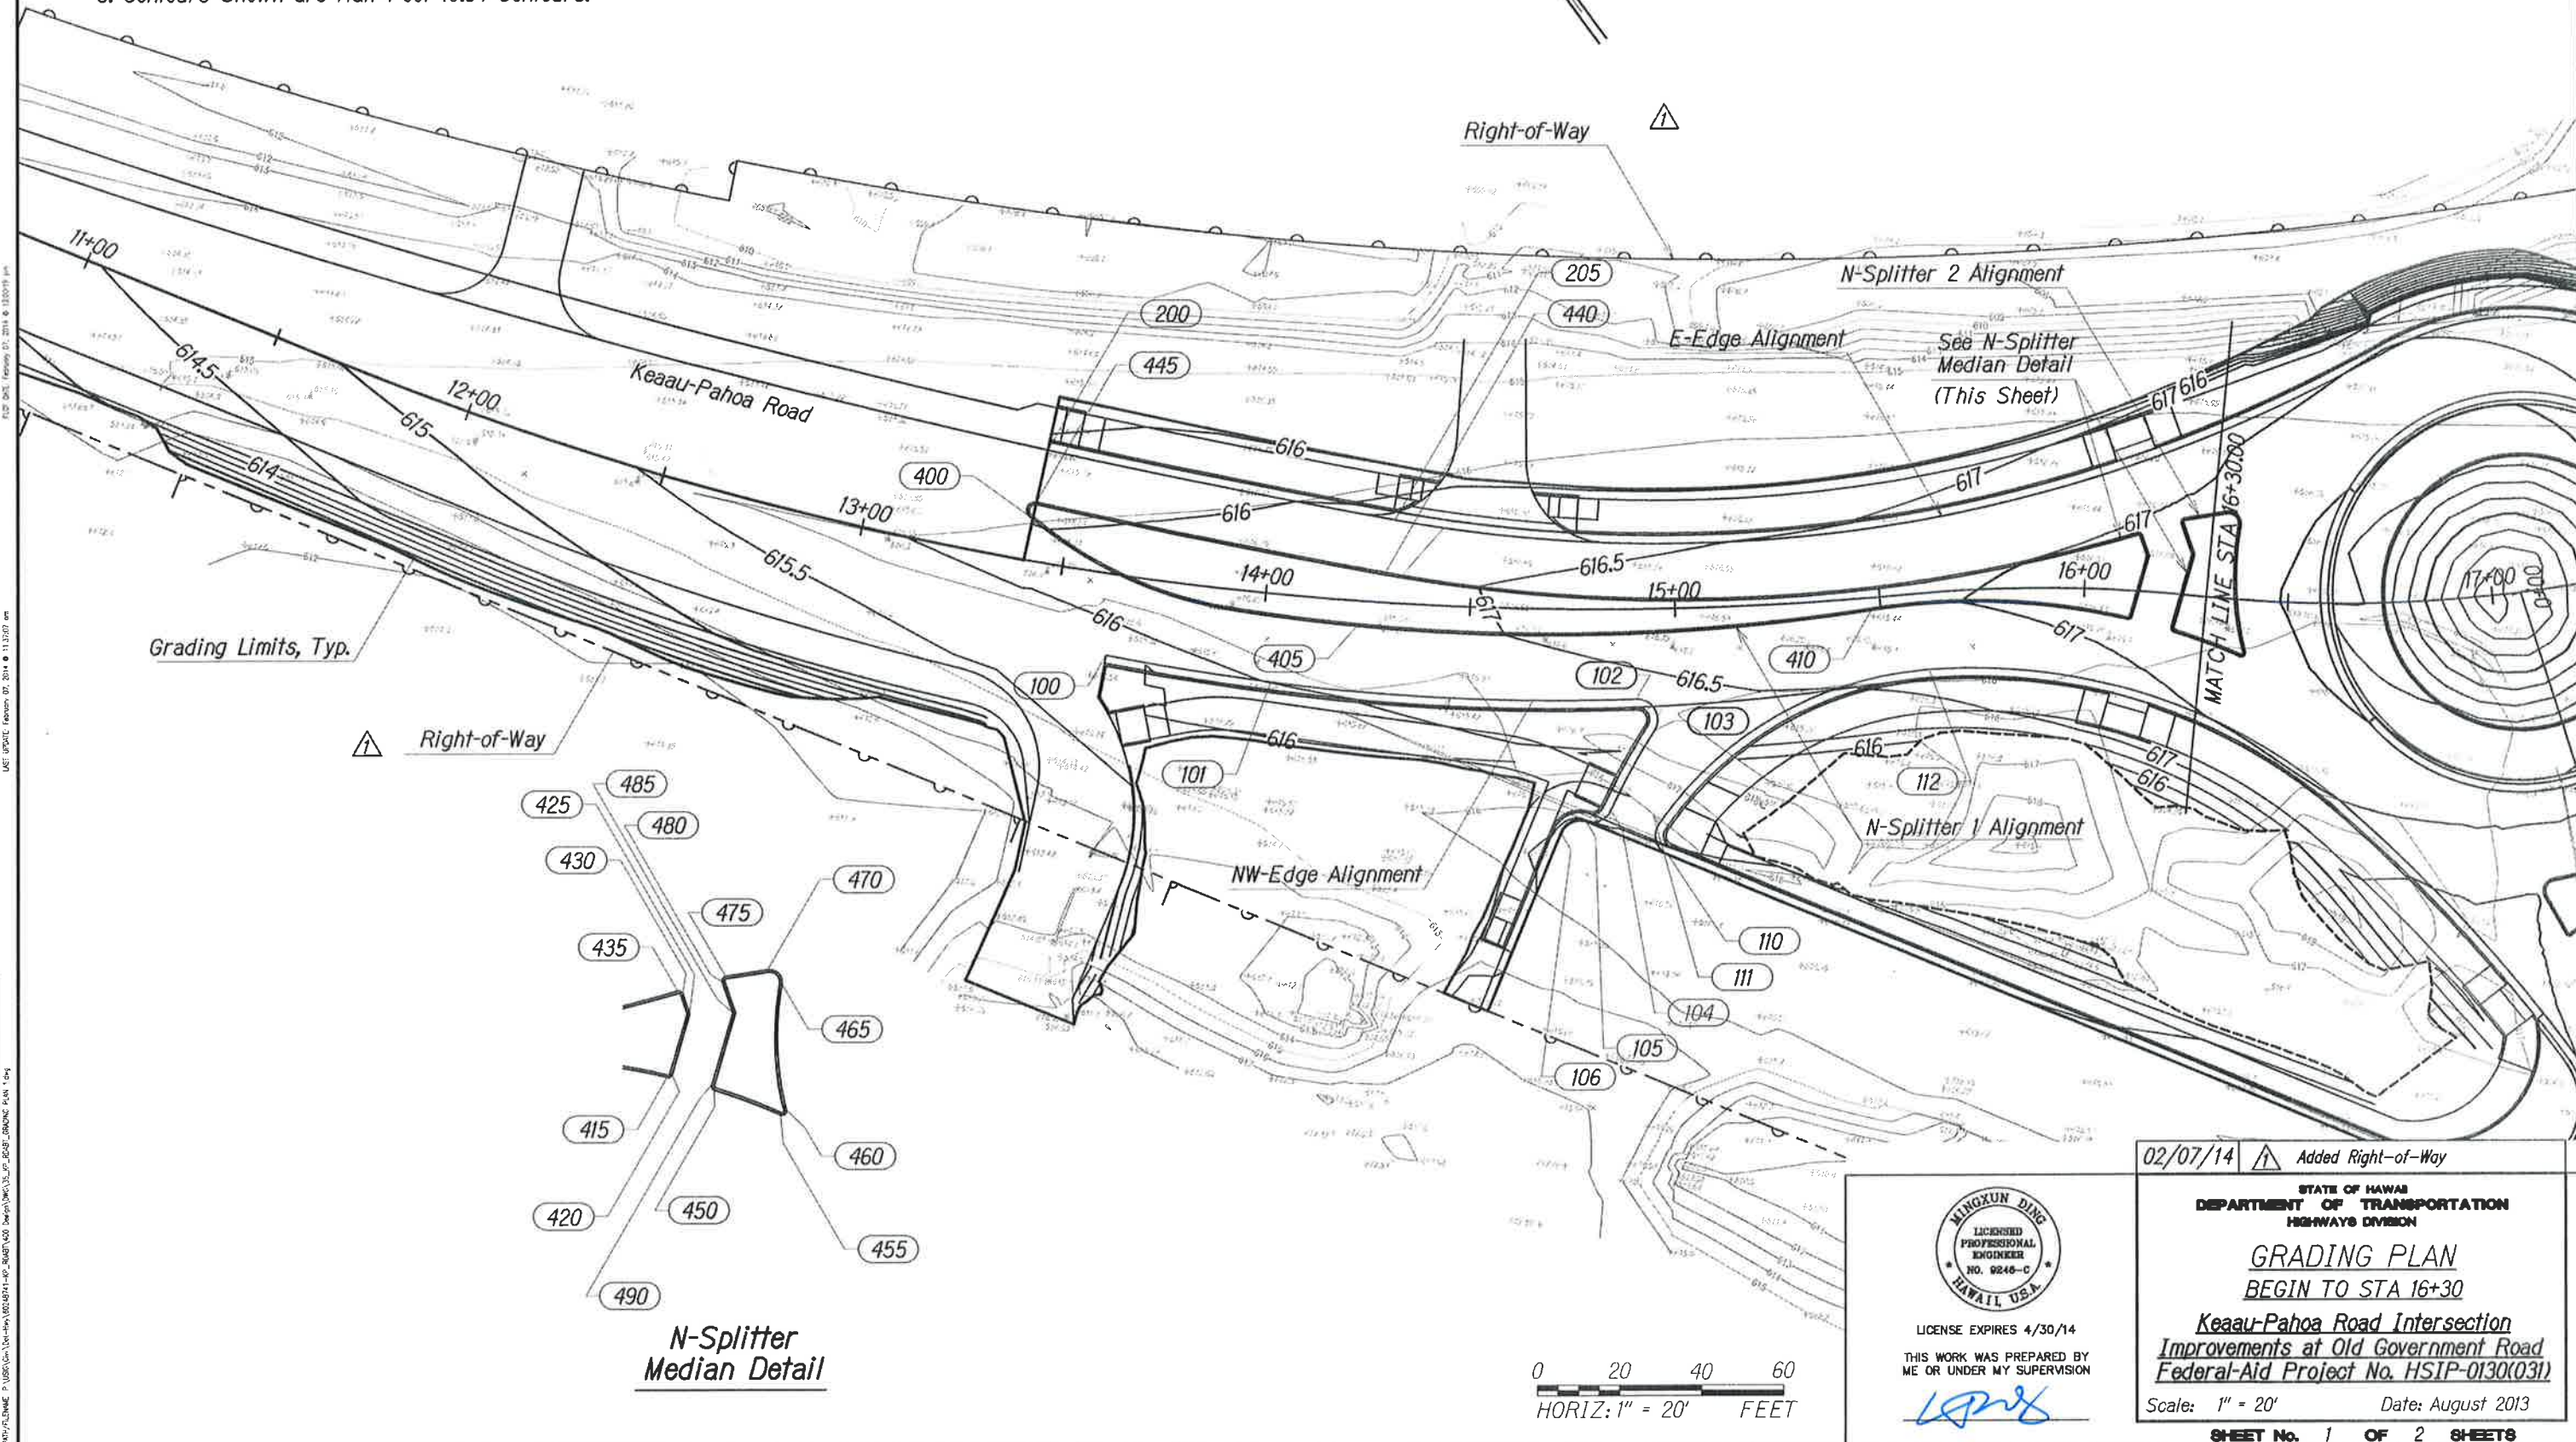

SURVEY PLOTTED BY	DATE
DESIGNED BY	
NOTED BY	
CHECKED BY	

PROJECT: Keaau-Pahoa Road Intersection Improvements at Old Government Road
SHEET: 35 OF 108
DATE: 02/07/14



LICENSE EXPIRES 4/30/14
THIS WORK WAS PREPARED BY
ME OR UNDER MY SUPERVISION

[Signature]

02/07/14 Added Right-of-Way

STATE OF HAWAII
DEPARTMENT OF TRANSPORTATION
HIGHWAYS DIVISION

GRADING PLAN
BEGIN TO STA 16+30


Keaau-Pahoa Road Intersection
Improvements at Old Government Road
Federal-Aid Project No. HSIP-0130(031)

Scale: 1" = 20' Date: August 2013

SHEET No. 1 OF 2 SHEETS

FED. ROAD DIST. NO.	STATE	FED. AID PROJ. NO.	FISCAL YEAR	SHEET NO.	TOTAL SHEETS
HAWAII	HAW.	HSIP-0130(031)	2014	36	108

- NOTES:
1. See Staking Data Sheets for Coordinate and Elevation Information.
 2. All Alignments, Points and Curves on Curb and Gutter are at Lip of Gutter. Barrier Curb Points are at Face of Curb.
 3. Contours Shown are Half-Foot (0.5') Contours.

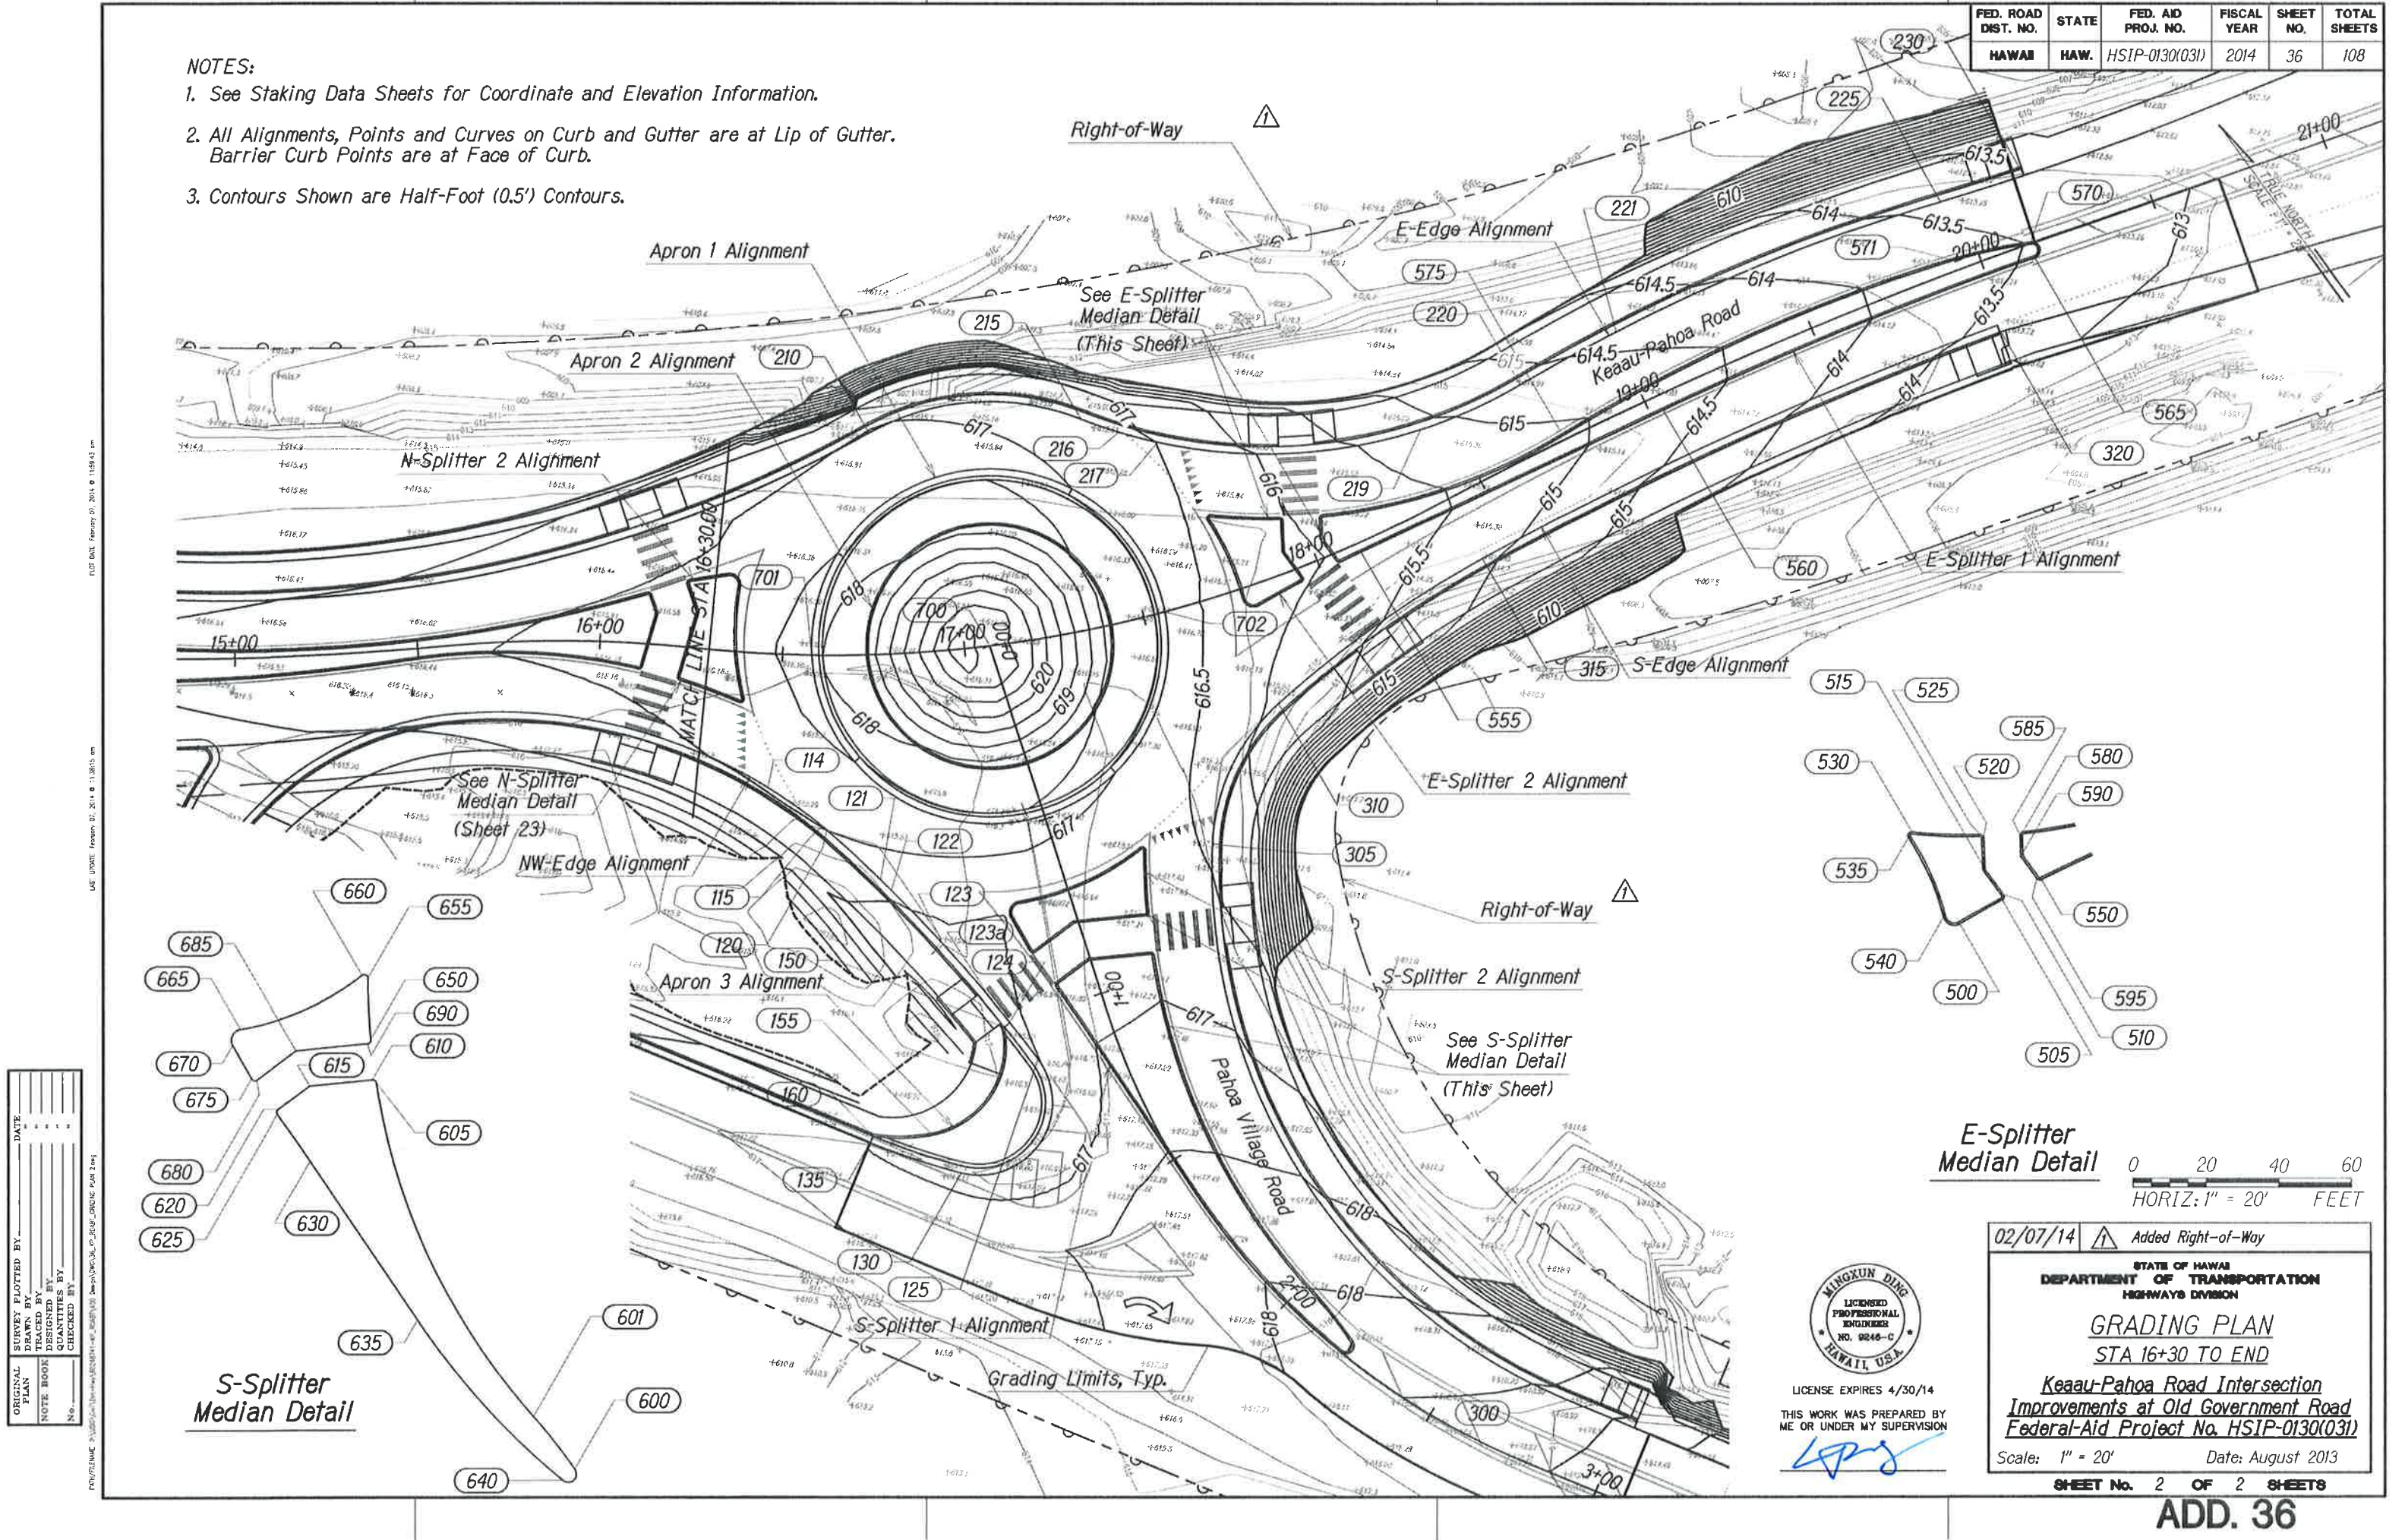

SURVEY PLOTTED BY	DATE
DESIGNED BY	
NOTED BY	
CHECKED BY	



LICENSE EXPIRES 4/30/14
THIS WORK WAS PREPARED BY
ME OR UNDER MY SUPERVISION

E-Splitter
Median Detail
0 20 40 60
HORIZ: 1" = 20' FEET

02/07/14 Added Right-of-Way

STATE OF HAWAII
DEPARTMENT OF TRANSPORTATION
HIGHWAYS DIVISION



GRADING PLAN
STA 16+30 TO END

Keaau-Pahoa Road Intersection
Improvements at Old Government Road
Federal-Aid Project No. HSIP-0130(031)

Scale: 1" = 20' Date: August 2013

SHEET No. 2 OF 2 SHEETS

FED. ROAD DIST. NO.	STATE	FED. AID PROJ. NO.	FISCAL YEAR	SHEET NO.	TOTAL SHEETS
HAWAII	HAW.	HSIP-0130(031)	2014	38	108

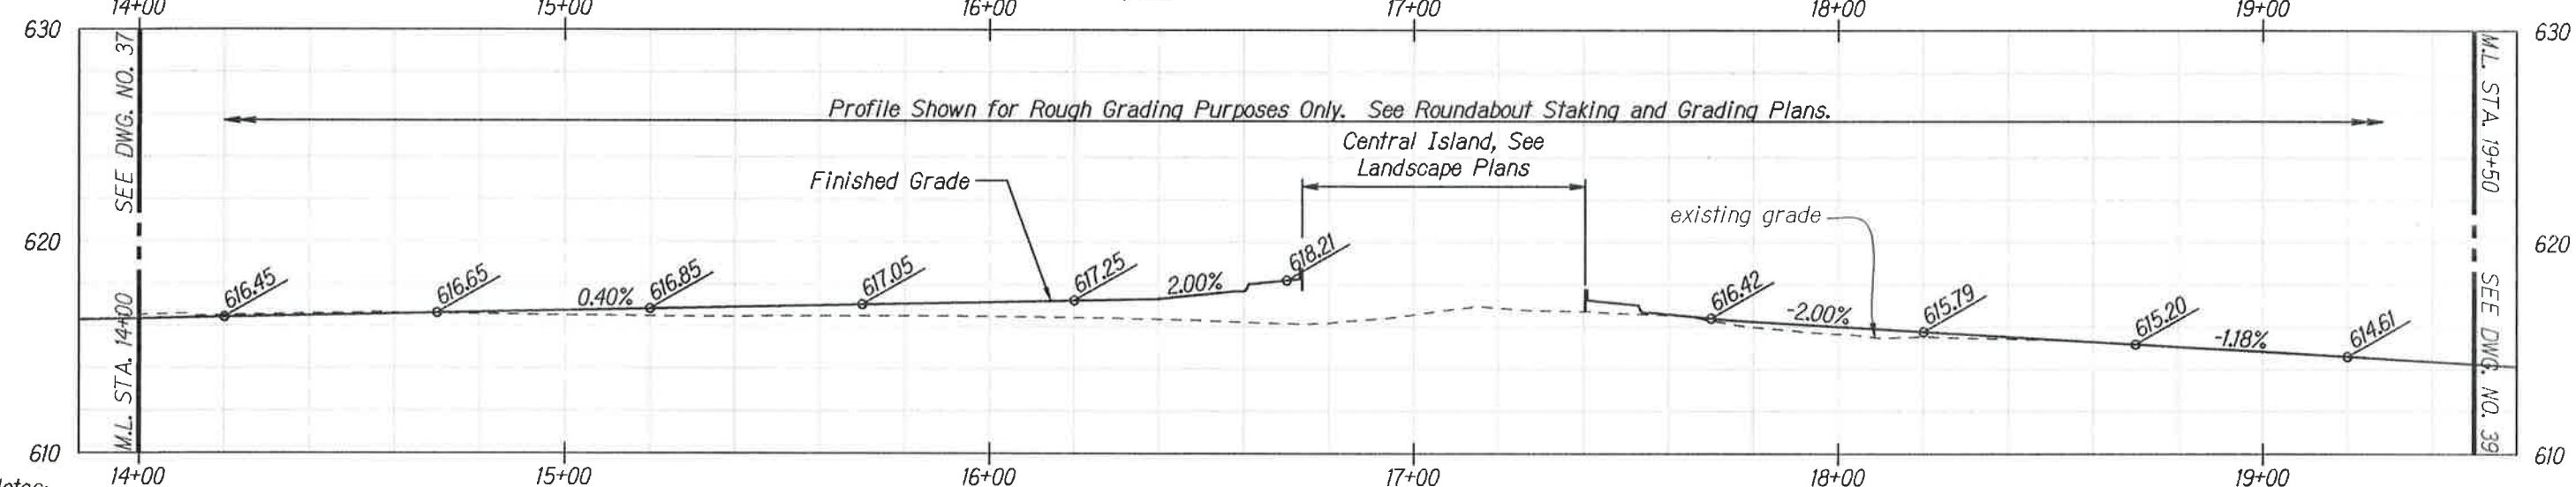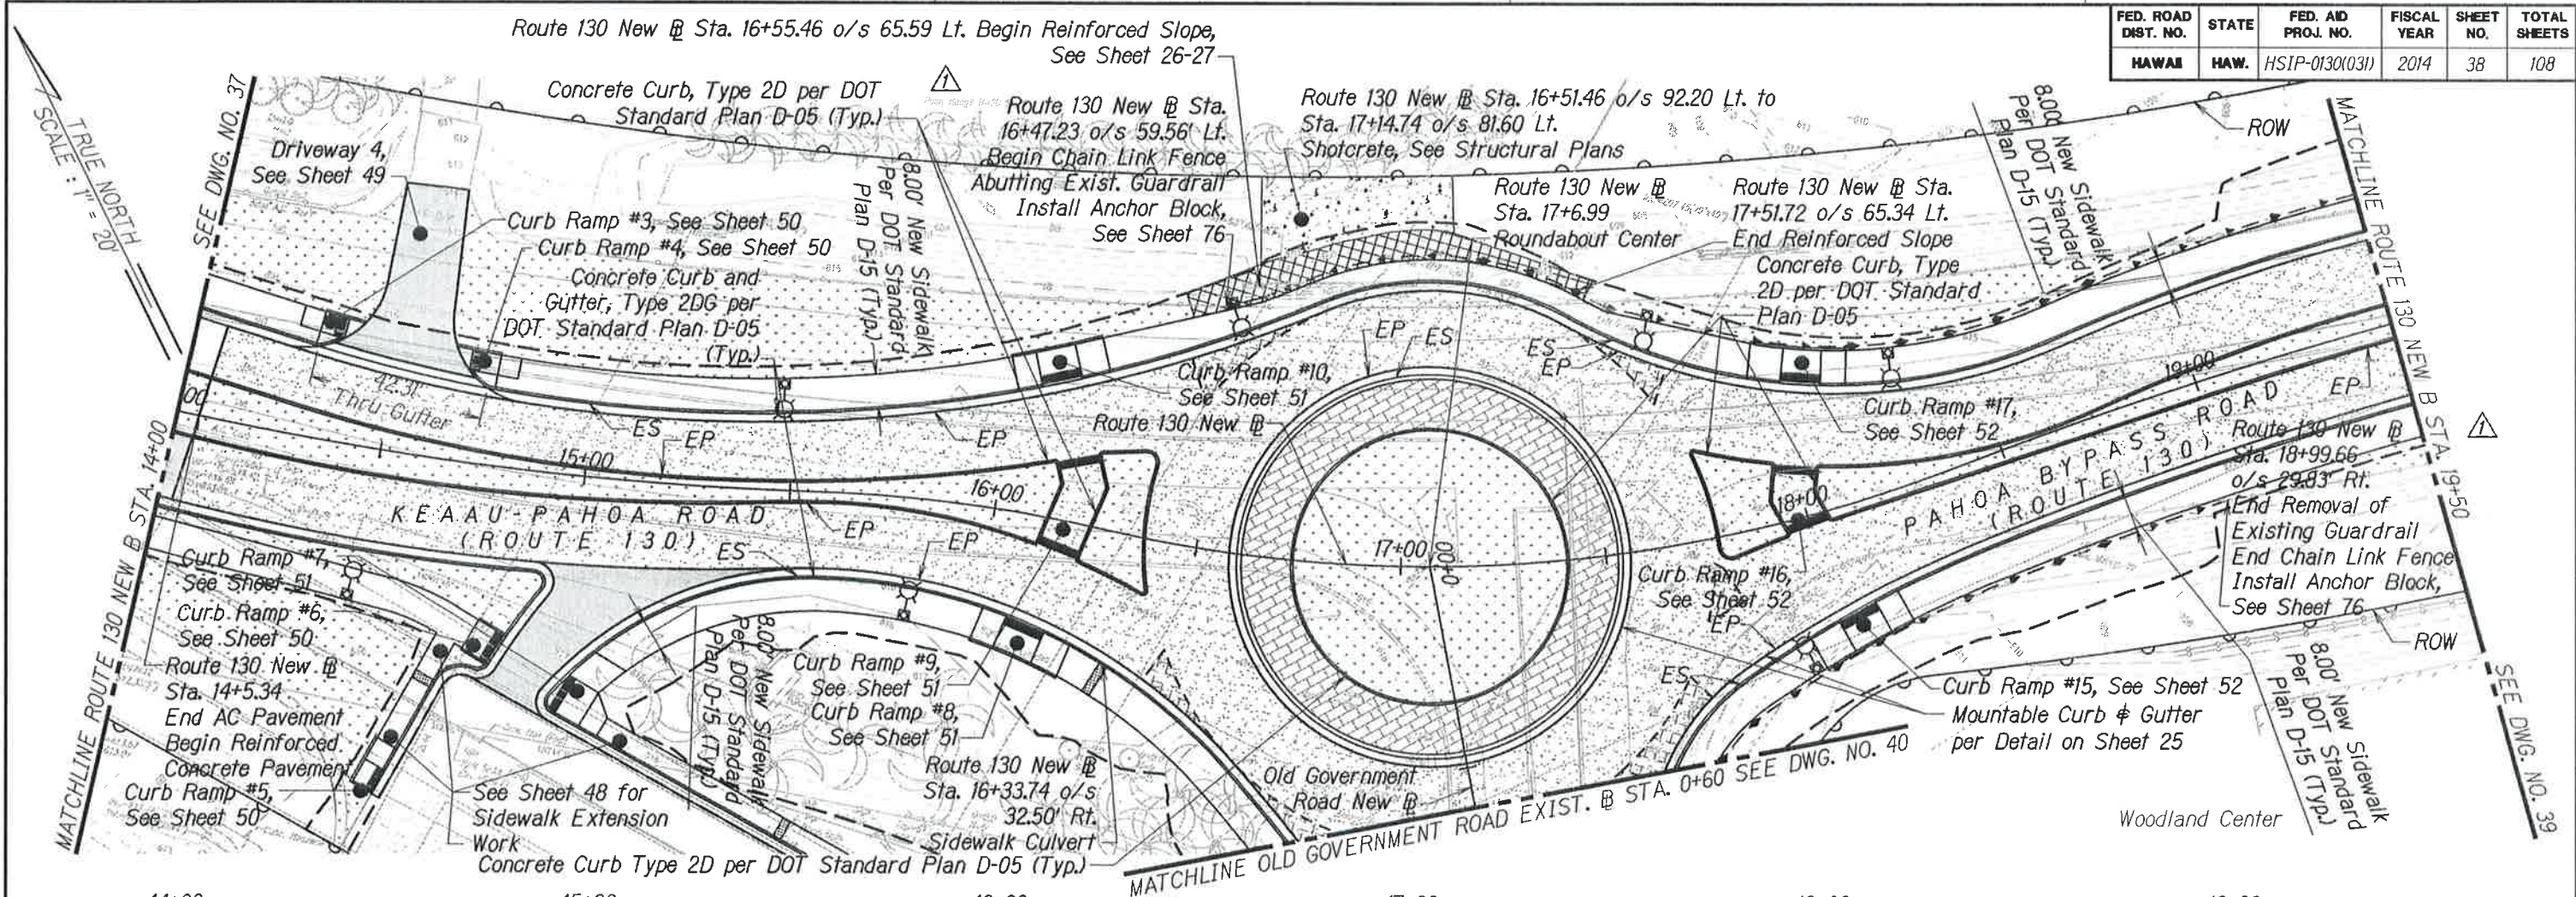


Notes:
1. Spot Elevations on Profile are at 50' Spacing, Typical

LEGEND

- | | |
|--|---|
| 9.5" Portland Cement Concrete, 6" Untreated Permeable Base, 6" Aggregate Subbase | Guardrail, See Sheet 74 for Details |
| 4" Asphaltic Concrete, 7" Asphalt Concrete Base, 6" Aggregate Subbase | 4'-High Chain Link Fence per HDOT Standard Plan D-02 with 5' max post spacing |
| Sidewalk Culvert, See Sheet 77 for Details | Right of Way |
| Truck Apron, See Sheet 25 for Details | Limits of Grading |
| | Light Pole, See Electrical Plans |
| | Reinforced Slope, See Sheet 22 for Detail |
| | Landscaping, See Landscape Plans |

ROADWAY PLAN & PROFILE ROUTE 130 STA 14+00 TO STA 19+50

Horizontal Scale: 1" = 20'
Vertical Scale: 1" = 4'

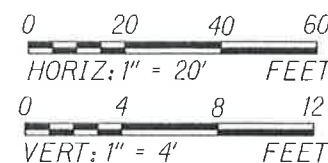

LICENSE EXPIRES 4/30/14
THIS WORK WAS PREPARED BY ME OR UNDER MY SUPERVISION

02/07/14 Amended Callouts to Include Anchor Block Installation

STATE OF HAWAII
DEPARTMENT OF TRANSPORTATION
HIGHWAYS DIVISION



ROADWAY PLAN & PROFILE
ROUTE 130 STA 14+00 TO STA 19+50
Kaau-Pahoa Road Intersection
Improvements at Old Government Road
Federal-Aid Project No. HSIP-0130(031)

Scale: As Shown Date: August 2013

SHEET No. 2 OF 4 SHEETS

ADD. 38

FED. ROAD DIST. NO.	STATE	FED. AID PROJ. NO.	FISCAL YEAR	SHEET NO.	TOTAL SHEETS
HAWAII	HAW.	HSIP-0130(031)	2014	39	108

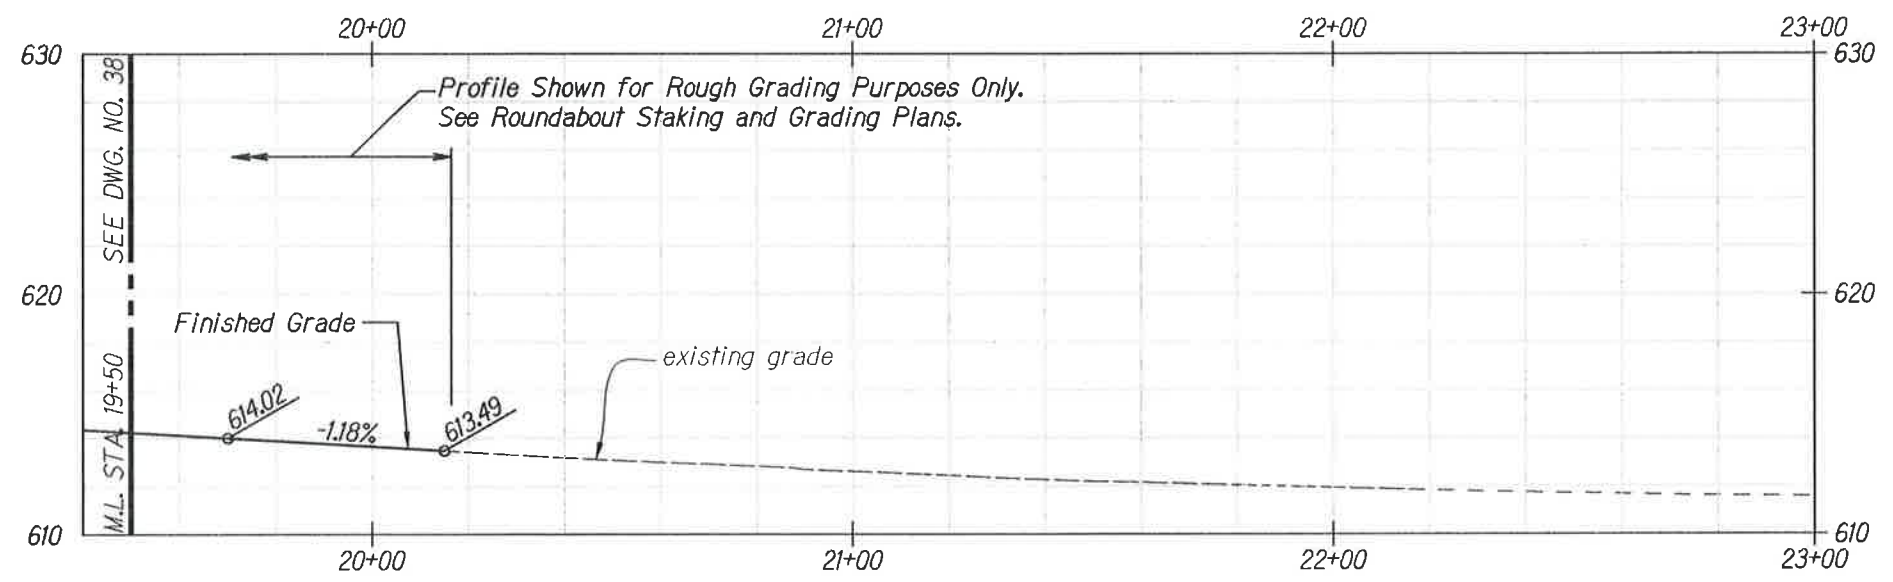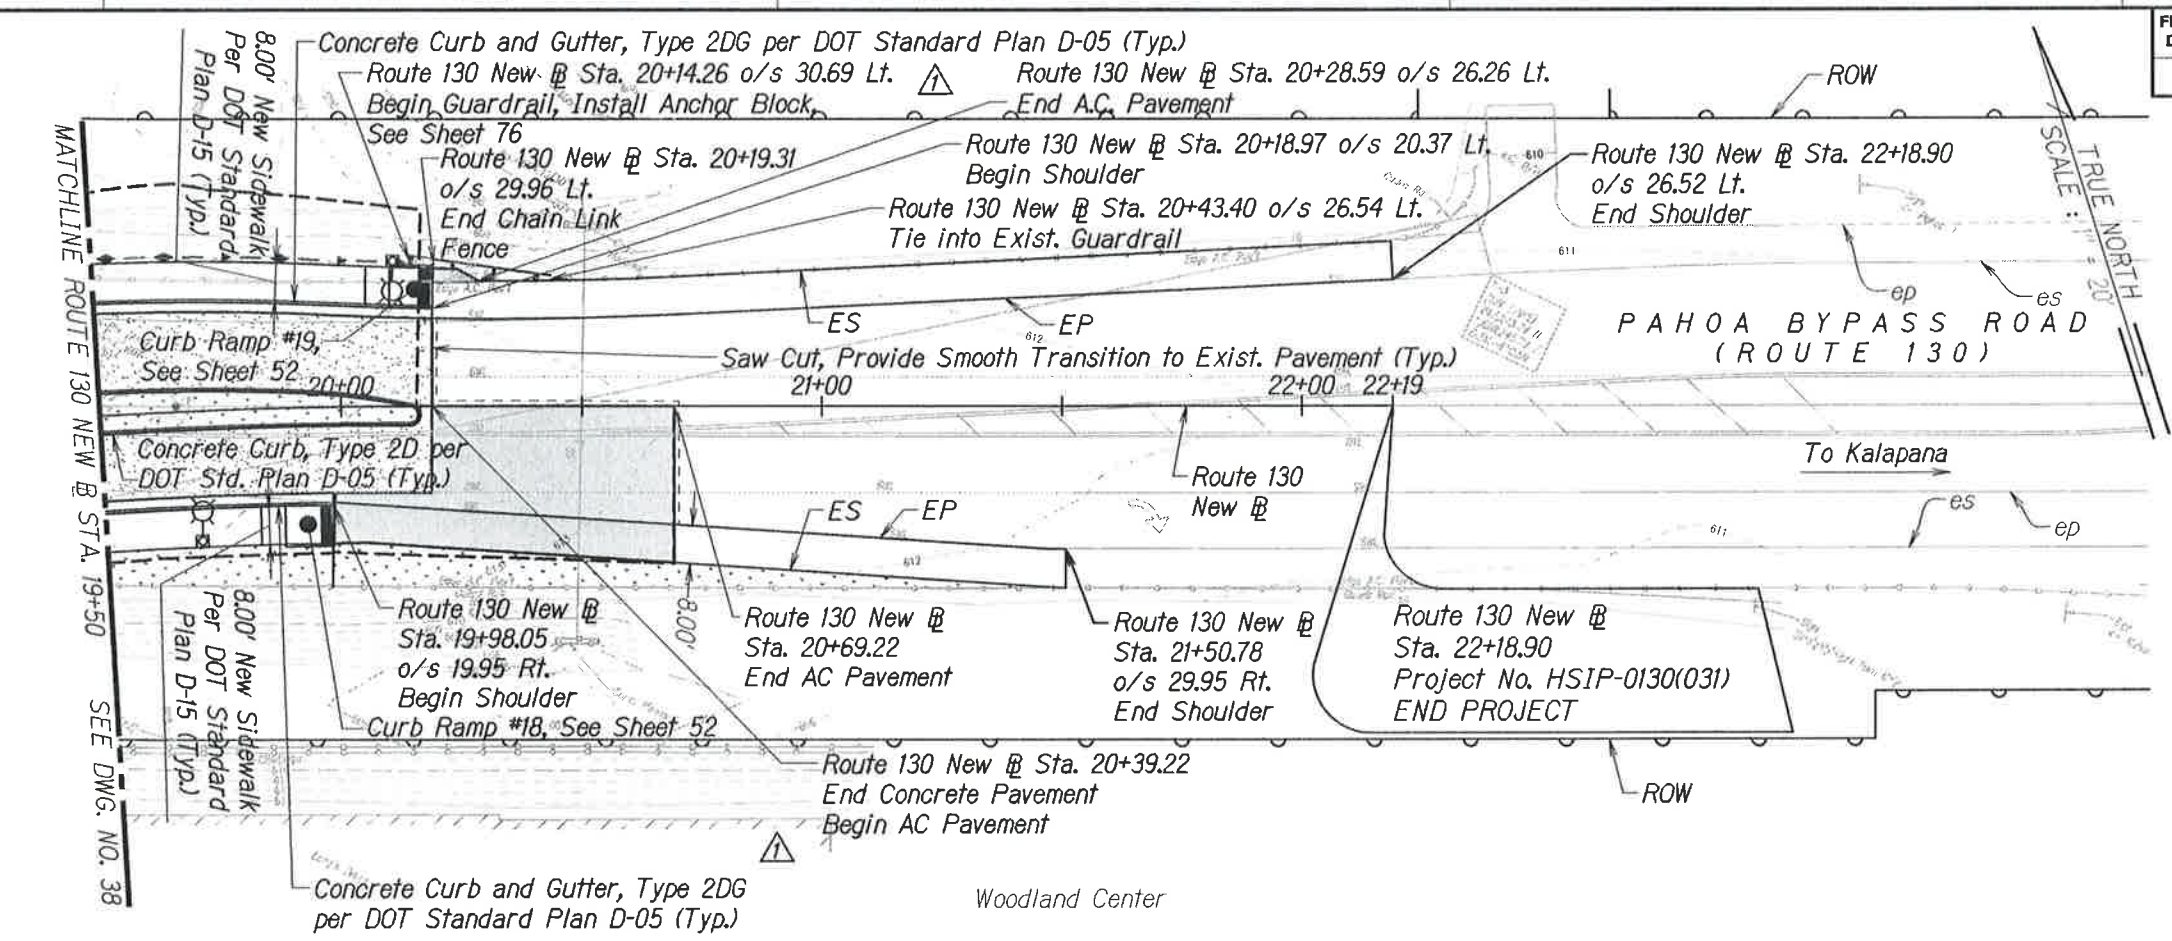


Notes:
1. Spot Elevations on Profile are at 50' Spacing, Typical

LEGEND

- | | | | |
|--|--|--|--|
| | 9.5" Portland Cement Concrete, 6" Untreated Permeable Base, 6" Aggregate Subbase | | Guardrail, See Sheet 74 for Details |
| | 4" Asphaltic Concrete, 7" Asphalt Concrete Base, 6" Aggregate Subbase | | 4'-High Chain Link Fence per HDOT Standard Plan D-02 with 5' max spacing |
| | Sidewalk Culvert, See Sheet 77 for Details | | Right of Way |
| | Truck Apron, See Sheet 25 for Details | | Limits of Grading |

ROADWAY PLAN & PROFILE ROUTE 130 STA 19+50 TO STA 22+00

Horizontal Scale: 1" = 20'
Vertical Scale: 1" = 4'

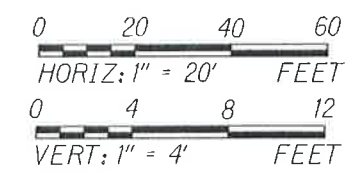

Light Pole, See Electrical Plans

Landscaping, See Landscape Plans



LICENSE EXPIRES 4/30/14
THIS WORK WAS PREPARED BY ME OR UNDER MY SUPERVISION

LP-8

02/07/14		Deleted Callout
02/07/14		Amended Callout to Include Anchor Block Installation



STATE OF HAWAII
DEPARTMENT OF TRANSPORTATION
HIGHWAYS DIVISION

ROADWAY PLAN & PROFILE
ROUTE 130 STA 19+50 TO STA 22+00
Keaau-Pahoa Road Intersection
Improvements at Old Government Road
Federal-Aid Project No. HSIP-0130(031)

Scale: As Shown Date: August 2013

SHEET No. 3 OF 4 SHEETS

FED. ROAD DIST. NO.	STATE	FED. AID PROJ. NO.	FISCAL YEAR	SHEET NO.	TOTAL SHEETS
HAWAII	HAW.	HSIP-0130(031)	2014	40	108

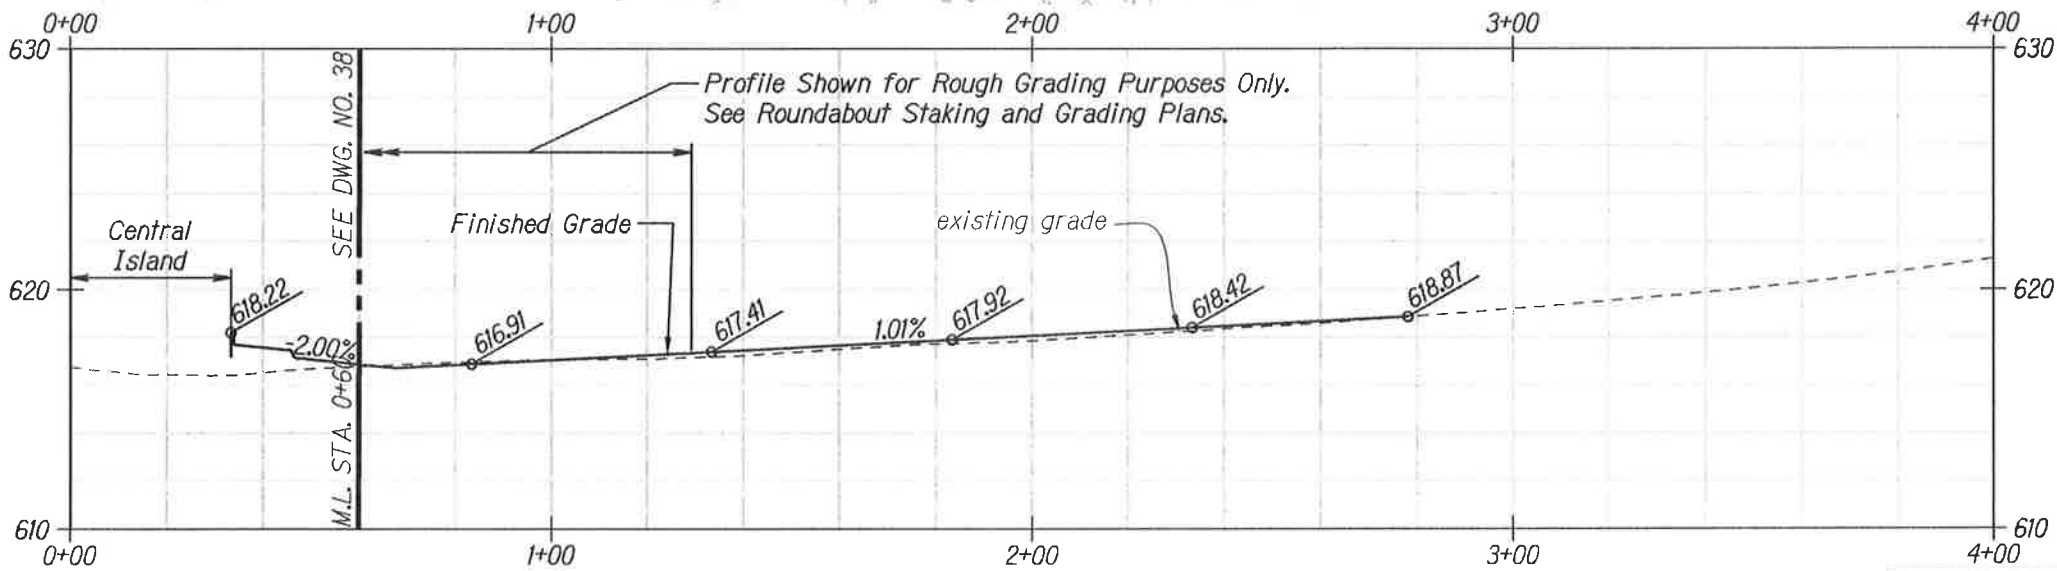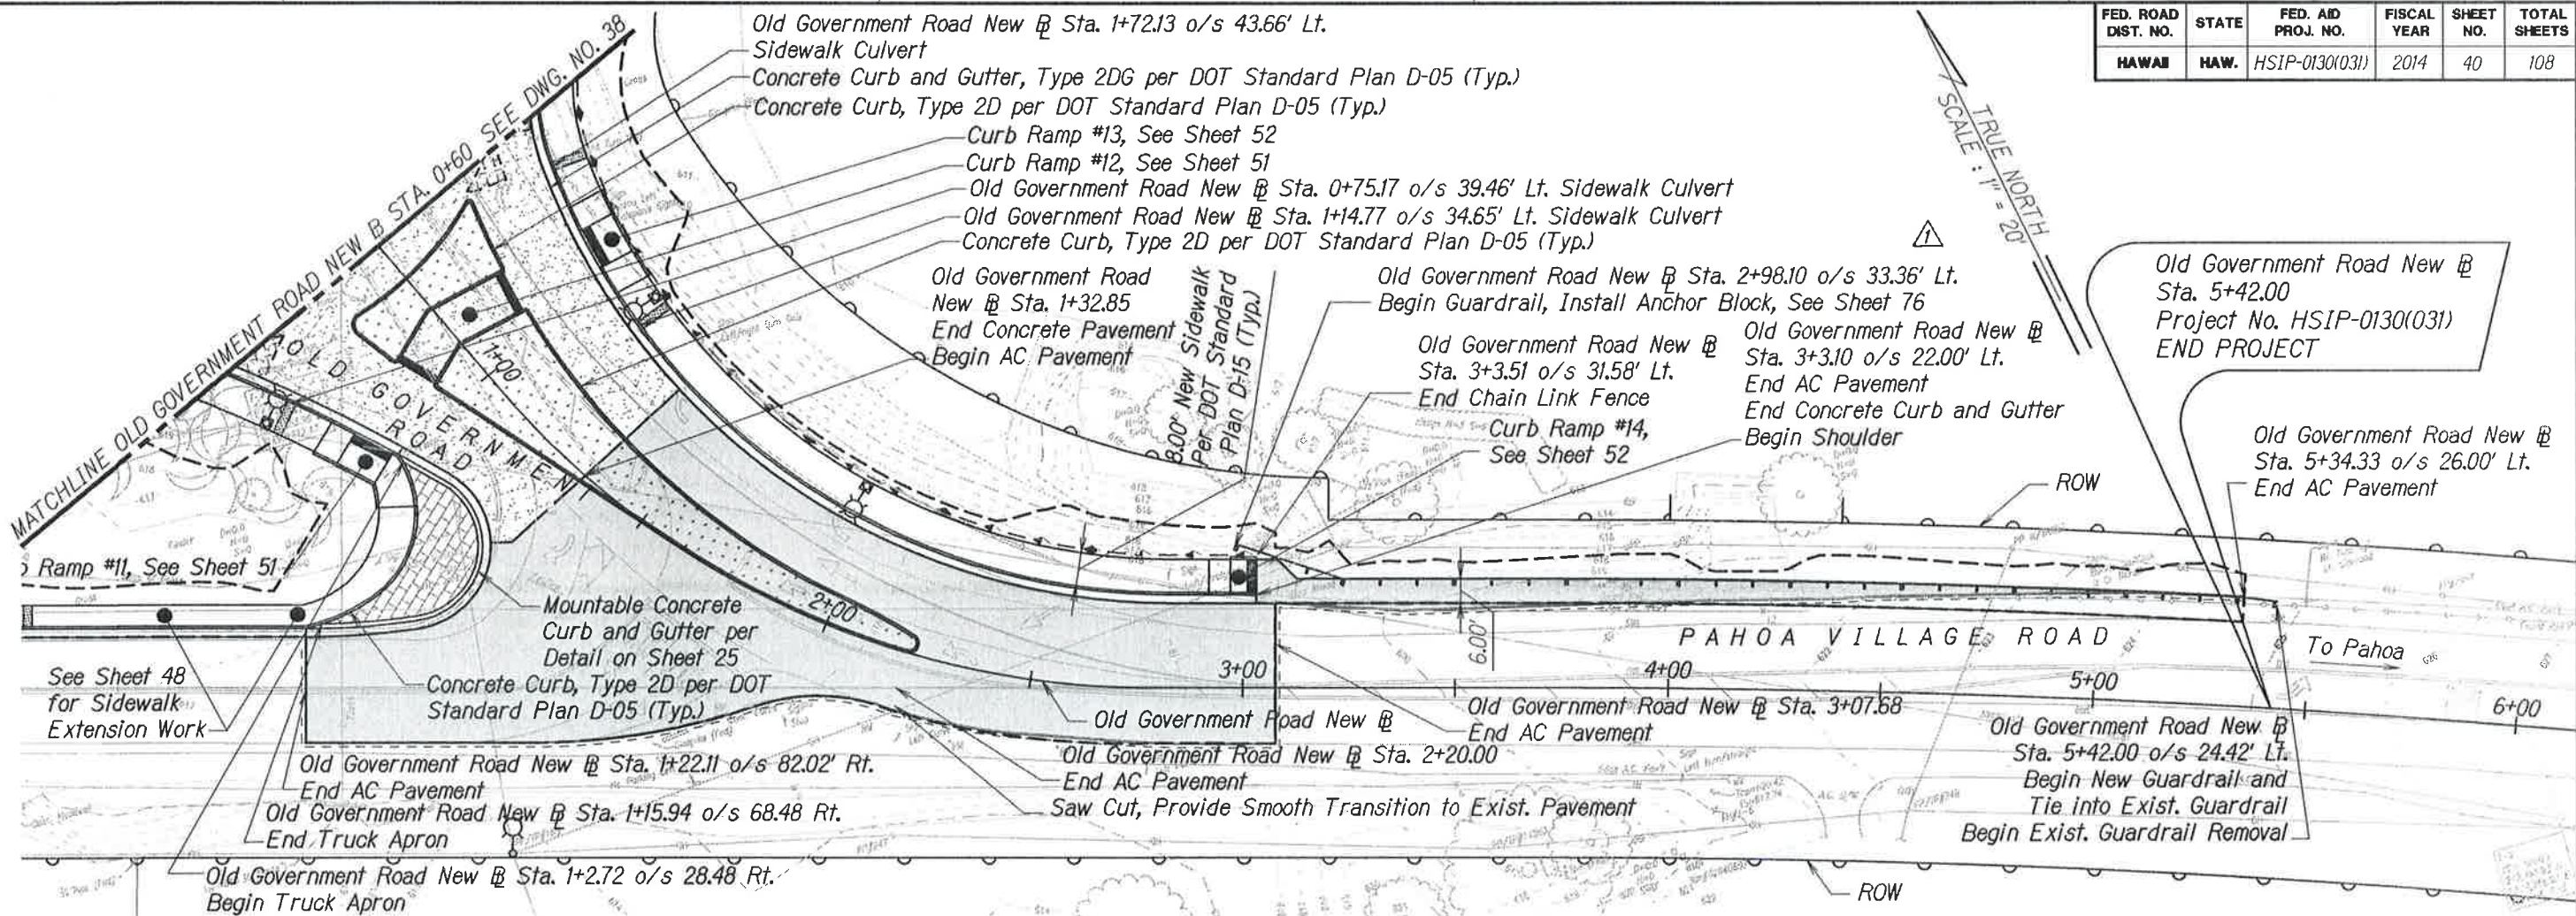


Notes:
1. Spot Elevations on Profile are at 50' Spacing, Typical

LEGEND

- 9.5" Portland Cement Concrete, 6" Untreated Permeable Base, 6" Aggregate Subbase
- 4" Asphaltic Concrete, 7" Asphalt Concrete Base, 6" Aggregate Subbase
- Transition 2" Coldplane, See Sheet 25 for Details
- Sidewalk Culvert, See Sheet 77 for Details
- Truck Apron, See Sheet 25 for Details
- Guardrail, See Sheet 74 for Details
- 4'-High Chain Link Fence per HDOT Standard Plan D-02 with 5' max post spacing
- Right of Way
- Limits of Grading

ROADWAY PLAN & PROFILE OLD GOV'T ROAD STA 0+60 TO END

Horizontal Scale: 1" = 20'
Vertical Scale: 1" = 4'

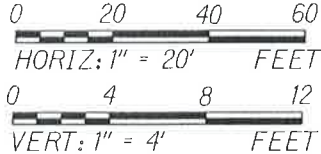

LICENSE EXPIRES 4/30/14
THIS WORK WAS PREPARED BY ME OR UNDER MY SUPERVISION

02/07/14 Amended Callout to Include Anchor Block Installation

STATE OF HAWAII
DEPARTMENT OF TRANSPORTATION
HIGHWAYS DIVISION

ROADWAY PLAN & PROFILE
OLD GOV'T ROAD STA 0+60 TO END
Keaau-Pahoa Road Intersection
Improvements at Old Government Road
Federal-Aid Project No. HSIP-0130(031)



Scale: As Shown Date: August 2013

SHEET No. 4 OF 4 SHEETS

PAVEMENT MARKING & SIGNAGE NOTES

1. Layout of pavement markings and signage shall be done by the Contractor and approved by the Engineer prior to any installation work.
2. Exist pavement markings not incorporated in the final traffic pattern shall be removed as directed by the Engineer. Costs shall be incidental to the various pavement marking items.
3. Raised pavement markers shall not be installed within crosswalks.
4. Final locations of all signs shall be approved by the Engineer prior to any installation work.
5. Exist signs not shown on these plans shall remain as posted unless otherwise directed by the Engineer. Removal and disposal of existing signs and/or posts as designated on these plans shall be incidental to the various signing items.
6. Final locations of all Stop Lines shall be approved by the Engineer prior to installation.
7. All pavement markings shall be as noted on the legend or plans.
8. All preformed pavement marking tapes over existing pavement shall be applied with an approved primer as recommended by the tape manufacturer and as approved by the Engineer. The primer shall be allowed to dry to the tacky stage prior to tape application.
9. Removal of Exist Delineators and Posts as directed by the Engineer shall be considered incidental to the various signing items.
10. Exist signs that are to be replaced shall not be removed until new signs are installed as replacements, or the messages are no longer necessary.
11. Backing for all new regulatory and warning signs shall not be spliced.
12. All sign panels shall conform to Section 629 to 631 of Special Provisions and the latest editions and amendments of the following FHWA publications:
 - a. "Manual on Uniform Traffic Control Devices for Street and Highways" (MUTCD)
 - b. "Standard Highway Signs"
 - c. "Standard Alphabets for Highway Signs"
13. The Contractor shall erect at the beginning of the project and at the end of the project advance construction warning signs as indicated on the plans or as directed by the Engineer for the duration of the highway project and shall be maintained by the Contractor. These signs shall be placed in addition to the required traffic control signs called for in Section 645-Work Zone Traffic Control. The advance construction warning signs shall be new and become the property of the State. The Contractor shall remove, clean, and deliver the signs and posts to the Oahu District Baseyard or as directed by the Engineer at the end of the project.
14. All signs, except Destination Signs, shall be installed on square tube posts, unless otherwise noted. No flanged channel posts shall be allowed.
15. Sign posts shall be painted with yellow reflective paint, except where located behind guardrails. Such paint work shall be considered incidental to sign items.
16. Contractor shall mark the back of all signs using labels and equipment provided by the State. Payment shall be considered incidental to sign items.
17. Contractor shall submit Shop Drawings to the Engineer for acceptance prior to fabricating, Destination, Street Name, Supplemental Street Name, and Non-Standard signs.

LEGEND

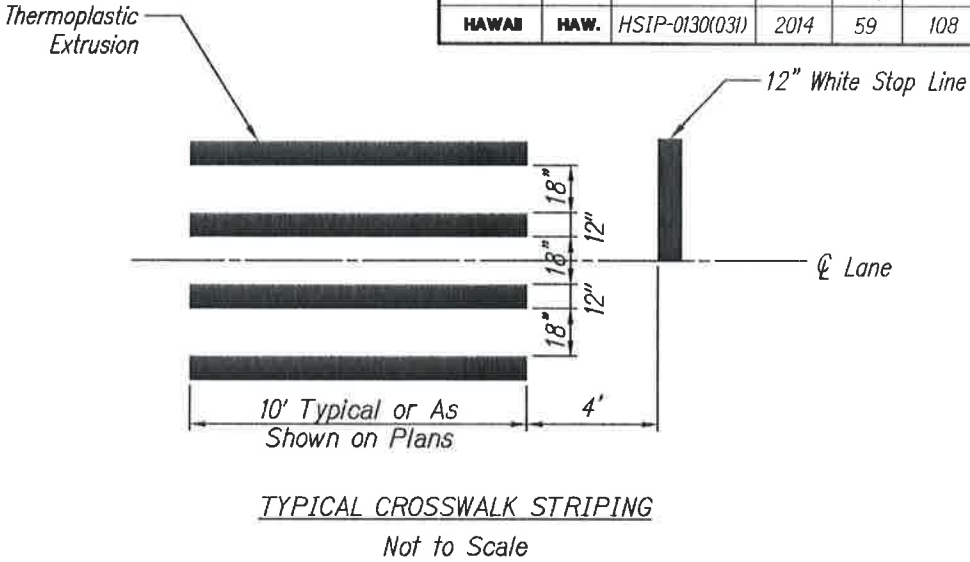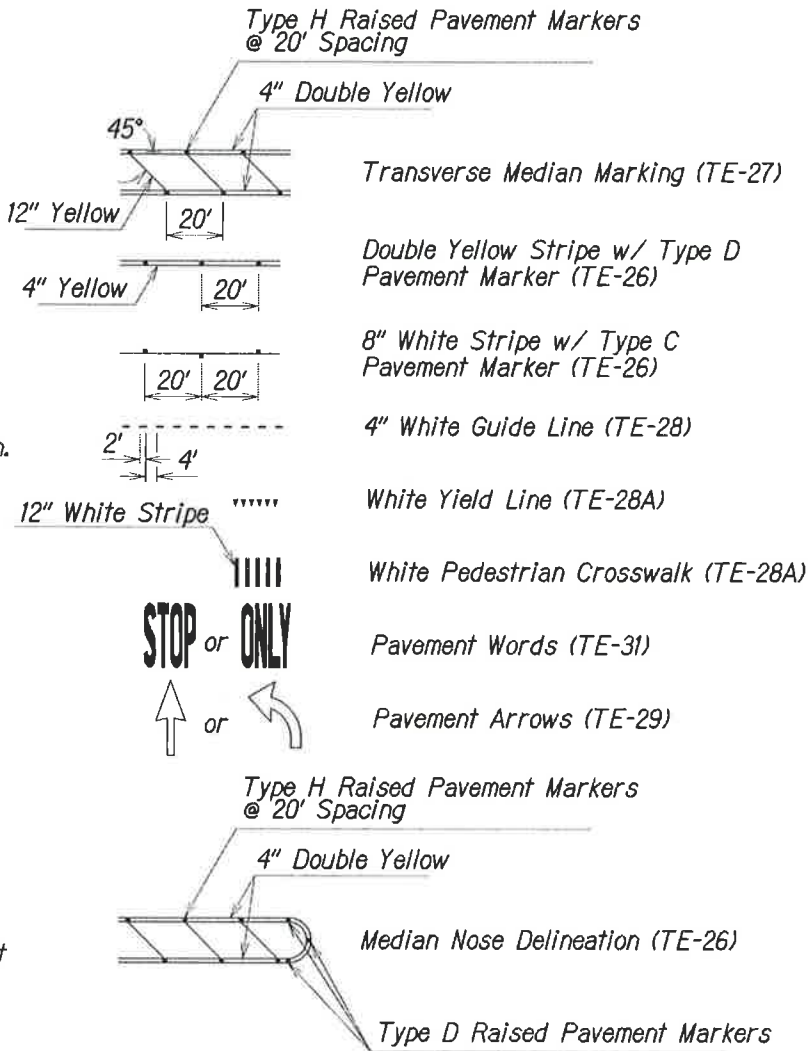

FED. ROAD DIST. NO.	STATE	FED. AID PROJ. NO.	FISCAL YEAR	SHEET NO.	TOTAL SHEETS
HAWAII	HAW.	HSIP-0130(031)	2014	59	108

ORIGINAL PLAN	DATE
SURVEY PLOTTED BY	
DESIGNED BY	
TEACED BY	
QUANTITIES BY	
CHECKED BY	



LICENSE EXPIRES 4/30/14
THIS WORK WAS PREPARED BY
ME OR UNDER MY SUPERVISION

02/07/14

Added notes 14, 15, 16, and 17 to
Paving Marking & Signage Notes

STATE OF HAWAII
DEPARTMENT OF TRANSPORTATION
HIGHWAYS DIVISION

PAVEMENT MARKING AND
SIGNAGE NOTES AND LEGEND


Kaau-Pahoa Road Intersection
Improvements at Old Government Road
Federal-Aid Project No. HSIP-0130(031)

Scale: None Date: August 2013

SHEET No. 1 OF 1 SHEETS



SLOPE INSTALLATION

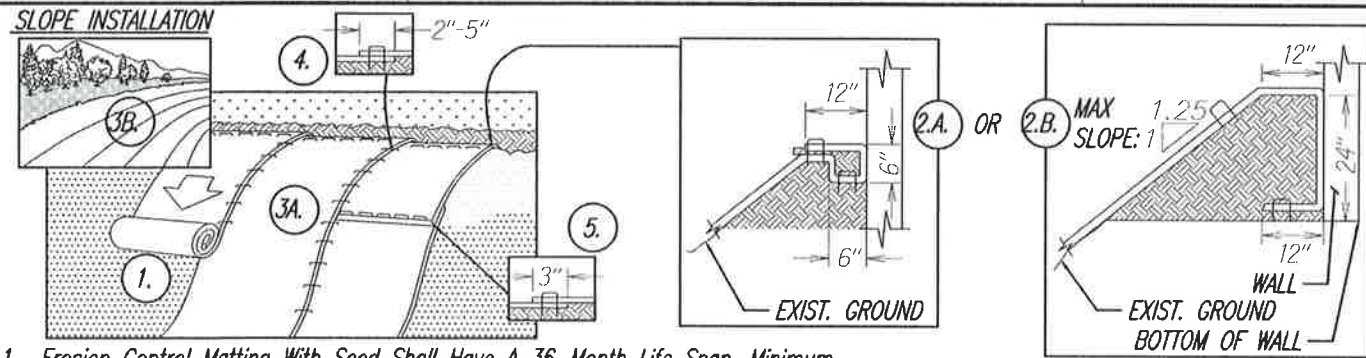


- Erosion Control Matting With Seed Shall Have A 36-Month Life Span, Minimum.
- Prepare Soil Before Installing Erosion Control Matting (ECM), Including Any Necessary Application Of Lime, Fertilizer, And Seed
- Anchor The ECM Using 2.A. Or 2.B.:
 - Begin At The Top Of The Slope By Anchoring The ECM In A 6" Deep x 8" Wide Trench With Approximately 12" Of ECM Extended Beyond The Up-Slope Portion Of The Trench. Anchor The ECM With A Row Of Staples/Stakes Approximately 12" Apart In The Bottom Of The Trench. Backfill And Compact The Trench After Stapling. Apply Seed To Compacted Soil And Fold Remaining 12" Portion Of ECM Back Over Seed And Compacted Soil. Secure ECM Over Compacted Soil With A Row Of Staples/Stakes Spaced Approximately 12" Apart Across The Width Of The ECM.
 - Begin At The Top Of The Slope By Anchoring The ECM In A 6" Deep x 6" Wide Trench With Remainder Of ECM Extended Beyond The Up-Slope Portion Of The Trench. Anchor The ECM With A Row Of Staples/Stakes Approximately 12" Apart In The Bottom Of The Trench. Backfill And Compact The Trench After Stapling. Apply Seed To Compacted Soil And Fold Remaining Portion Of ECM Back Over Seed And Compacted Soil. Secure ECM Over Compacted Soil With A Row Of Staples/Stakes Spaced Approximately 12" Apart Across The Width Of The ECM.
- Roll The ECM (A.) Down Or (B.) Horizontally Across The Slope. ECM Will Unroll With Appropriate Side Against The Soil Surface. All ECM Must Be Securely Fastened To Soil Surface By Placing Staples/Stakes In Appropriate Locations As Shown In The Staple Pattern Guide. When Using The DOT System, Staples/Stakes Should Be Placed Through Each Of The Colored Dots Corresponding To The Appropriate Staple Pattern.
- The Edges Of Parallel ECM Must Be Stapled With Approximately 2" - 5" Overlap Depending On ECM Type. Do Not Leave Gap.
- Consecutive ECM Spliced Down The Slope Must Be Placed End Over End (Shingle Style) With An Approximate 3" Overlap. Staple Through Overlapped Area, Approximately 12" Apart Across Entire ECM Width.

*In Loose Soil Conditions, The Use Of Staple Or Stake Lengths Greater Than 6" (15 cm) May Be Necessary To Properly Secure The ECM.
- Bury Side And Bottom Edges Of The ECM, 4" - 6" Minimum.
- Extend ECM Down Slope S Minimum Distance Of 2' Beyond Graded Area. See GRADING PLAN Sheet 35-36. For Limits Of Area Of Slope Protection.

EROSION CONTROL MATTING (ECM)

Scale: Not to Scale

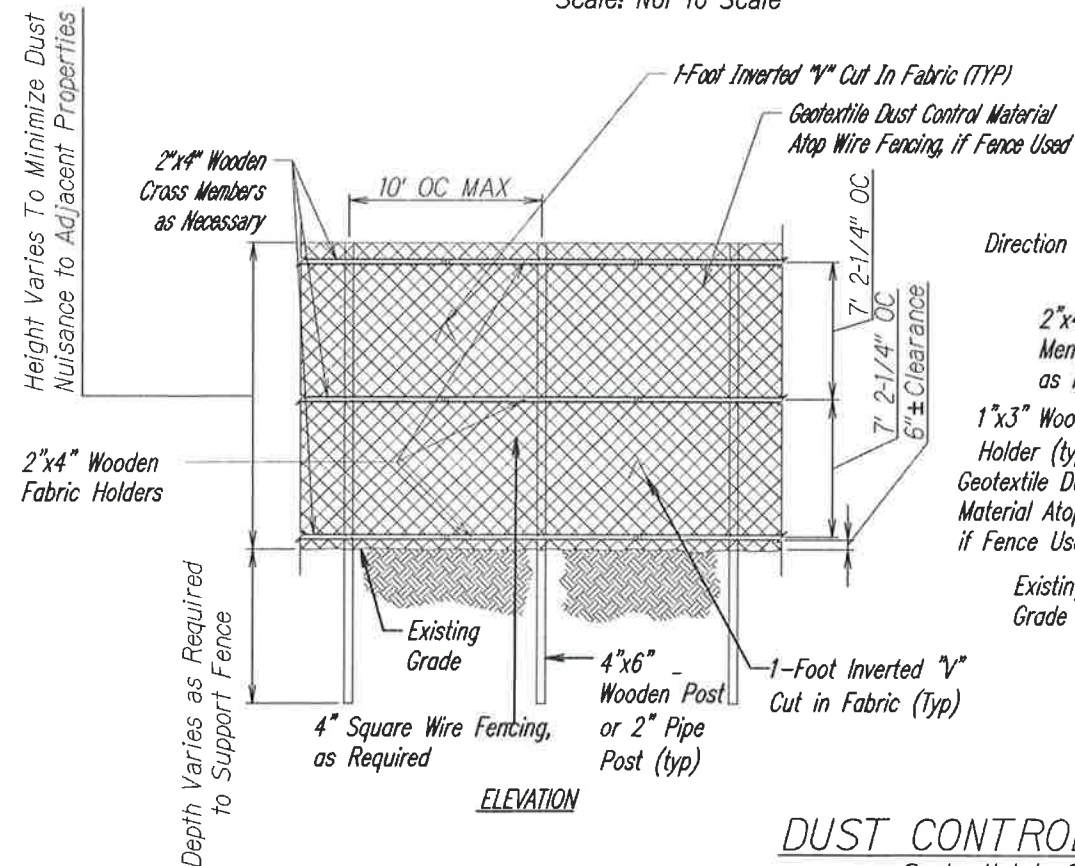


DUST CONTROL FENCE

Scale: Not to Scale


FILTER BAG FOR GRATED DRAIN INLET

Scale: Not to Scale

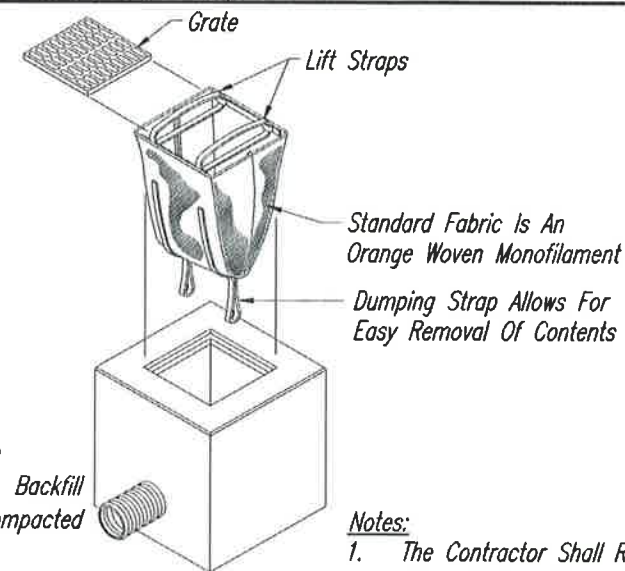

Notes:

- The Contractor Shall Remove Filters During Times of Above Normal Rainfall Events and Replace Them When Event Has Passed.
- The Contractor Shall Remove All Accumulated Sediment and Debris From Vicinity of Unit After Each Storm Event. The Sediment Bag Should be Checked After Each Storm Event and at Regular Intervals. If the Containment Area is More Than 1/3 Full of Sediment, the Unit Must be Emptied.

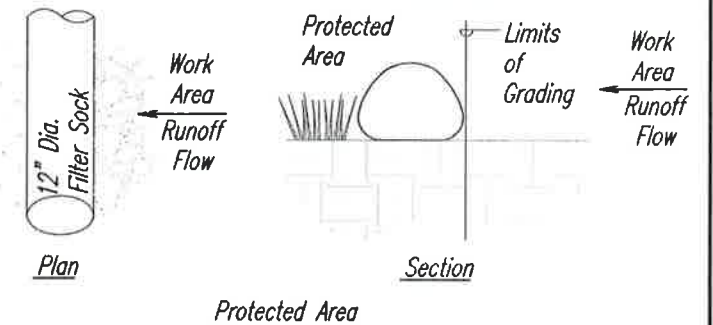

Notes:

- Installation, Inspection, Maintenance and Removal of Compost Filter Socks Shall be Done in Accordance With Manufacturer's Recommendations.
- Provide Necessary Training for Personnel Who Will be Responsible for Implementation of BMPs.

FILTER SOCK

Scale: Not to Scale

Notes:


- Cross Members and Posts of the Wooden Fence Frame Shall be Held Together With Galvanized Steel Flathead Screws.
- Wooden Fabric Holders Shall Fasten the Geotextile Fabric to the Wooden Fence Frame with Galvanized Steel Flathead Screws; Wire Ties Shall be Used if Pipe Posts are Used.
- Wooden Bracing Pieces Shall be Attached to the Wooden Fence Frame With Galvanized Steel Flathead Screws.
- Height of Fence Shall be Field-adjusted by the Contractor to Keep the Project Area and Surrounding Area Free From Dust Nuisance as Indicated in Grading Note 3.
- Appropriate Depth of Wooden or Pipe Fence Frame Posts Shall be Determined in Field by the Contractor.
- Dust Control Fence shall be located outside of clear zone.



LICENSE EXPIRES 4/30/14
THIS WORK WAS PREPARED BY
ME OR UNDER MY SUPERVISION

02/07/14	Added ECM Detail; Rearranged Sheet
STATE OF HAWAII DEPARTMENT OF TRANSPORTATION HIGHWAYS DIVISION	
EROSION CONTROL DETAILS	
Kaaau-Pahoa Road Intersection Improvements at Old Government Road Federal-Aid Project No. HSIP-0130(031)	
Scale: None	Date: August 2013
SHEET No. 1 OF 1 SHEETS	

FED. ROAD DIST. NO.	STATE	FED. AID PROJ. NO.	FISCAL YEAR	SHEET NO.	TOTAL SHEETS
HAWAII	HAW.	HSIP-0130(031)	2013	103	108

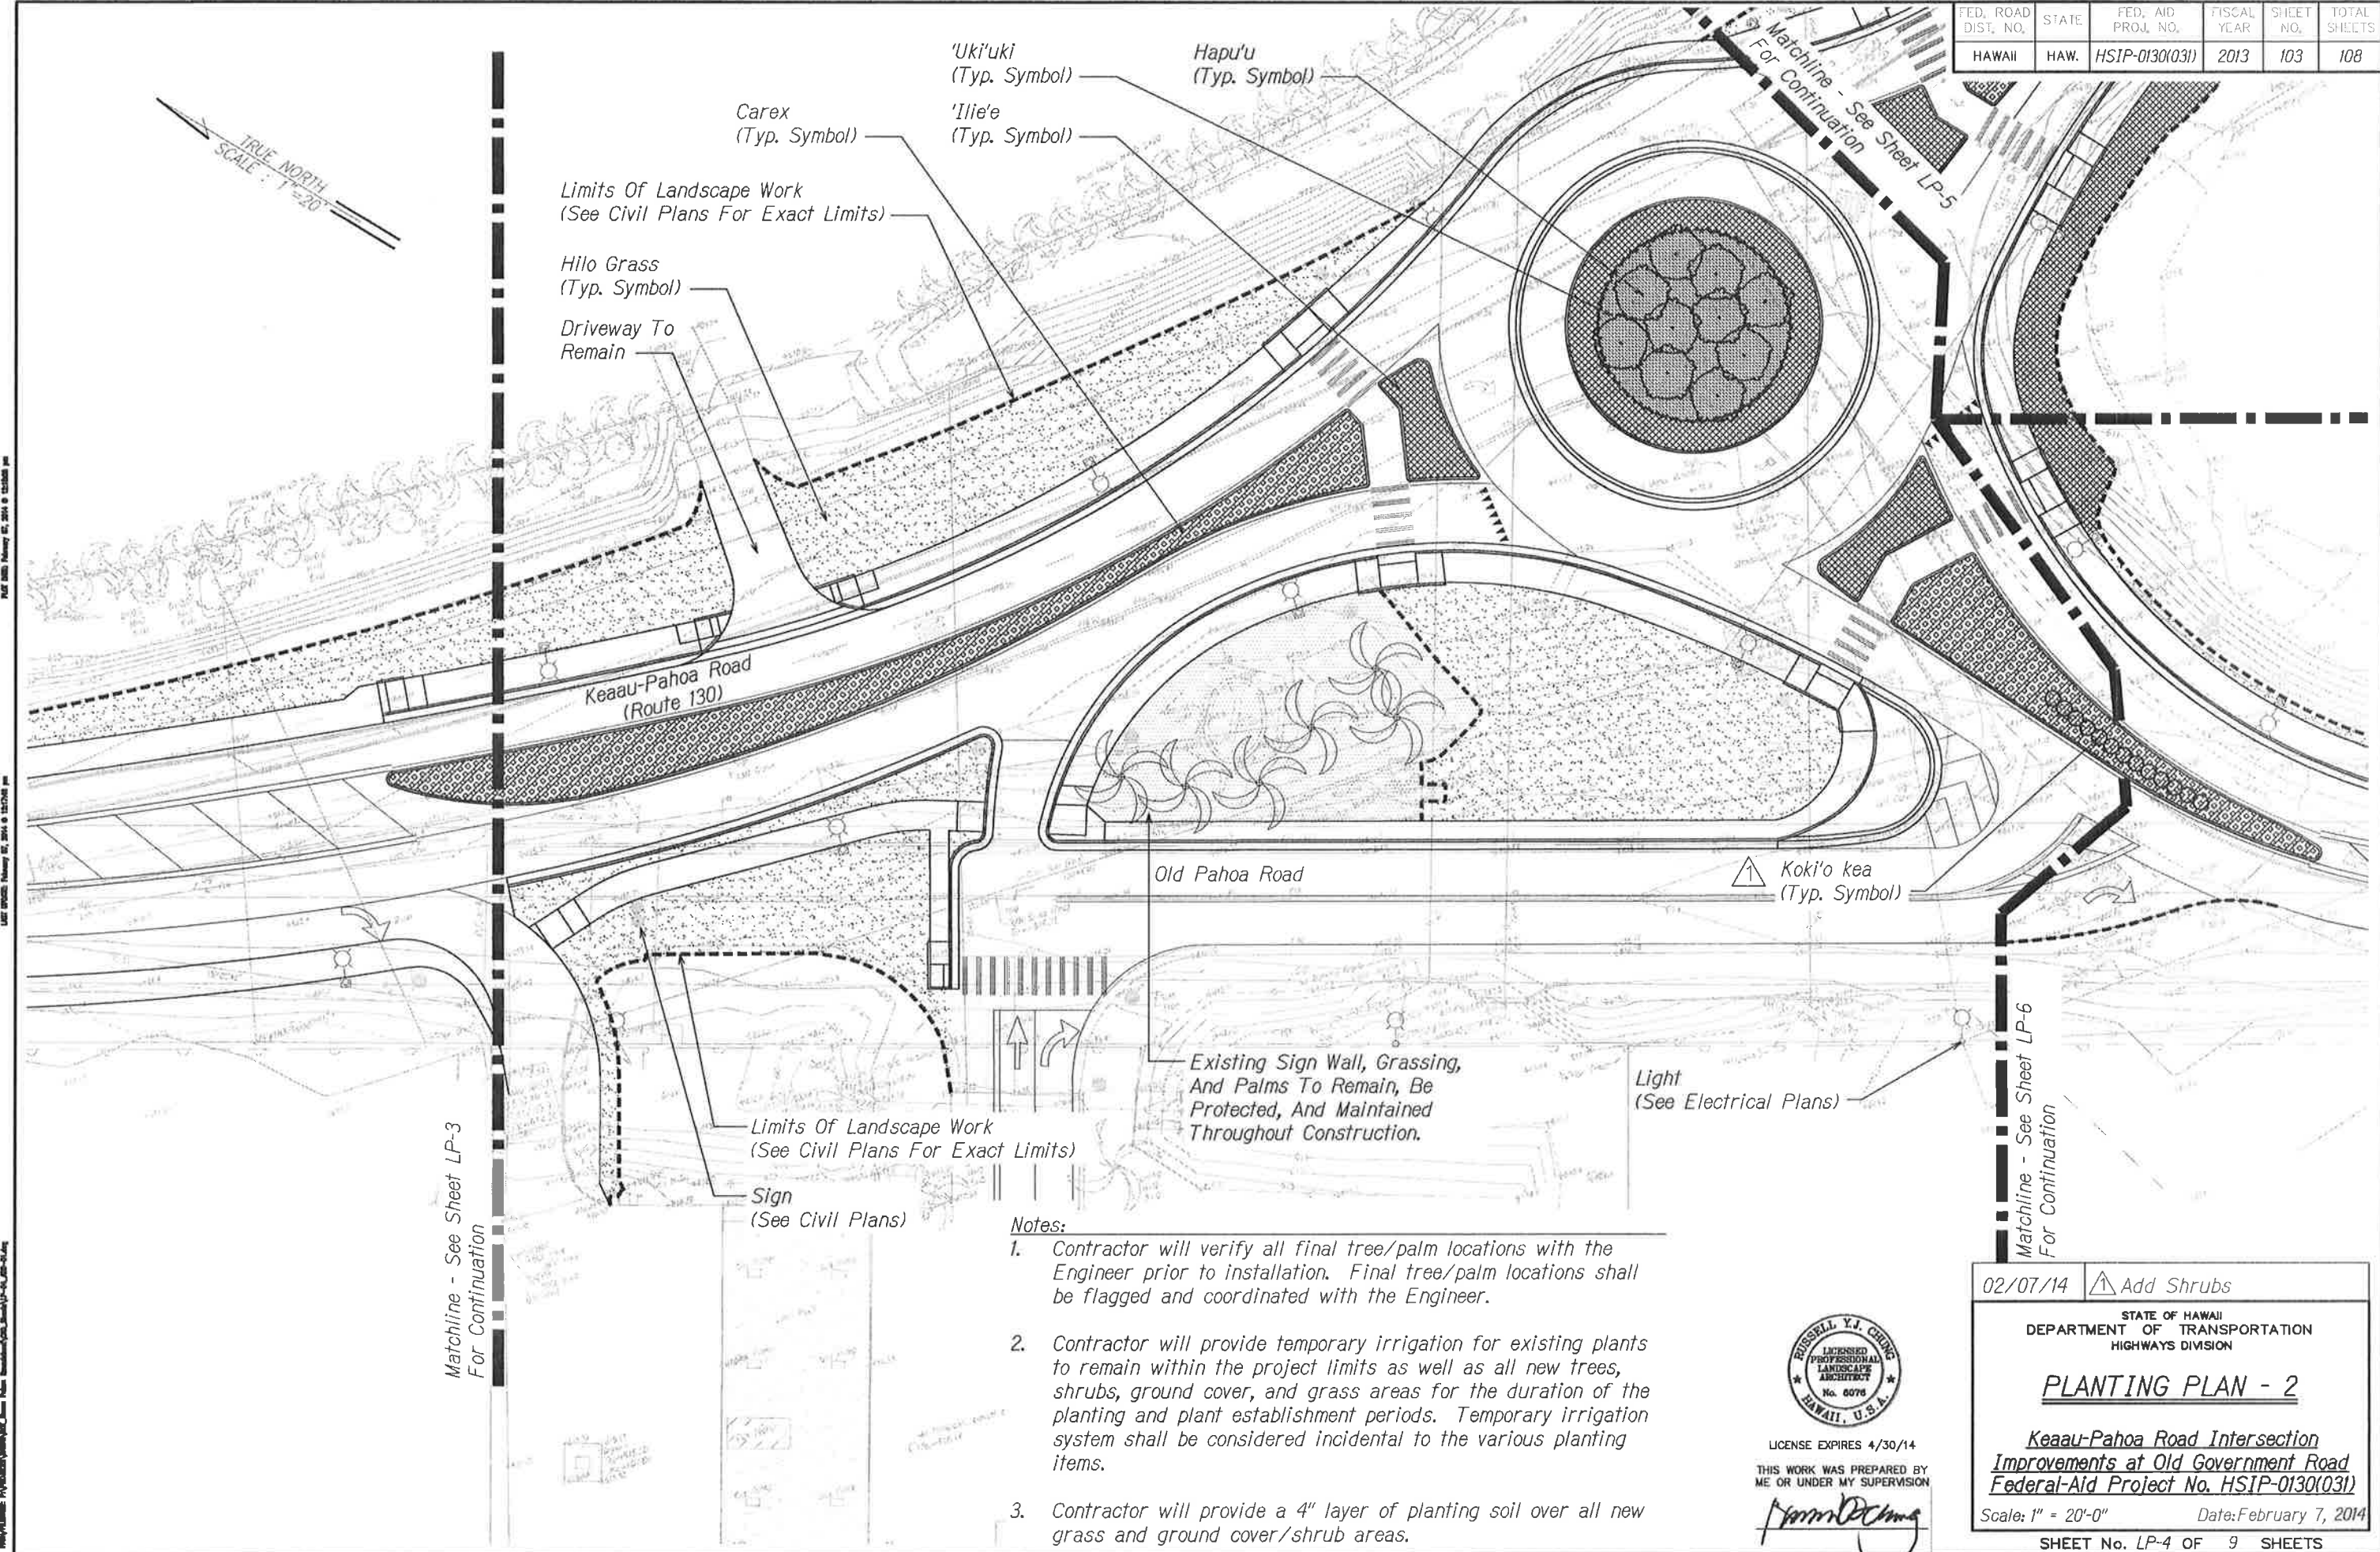

ORIGINAL PLAN	SURVEY PLOTTED BY	DATE
NOTE BOOK	DRAWN BY	
	DESIGNED BY	
	QUANTITIES BY	
	CHECKED BY	





LICENSE EXPIRES 4/30/14

THIS WORK WAS PREPARED BY ME OR UNDER MY SUPERVISION

Handwritten signature

FED. ROAD DIST. NO.	STATE	FED. AID PROJ. NO.	FISCAL YEAR	SHEET NO.	TOTAL SHEETS
HAWAII	HAW.	HSIP-0130(031)	2013	105	108

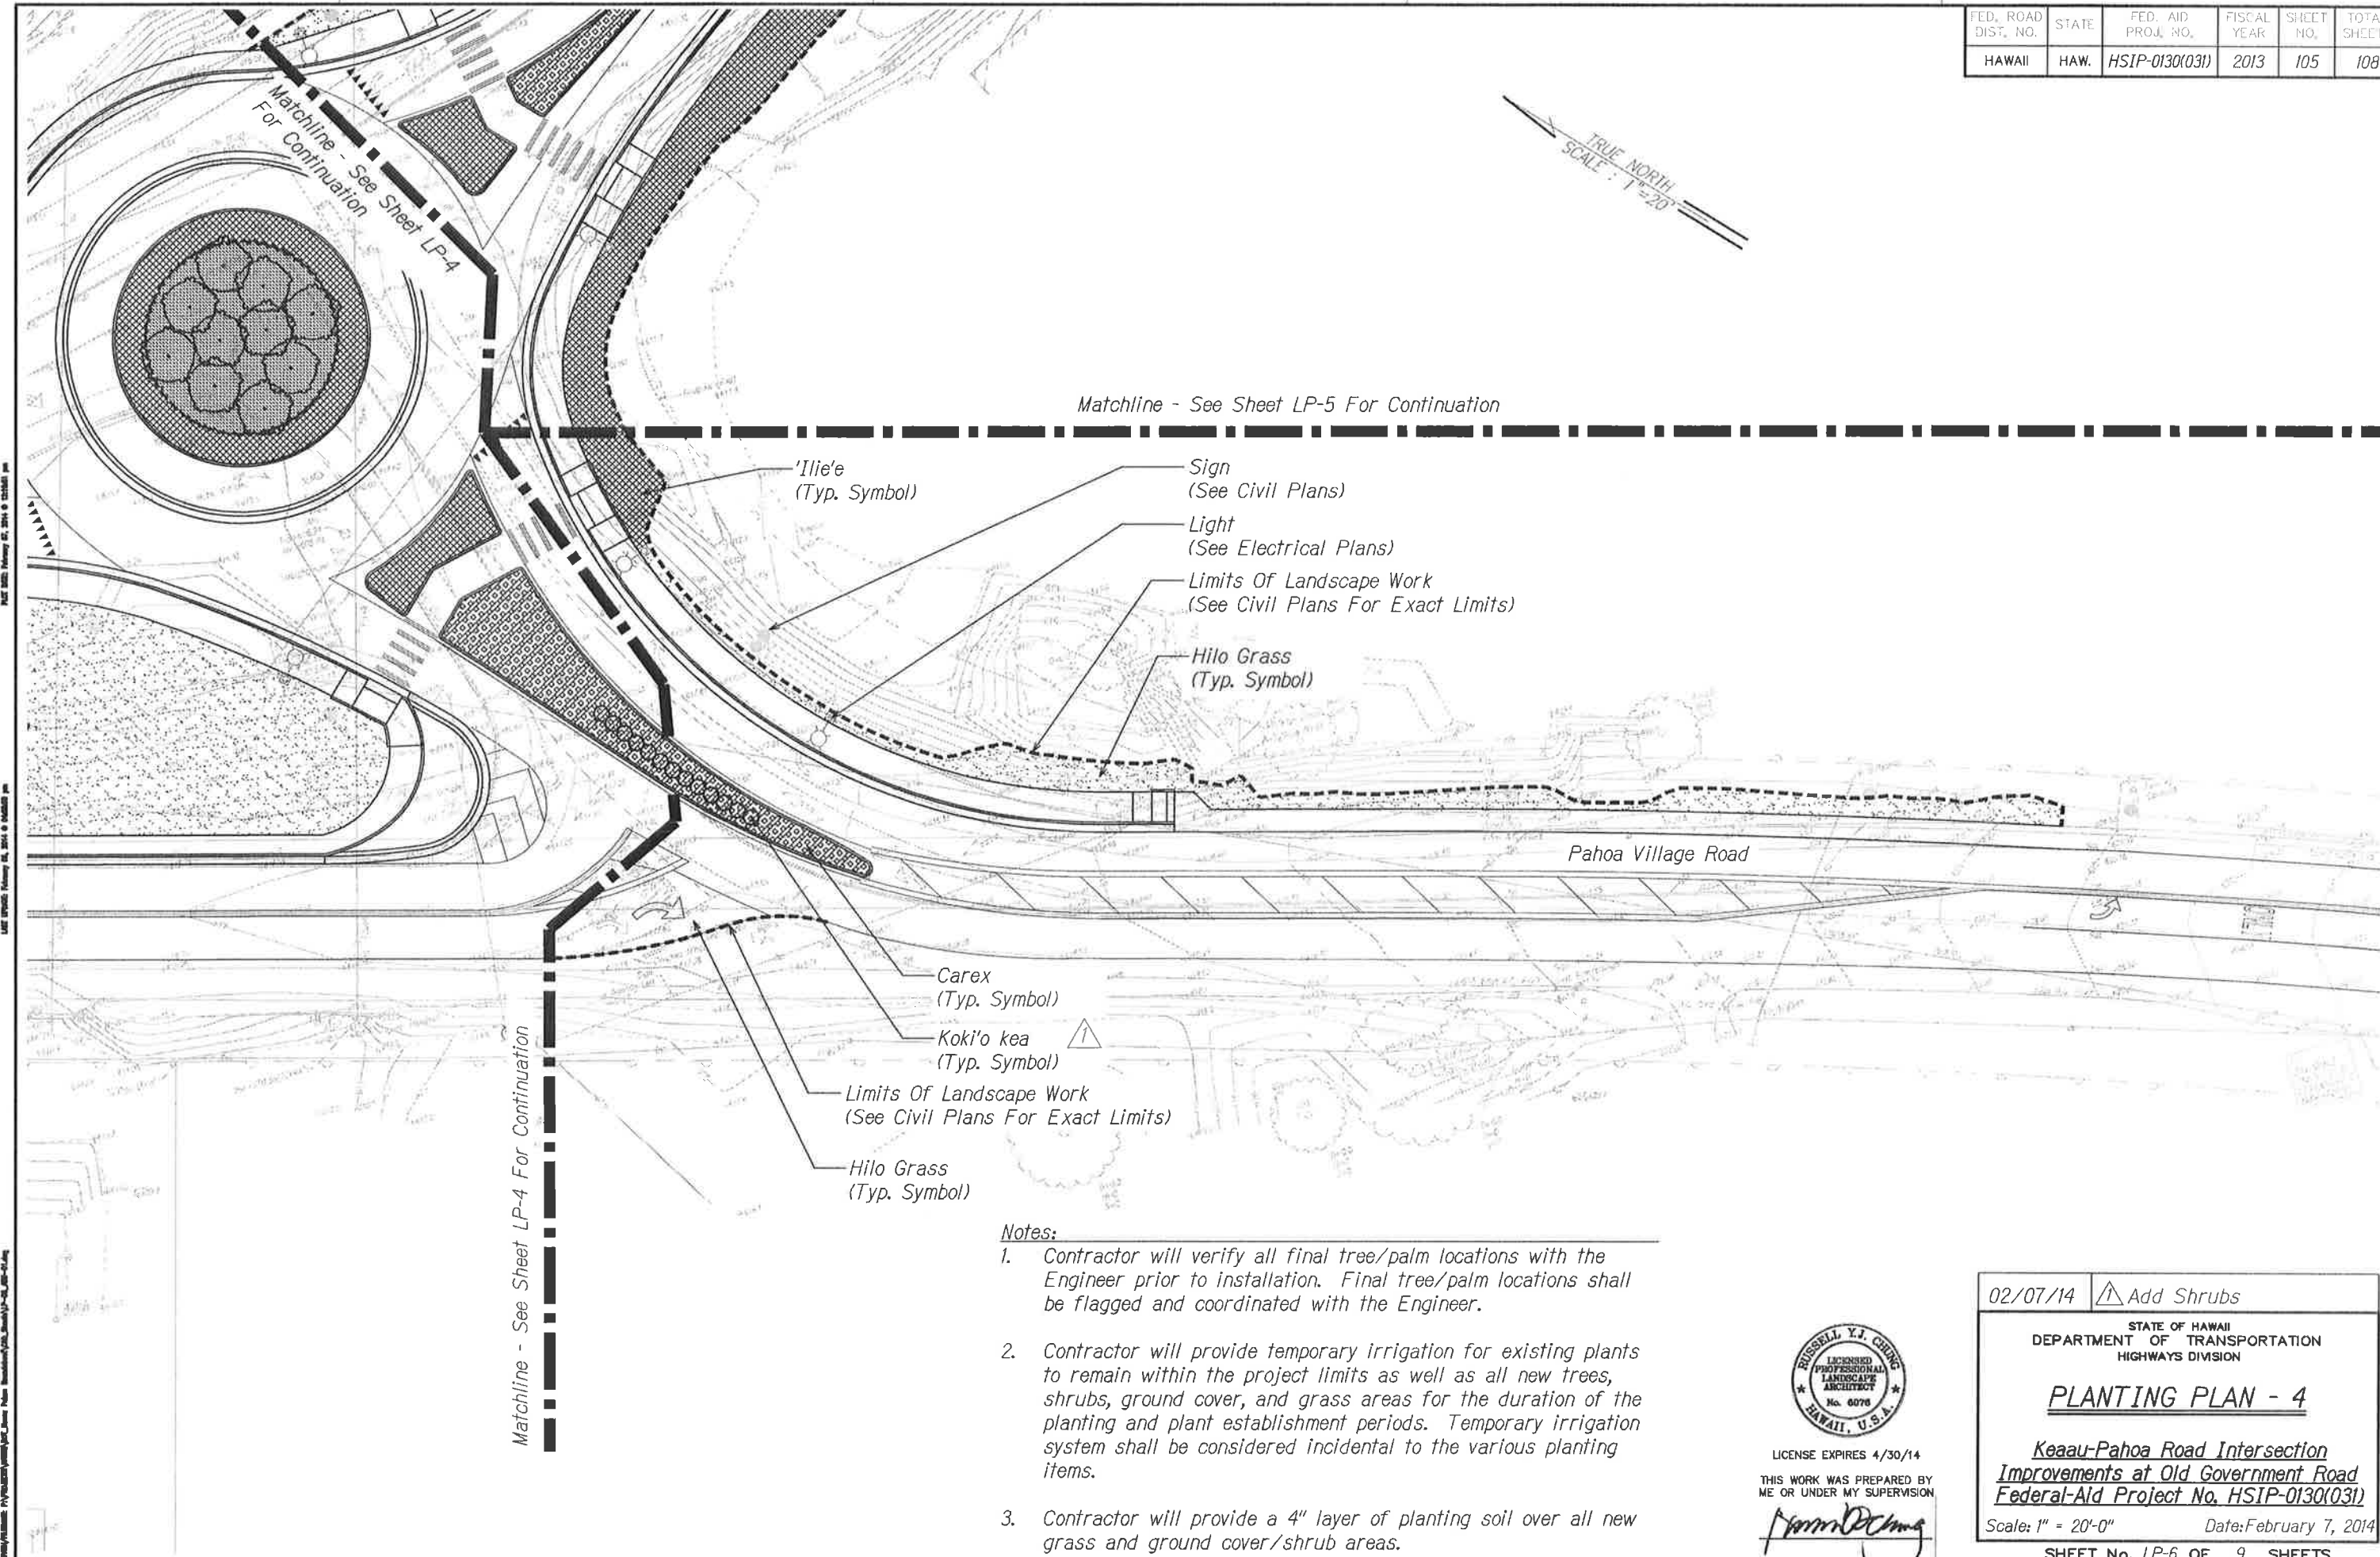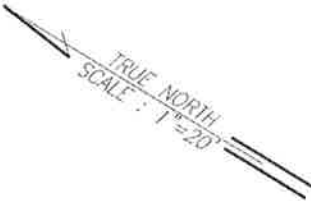

ORIGINAL PLAN	SURVEY PLOTTED BY	DATE
NOTE BOOK	DRAWN BY	
CHECKED BY	DESIGNED BY	
	QUANTITIES BY	

- Notes:
1. Contractor will verify all final tree/palm locations with the Engineer prior to installation. Final tree/palm locations shall be flagged and coordinated with the Engineer.
 2. Contractor will provide temporary irrigation for existing plants to remain within the project limits as well as all new trees, shrubs, ground cover, and grass areas for the duration of the planting and plant establishment periods. Temporary irrigation system shall be considered incidental to the various planting items.
 3. Contractor will provide a 4" layer of planting soil over all new grass and ground cover/shrub areas.



LICENSE EXPIRES 4/30/14
THIS WORK WAS PREPARED BY
ME OR UNDER MY SUPERVISION

[Signature]

02/07/14 Add Shrubs

STATE OF HAWAII
DEPARTMENT OF TRANSPORTATION
HIGHWAYS DIVISION

PLANTING PLAN - 4

Keaau-Pahoa Road Intersection
Improvements at Old Government Road
Federal-Aid Project No. HSIP-0130(031)

Scale: 1" = 20'-0" Date: February 7, 2014

SHEET No. LP-6 OF 9 SHEETS

FED. ROAD DIST. NO.	STATE	FED. AID PROJ. NO.	FISCAL YEAR	SHEET NO.	TOTAL SHEETS
HAWAII	HAW.	HSIP-0130(031)	2013	108	108

PLANT SCHEDULE

<u>NATIVE TREES</u>	<u>BOTANICAL NAME</u>	<u>COMMON NAME</u>	<u>CONT.</u>	<u>SIZE</u>	<u>REMARKS</u>
	CIBOTIUM GLAUCUM	HAPU'U	FIELD STOCK	4'-6' T.H.	
<u>SHRUBS</u>	<u>BOTANICAL NAME</u>	<u>COMMON NAME</u>	<u>CONT.</u>		<u>REMARKS</u>
	HIBISCUS WAIMEAE	KOKI'O KEA	3 GAL.		BUSHY
<u>SHRUB AREAS</u>	<u>BOTANICAL NAME</u>	<u>COMMON NAME</u>	<u>CONT.</u>		<u>REMARKS</u>
	DIANELLA SANDWICENSIS	'UKI'UKI	6" POTS		18" O.C. TRIANGULAR SPACING
<u>GROUND COVERS</u>	<u>BOTANICAL NAME</u>	<u>COMMON NAME</u>	<u>CONT.</u>		<u>REMARKS</u>
	CAREX WAHUENSIS	CAREX	6" POTS @ 12" OC		
	PLUMBAGO ZEYLANICA	'ILIE'E	4" POTS @ 18" OC		
<u>GRASSES</u>	<u>BOTANICAL NAME</u>	<u>COMMON NAME</u>	<u>CONT.</u>		<u>REMARKS</u>
	PASPALUM CONJUGATUM	HILO GRASS	SPRIGS		

ORIGINAL PLAN

NOTE BOOK

No. _____

SURVEY PLOTTED BY _____

DATE _____

DRAWN BY _____

DESIGNED BY _____

CHECKED BY _____

PLANT SCHEDULE - February 7, 2014 - 8:00 AM

DATE: 02/07/14

PLANT SCHEDULE - February 7, 2014 - 8:00 AM



LICENSE EXPIRES 4/30/14

THIS WORK WAS PREPARED BY ME OR UNDER MY SUPERVISION

[Signature]

02/07/14  Add Shrubs

STATE OF HAWAII
DEPARTMENT OF TRANSPORTATION
HIGHWAYS DIVISION

PLANT SCHEDULE

Keaau-Pahoa Road Intersection
Improvements at Old Government Road
Federal-Aid Project No. HSIP-0130(031)

Scale: NONE Date: February 7, 2014

SHEET No. LP-9 OF 9 SHEETS

ADD. 108