


FED. ROAD DIST. NO.	STATE	FED. AID PROJ. NO.	FISCAL YEAR	SHEET NO.	TOTAL SHEETS
HAWAII	HAW.	HSIP-0130(031)	2014	9	108

T.M.K. 1-05-07:79

Route 130 New B

①	②	③	④	⑤	⑥
B CURVE DATA	B CURVE DATA	B CURVE DATA	B CURVE DATA	B CURVE DATA	B CURVE DATA
$\Delta = 27^{\circ}44'25''$	$\Delta = 11^{\circ}23'51''$	$\Delta = 34^{\circ}16'40''$	$\Delta = 08^{\circ}54'14''$	$\Delta = 49^{\circ}45'35''$	$\Delta = 03^{\circ}26'21''$
$R = 810.00'$	$R = 350.00'$	$R = 350.00'$	$R = 1180.00'$	$R = 200.00'$	$R = 2864.79'$
$T = 200.01'$	$T = 34.93'$	$T = 107.93'$	$T = 91.87'$	$T = 92.75'$	$T = 86.00'$
$L = 388.35'$	$L = 69.51'$	$L = 206.28'$	$L = 183.19'$	$L = 168.29'$	$L = 171.93'$
$Lc = 392.17'$	$Lc = 69.62'$	$Lc = 209.39'$	$Lc = 183.37'$	$Lc = 173.69'$	$Lc = 171.95'$

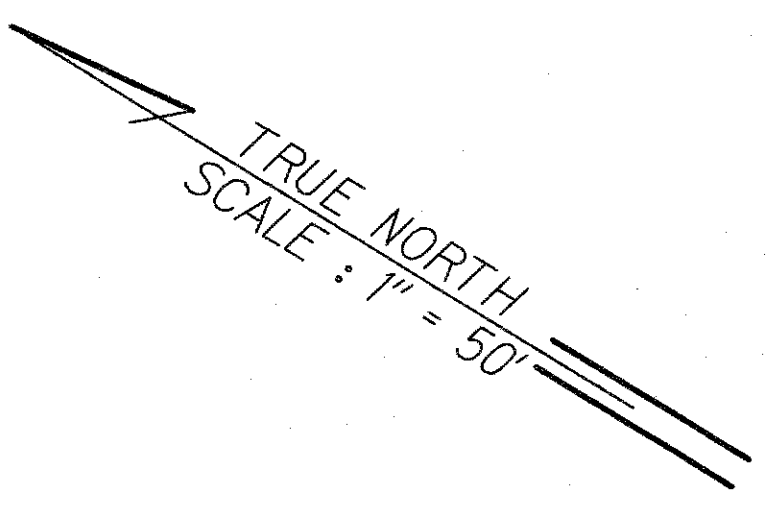

LEGEND FOR AS-BUILT POSTINGS

Squiggly line for as-built deletion

Double line for as-built deletion

Roadway Text for as-built posting

Notes:

1. Keaau-Pahoa Road: Route 130 Exist. B Sta 9+00 to Sta 17+00
2. Pahoa Bypass Road: Route 130 Exist. B Sta 17+00 to Sta 20+00

Route 130
New B Sta. 8+60.00
Project No. HSIP-0130(031)
BEGIN PROJECT

Cold Plane and Repave 2" HMA Pav't, Mix No. IV

Route 130 Exist B
(See Notes)

T.M.K. 1-05-07:19

Proposed Roundabout

PRC: 16+26.45

New Splitter Island

PRC: 15+56.83

Route 130 New B

Cold Plane and Repave 2" HMA Pav't, Mix No. IV

Route 130
New B Sta. 22+18.90
Project No. HSIP-0130(031)
END PROJECT

Old Government Road New B Sta. 5+42.00
Project No. HSIP-0130(031)
END PROJECT

T.M.K. 1-05-07:20

Woodland Center

New Splitter Island
BP: 0+00.00

Old Government Road New B

PC: 1+04.40

PT: 2+78.10

PC: 3+70.05

Cold Plane and Repave 2" HMA Pav't, Mix No. IV

T.M.K. 1-05-07:07


Cold Plane and Repave 4" HMA Pav't, Mix No. IV

T.M.K. 1-05-07:80

Pahoa Marketplace

OVERALL SITE PLAN

Scale: 1" = 50'

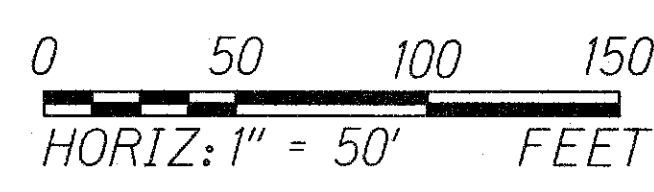

LICENSE EXPIRES 4/30/18
THIS WORK WAS PREPARED BY ME OR UNDER MY SUPERVISION

Date: July 18, 2014

STATE OF HAWAII
DEPARTMENT OF TRANSPORTATION
HIGHWAYS DIVISION

OVERALL SITE PLAN

Keaau-Pahoa Road Intersection
Improvements at Old Government Road
Federal-Aid Project No. HSIP-0130(031)

Scale: 1" = 50' Date: August 2013

SHEET No. 1 OF 1 SHEETS

"AS-BUILT"

SURVEY PLOTTED BY	DATE
DRAWN BY	
DESIGNED BY	
QUANTITIES BY	
CHECKED BY	
NO.	

PLOT DATE: February 24, 2017 @ 04:11:01 pm
 LAST UPDATE: February 24, 2017 @ 03:54:31 pm
 P:\PROJECTS\HSIP-0130(031)\Keaau-Pahoa Road Intersection\Overall Site Plan\Overall Site Plan.dwg