


FED. ROAD DIST. NO.	STATE	FED. AID PROJ. NO.	FISCAL YEAR	SHEET NO.	TOTAL SHEETS
HAWAII	HAW.	HSIP-0130(031)	2014	63	108

KEYS:

- ① Remove Exist. Sign(s) $\neq$ Post(s)
- ② Remove Exist. Sign(s) w/ Post(s);
Relocate $\neq$ Reinstall Exist. Sign(s) w/ New Post(s)
- ③ Exist. Sign(s) $\neq$ Post(s) to Remain
- ④ Install New Sign(s) $\neq$ Post(s)
- ⑤ Remove Exist. Sign(s) w/ Post(s);
Install New Sign(s) w/ New Post(s)
- ⑥ Relocate Exist. Sign(s)

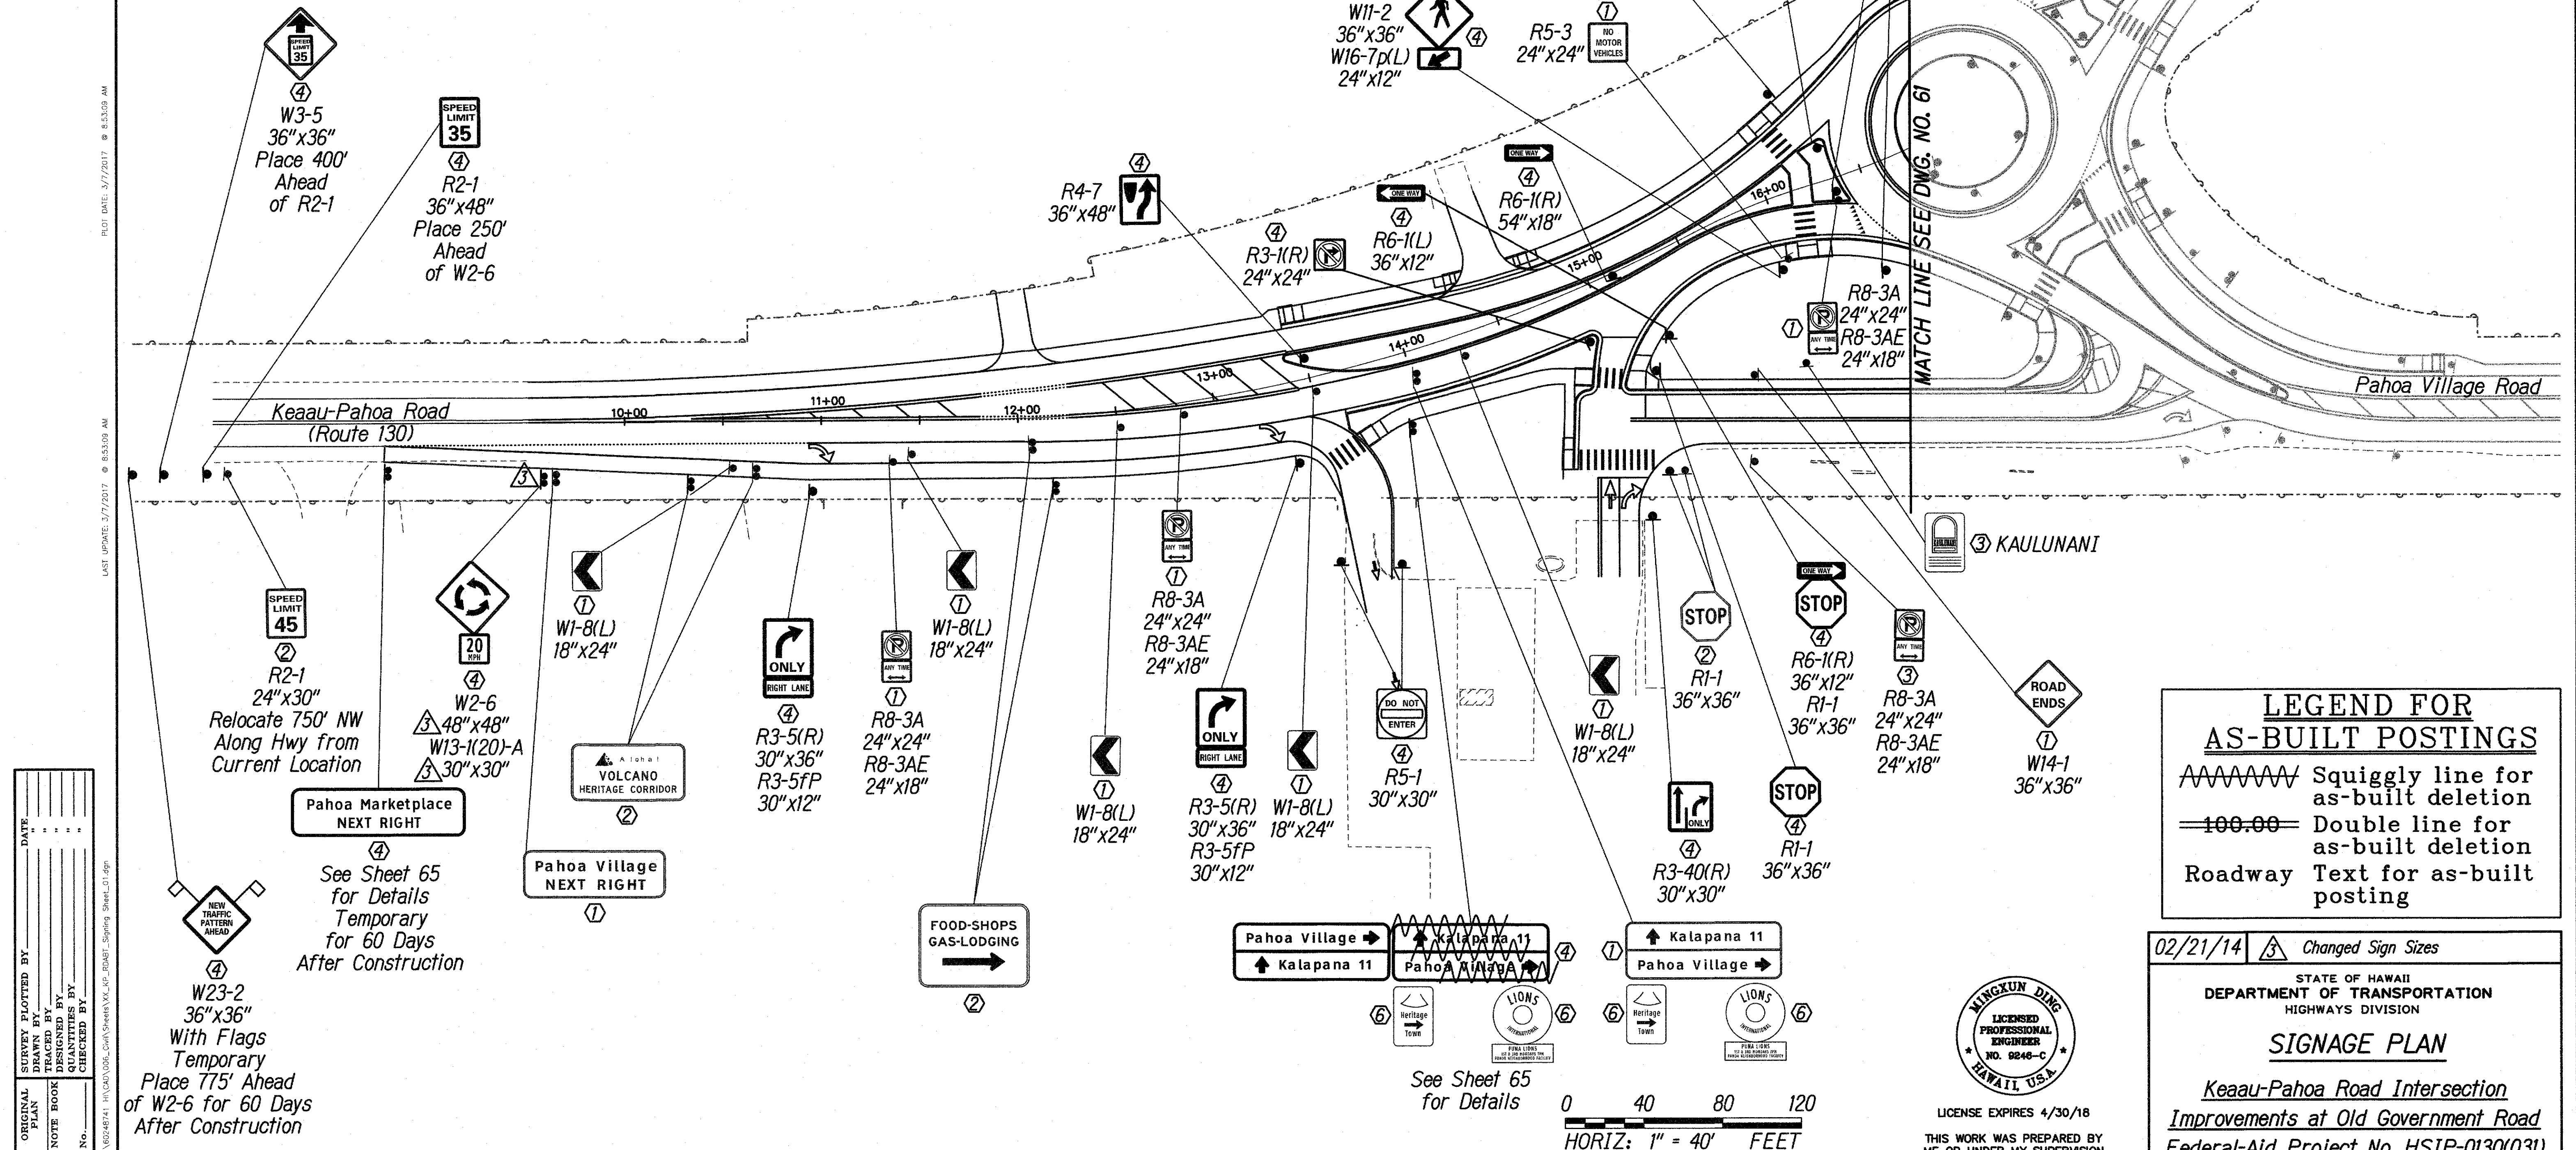

LEGEND FOR AS-BUILT POSTINGS

	Squiggly line for as-built deletion
	Double line for as-built deletion
Roadway	Text for as-built posting

02/21/14	 Changed Sign Sizes
STATE OF HAWAII DEPARTMENT OF TRANSPORTATION HIGHWAYS DIVISION	
<u>SIGNAGE PLAN</u>	
<u>Keaau-Pahoa Road Intersection</u> <u>Improvements at Old Government Road</u> <u>Federal-Aid Project No. HSIP-0130(031)</u>	
Scale: 1" = 40'	Date: August 2013
SHEET NO. 1 OF 2 SHEETS	

”AS-BUILT”





ADD. 63

PLOT DATE: 3/7/2017 @ 8:52:27 AMAST UPDATE: 3/7/2017 8:52:27 AM

PATH/FILENAME: Z:\60248741 HI\CAD\006_Civil\Sheets\XX_KP_RDABI_Signing Sheet_02.dgn





FED. ROAD DIST. NO.	STATE	FED. AID PROJ. NO.	FISCAL YEAR	SHEET NO.	TOTAL SHEETS
HAWAII	HAW.	HSIP-0130(031)	2014	65	108

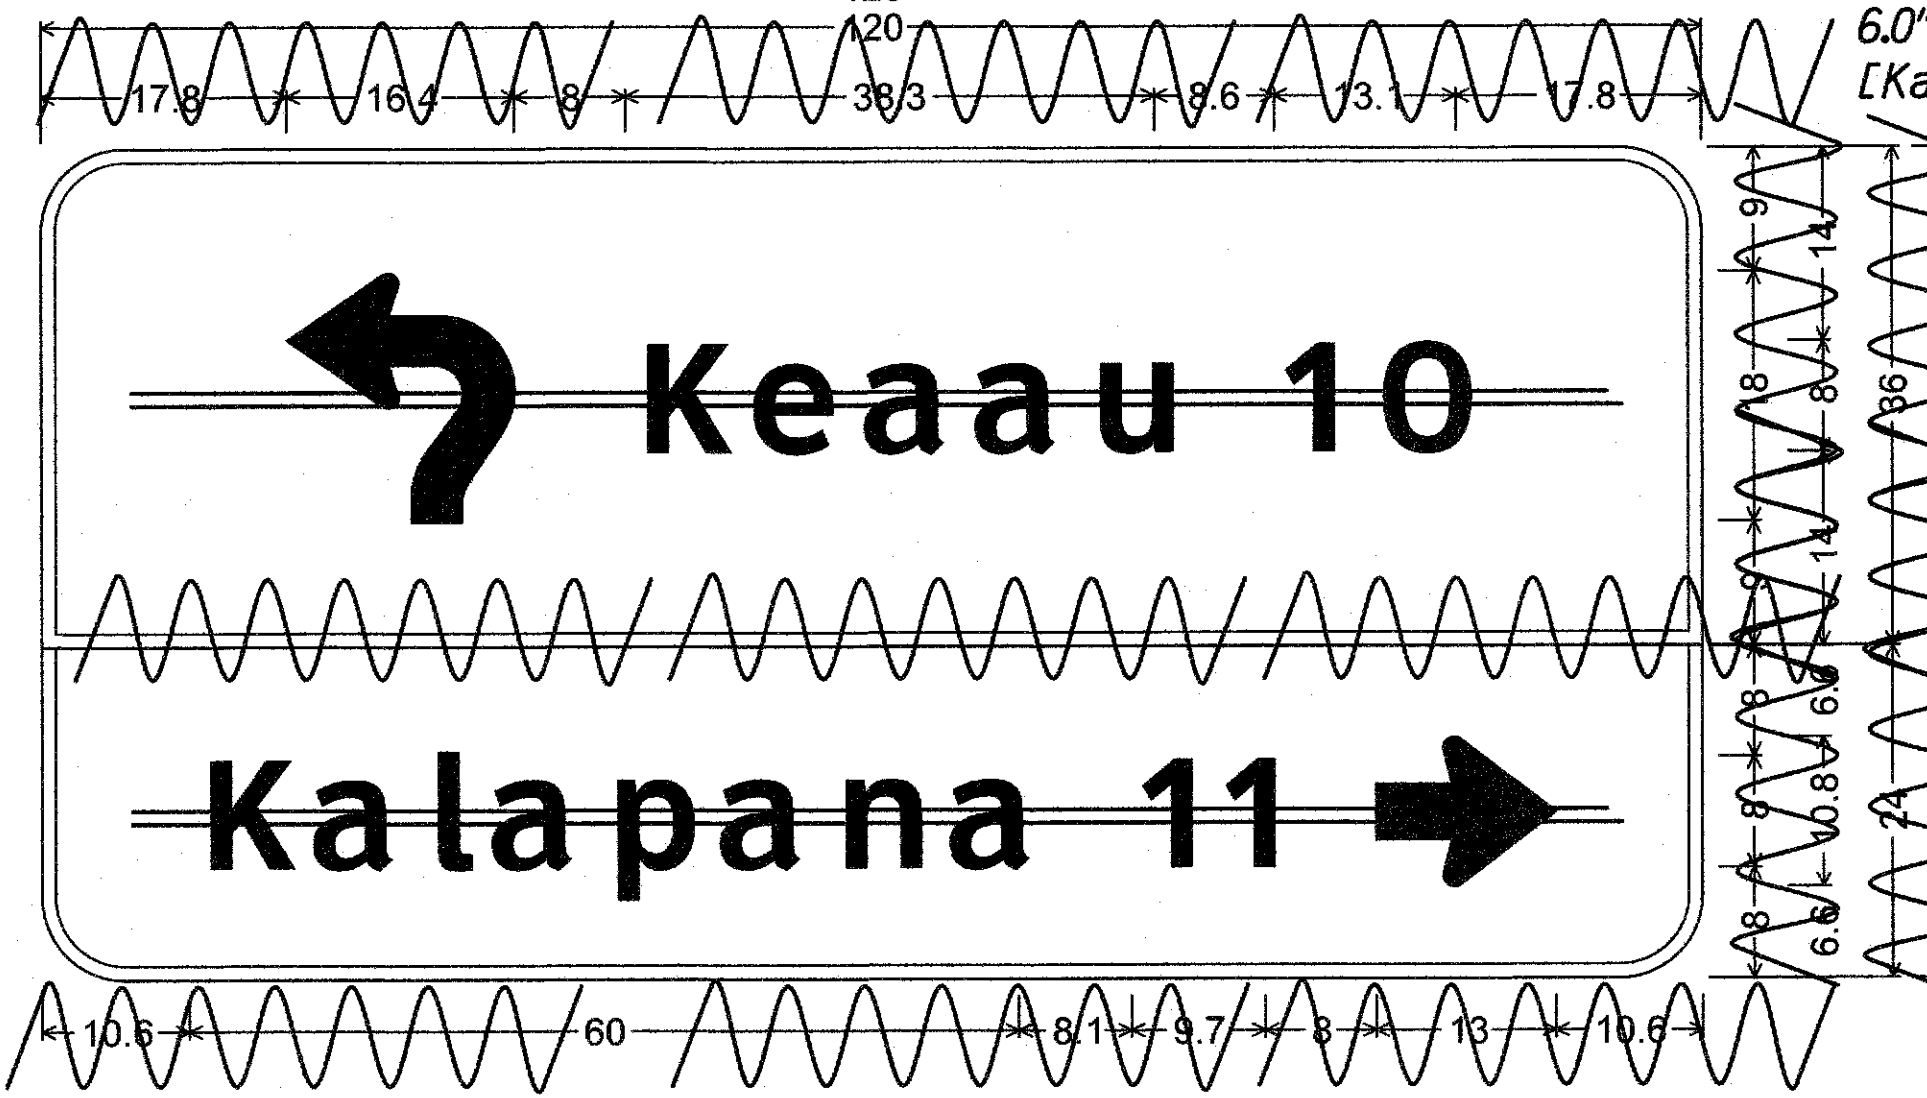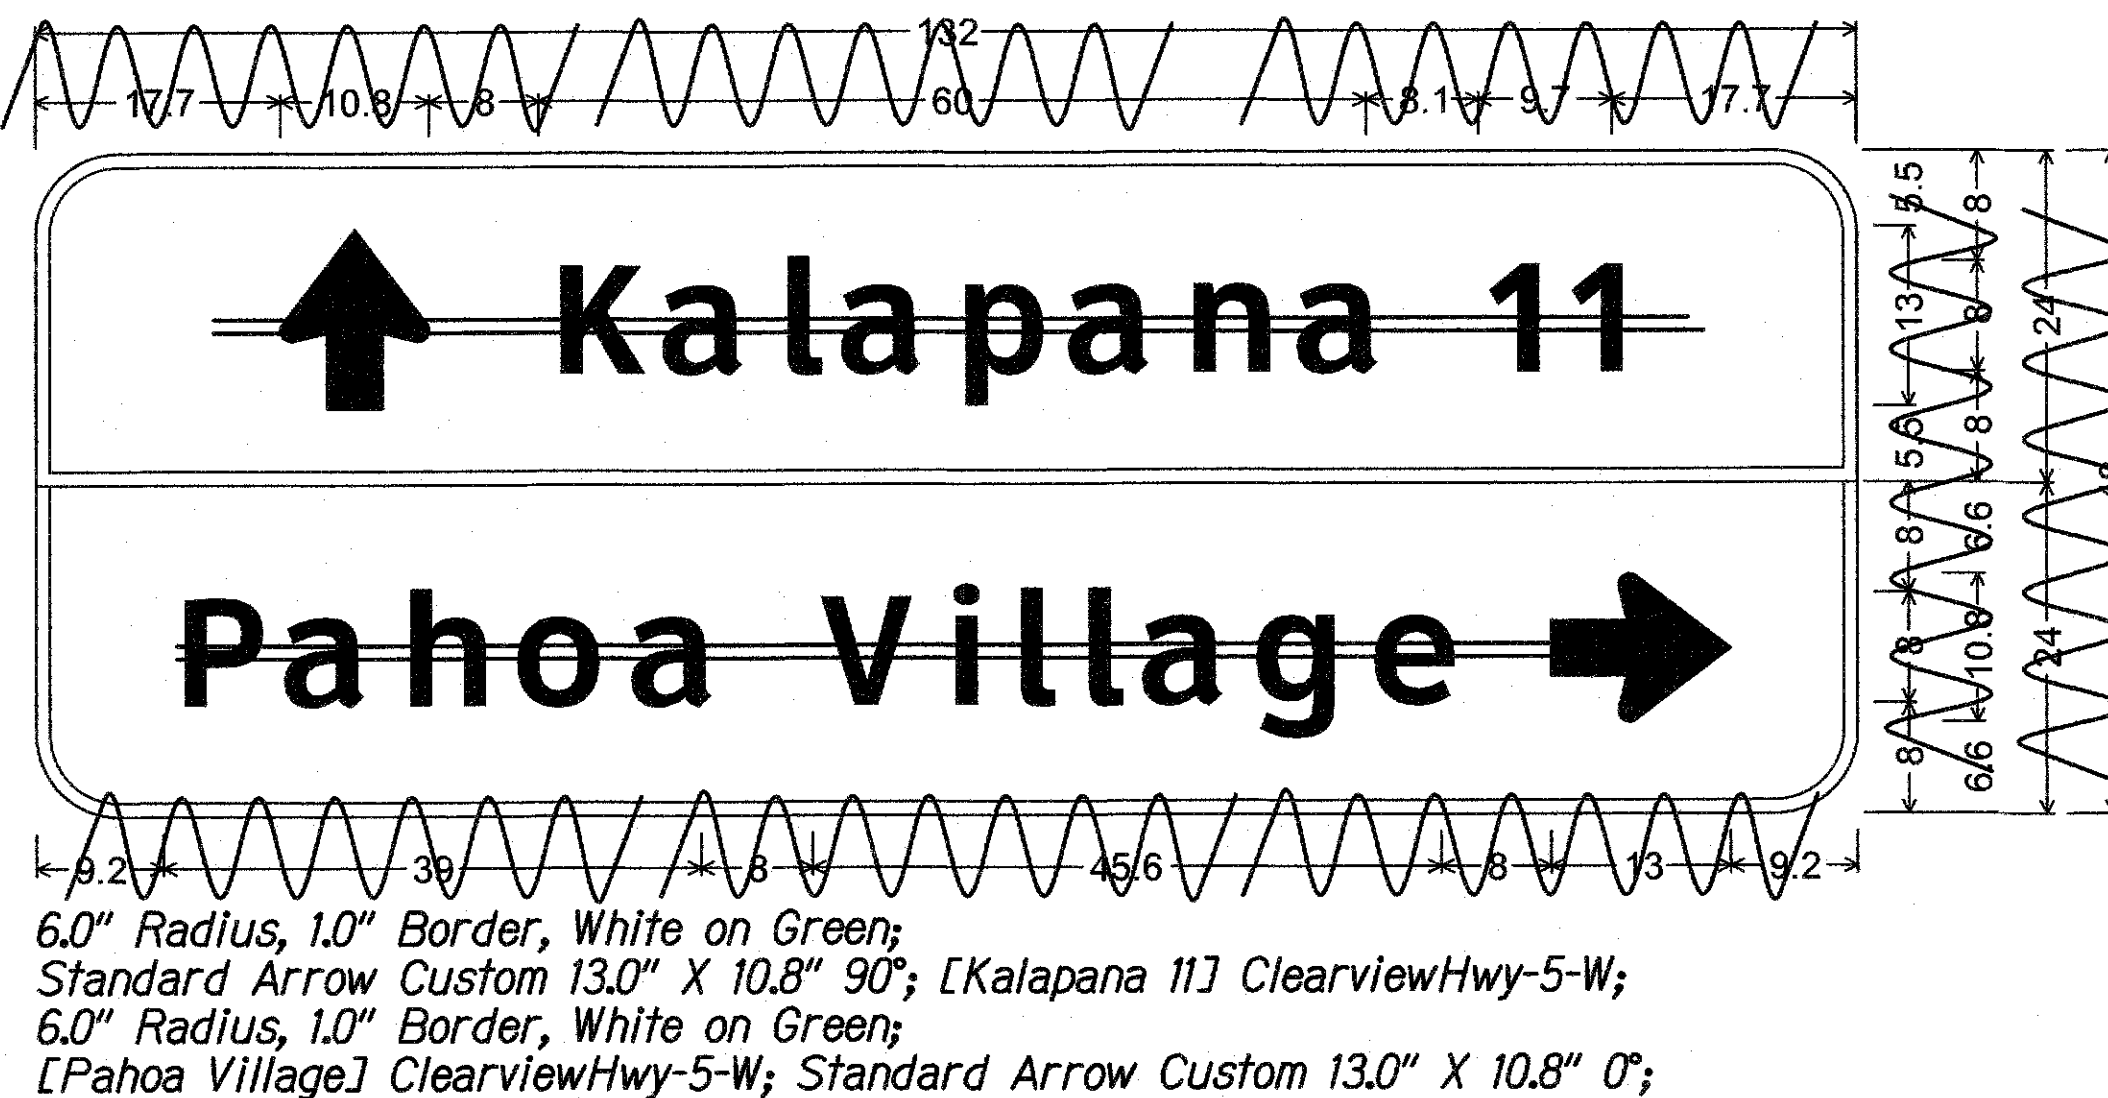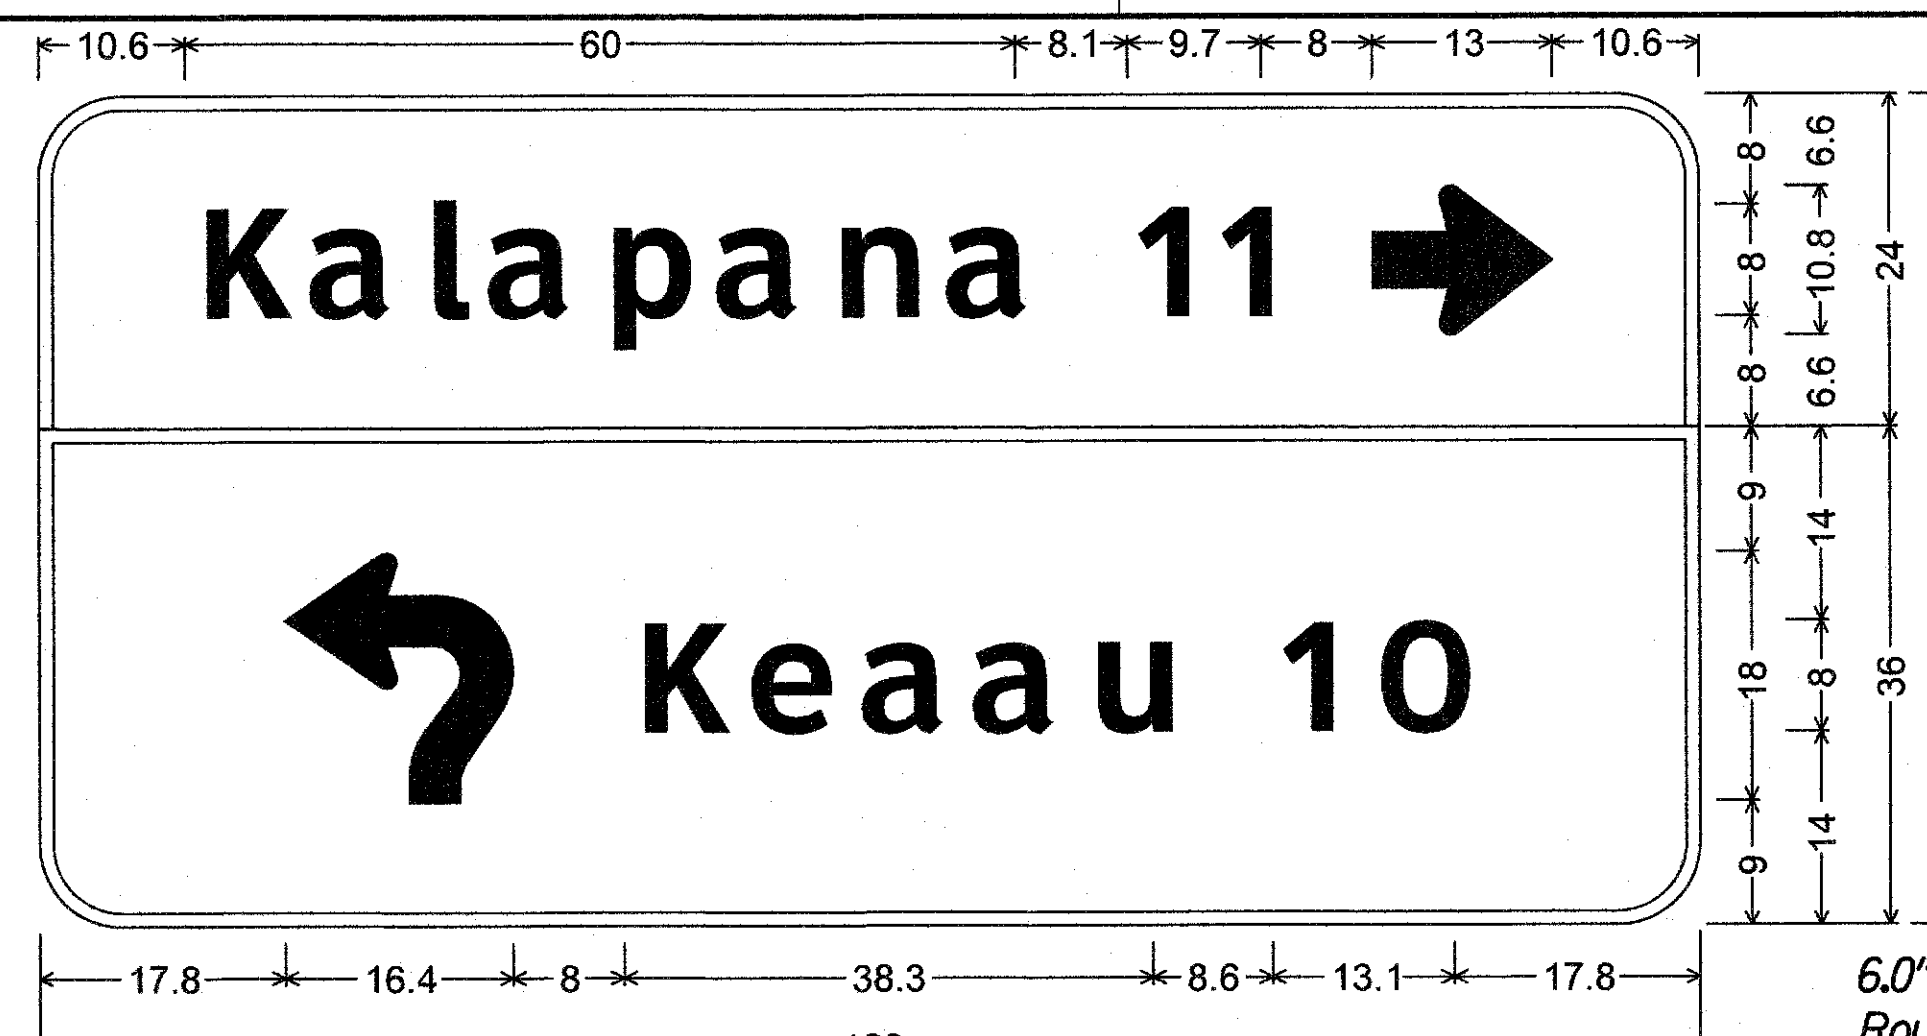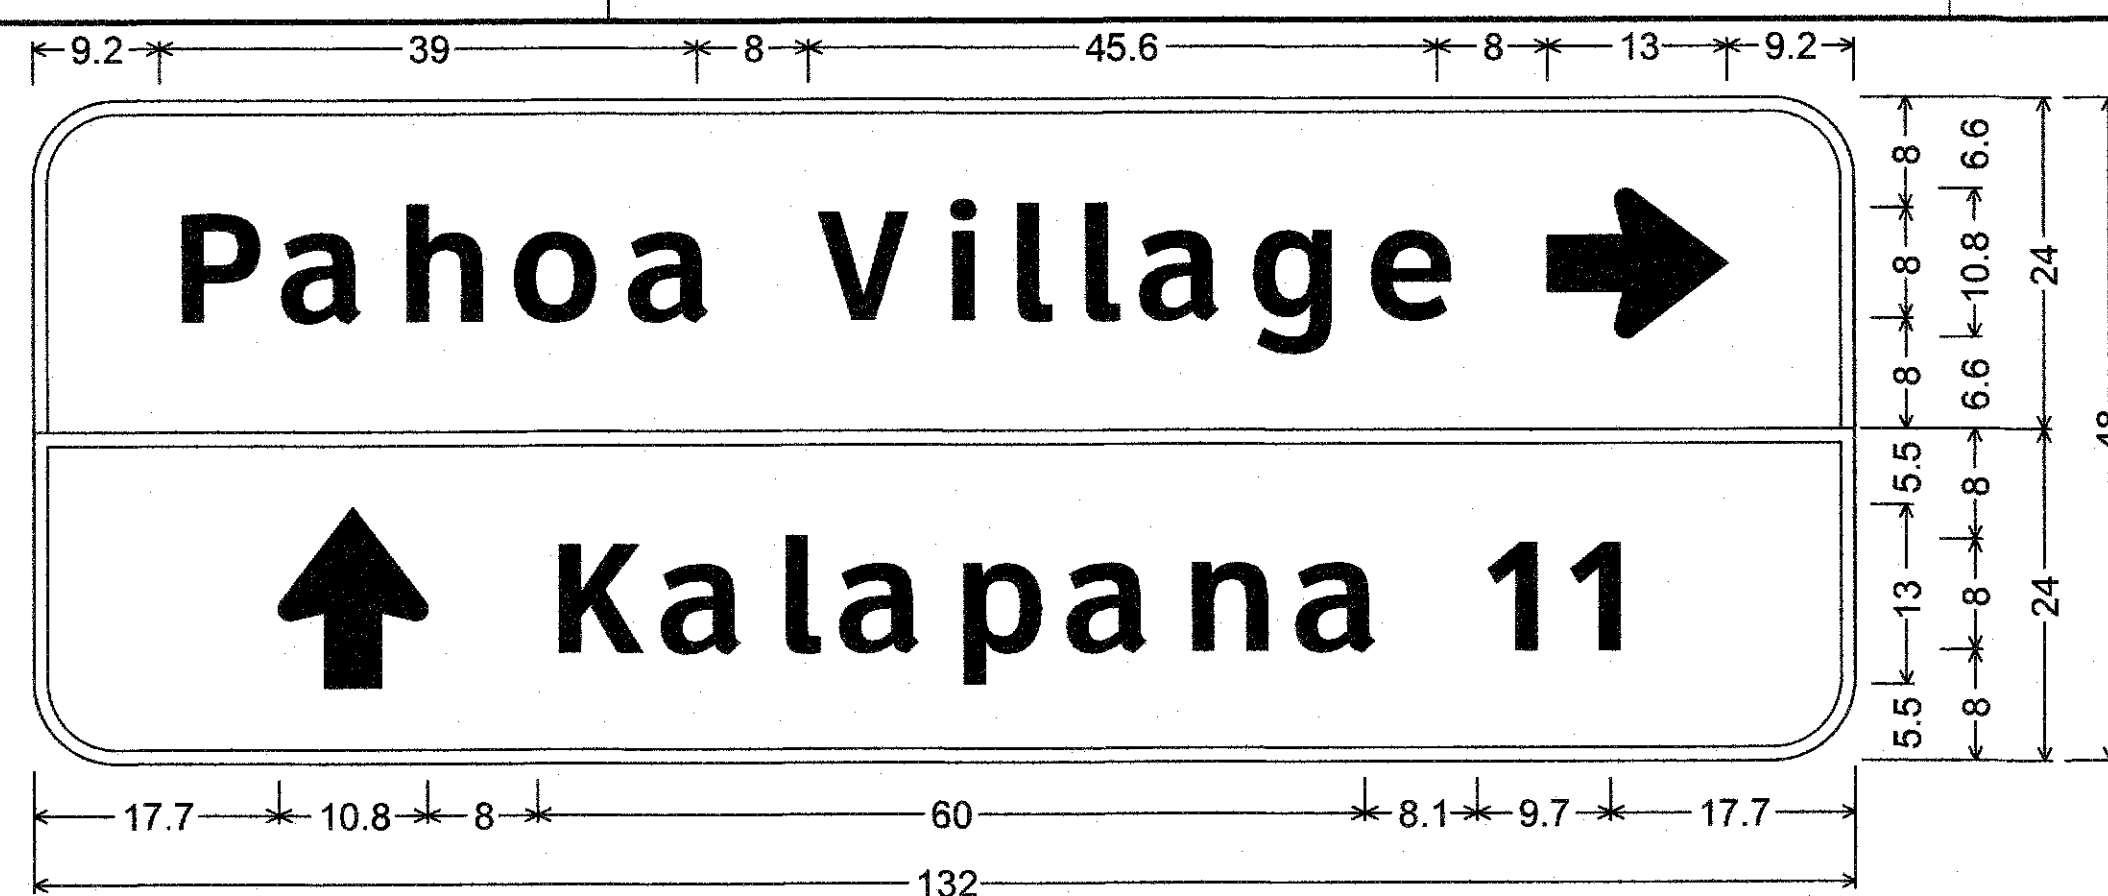

6.0" Radius, 1.0" Border, White on Green;
Roundabout Arrow - 8"; [Keaau 10] ClearviewHwy-5-W;
6.0" Radius, 1.0" Border, White on Green;
[Kalapana 11] ClearviewHwy-5-W; Standard Arrow Custom 13.0" X 10.8" 0°;

LEGEND FOR AS-BUILT POSTINGS	
	Squiggly line for as-built deletion
	Double line for as-built deletion
	Roadway Text for as-built posting

6.0" Radius, 1.0" Border, White on Green;
Standard Arrow Custom 13.0" X 10.8" 90°; [Kalapana 11] ClearviewHwy-5-W;
6.0" Radius, 1.0" Border, White on Green;
[Pahoa Village] ClearviewHwy-5-W; Standard Arrow Custom 13.0" X 10.8" 0°;

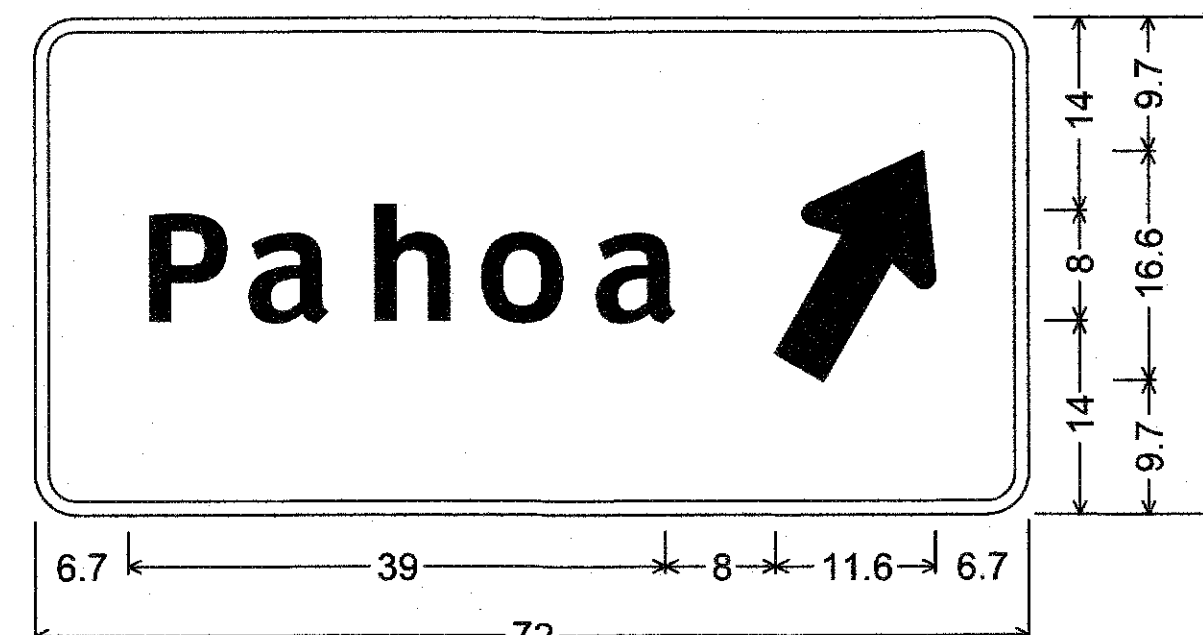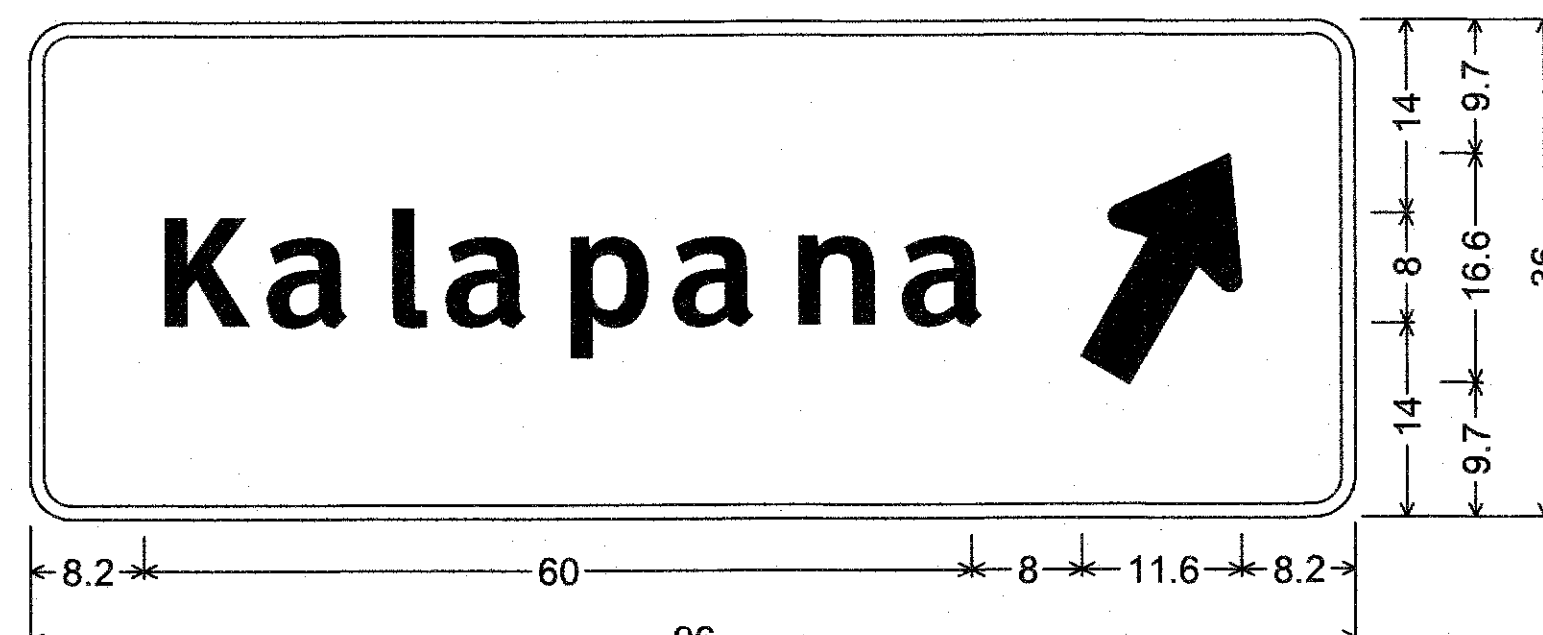


NOTES:


1. All Letters and Figures Shall Conform to the Latest Edition of FHWA Publication "Standard Alphabets for Highway Signs" and as Amended.
2. For Sign Panel Mounting Details Refer to "Laminated Aluminum Sign Panels (Ground Mounted)" TE-23 of the State Highways Standard Plans.
3. All sign dimensions are in inches, unless otherwise noted.

3.0" Radius, 1.0" Border, White on Green;
[Kalapana] ClearviewHwy-5-W;
Standard Arrow Custom 18.0" X 10.8" 60°;


3.0" Radius, 1.0" Border, White on Green;
[Pahoa] ClearviewHwy-5-W;
Standard Arrow Custom 18.0" X 10.8" 60°;

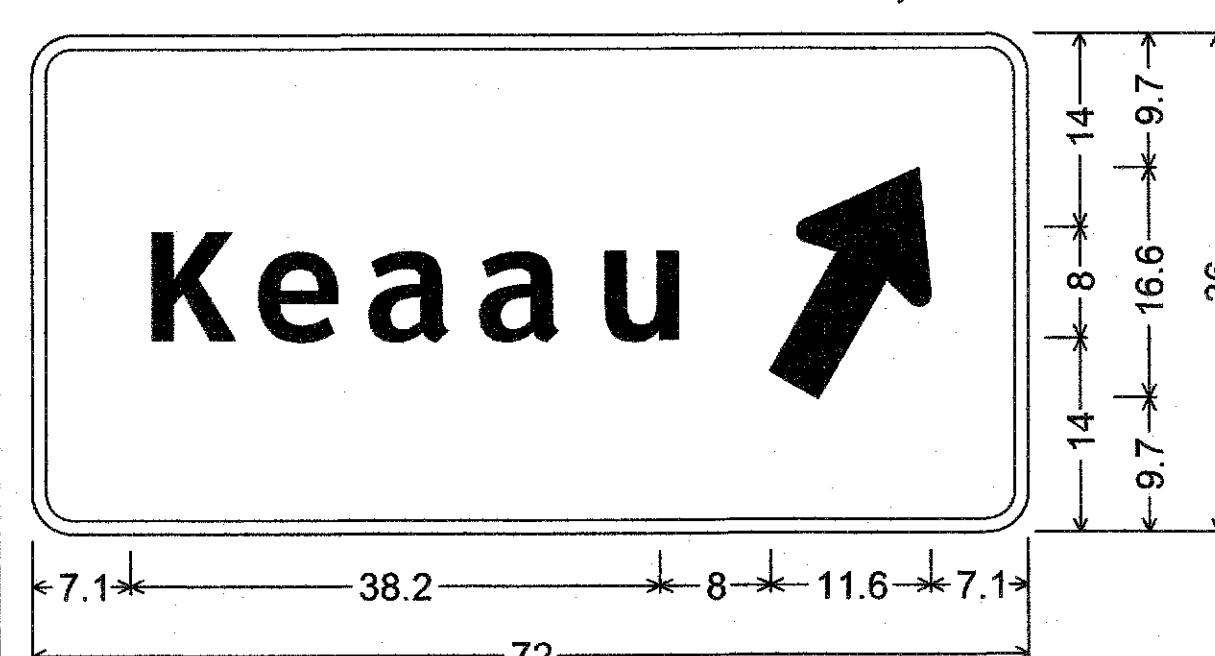


3.0" Radius, 1.0" Border, White on Green;
[Keaau] ClearviewHwy-5-W;
Standard Arrow Custom 18.0" X 10.8" 60°;

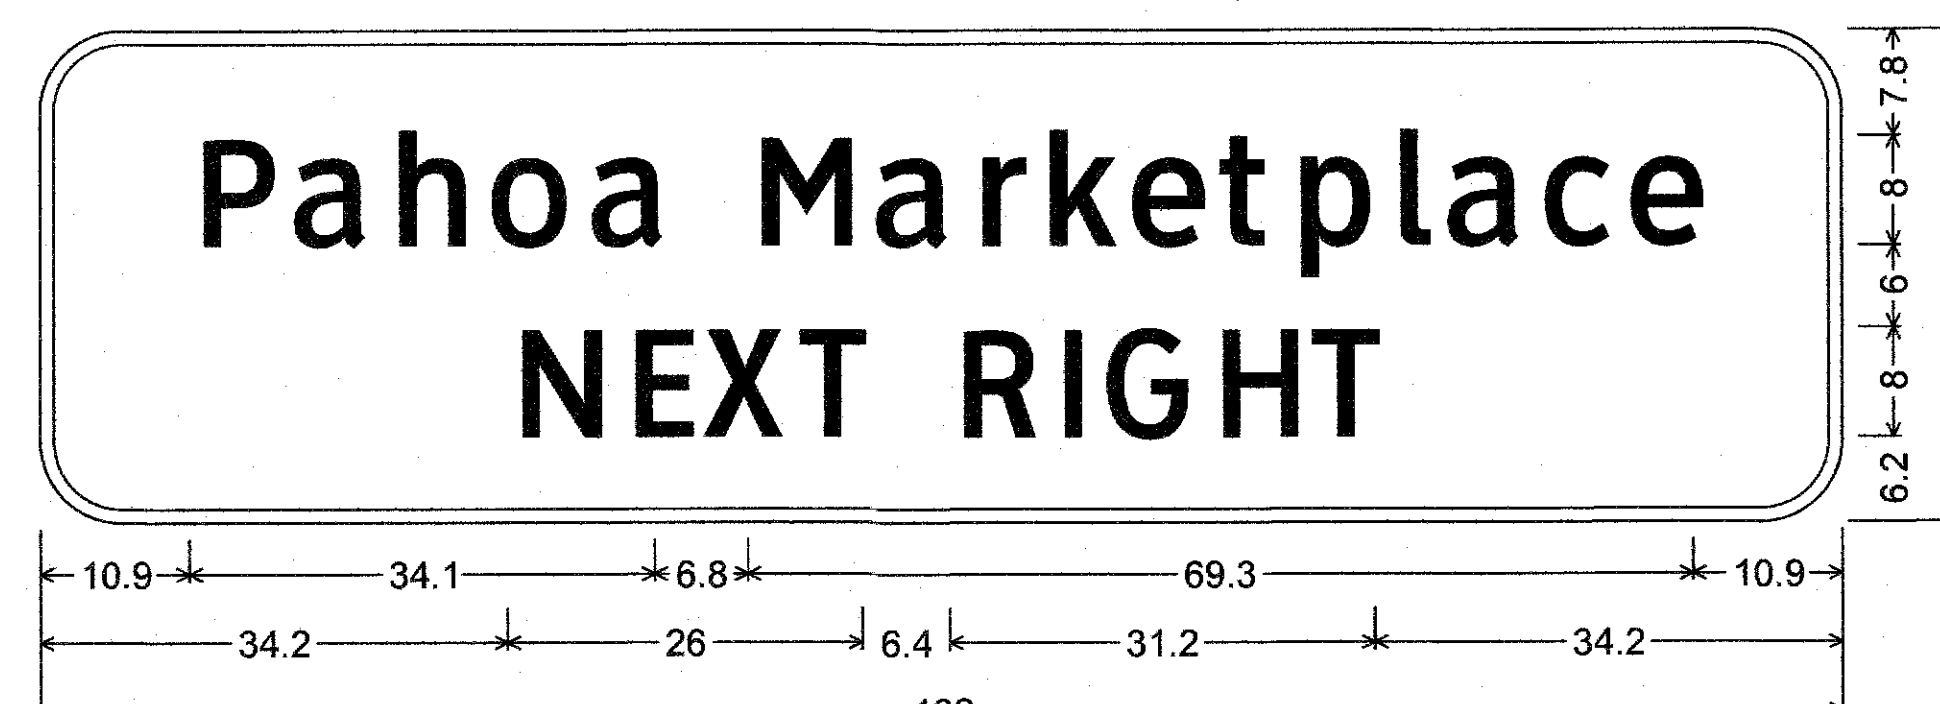

6.0" Radius, 1.0" Border, Black on Orange;
[Pahoa Marketplace] ClearviewHwy-3-W; [NEXT RIGHT] ClearviewHwy-3-W;

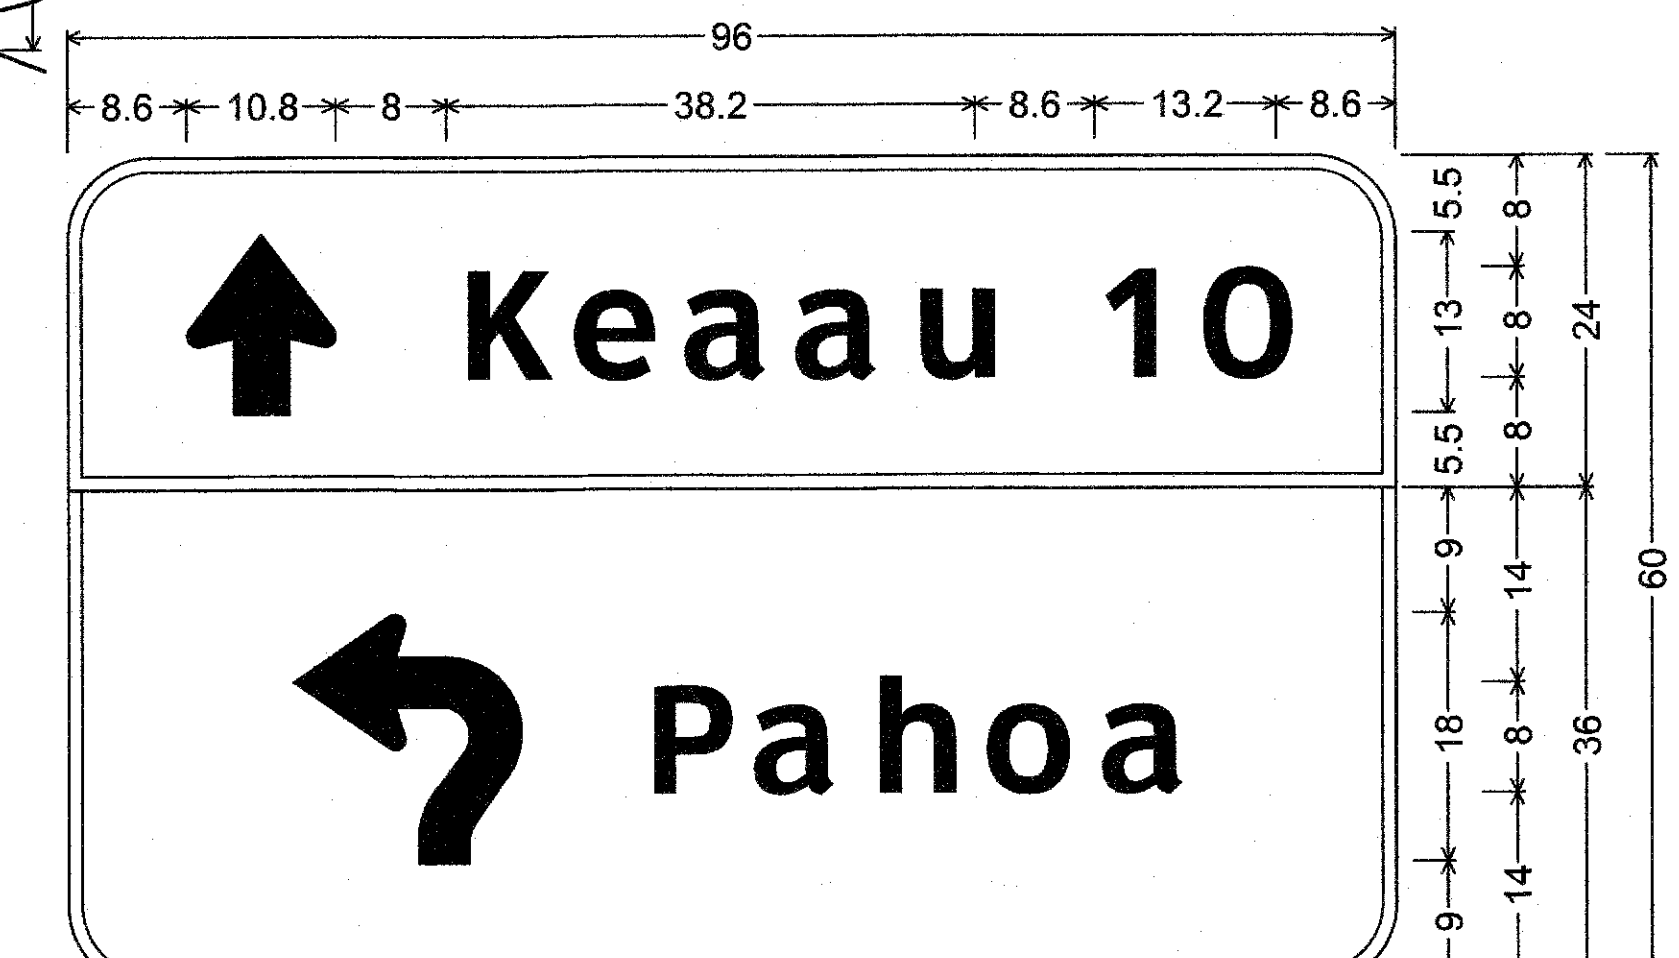

6.0" Radius, 1.0" Border, White on Green;
Standard Arrow Custom 13.0" X 10.8" 90°; [Keaau 10] ClearviewHwy-5-W;
6.0" Radius, 1.0" Border, White on Green;
Roundabout Arrow - 8"; [Pahoa] ClearviewHwy-5-W;

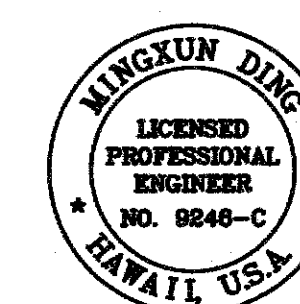

LICENSE EXPIRES 4/30/18
THIS WORK WAS PREPARED BY
ME OR UNDER MY SUPERVISION

STATE OF HAWAII DEPARTMENT OF TRANSPORTATION HIGHWAYS DIVISION	
SIGN DETAILS	
Keaau-Pahoa Road Intersection Improvements at Old Government Road Federal-Aid Project No. HSIP-0130(031)	
Scale: N/A	Date: August 2013
SHEET No. 1 OF 1 SHEETS	

"AS-BUILT"