


FED. ROAD DIST. NO.	STATE	FED. AID PROJ. NO.	FISCAL YEAR	SHEET NO.	TOTAL SHEETS
HAWAII	HAW.	HSIP-0130(031)	2014	C.O. ADD. 22	108

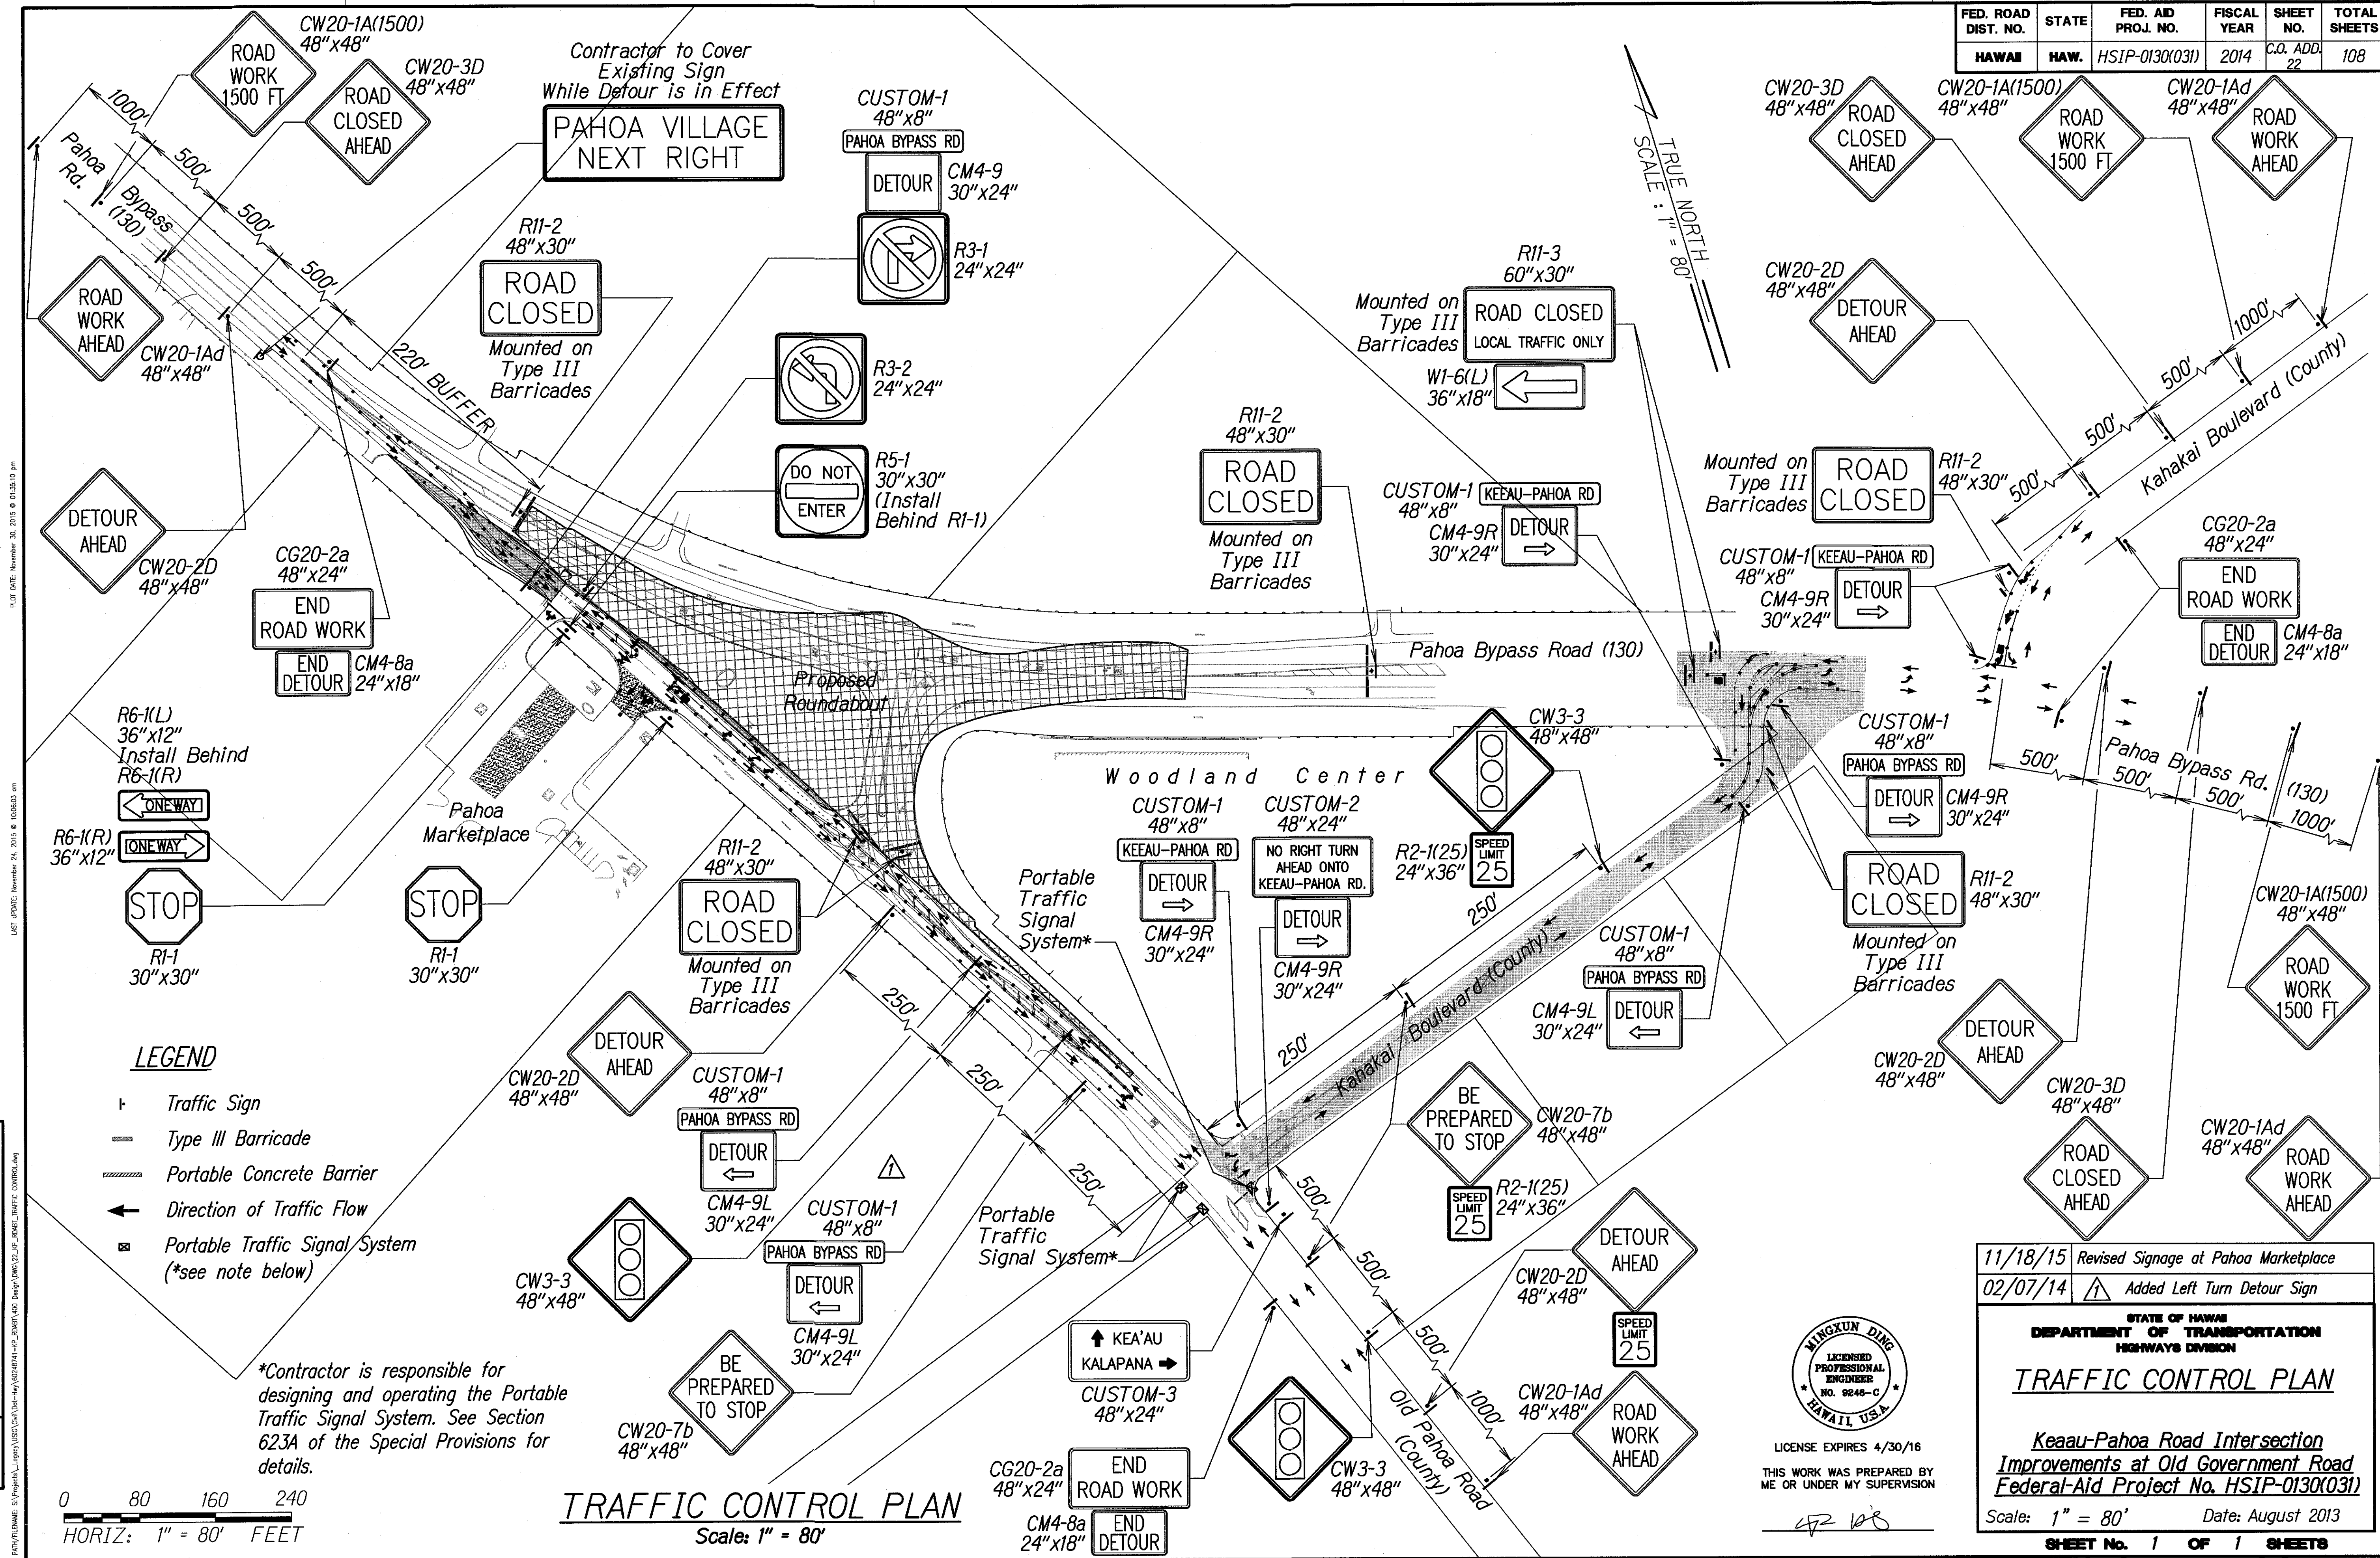

SURVEY PLOTTED BY	DATE
DRAWN BY	
DESIGNED BY	
QUANTITIES BY	
CHECKED BY	
NO.	

11/18/15 Revised Signage at Pahoa Marketplace
02/07/14 Added Left Turn Detour Sign

STATE OF HAWAII
DEPARTMENT OF TRANSPORTATION
HIGHWAYS DIVISION

TRAFFIC CONTROL PLAN

Keau-Pahoa Road Intersection
Improvements at Old Government Road
Federal-Aid Project No. HSIP-0130(031)


Scale: 1" = 80' Date: August 2013

SHEET No. 1 OF 1 SHEETS


C.O.ADD. 22

FED. ROAD DIST. NO.	STATE	FED. AID PROJ. NO.	FISCAL YEAR	SHEET NO.	TOTAL SHEETS
HAWAII	HAW.	HSIP-0130(031)	2014	23	108


- NOTES:
1. All Letters and Figures Shall Conform to the Latest Edition of FHWA Publication "Standard Alphabets for Highway Signs" and as Amended.
 2. For Sign Panel Mounting Details Refer to "Laminated Aluminum Sign Panels (Ground Mounted)" TE-23 of the State Highways Standard Plans.
 3. All sign dimensions are in inches, unless otherwise noted.

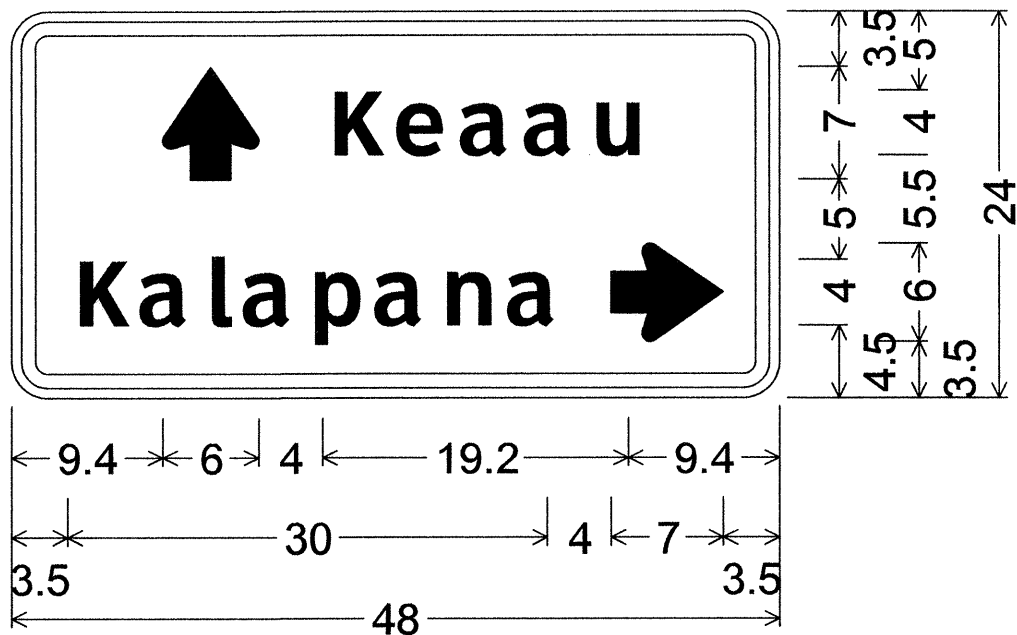


2.3" Radius, 0.9" Border, 0.6" Indent, Black on Orange;
Standard Arrow Custom 7.0" X 6.0" 90°;
[Keaau] ClearviewHwy-5-W;
[Kalapana] ClearviewHwy-5-W;
Standard Arrow Custom 7.0" X 6.0" 0°;

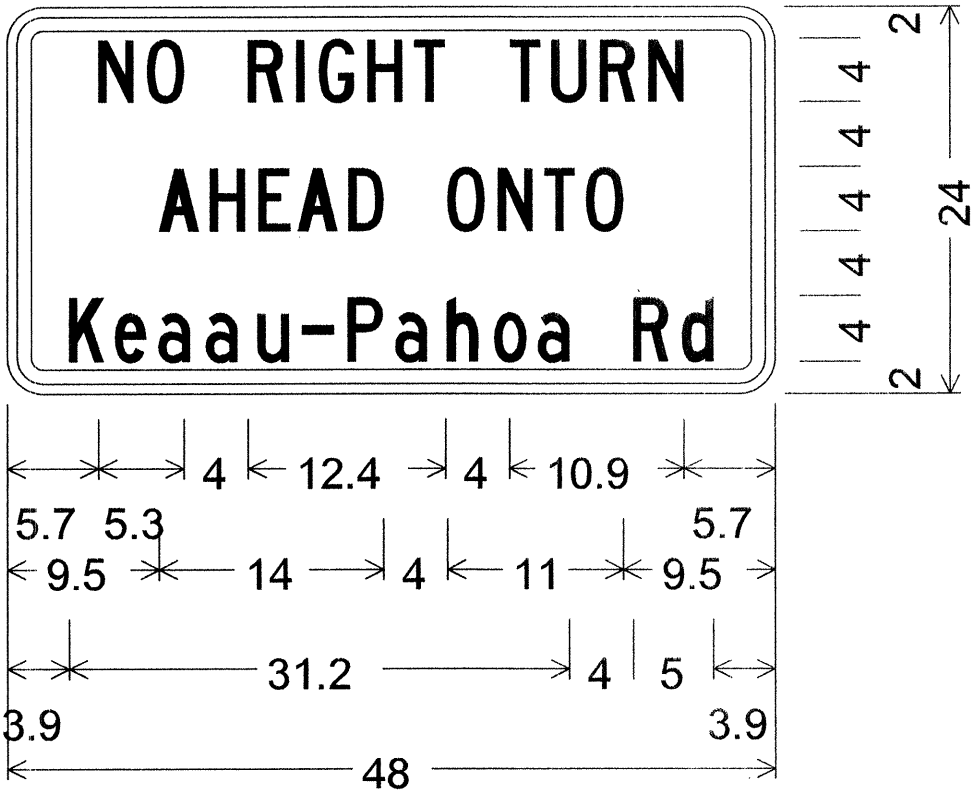

2.3" Radius, 0.9" Border, 0.6" Indent, Black on Orange;
[NO RIGHT TURN] C;
[AHEAD ONTO] C;
[Keaau-Pahoa Rd] C;

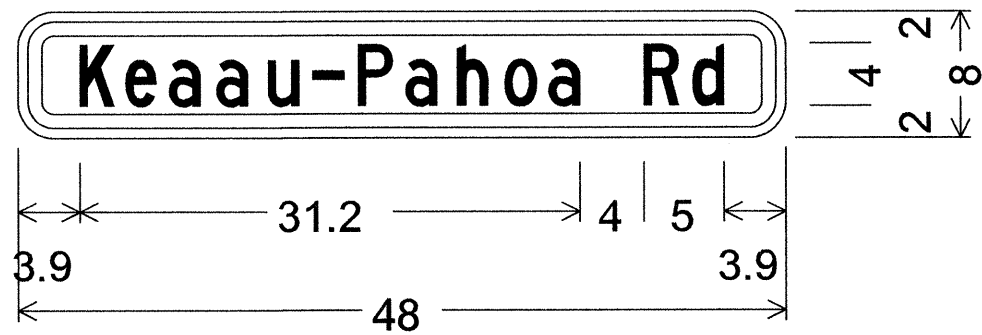

2.3" Radius, 0.9" Border, 0.6" Indent, Black on Orange;
[Keaau-Pahoa Rd] C;

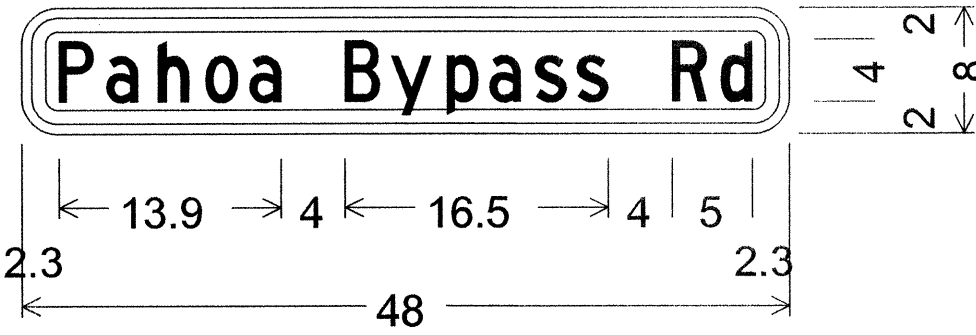


2.3" Radius, 0.9" Border, 0.6" Indent, Black on Orange;
[Pahoa Bypass Rd] C;

ORIGINAL PLAN	SURVEY PLOTTED BY	DATE
NOTE BOOK	DRAWN BY	
No.	DESIGNED BY	
	CHECKED BY	

PRINT/FILENAME: P:\60249741_H\CA0\006_Civil\Sheets\XX_KP_PDA\T_Hoffie_Control_Sign_Format_Sheet.dgn

PLOT DATE: 8/28/2013 @ 8:21:12 AM

LAST UPDATE: 8/28/2013 @ 8:29:12 AM

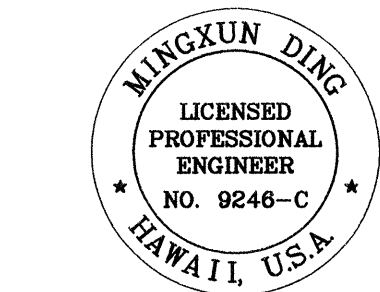

LICENSE EXPIRES 4/30/14
THIS WORK WAS PREPARED BY
ME OR UNDER MY SUPERVISION

Signature

STATE OF HAWAII
DEPARTMENT OF TRANSPORTATION
HIGHWAYS DIVISION

TRAFFIC CONTROL SIGN DETAILS

Keaau-Pahoa Road Intersection
Improvements at Old Government Road
Federal-Aid Project No. HSIP-0130(031)

Scale: N/A Date: August 2013

SHEET No. 1 OF 1 SHEETS