
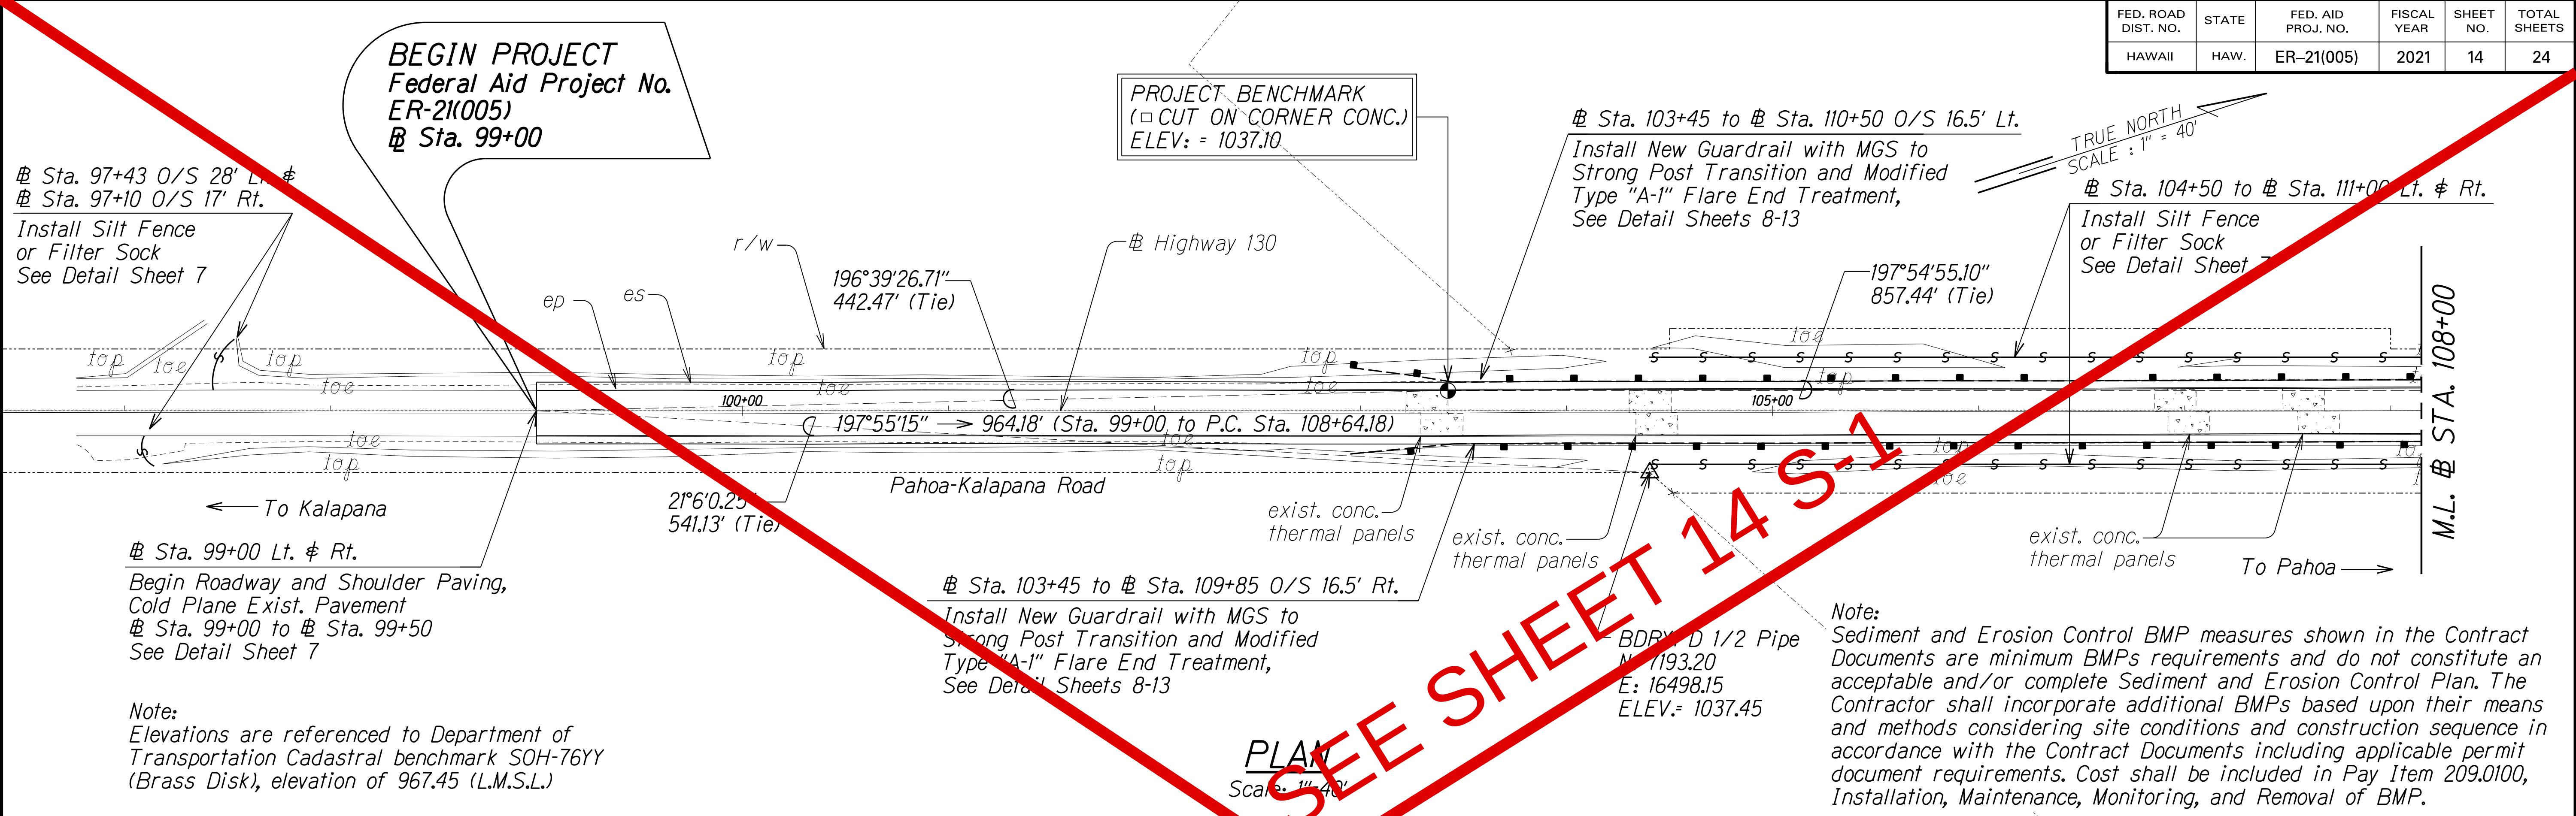
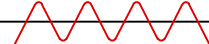


FED. ROAD DIST. NO.	STATE	FED. AID PROJ. NO.	FISCAL YEAR	SHEET NO.	TOTAL SHEETS
HAWAII	HAW.	ER-21(005)	2021	14	24

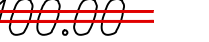


LEGEND FOR AS-BUILT POSTINGS

 Squiggly line for as-built deletion

 Double line for as-built deletion

 Roadway

Text for as-built posting

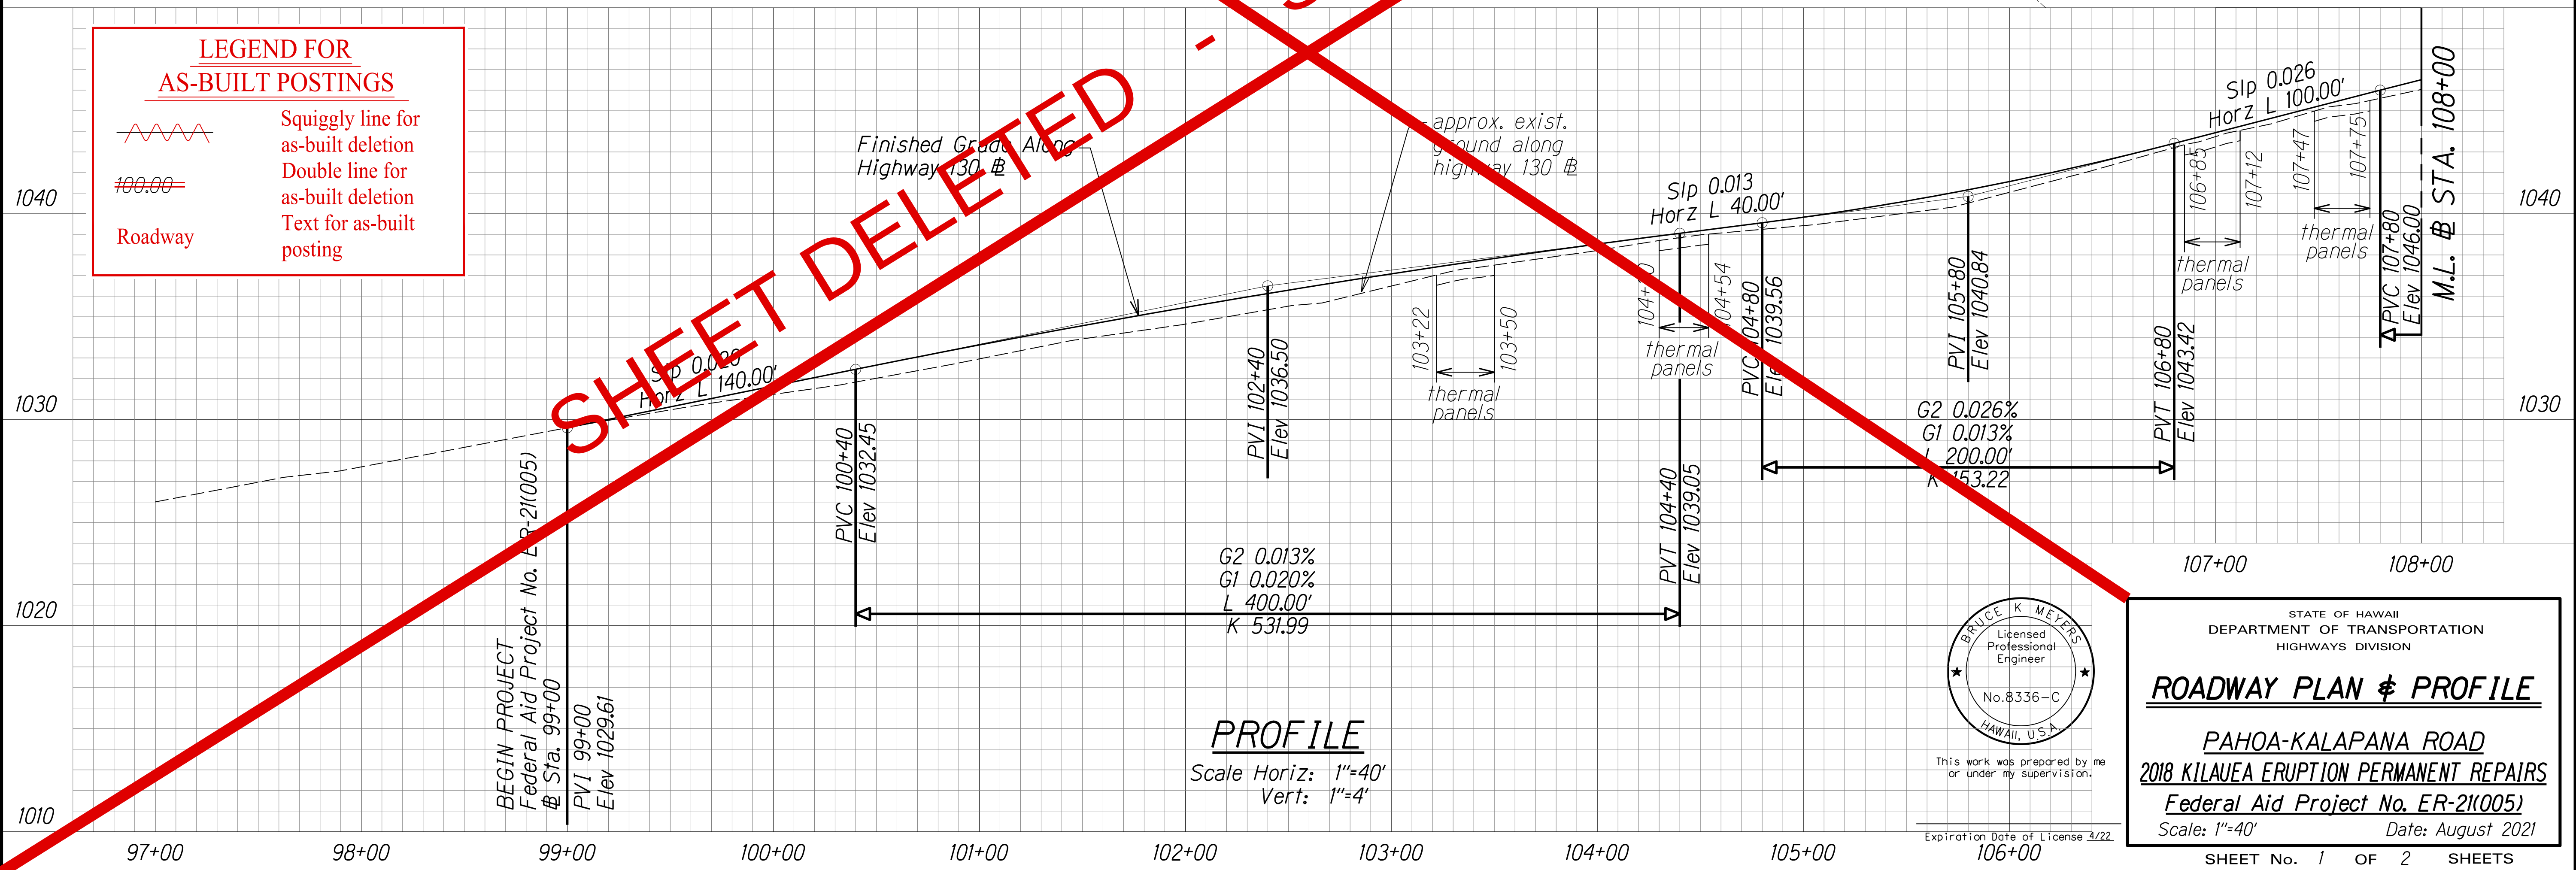


ORIGINAL PLAN	SURVEY PLOTTED BY	DATE
NOTE BOOK	DESIGNED BY	
	QUANTITIES BY	
	CHECKED BY	

AS-BUILT

FED. ROAD DIST. NO.	STATE	FED. AID PROJ. NO.	FISCAL YEAR	SHEET NO.	TOTAL SHEETS
HAWAII	HAW.	ER-21(005)	2021	15	24

Sta. 103+45 to Sta. 110+50 O/S 16.5' Lt.
Install New Guardrail with MGS to Strong Post Transition and Modified Type "A-1" Flare End Treatment, See Detail Sheets 8-13

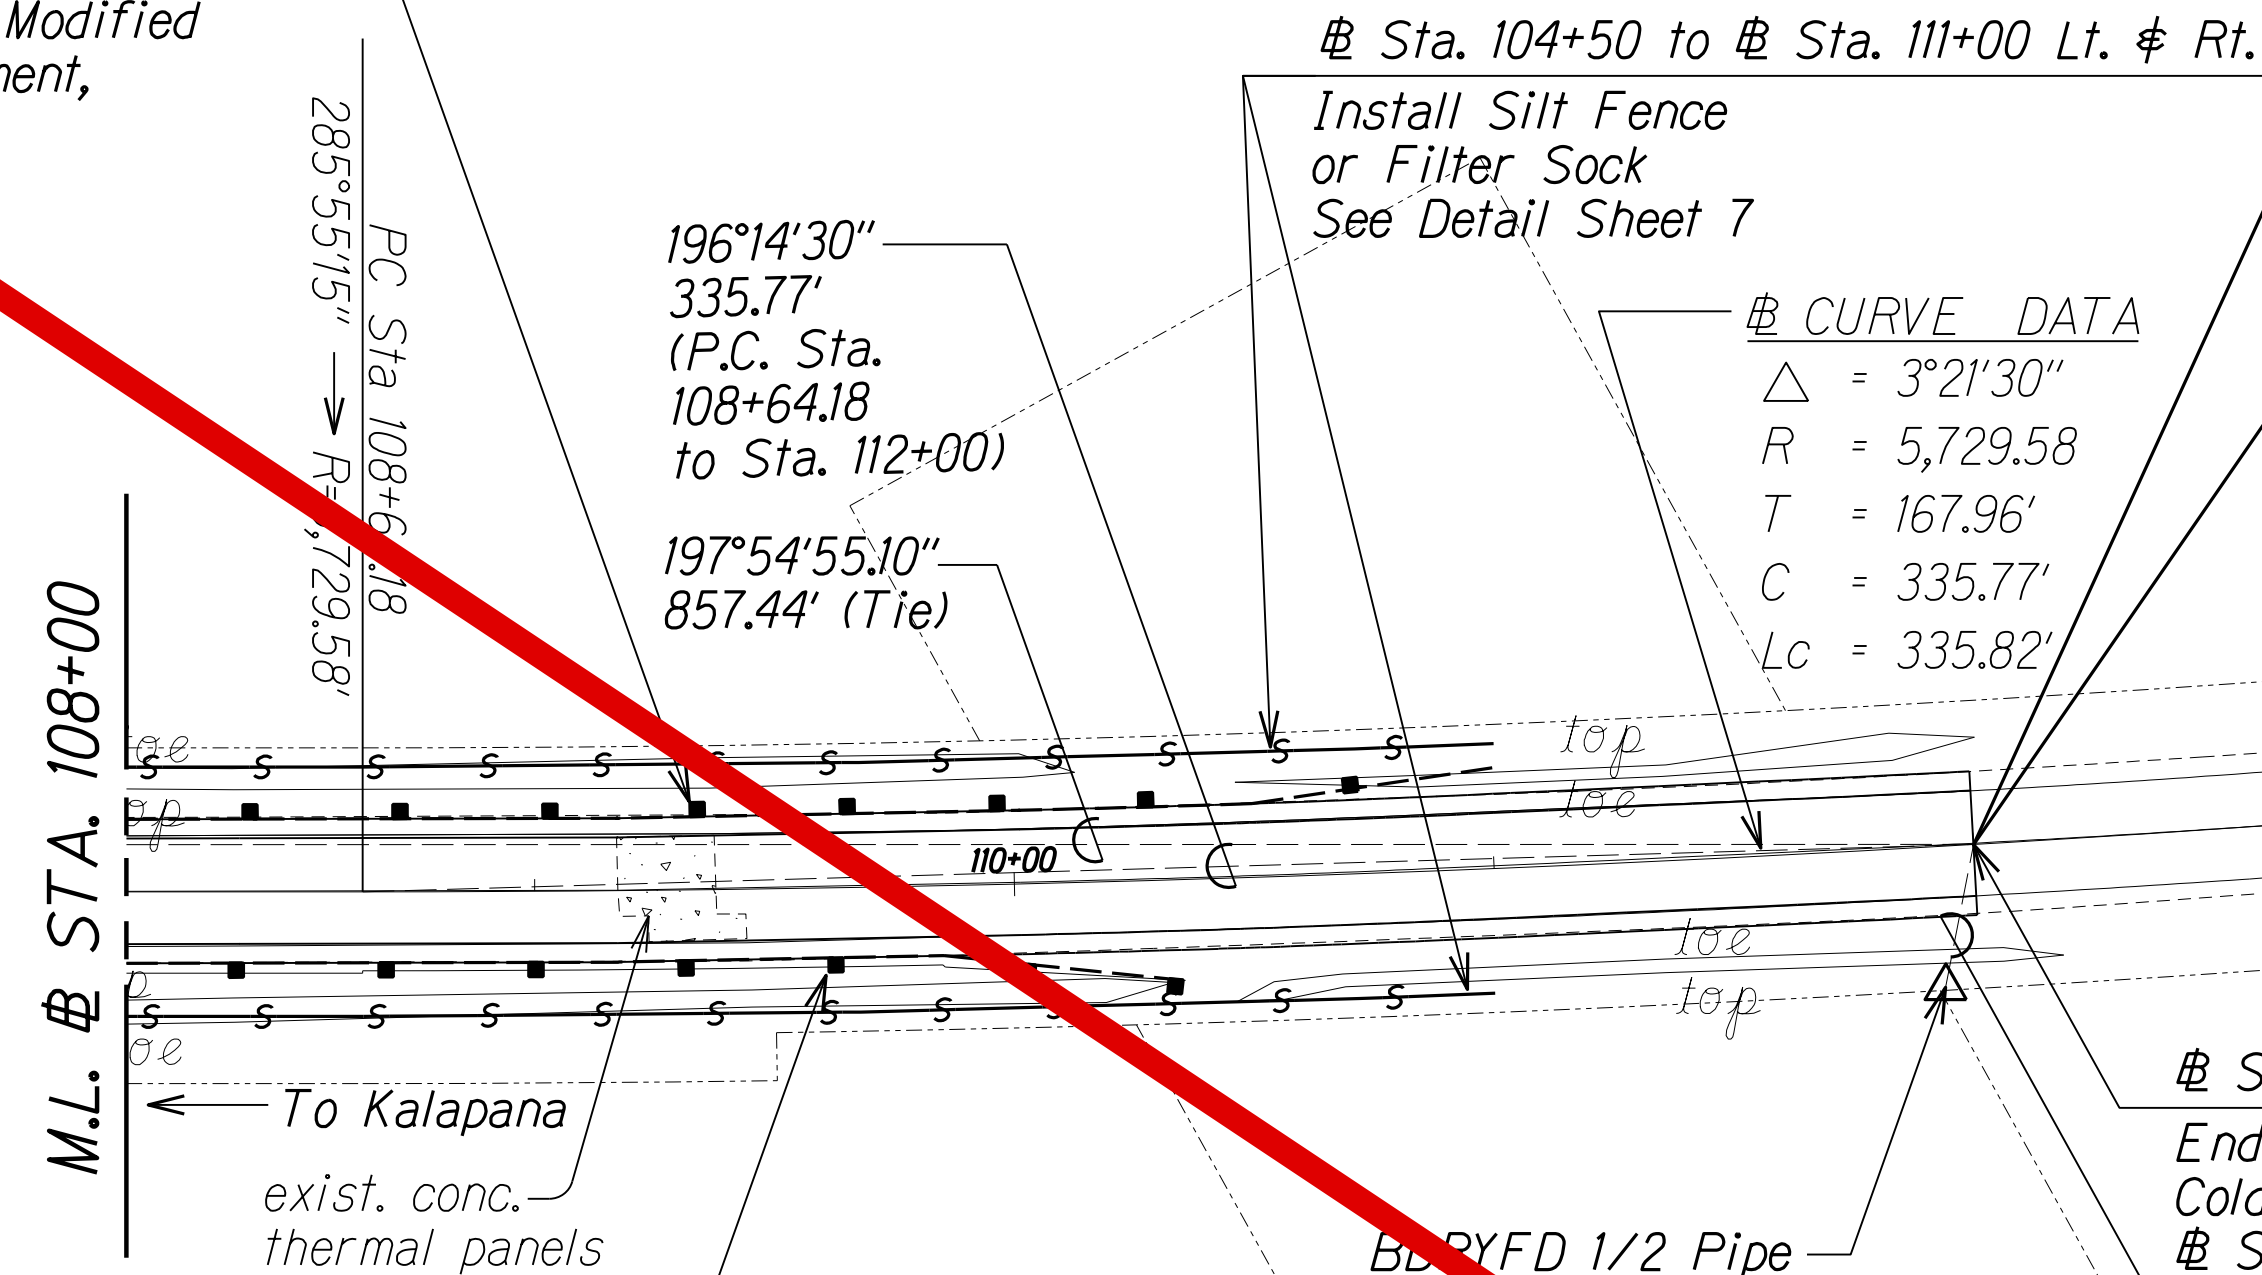

END PROJECT
Federal Aid Project No.
ER-21(005)
Sta. 112+00

TRUE NORTH
SCALE : 1" = 40'

Sta. 103+45 to Sta. 109+85 O/S 16.5' Rt.
Install New Guardrail with MGS to Strong Post Transition and Modified Type "A-1" Flare End Treatment, See Detail Sheets 8-13

Sta. 112+00 Lt. & Rt.
End Roadway and Shoulder Paving, Cold Plane Exist. Pavement
Sta. 111+50 to Sta. 112+00
See Detail Sheet 7

Note:
Sediment and Erosion Control BMP measures shown in the Contract Documents are minimum BMPs requirements and do not constitute an acceptable and/or complete Sediment and Erosion Control Plan. The Contractor shall incorporate additional BMPs based upon their means and methods considering site conditions and construction sequence in accordance with the Contract Documents including applicable permit document requirements. Cost shall be included in Pay Item 209.0100, Installation, Maintenance, Monitoring, and Removal of BMP.


LEGEND FOR
AS-BUILT POSTINGS

Squiggly line for as-built deletion


Double line for as-built deletion

Text for as-built posting

Roadway

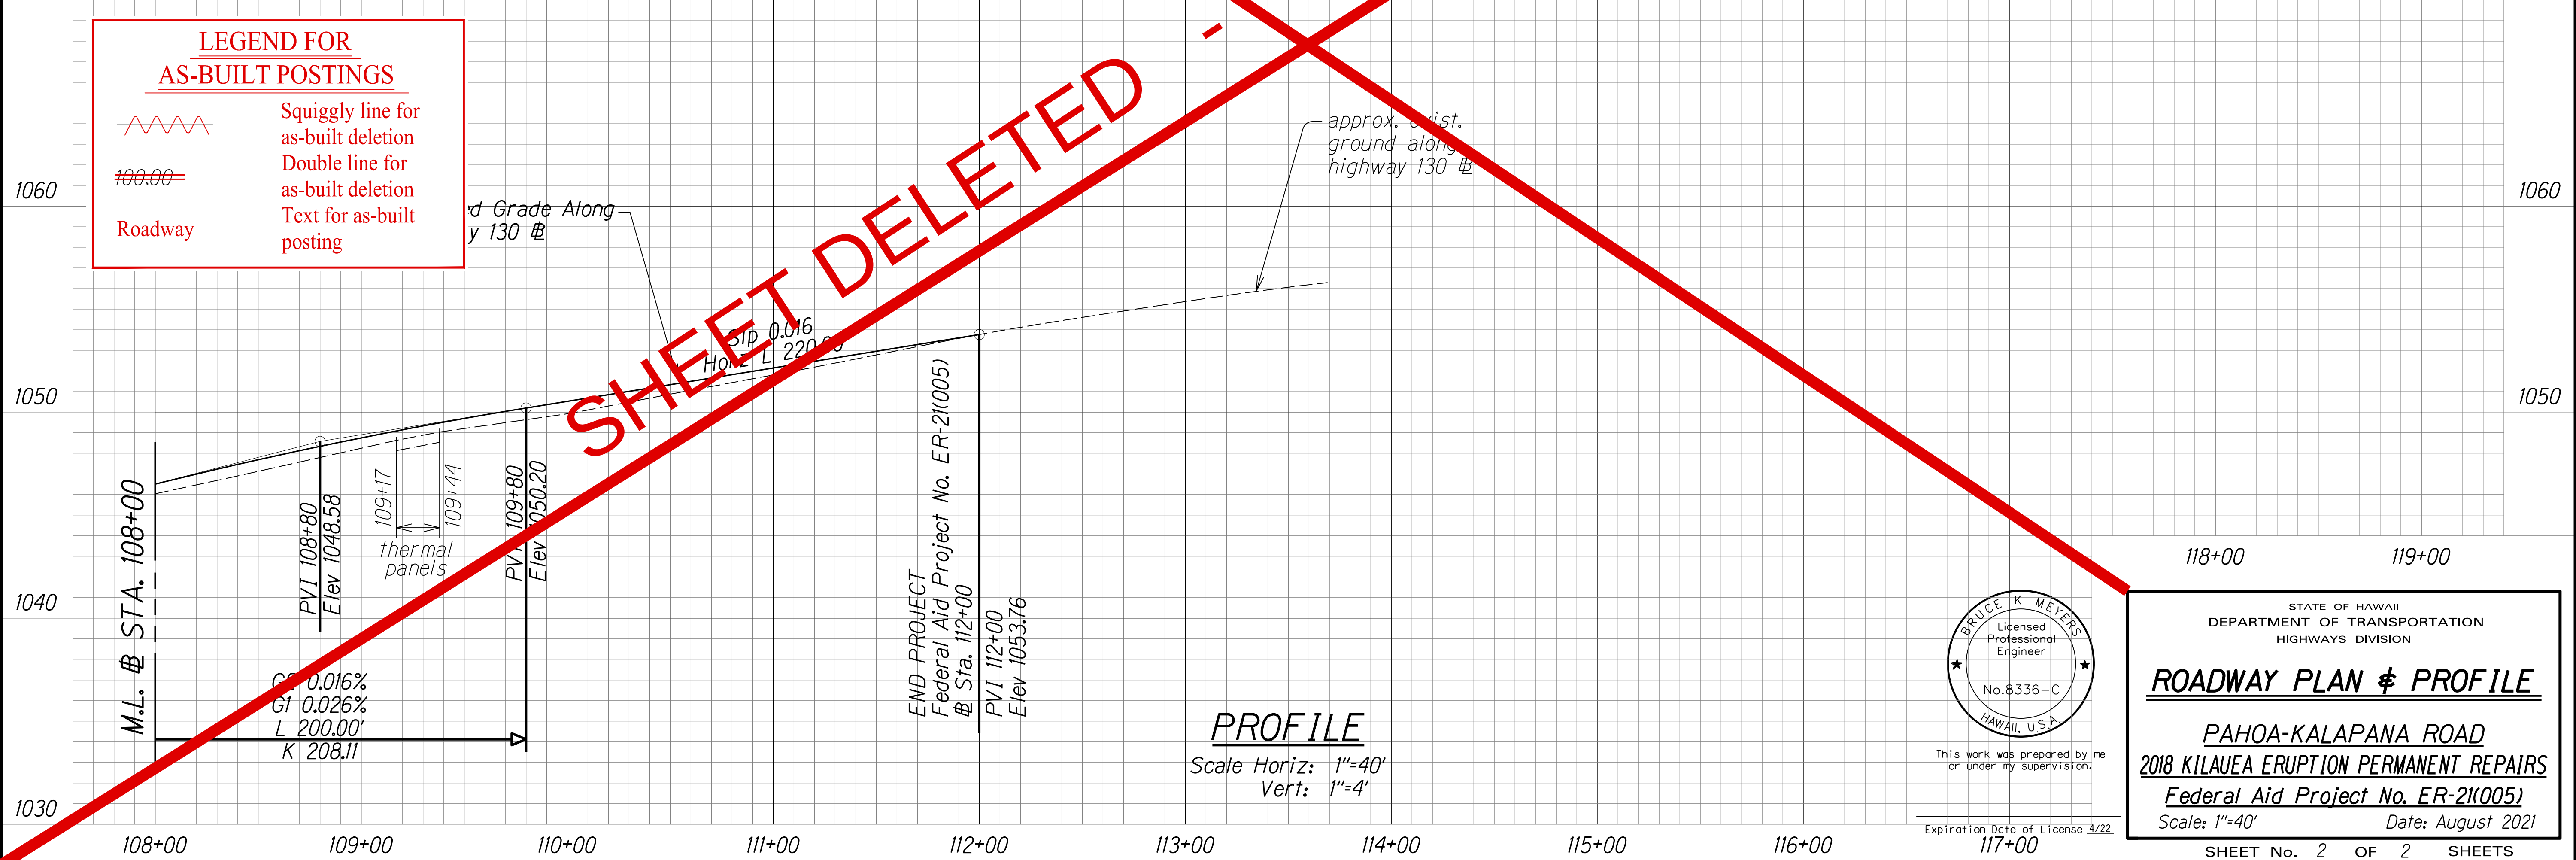

SURVEY PLOTTED BY	DATE
DESIGNED BY	
TRACED BY	
NOTED BY	
QUANTITIES BY	
CHECKED BY	

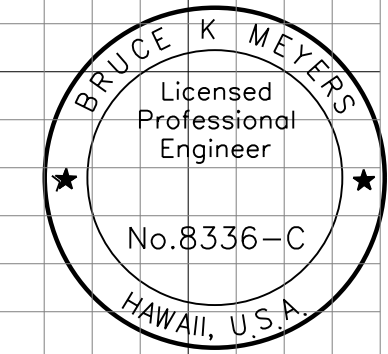

This work was prepared by me or under my supervision.

Expiration Date of License 3/22

STATE OF HAWAII
DEPARTMENT OF TRANSPORTATION
HIGHWAYS DIVISION

ROADWAY PLAN & PROFILE

PAHOA-KALAPANA ROAD

2018 KILAUEA ERUPTION PERMANENT REPAIRS

Federal Aid Project No. ER-21(005)

Scale: 1"=40' Date: August 2021

