


FED. ROAD DIST. NO.	STATE	PROJ. NO.	FISCAL YEAR	SHEET NO.	TOTAL SHEETS
HAWAII	HAW.	139A-01-05M	2005	ADD.61	106

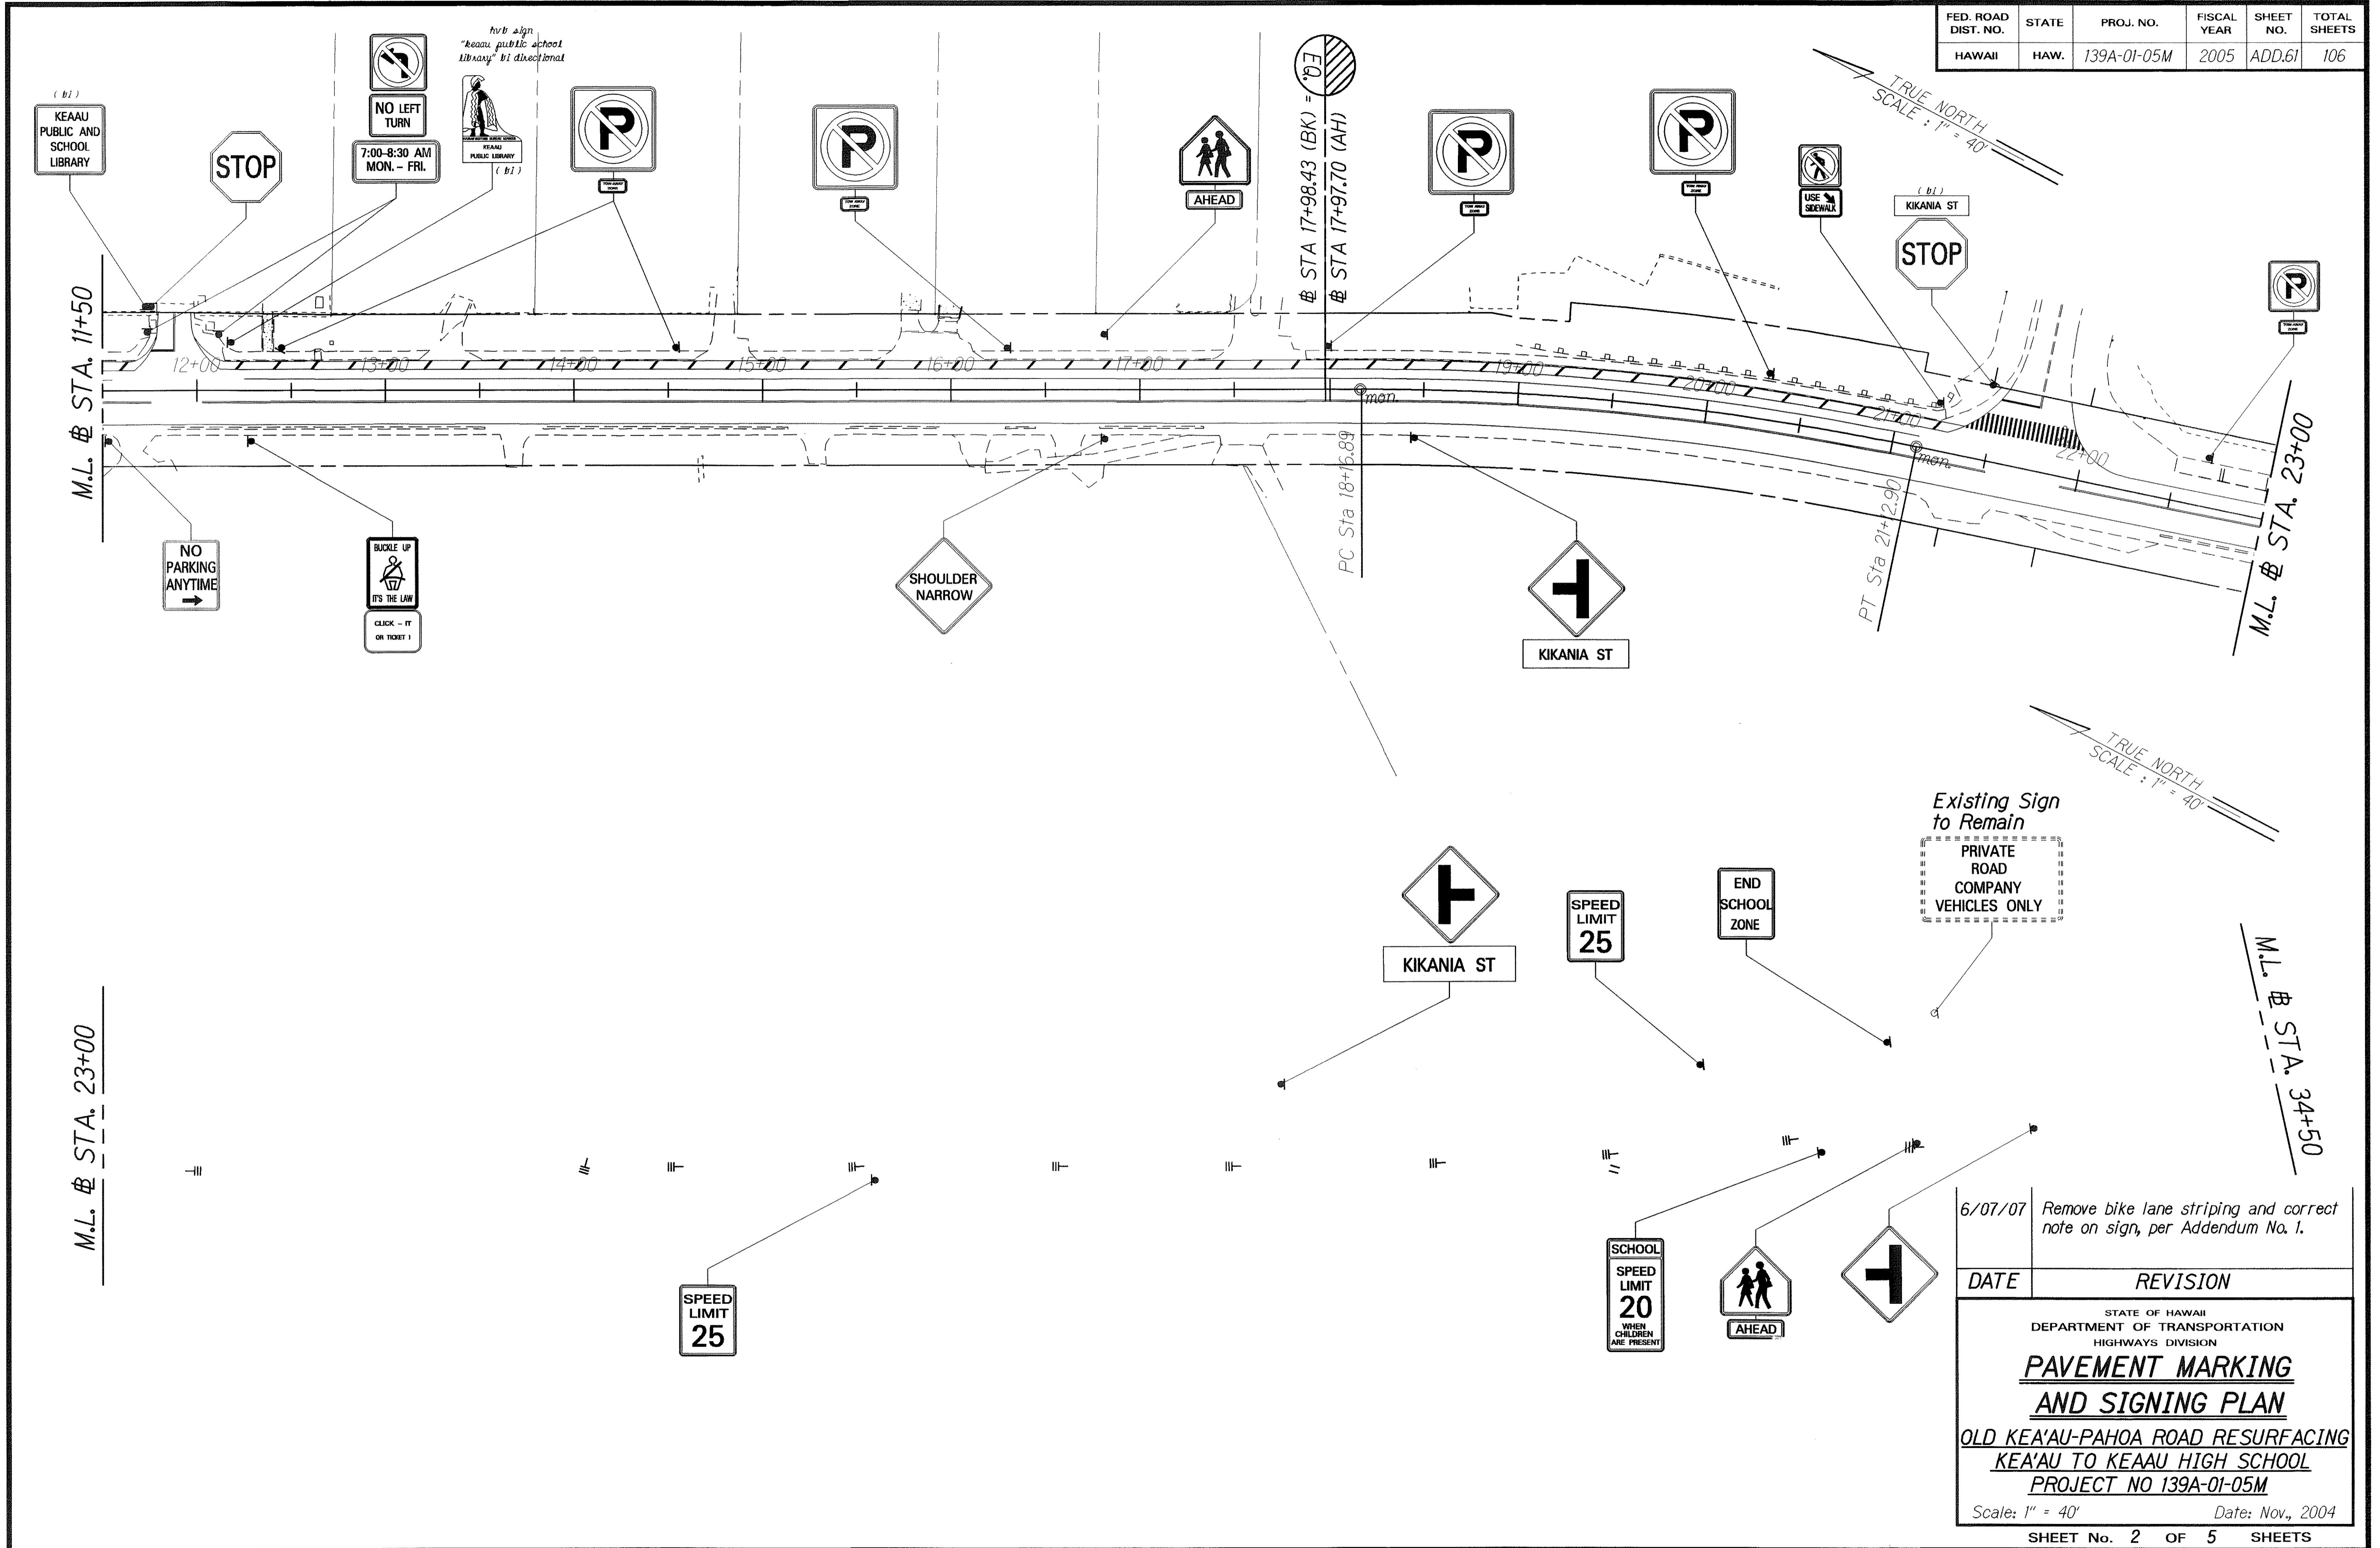


SURVEY PLOTTED BY	DATE
DRAWN BY	
TRACED BY	
NOTE BOOK	
EXTRA DESIGN	
QUANTITIES BY	
CHECKED BY	

6/07/07 Remove bike lane striping and correct note on sign, per Addendum No. 1.

DATE	REVISION
6/07/07	Remove bike lane striping and correct note on sign, per Addendum No. 1.

STATE OF HAWAII
 DEPARTMENT OF TRANSPORTATION
 HIGHWAYS DIVISION
**PAVEMENT MARKING
 AND SIGNING PLAN**
 OLD KEA'AU-PAHOA ROAD RESURFACING
 KEA'AU TO KEAAU HIGH SCHOOL
 PROJECT NO 139A-01-05M
 Scale: 1" = 40' Date: Nov., 2004

FED. ROAD DIST. NO.	STATE	PROJ. NO.	FISCAL YEAR	SHEET NO.	TOTAL SHEETS
HAWAII	HAW.	139A-01-05M	2005	ADD.62	106

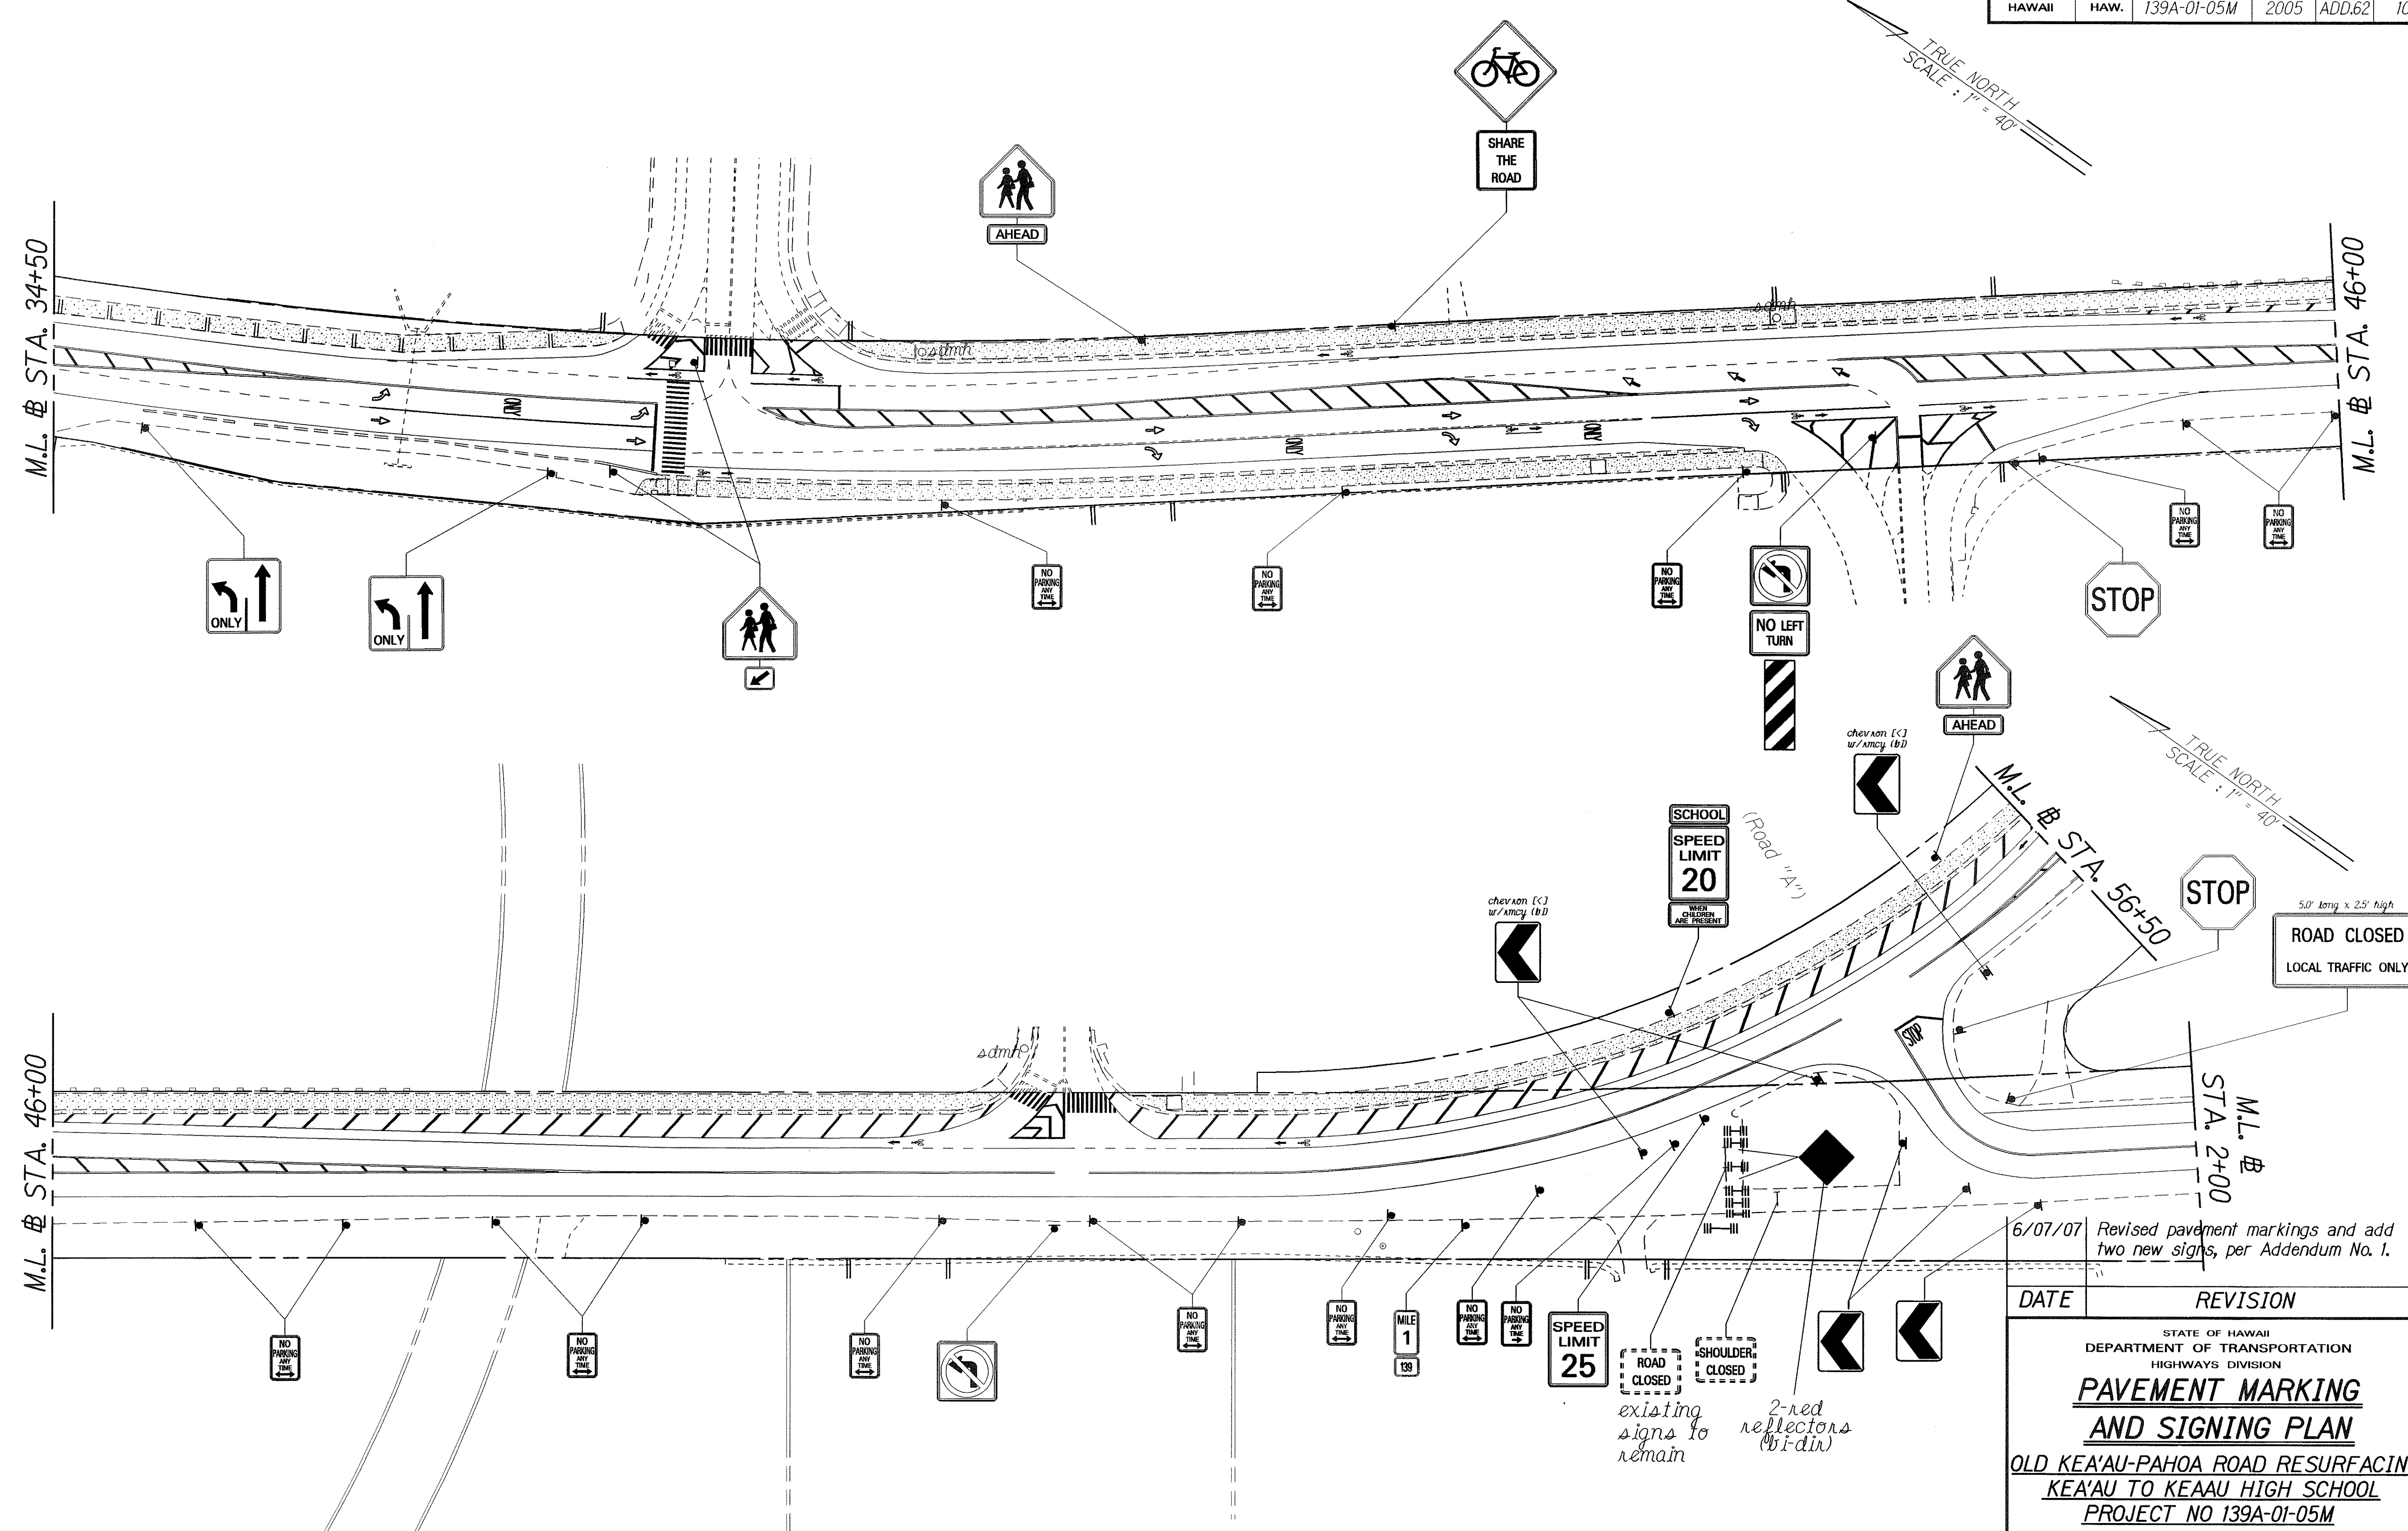



ORIGINAL PLAN	SURVEY PLOTTED BY	DATE
TRACED BY		
NOTE BOOK		
QUANTITIES BY		
CHECKED BY		

DATE	REVISION
6/07/07	Revised pavement markings and add two new signs, per Addendum No. 1.

STATE OF HAWAII
DEPARTMENT OF TRANSPORTATION
HIGHWAYS DIVISION
**PAVEMENT MARKING
AND SIGNING PLAN**
OLD KEA'AU-PAHOA ROAD RESURFACING
KEA'AU TO KEAAU HIGH SCHOOL
PROJECT NO 139A-01-05M
Scale: 1" = 40' Date: Nov., 2004

SHEET No. 3 OF 5 SHEETS

FED. ROAD DIST. NO.	STATE	PROJ. NO.	FISCAL YEAR	SHEET NO.	TOTAL SHEETS
HAWAII	HAW.	139A-01-05M	2007	63	106

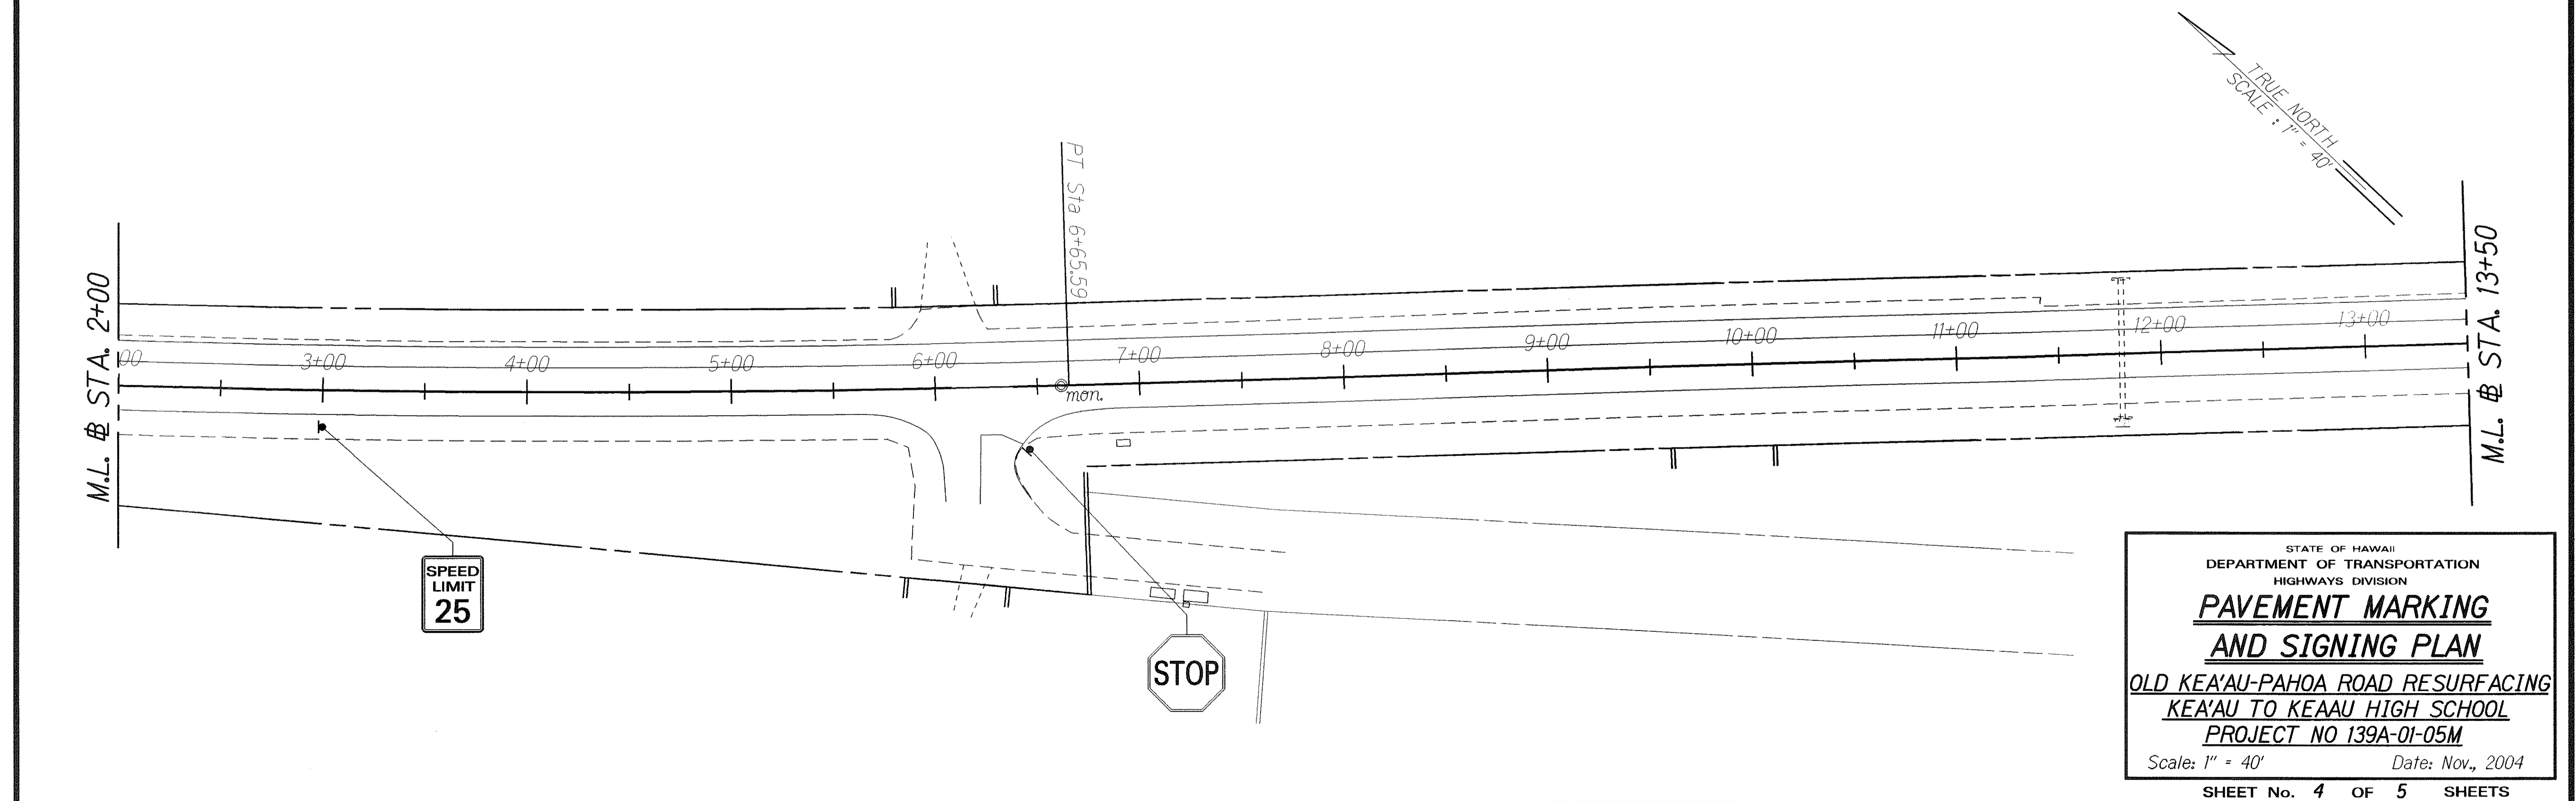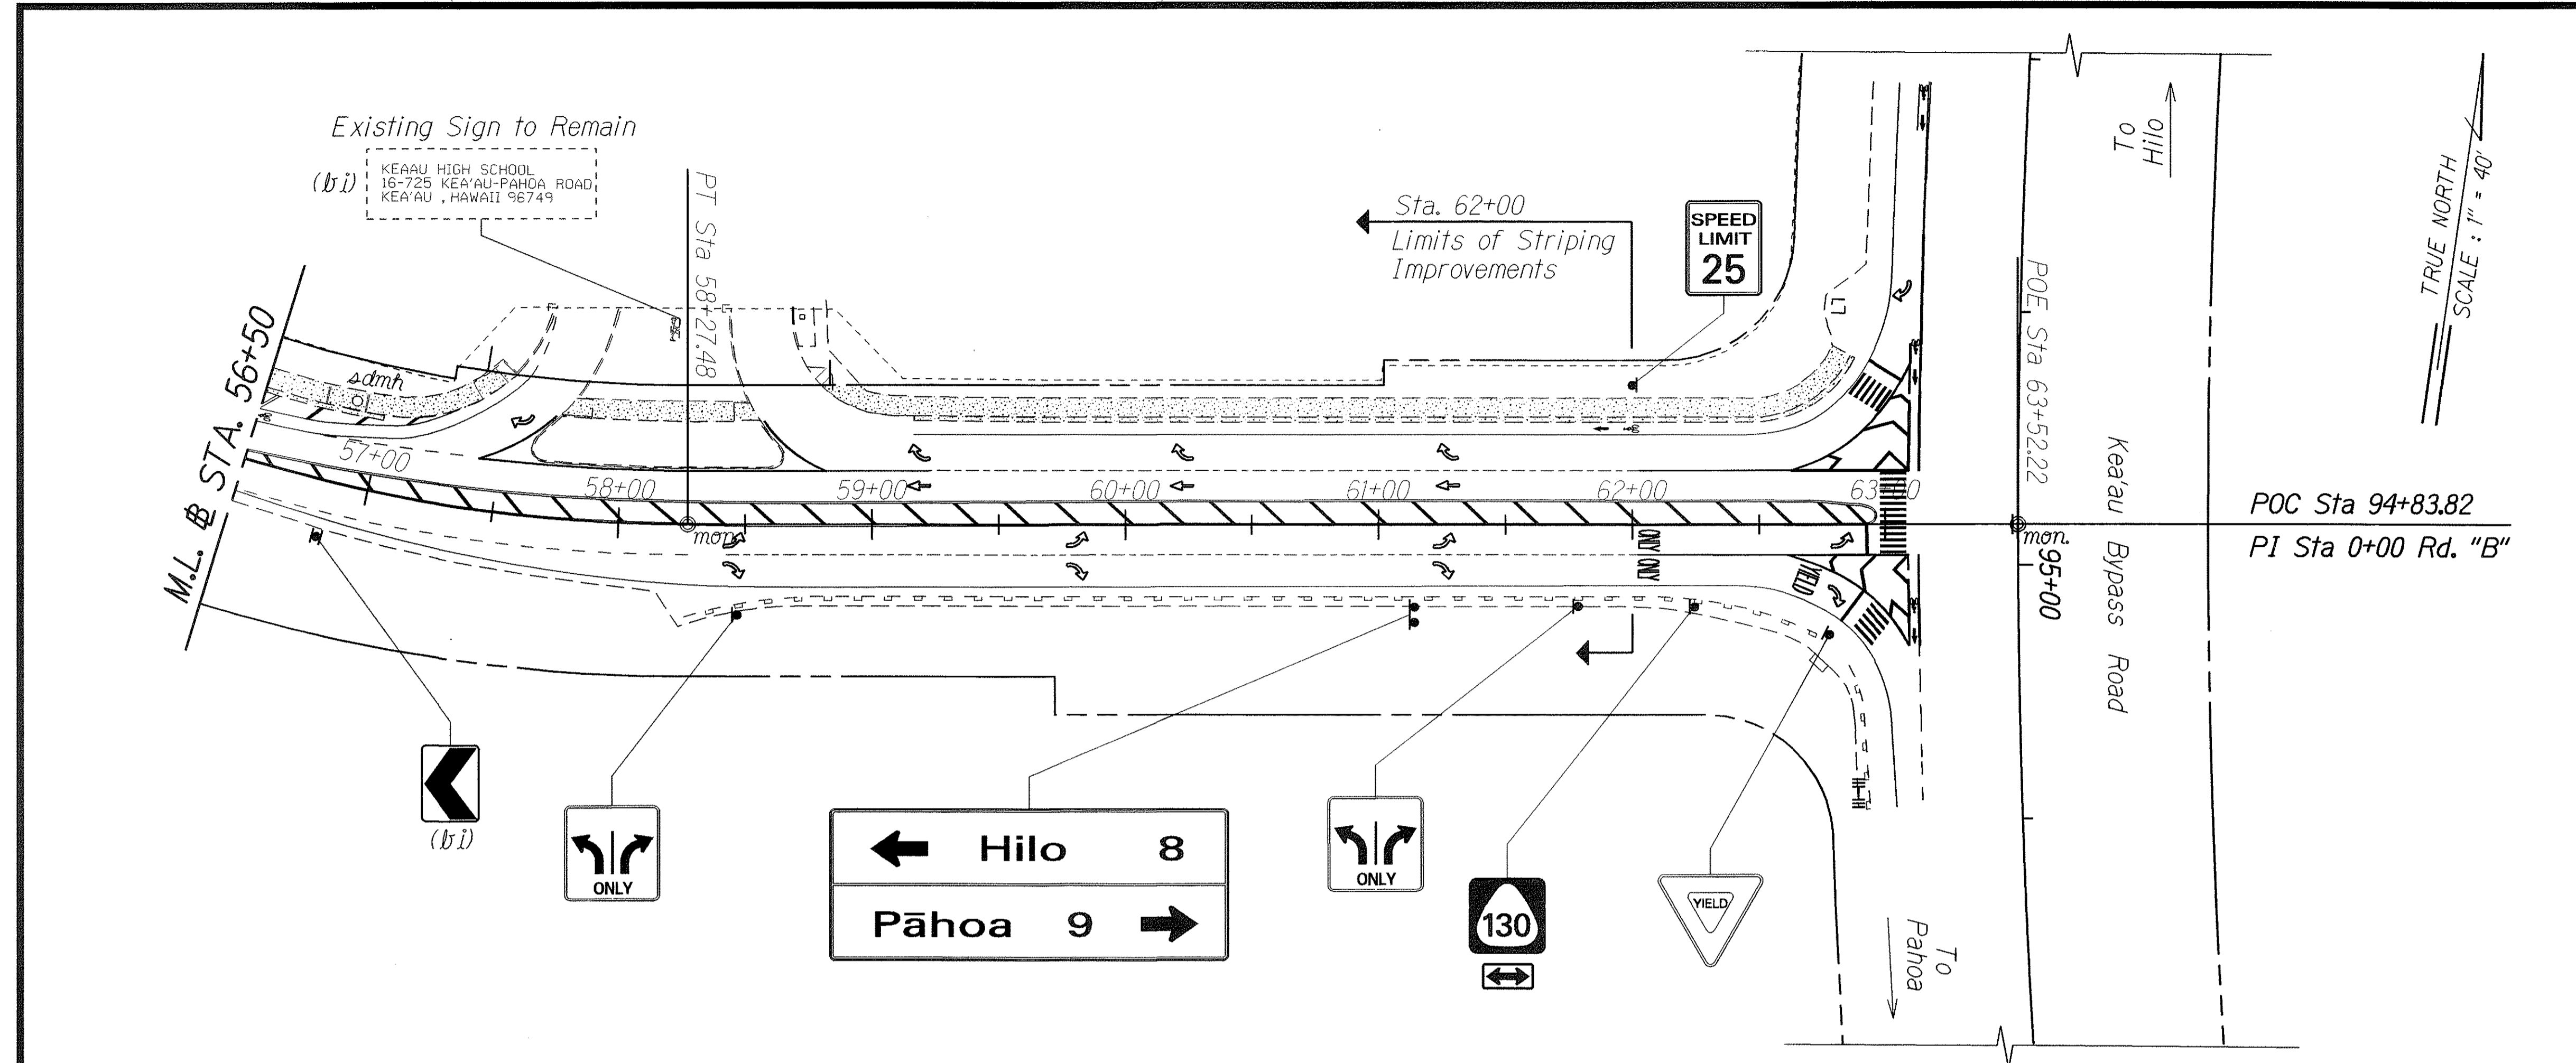

ORIGINAL PLAN	DATE
DESIGNED BY	
TRACED BY	
NOTE BOOK	
DESIGNED BY	
QUANTITIES BY	
CHECKED BY	

STATE OF HAWAII
DEPARTMENT OF TRANSPORTATION
HIGHWAYS DIVISION


**PAVEMENT MARKING
AND SIGNING PLAN**

**OLD KEA'AU-PAHOA ROAD RESURFACING
KEA'AU TO KEAAU HIGH SCHOOL
PROJECT NO 139A-01-05M**

Scale: 1" = 40' Date: Nov., 2004

SHEET No. 4 OF 5 SHEETS

FED. ROAD DIST. NO.	STATE	PROJ. NO.	FISCAL YEAR	SHEET NO.	TOTAL SHEETS
HAWAII	HAW.	139A-01-05M	2007	64	106

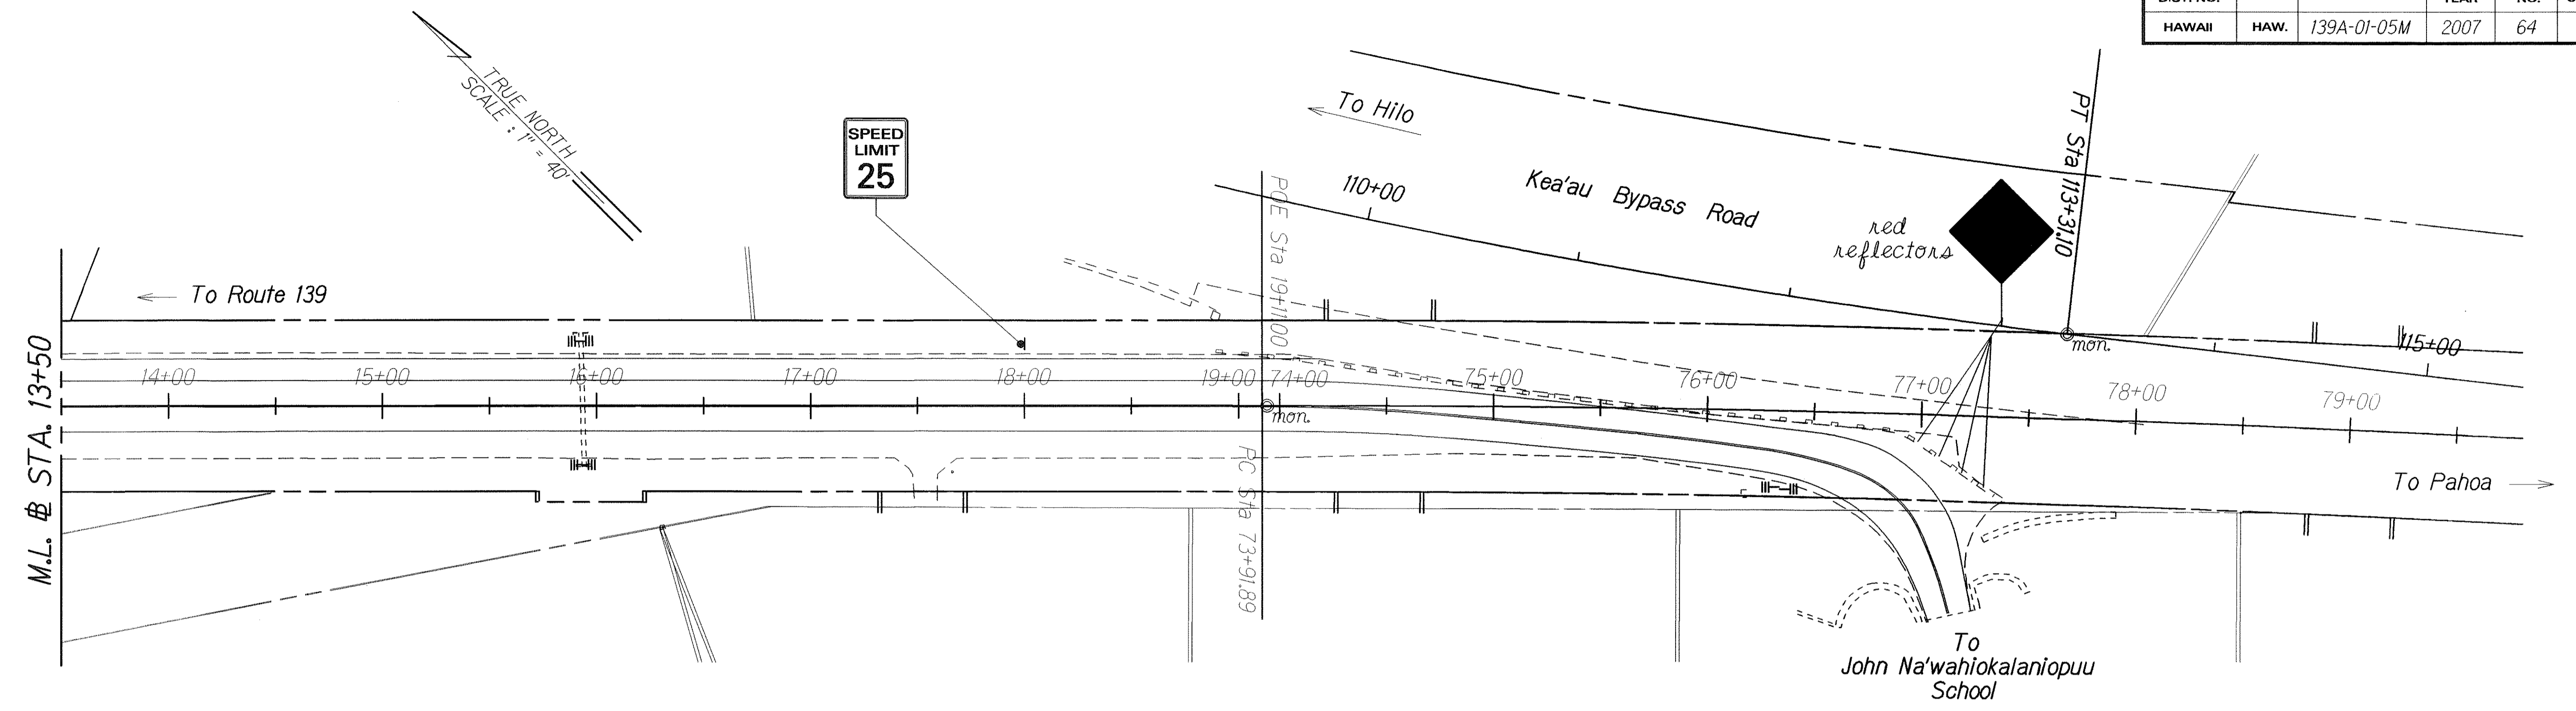

DESIGNED BY	DATE
DRAWN BY	
CHECKED BY	
IN CHARGE	
DATE	
NOTE BOOK	
QUANTITIES BY	
CHECKED BY	

STATE OF HAWAII
DEPARTMENT OF TRANSPORTATION
HIGHWAYS DIVISION

**PAVEMENT MARKING
AND SIGNING PLAN**

**OLD KEA'AU-PAHOA ROAD RESURFACING
KEA'AU TO KEAAU HIGH SCHOOL
PROJECT NO 139A-01-05M**

Scale: 1" = 40' Date: Nov., 2004

SHEET No. 5 OF 5 SHEETS