




FED. ROAD DIST. NO.	STATE	PROJ. NO.	FISCAL YEAR	SHEET NO.	TOTAL SHEETS
HAWAII	HAW.	139A-01-05M	2007	10	106

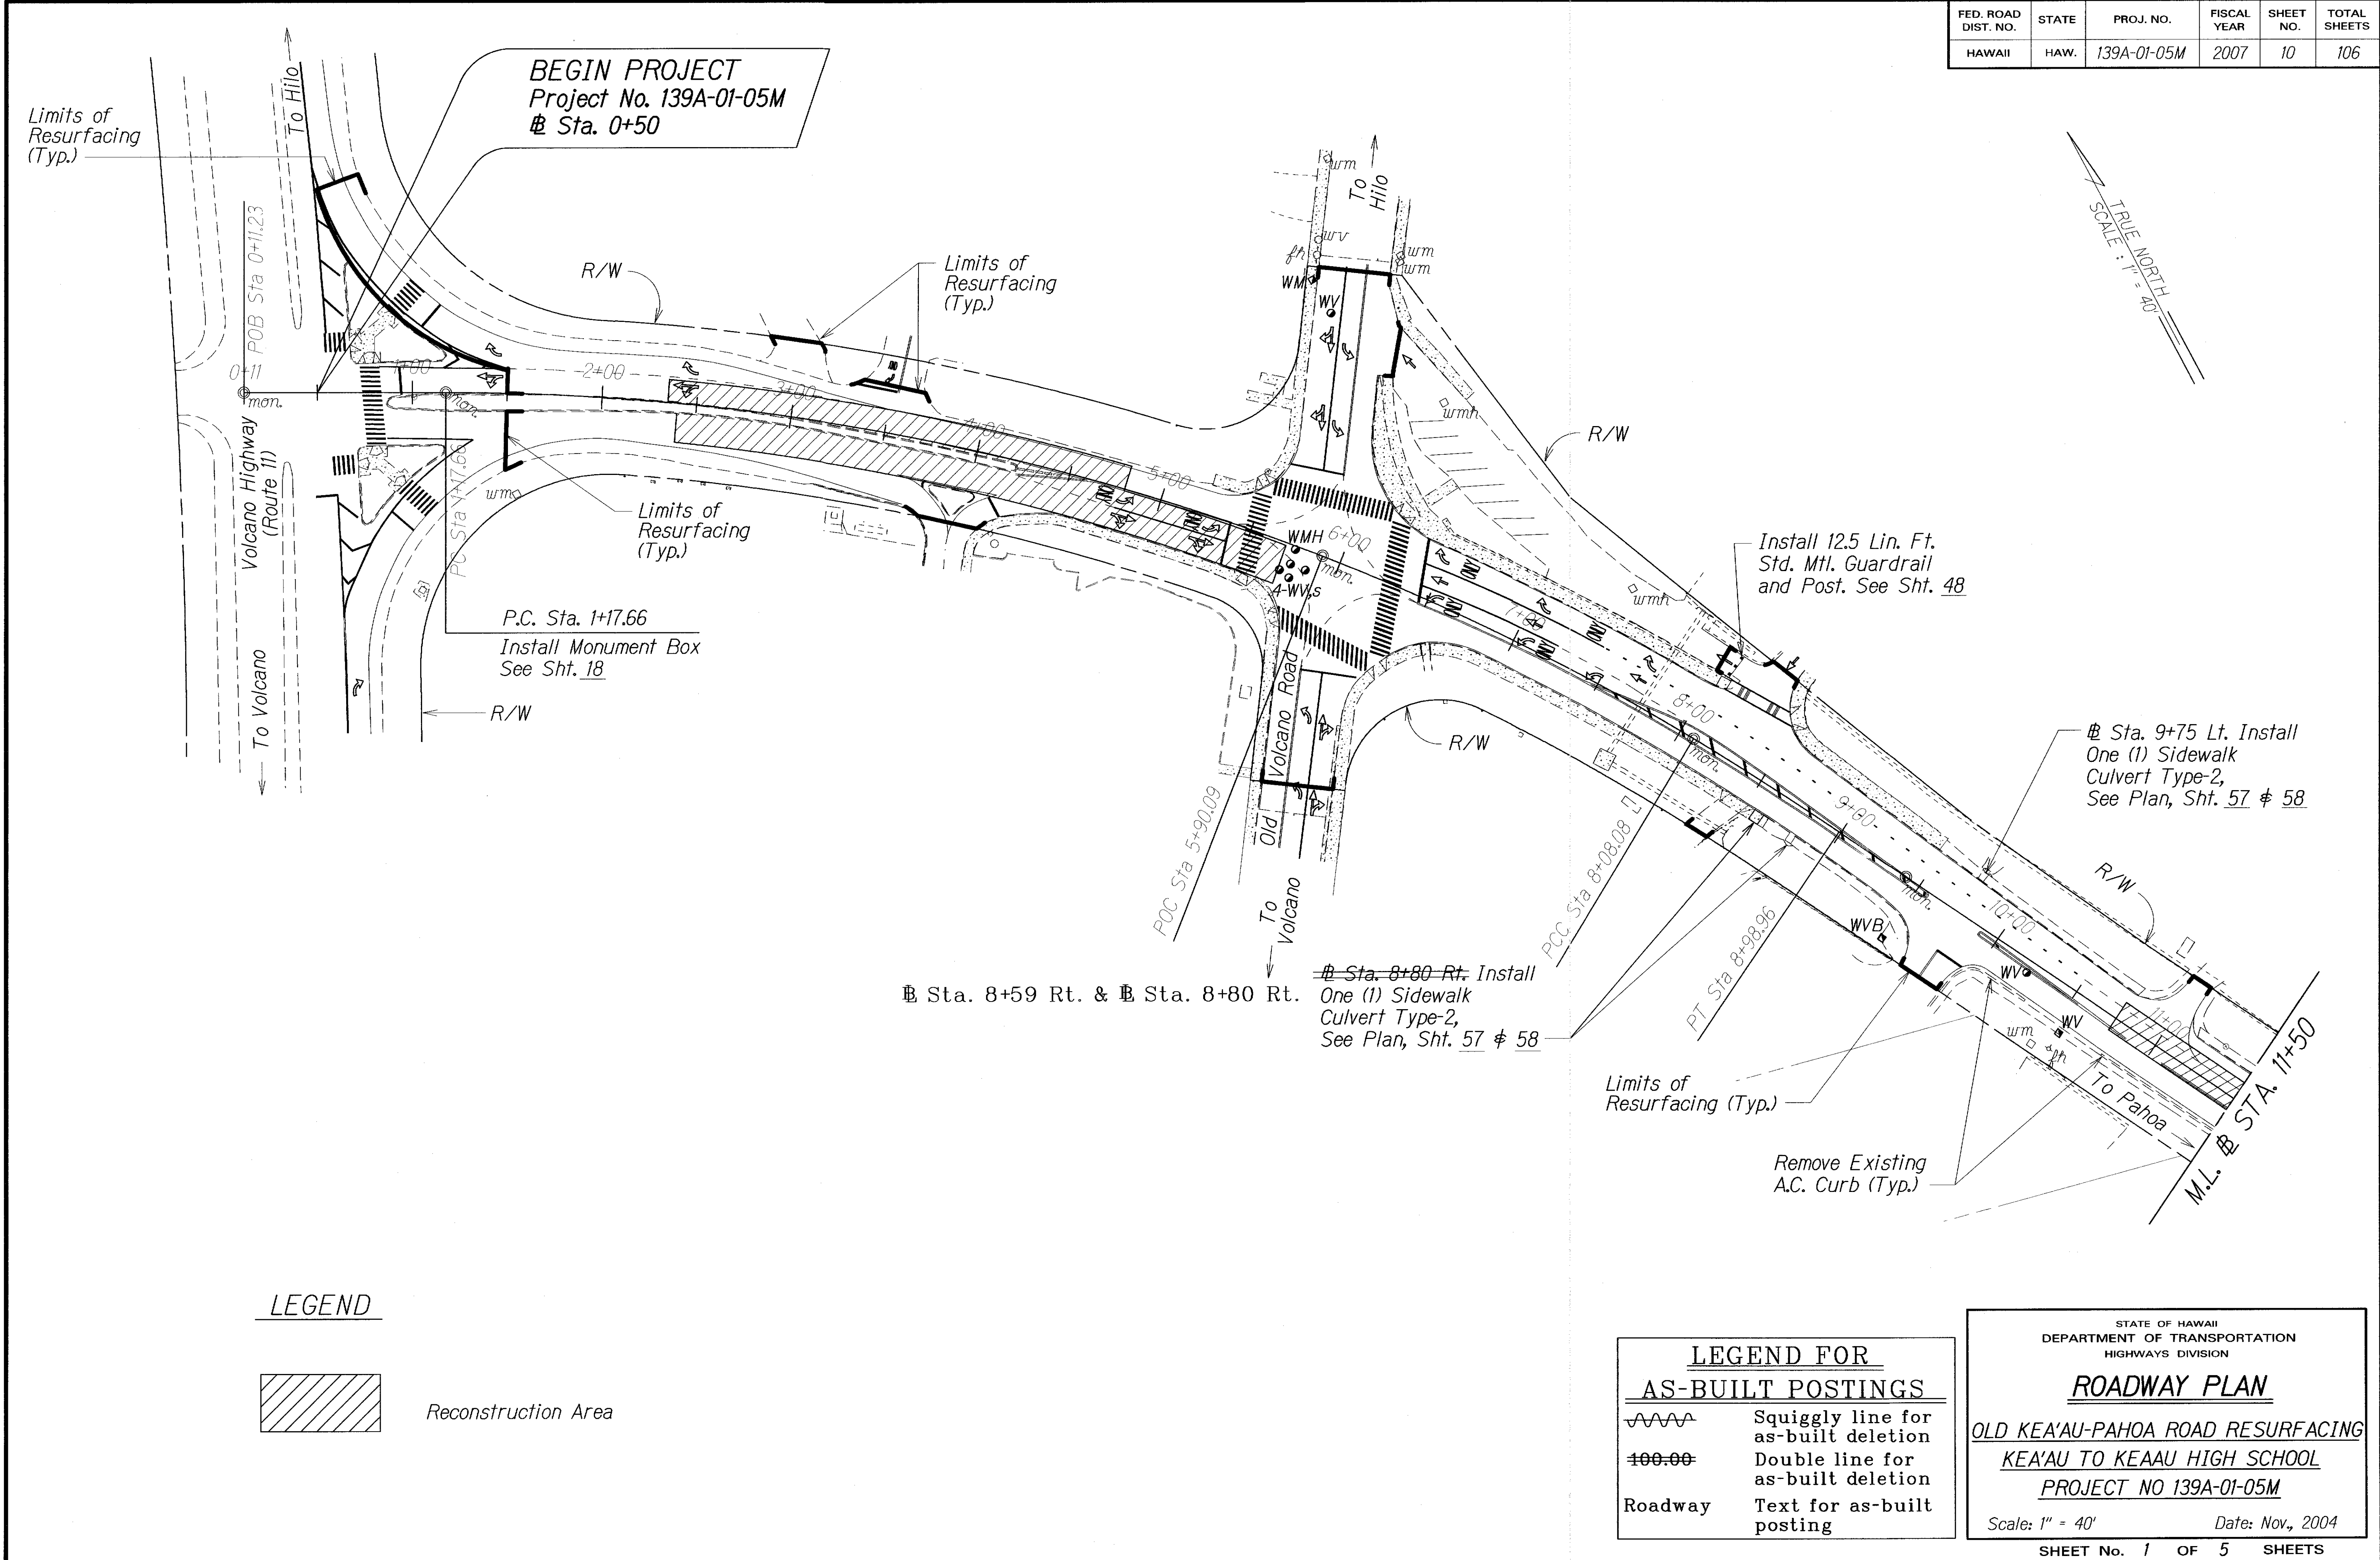


ORIGINAL PLAN	SURVEY PLOTTED BY	DATE
NOTE BOOK	DRAWN BY	
DESIGNED BY	CHECKED BY	
QUANTITIES BY		
CHECKED BY		

"AS-BUILT"

FED. ROAD DIST. NO.	STATE	PROJ. NO.	FISCAL YEAR	SHEET NO.	TOTAL SHEETS
HAWAII	HAW.	139A-01-05M	2007	11	106

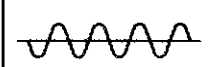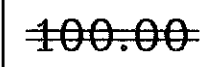LEGEND FOR AS-BUILT POSTINGS	
	Squiggly line for as-built deletion
	Double line for as-built deletion
Roadway	Text for as-built posting

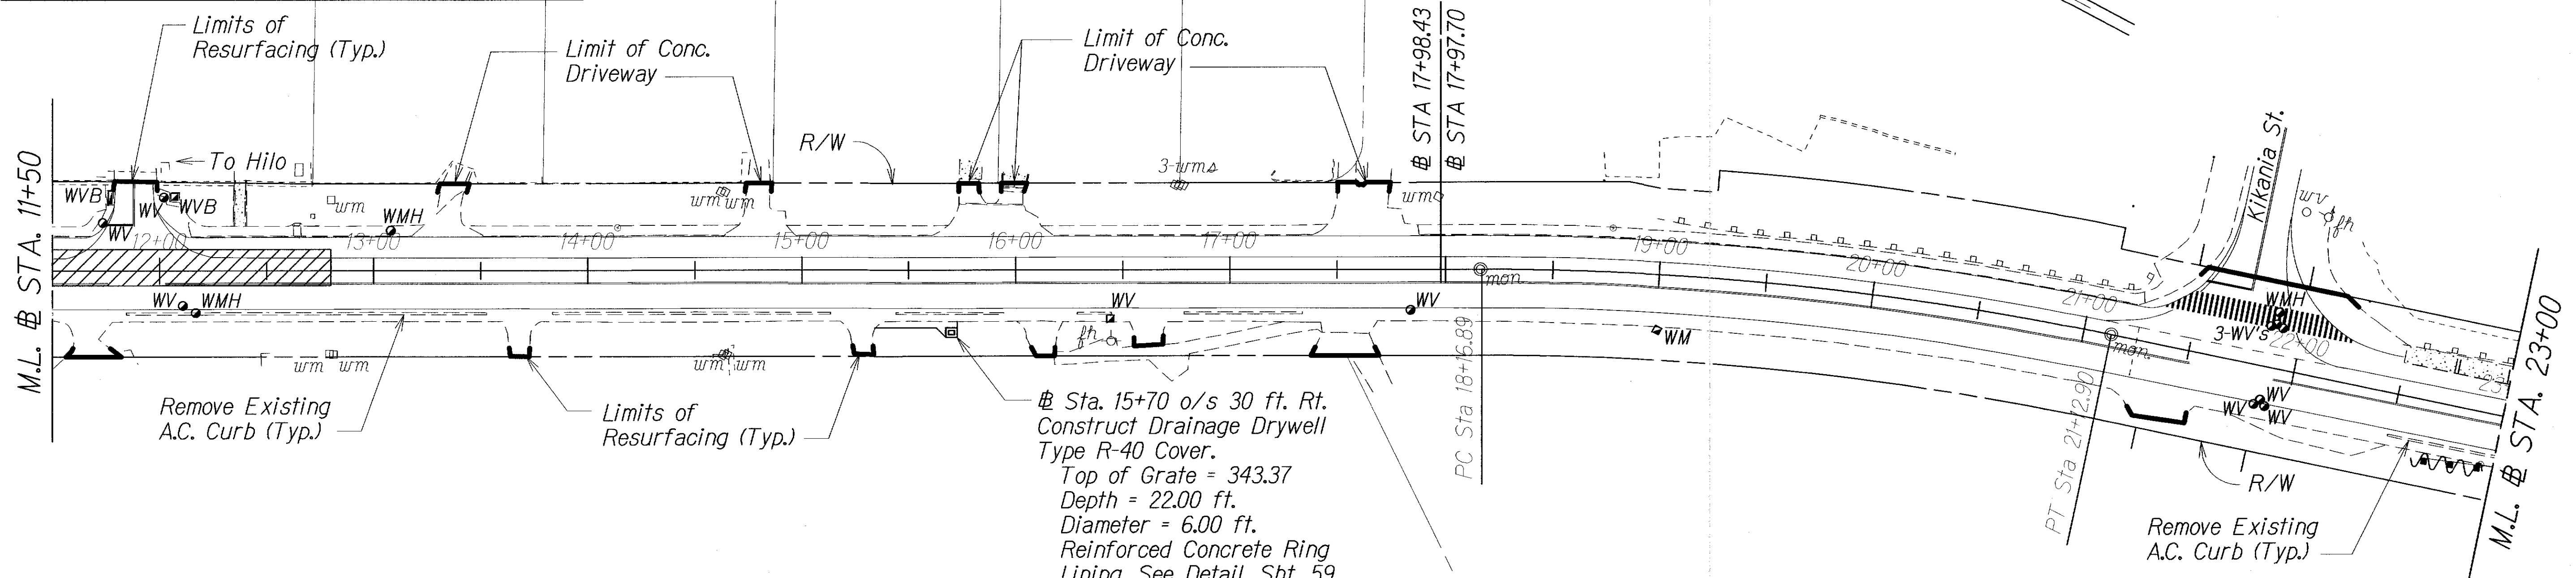

22+66.25
 @ Sta. 24+32.5 Lt. to @ Sta. 27+70 Lt.
 Install Fleet-350 Trailing End Treatment
 Install Std. Mtl. Guardrail and Posts.
 Leading End - Connect to Underpass Guardrail.


~~Sta. 27+70 o/s Lt. 26 Ft. (+/-)
 Connect to Existing 16" Dia. D.I. Waterline.
 Coordinate work with Guardrail Installation
 to avoid conflict and damage. All waterline
 work shop drawings shall be submitted to
 the County of Hawaii Dept. of Water Supply
 for review and approval.~~


~~Sta. 28+70 o/s Lt. 25 Ft. (+/-)
 Connect to Existing 16" Dia. D.I. Waterline.
 Coordinate work with Guardrail Installation
 to avoid conflict and damage. All waterline
 work shop drawings shall be submitted to
 the County of Hawaii Dept. of Water Supply
 for review and approval.~~

24+32.50
 @ Sta. 22+66.25 Rt. to @ Sta. 25+68.75 Rt.
 Install Fleet-350 Leading End Treatment,
 Install Std. Mtl. Guardrail and Posts.
 Trailing End - Install Type "G" Modified
 End Treatment, R=15ft.

@ Sta. 28+70 Lt. to @ Sta. 30+38.75 Lt.
 Install Std. Mtl. Guardrail and Posts.
 Trailing End - Connect to Underpass Guardrail.
 Install Fleet-350 Leading End Treatment.

@ Sta. 34+25 Lt. Install
 Sidewalk Culvert Apron
 See Def., Sht. 58

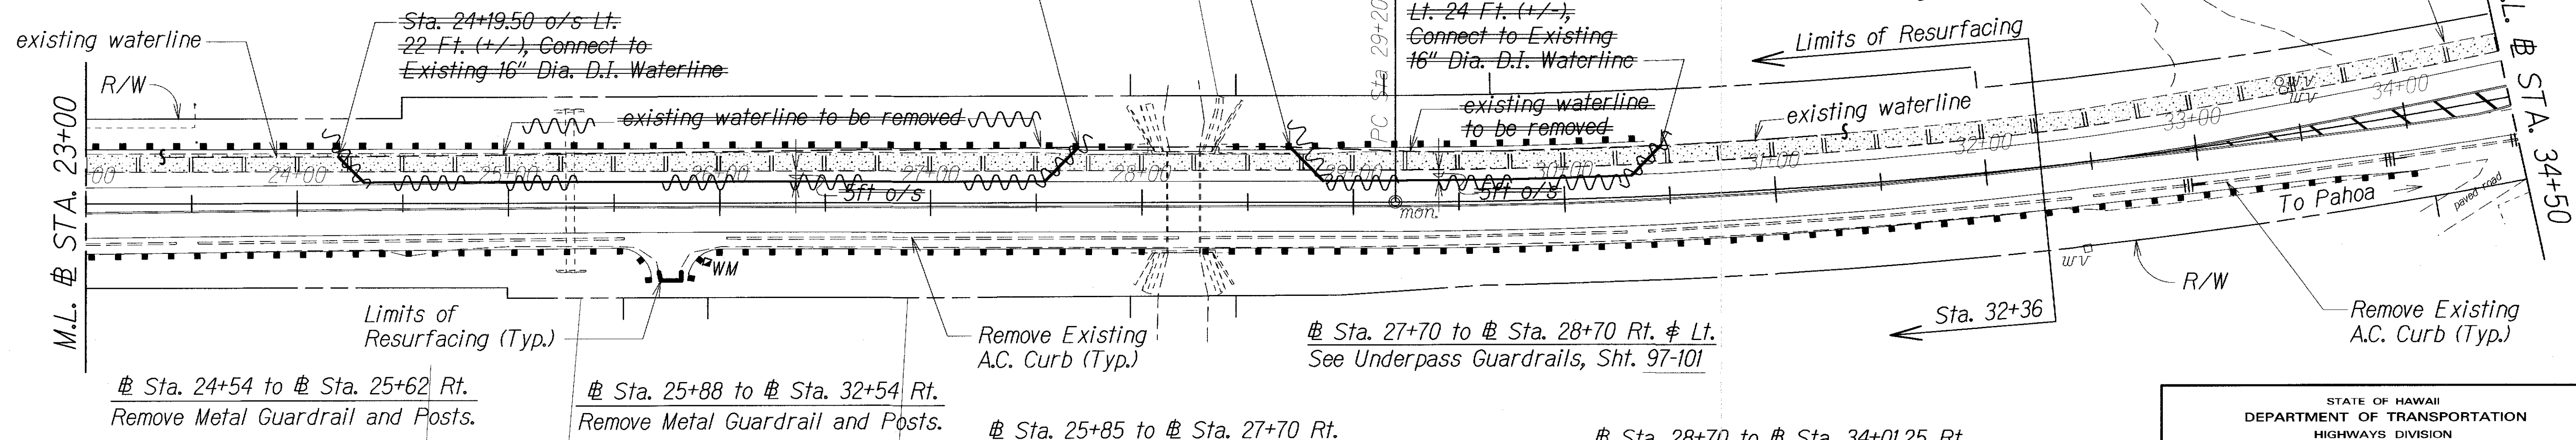

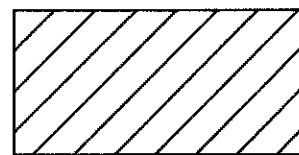LEGEND	
	Reconstruction Area

@ Sta. 28+70 to @ Sta. 34+01.25 Rt.
 Install Fleet-350 Trailing End Treatment
 Install Std. Mtl. Guardrail and Posts.
 Leading End - Connect to Underpass Guardrail.

@ Sta. 25+85 to @ Sta. 27+70 Rt.
 Install Type "G" Modified Leading End Treatment,
 R=15 ft. Install Std. Mtl. Guardrail and Posts.
 Trailing End - Connect to Underpass Guardrail.

@ Sta. 25+88 to @ Sta. 32+54 Rt.
 Remove Metal Guardrail and Posts.

@ Sta. 24+54 to @ Sta. 25+62 Rt.
 Remove Metal Guardrail and Posts.

STATE OF HAWAII

DEPARTMENT OF TRANSPORTATION

HIGHWAYS DIVISION

ROADWAY PLAN

OLD KEA'AU-PAHOA ROAD RESURFACING

KEA'AU TO KEAAU HIGH SCHOOL

PROJECT NO 139A-01-05M

Scale: 1" = 40' Date: Nov., 2004



SHEET No. 2 OF 5 SHEETS

ORIGINAL	DATE
DESIGNED BY	
TRACED BY	
NOTED BY	
QUANTITIES BY	
CHECKED BY	

"AS-BUILT"

FED. ROAD DIST. NO.	STATE	PROJ. NO.	FISCAL YEAR	SHEET NO.	TOTAL SHEETS
HAWAII	HAW.	139A-01-05M	2007	12	106

Limit of Hydromulch
 @ Sta. 37+00 Lt. to @ Sta. 37+25 Lt.

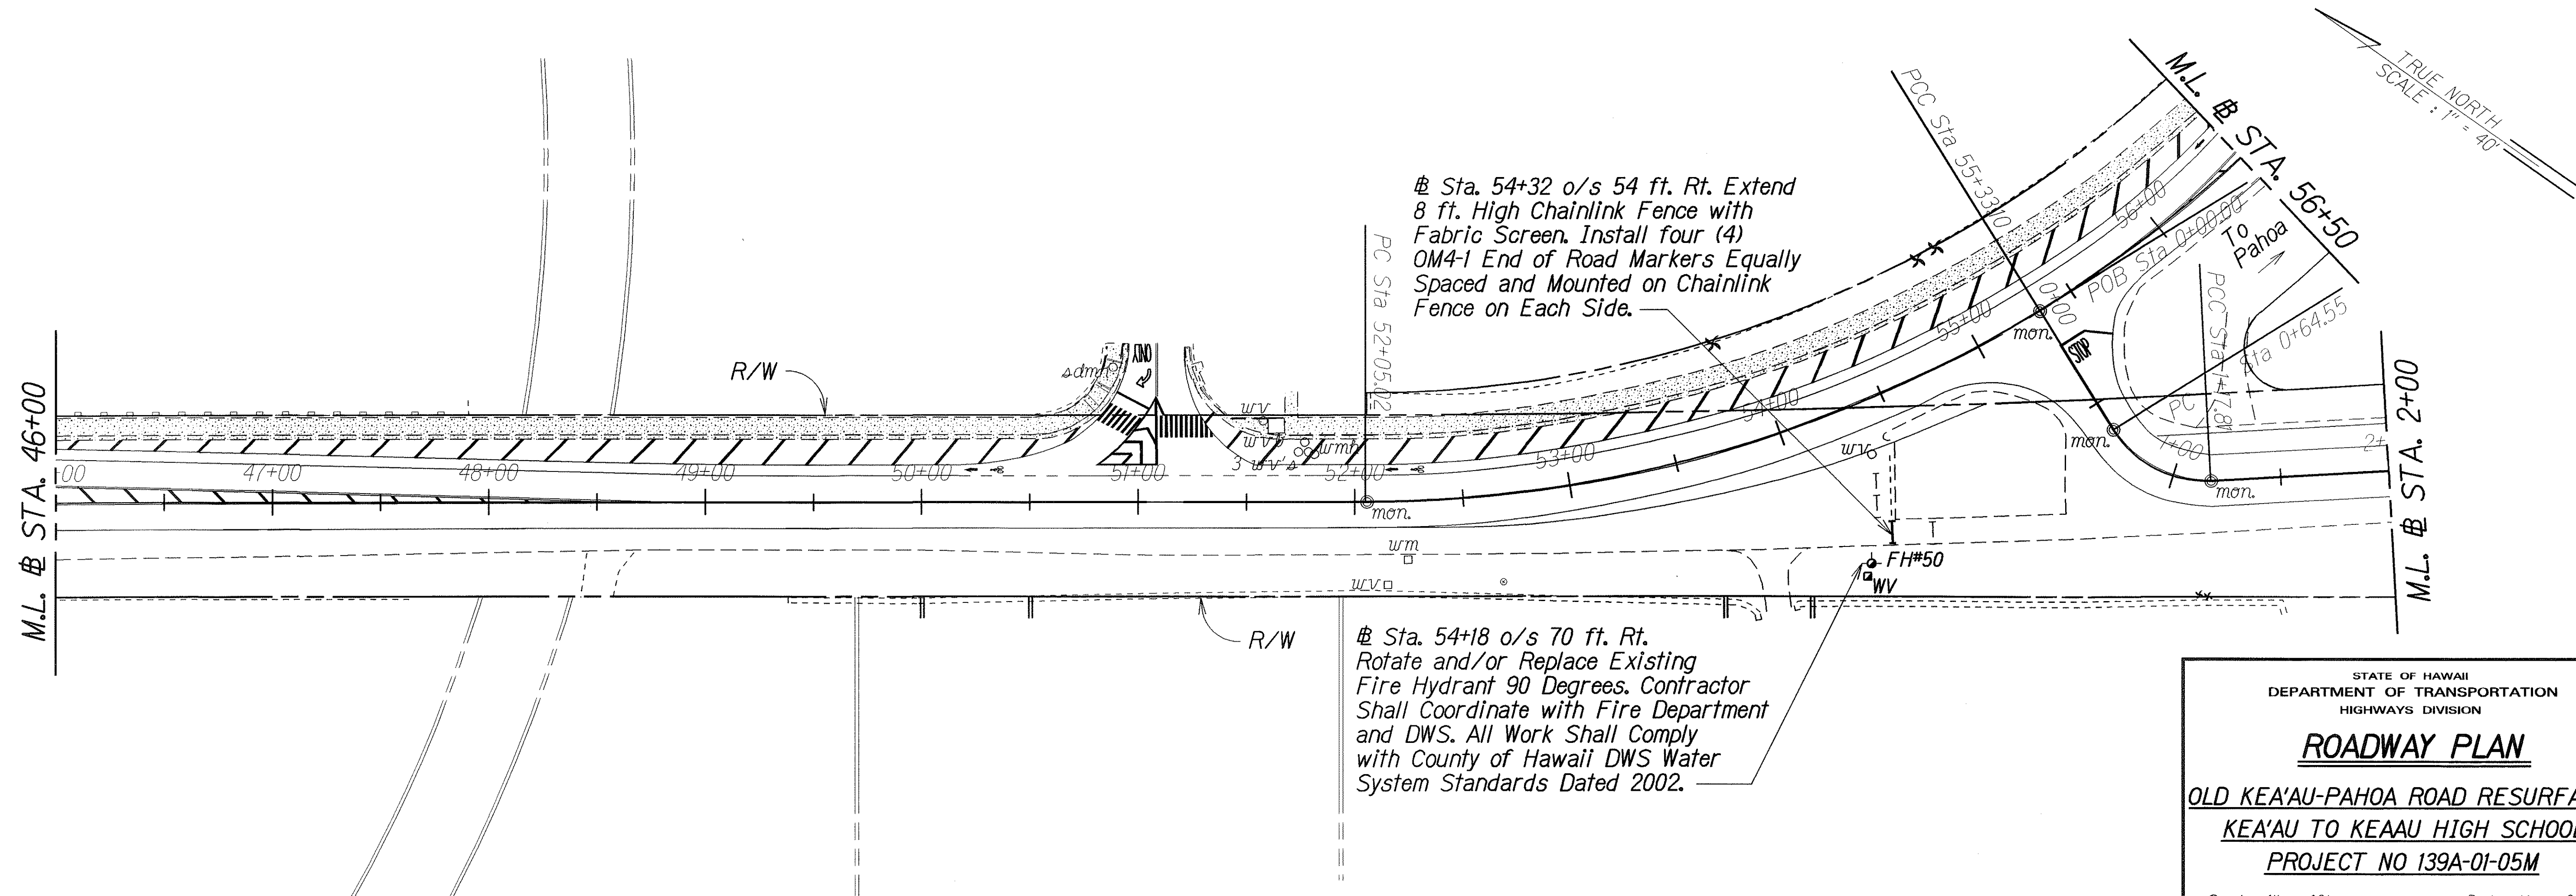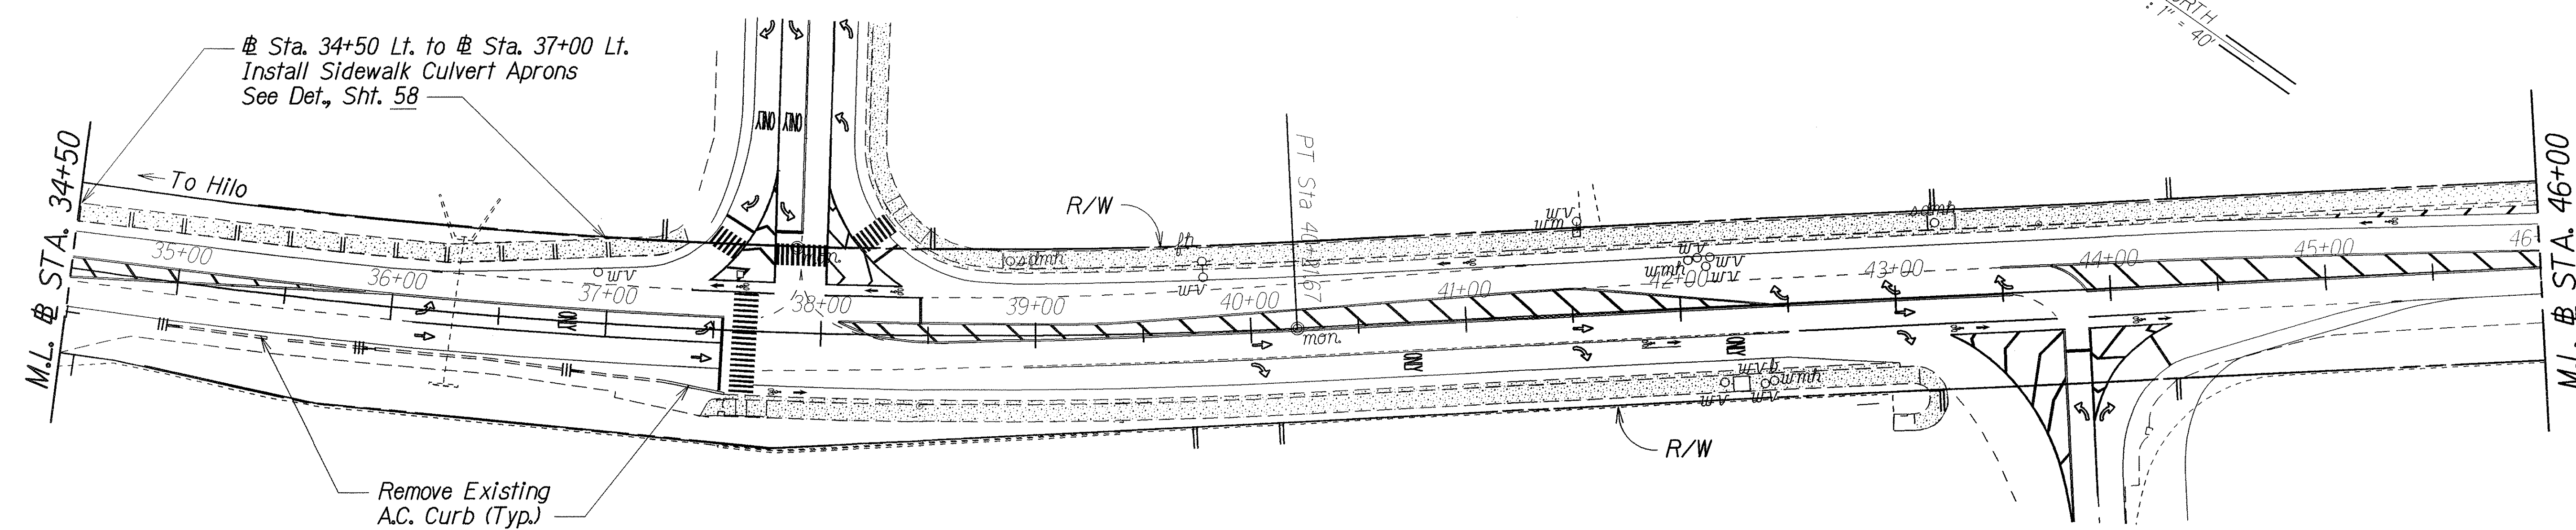

ORIGINAL PLAN	SURVEY PLOTTED BY	DATE
NOTE BOOK	DRAWN BY	
5/10/03	TRACED BY	
5/10/03	CHECKED BY	
5/10/03	QUANTITIES BY	
5/10/03	CHECKED BY	

STATE OF HAWAII
 DEPARTMENT OF TRANSPORTATION
 HIGHWAYS DIVISION



ROADWAY PLAN

OLD KEA'AU-PAHOA ROAD RESURFACING
 KEA'AU TO KEAAU HIGH SCHOOL
 PROJECT NO 139A-01-05M

Scale: 1" = 40' Date: Nov., 2004

SHEET No. 3 OF 5 SHEETS

FED. ROAD DIST. NO.	STATE	PROJ. NO.	FISCAL YEAR	SHEET NO.	TOTAL SHEETS
HAWAII	HAW.	139A-01-05M	2007	13	106

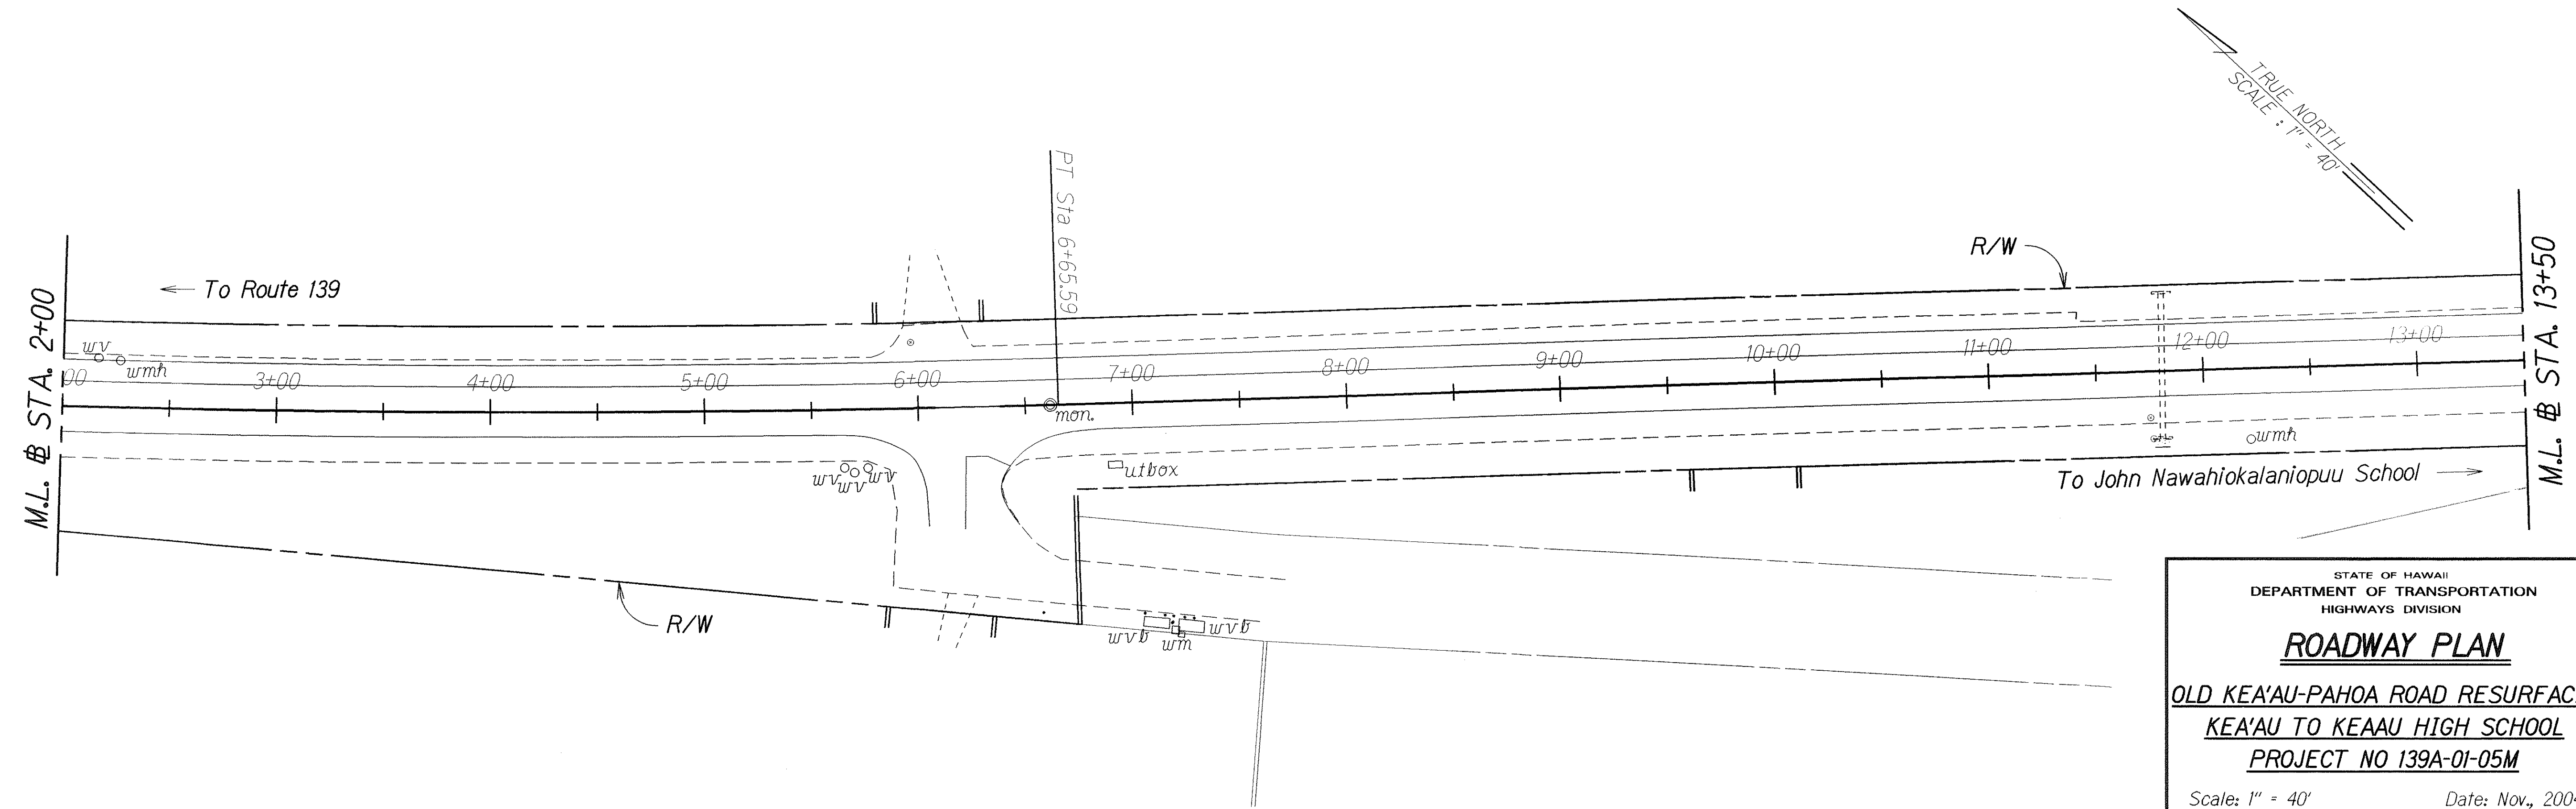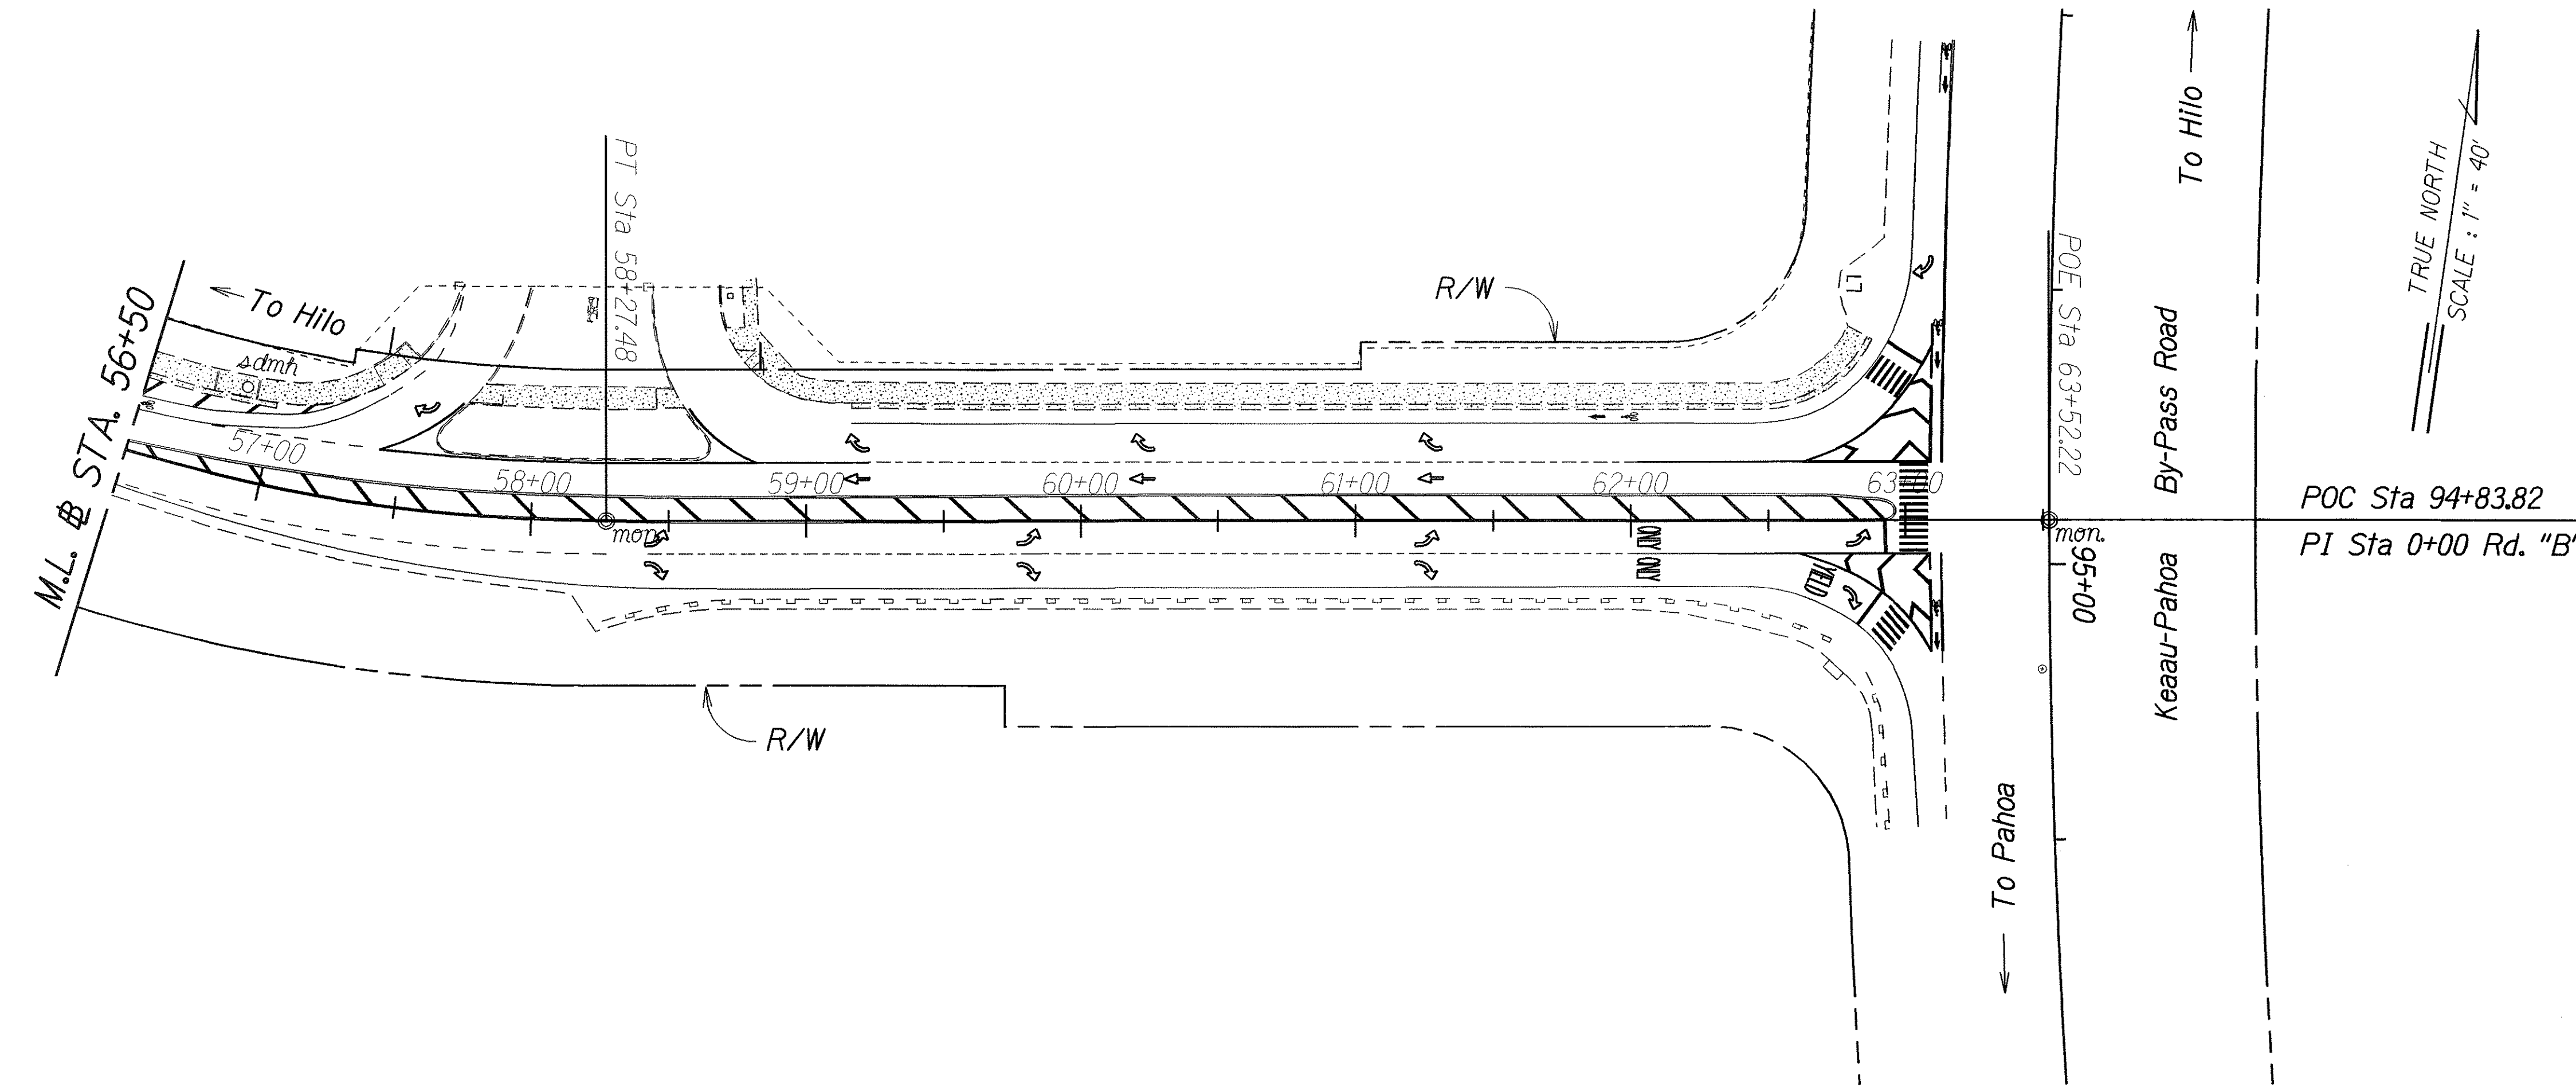

ORIGINAL PLAN	SURVEY PLOTTED BY	DATE
NOTE BOOK	DESIGNED BY	
5/10/07	QUANTITIES BY	
IN DELIVERABLES	CHECKED BY	

STATE OF HAWAII
DEPARTMENT OF TRANSPORTATION
HIGHWAYS DIVISION


ROADWAY PLAN

OLD KEA'AU-PAHOA ROAD RESURFACING
KEA'AU TO KEAAU HIGH SCHOOL
PROJECT NO 139A-01-05M

Scale: 1" = 40' Date: Nov., 2004

SHEET No. 4 OF 5 SHEETS

FED. ROAD DIST. NO.	STATE	PROJ. NO.	FISCAL YEAR	SHEET NO.	TOTAL SHEETS
HAWAII	HAW.	139A-01-05M	2007	14	106

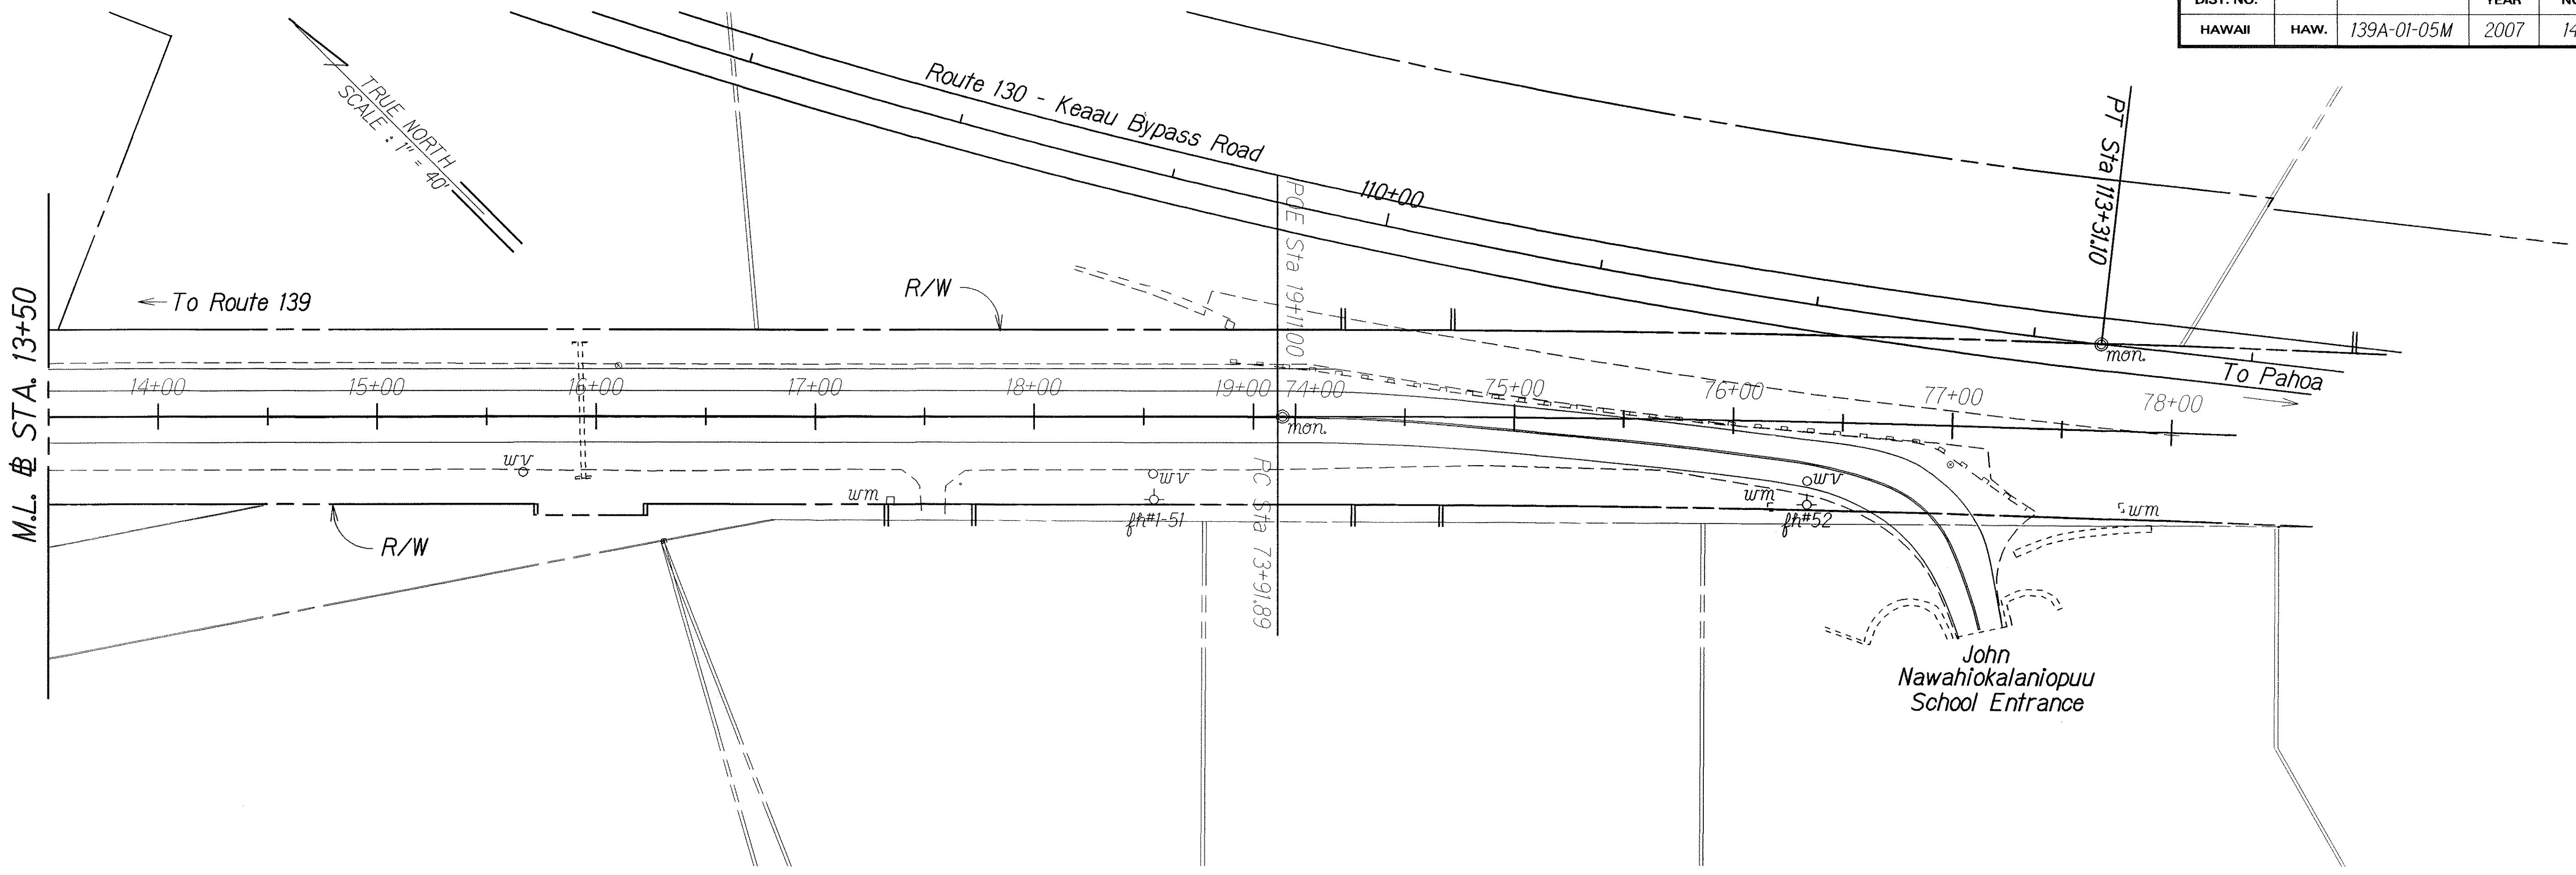

ORIGINAL PLAN	DATE
DRAWN BY	
DESIGNED BY	
CHECKED BY	
IN CHARGE	

STATE OF HAWAII
DEPARTMENT OF TRANSPORTATION
HIGHWAYS DIVISION

ROADWAY PLAN
OLD KEA'AU-PAHOA ROAD RESURFACING
KEA'AU TO KEAAU HIGH SCHOOL
PROJECT NO 139A-01-05M

Scale: 1" = 40' Date: Nov., 2004
SHEET No. 5 OF 5 SHEETS