


FED. ROAD DIST. No.	STATE	FED. AID PROJ. No.	FISCAL YEAR	SHEET No.	TOTAL SHEETS
HAWAII	HAW.	S-0160(1)	1961	5	18



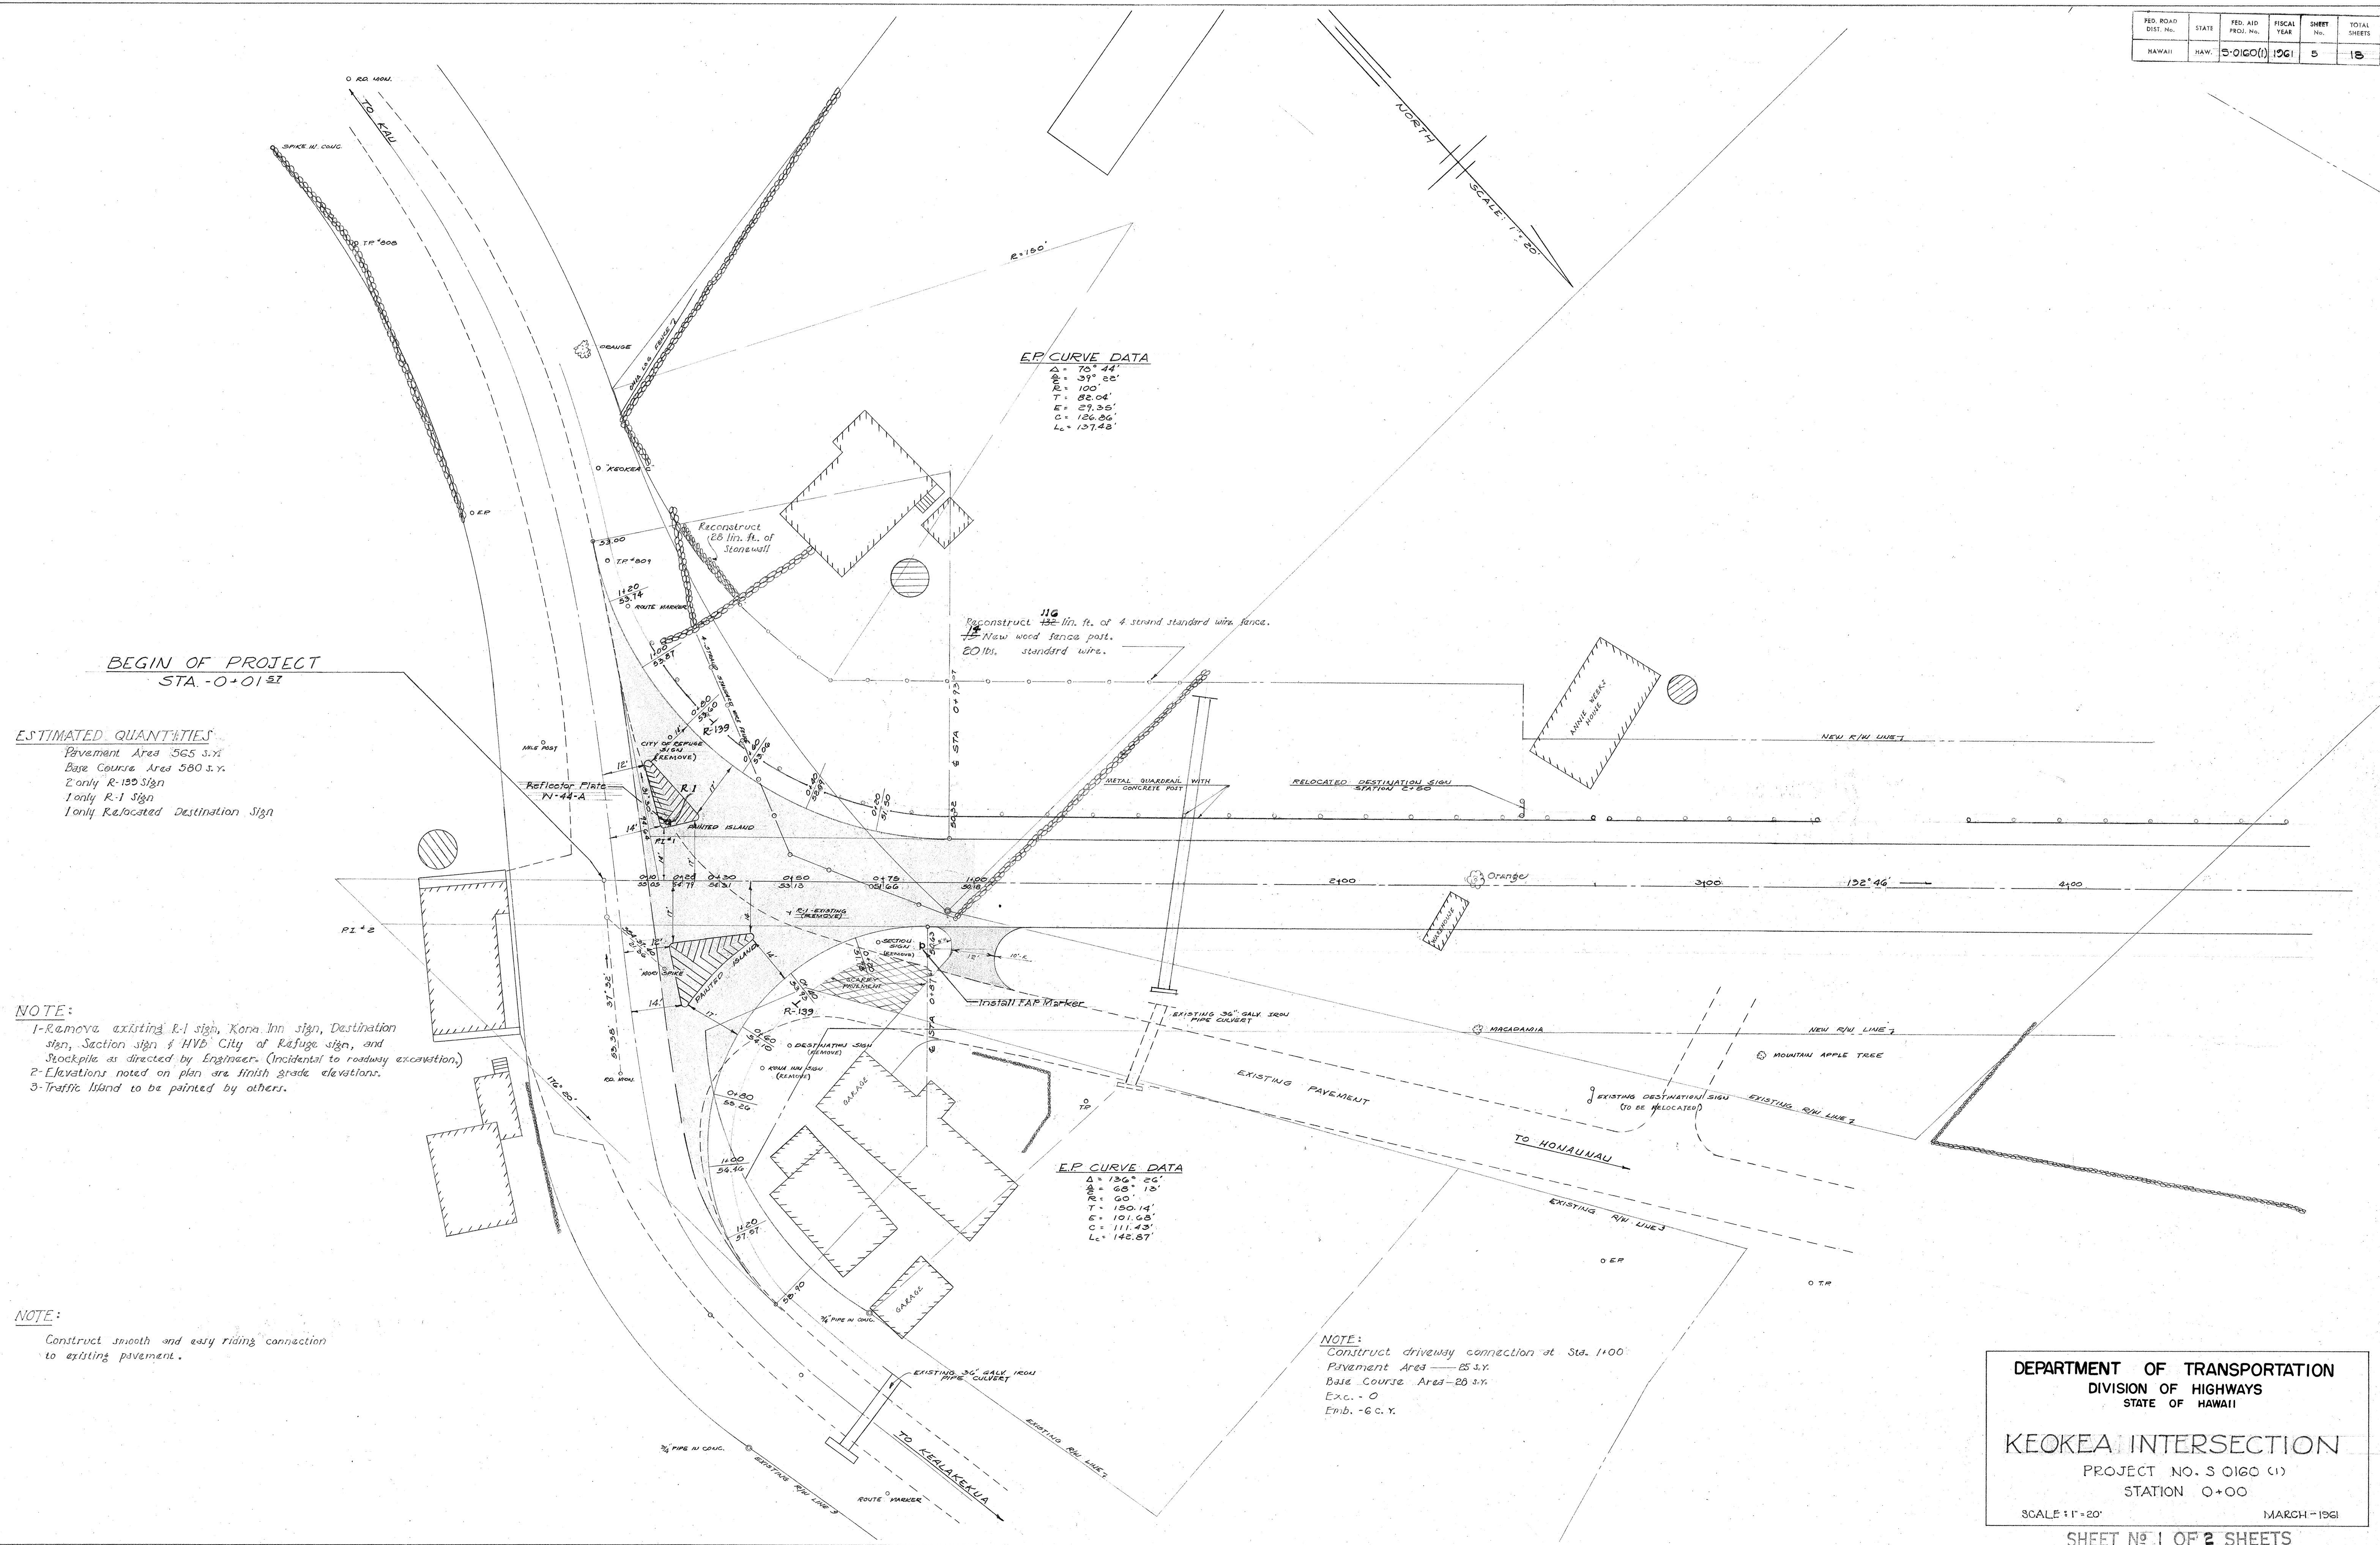


DEPARTMENT OF TRANSPORTATION
DIVISION OF HIGHWAYS
STATE OF HAWAII

KEOKEA INTERSECTION
PROJECT NO. S 0160 (1)
STATION 0+00
SCALE 1" = 20'
MARCH - 1961

SHEET NO. 1 OF 2 SHEETS

FED. ROAD DIST. NO.	STATE	FED. AID PROJ. NO.	FISCAL YEAR	SHEET NO.	TOTAL SHEETS
HAWAII	HAW	S-0160(1)	1961	6	16

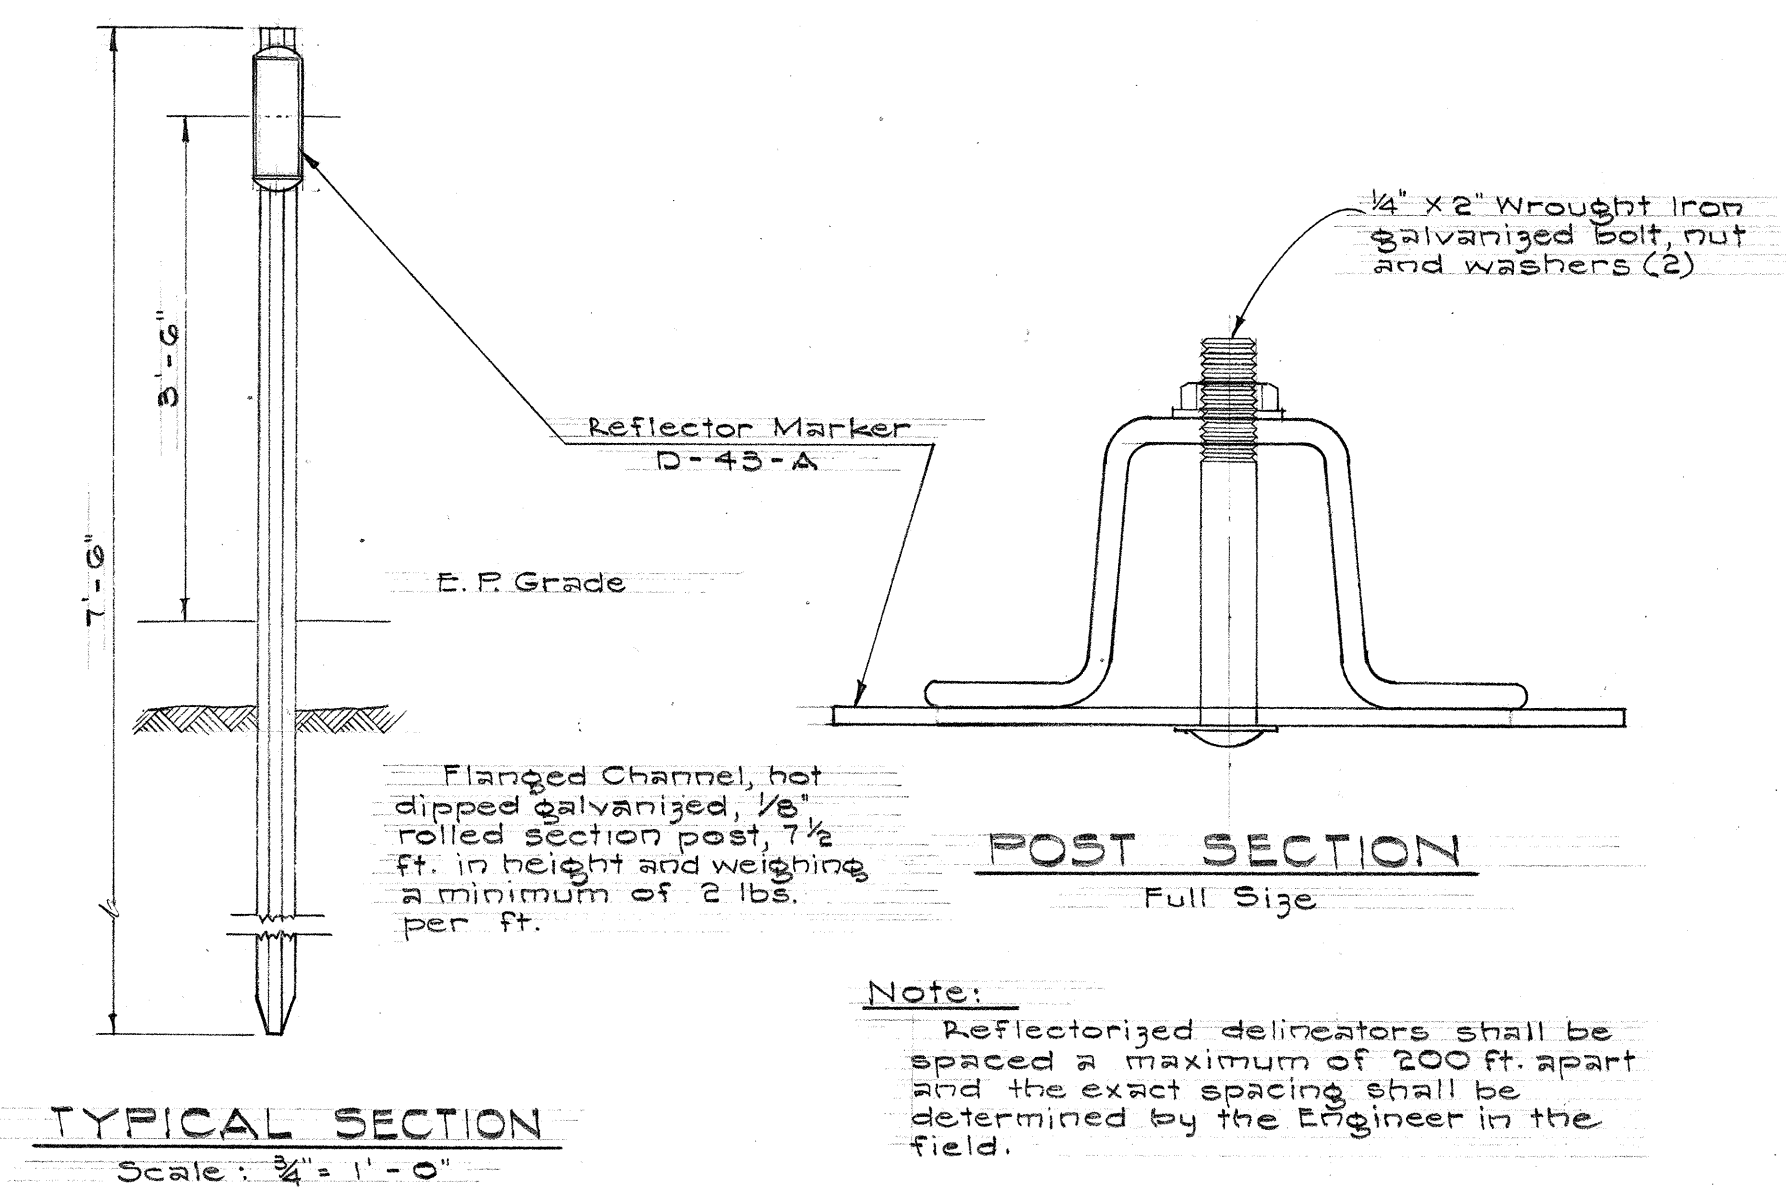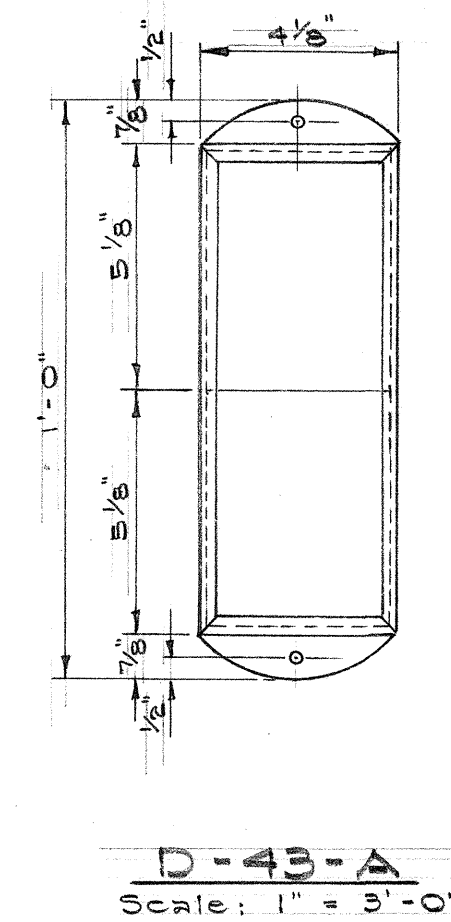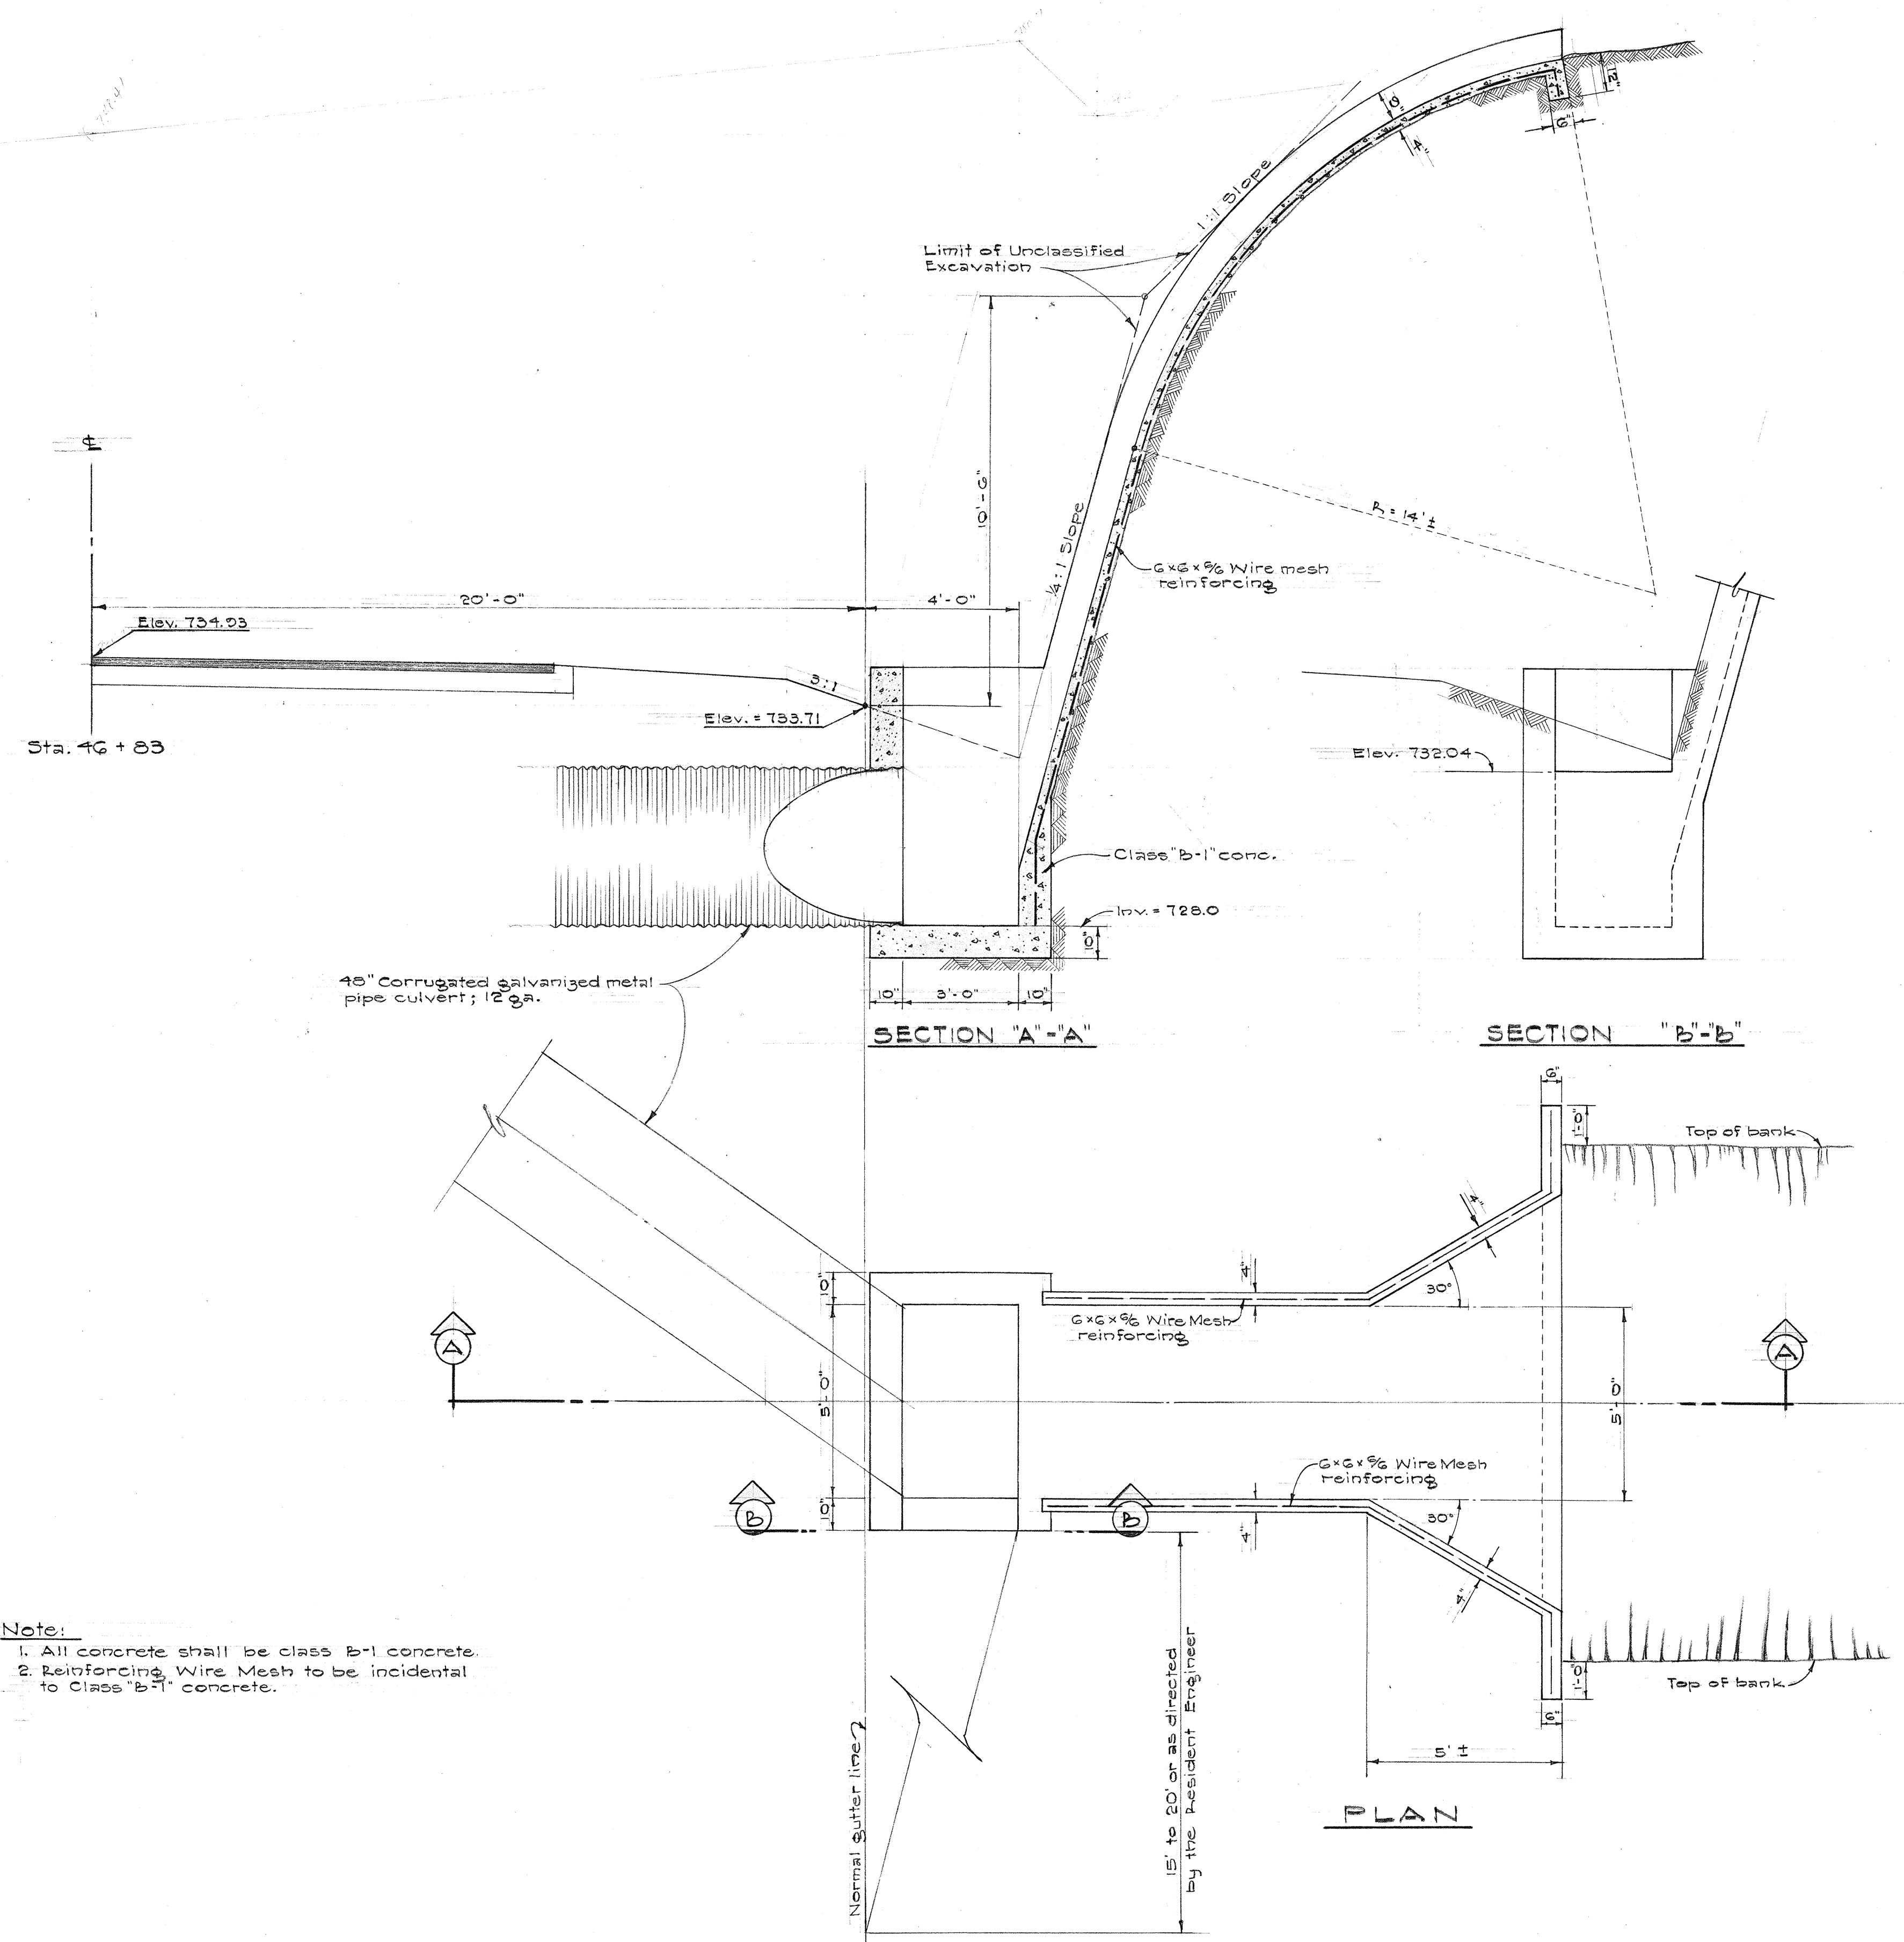

DETAIL OF REFLECTORIZED DELINEATOR
Scale: As Shown

Note:
1. All concrete shall be class B-1 concrete.
2. Reinforcing Wire Mesh to be incidental to Class B-1 concrete.

DETAIL OF SPECIAL CONCRETE DROP INTAKE & SPILLWAY AT STA. 46+83
Scale: 3/8" = 1'-0"

STATE OF HAWAII
DEPARTMENT OF TRANSPORTATION
DIVISION OF HIGHWAYS
MISCELLANEOUS DETAILS
CITY OF REFUGE ROAD
Project No. S-0160(1)
SCALE: As Shown
DATE: May, 1961
SHEET NO. 2 OF 2 SHEETS

ORIGINAL PLAN	DATE
DESIGNED BY	
TRACED BY	
QUANTITIES BY	
CHECKED BY	
NOTE BOOK No.	