

INDEX TO DRAWINGS	
SHEET	DESCRIPTION
1	TITLE SHEET
2	TYPICAL SECTIONS
3-4	PLAN & PROFILE
5-6	DETAIL SHEETS
7-13	CROSS - SECTIONS
14-18	STANDARD DETAILS

STATE OF HAWAII

DEPARTMENT OF TRANSPORTATION

DIVISION OF HIGHWAYS

"AS BUILT" PLANS OF

CITY OF REFUGE ROAD

(KEOKEA JCT. TOWARDS CITY OF REFUGE)

FEDERAL AID PROJECT NO. S-0160(I)

DISTRICT OF SOUTH KONA


ISLAND OF HAWAII

SCALES

PLAN	-----	INCH	=	100 FT.
PROFILE	-----	HOR. INCH	=	100 FT.
		VER. INCH	=	10 FT.
CROSS SECTION	-----	HOR. INCH	=	10 FT.
		VER. INCH	=	10 FT.

LOCATION


PROJ. NO. S-0160(I)

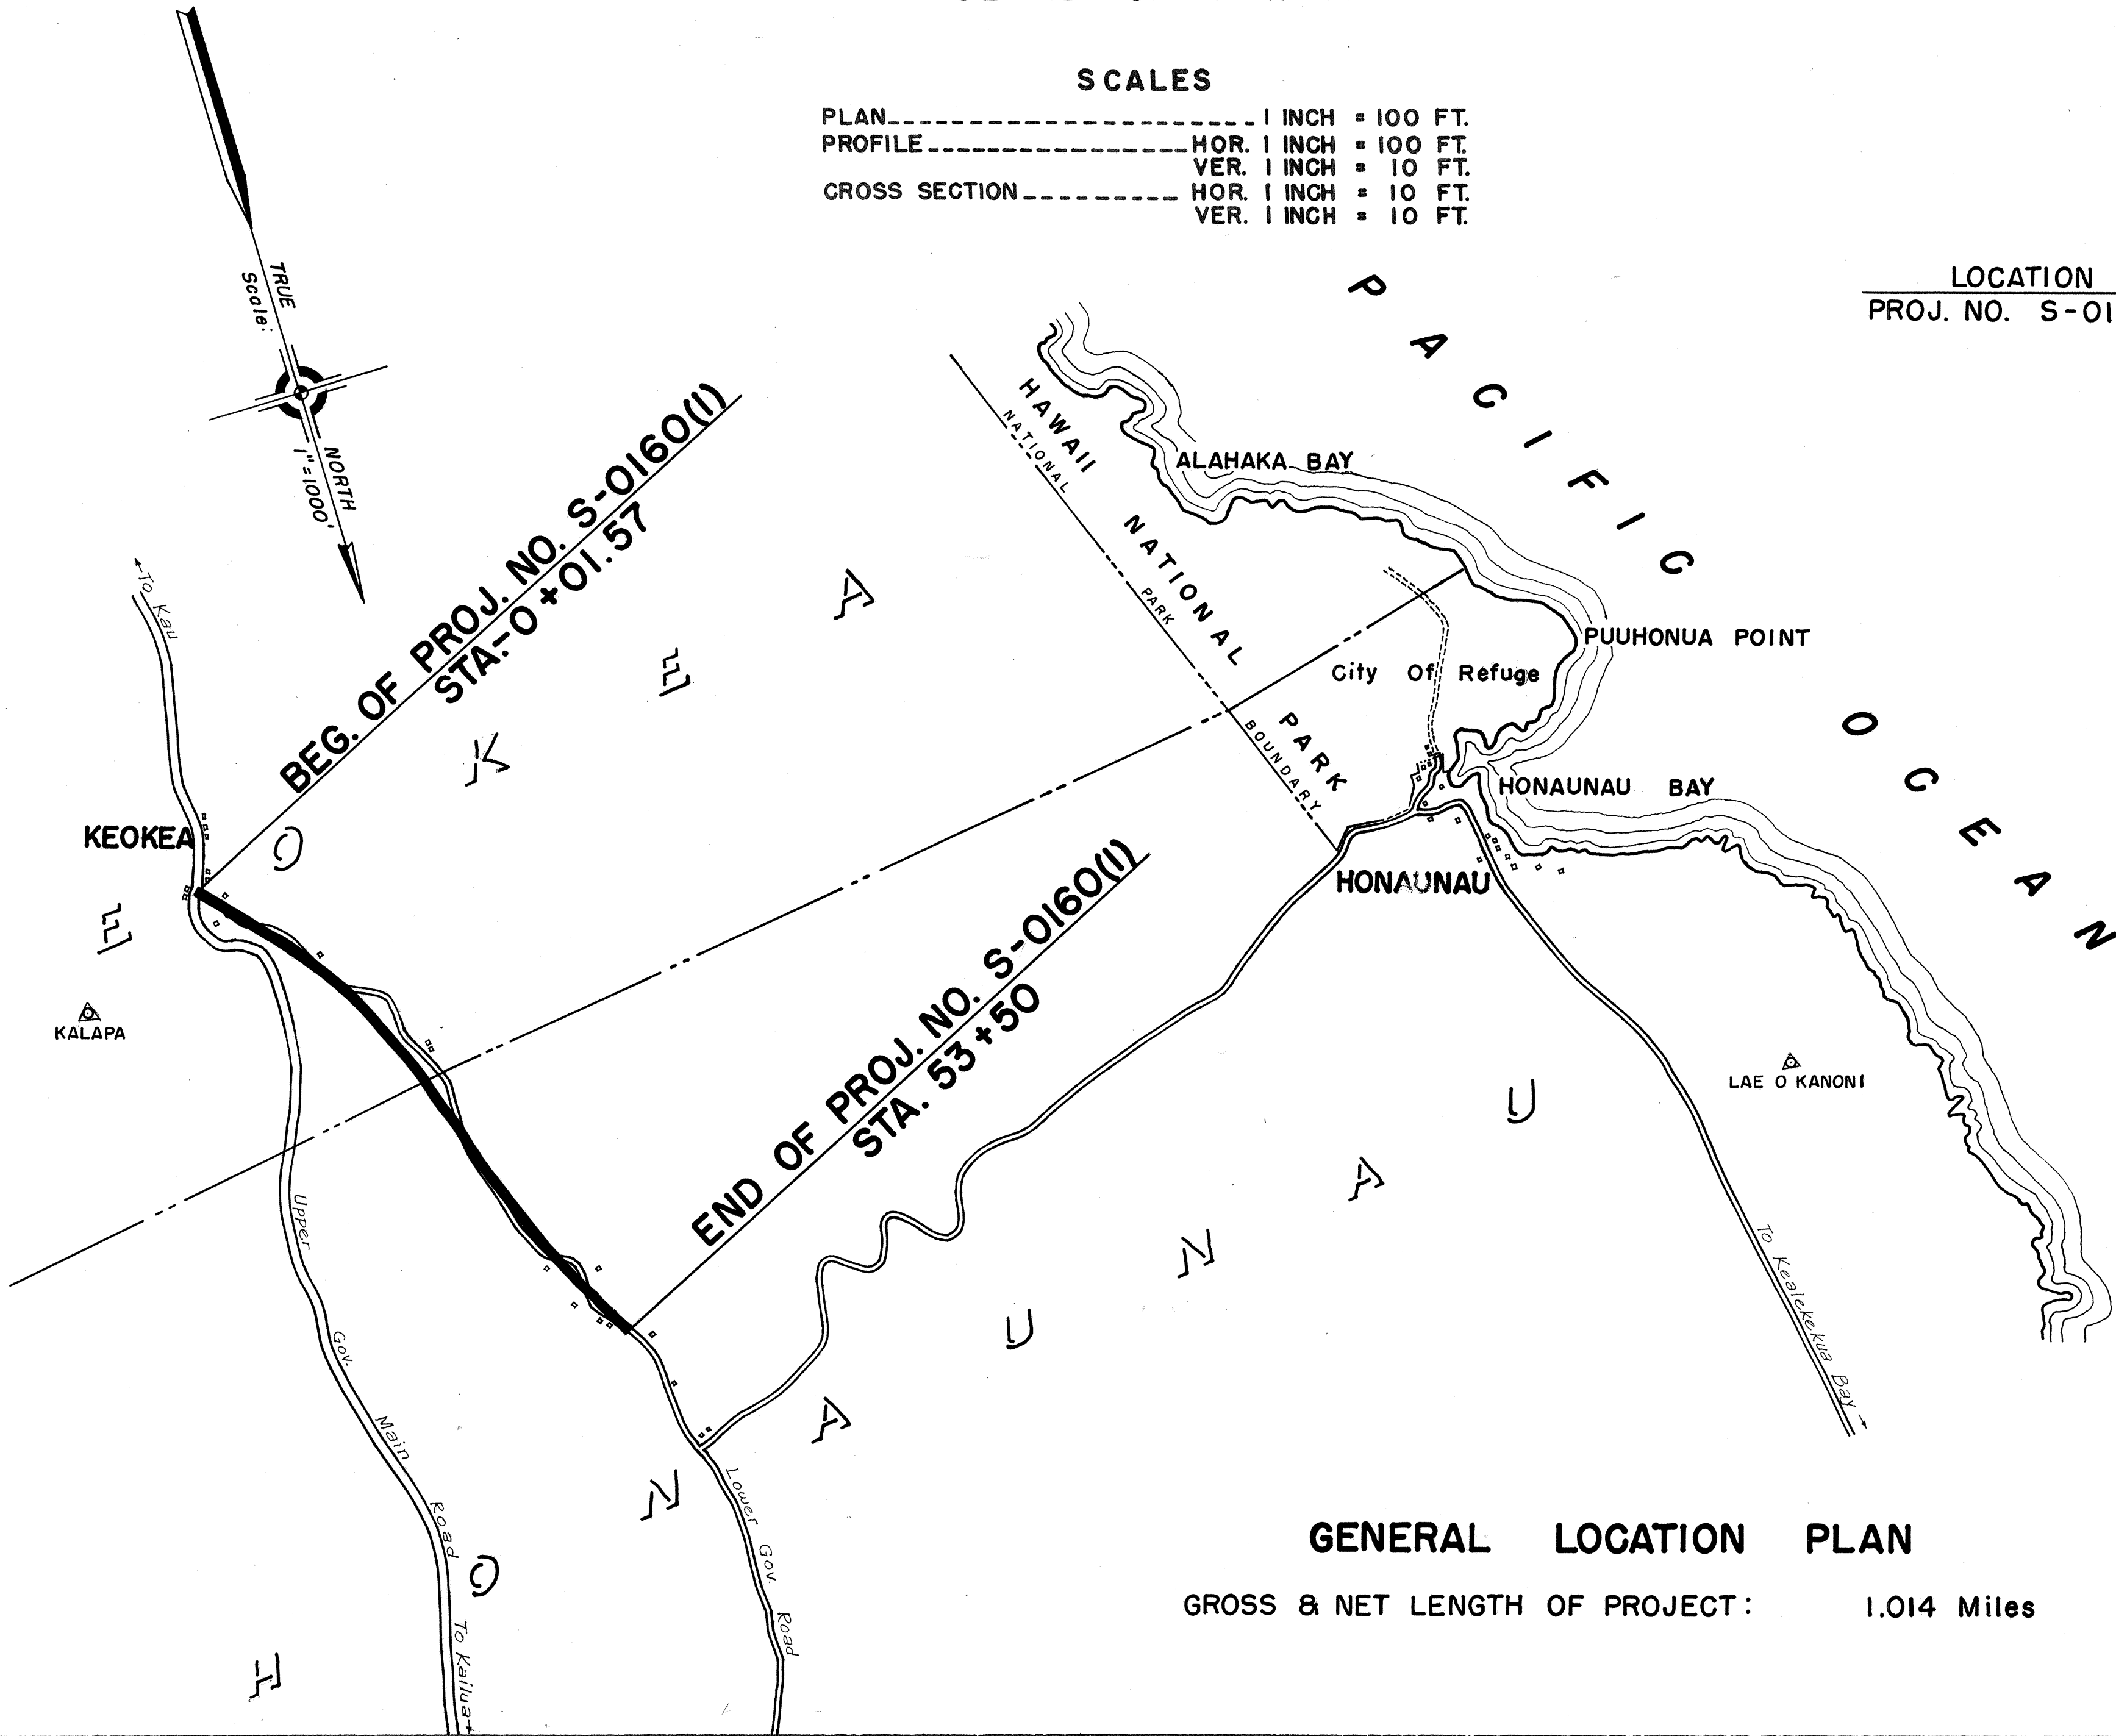

GENERAL LOCATION PLAN

GROSS & NET LENGTH OF PROJECT:

1.014 Miles

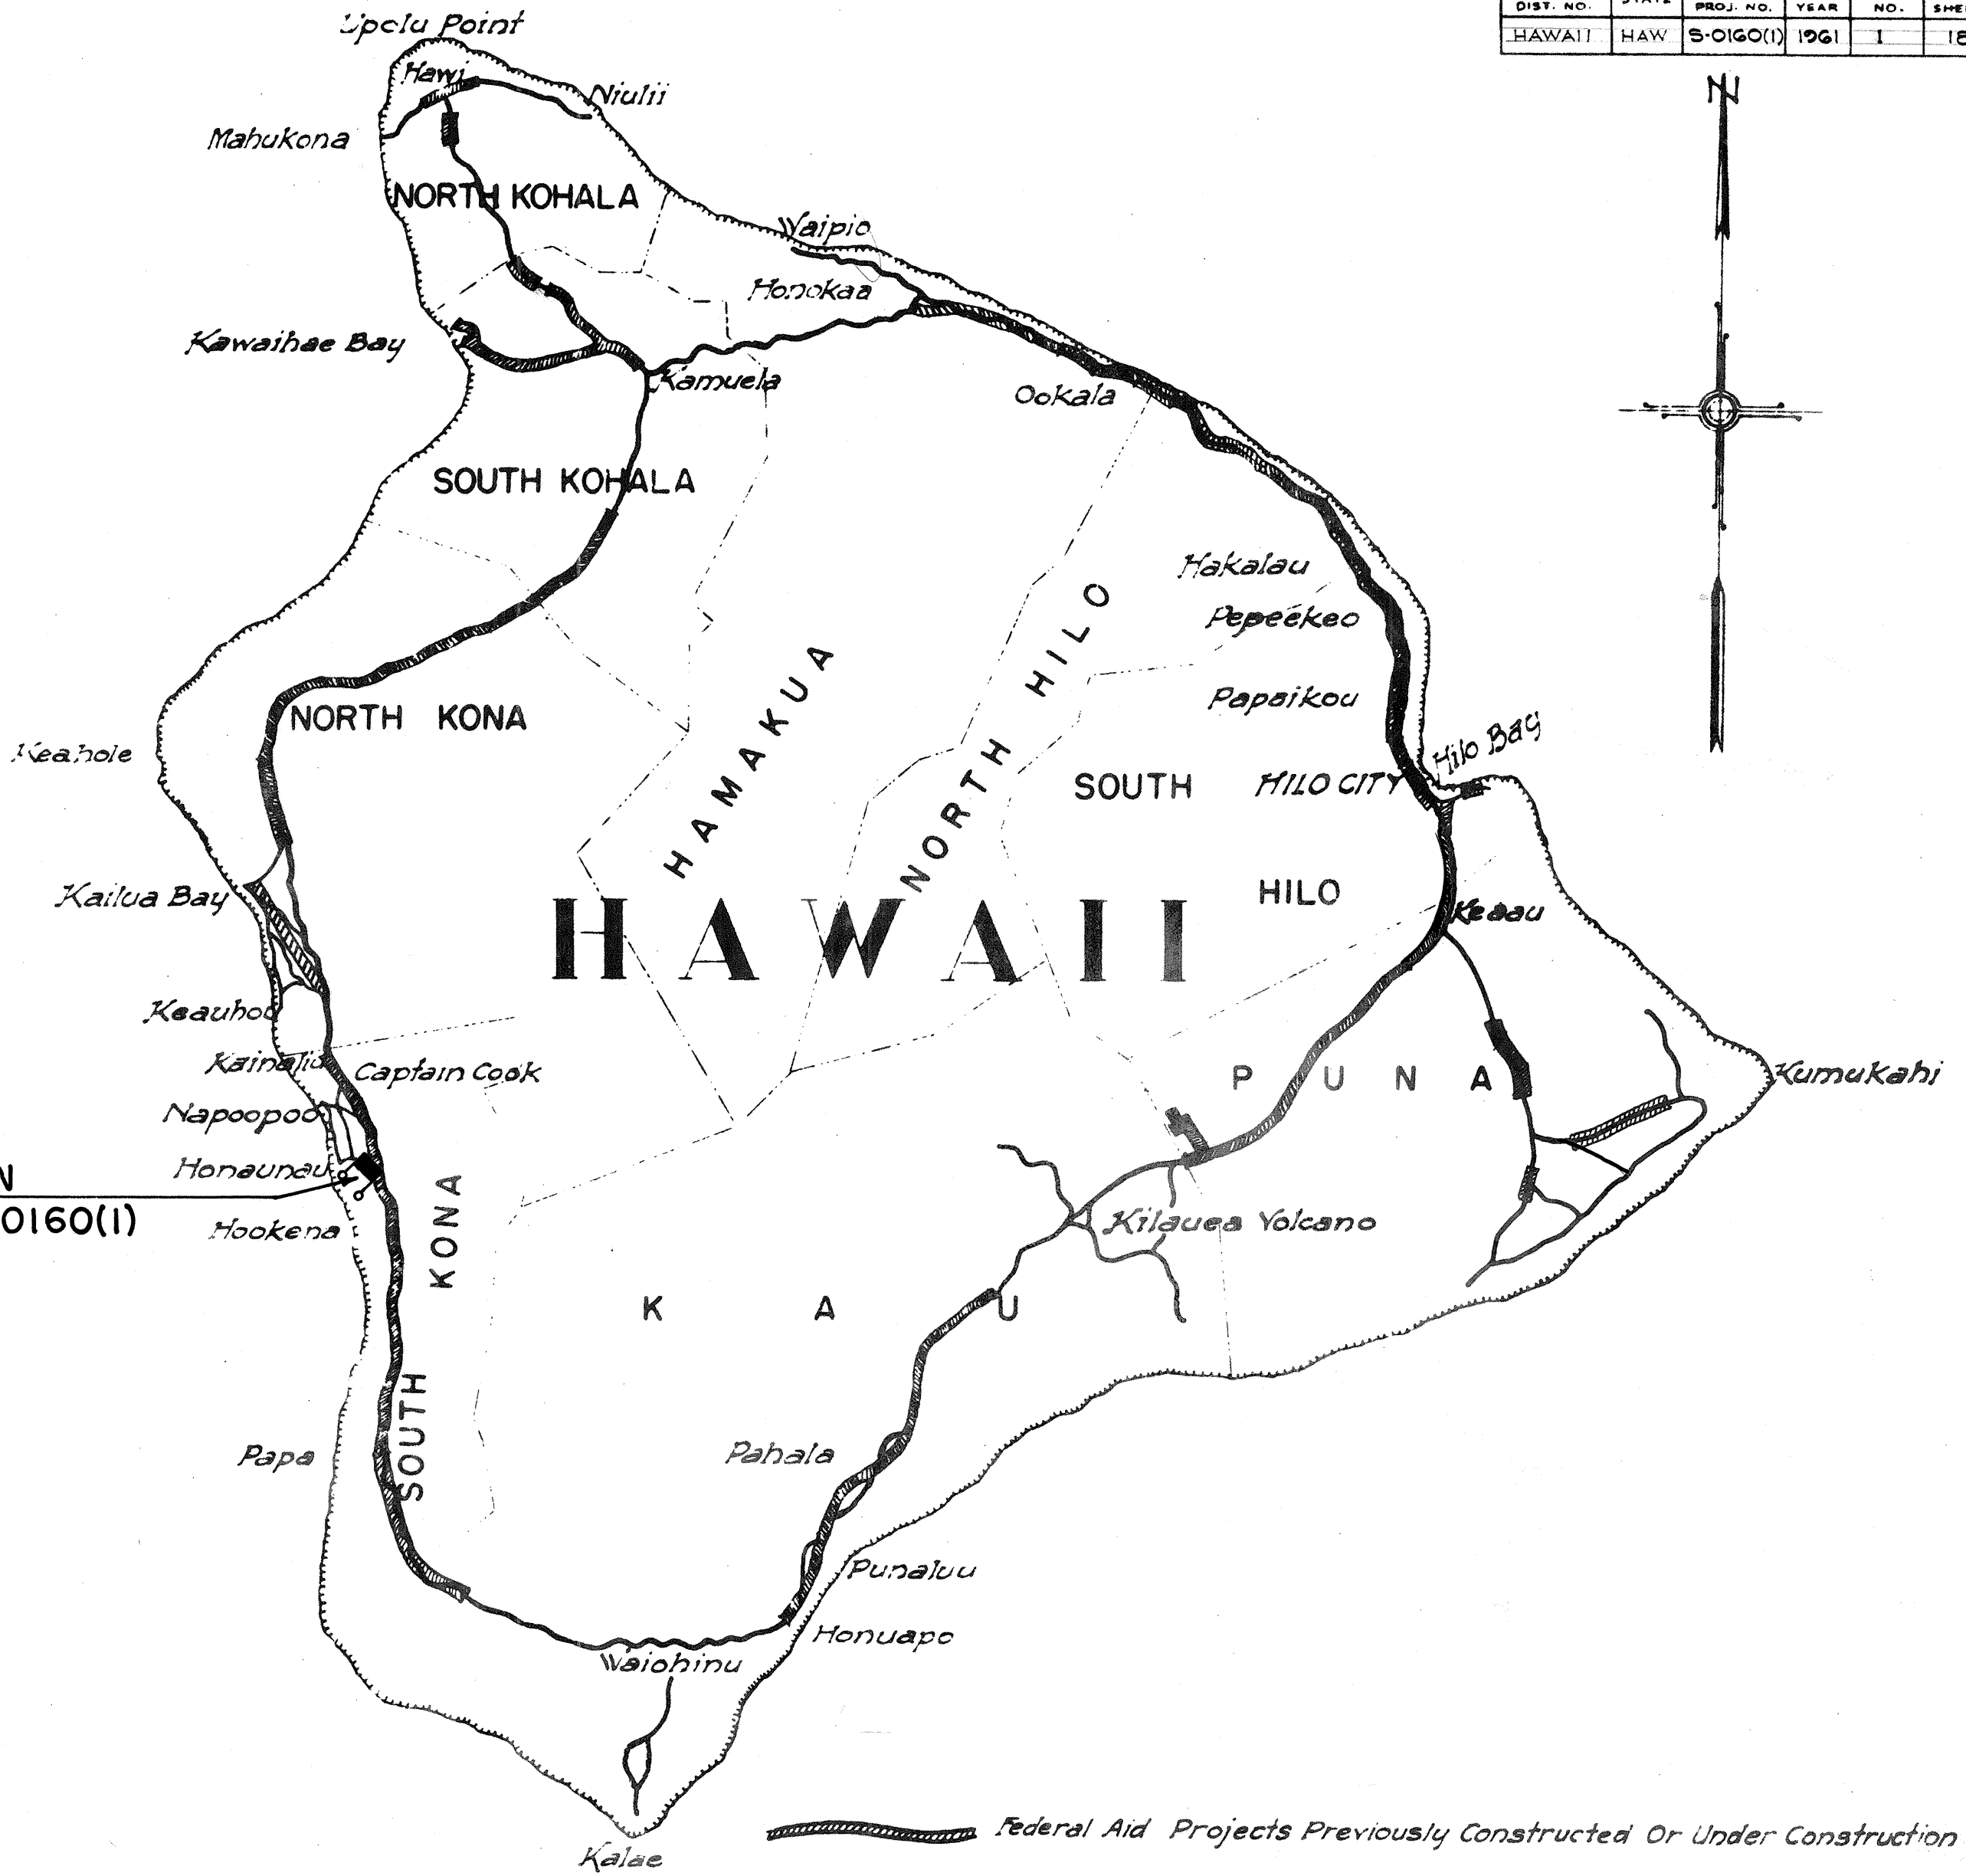

NOTE:

ALL CHANGES MADE DURING CONSTRUCTION

HAVE BEEN NOTED ON THESE TRACINGS IN

RED AND CHECKED BY:

DESIGN CLASSIFICATION

ADT (1961)	275
ADT (1981)	1500
DHV	11%
D	60
T	9%
V	40 M.P.H

APPROVED:

DATE 5/31/61

Sam O. Hirota

for DIRECTOR OF TRANSPORTATION

Largo J. J. J.

PROJECT ENGINEER

May 27, 1963

DATE

DEPARTMENT OF COMMERCE

BUREAU OF PUBLIC ROADS

APPROVED:

DIVISION ENGINEER DATE