



FED. ROAD DIST. NO.	STATE	FED. AID PROJ. NO.	FISCAL YEAR	SHEET NO.	TOTAL SHEETS
HAWAII	HAW.	5-01600	1965	2	31

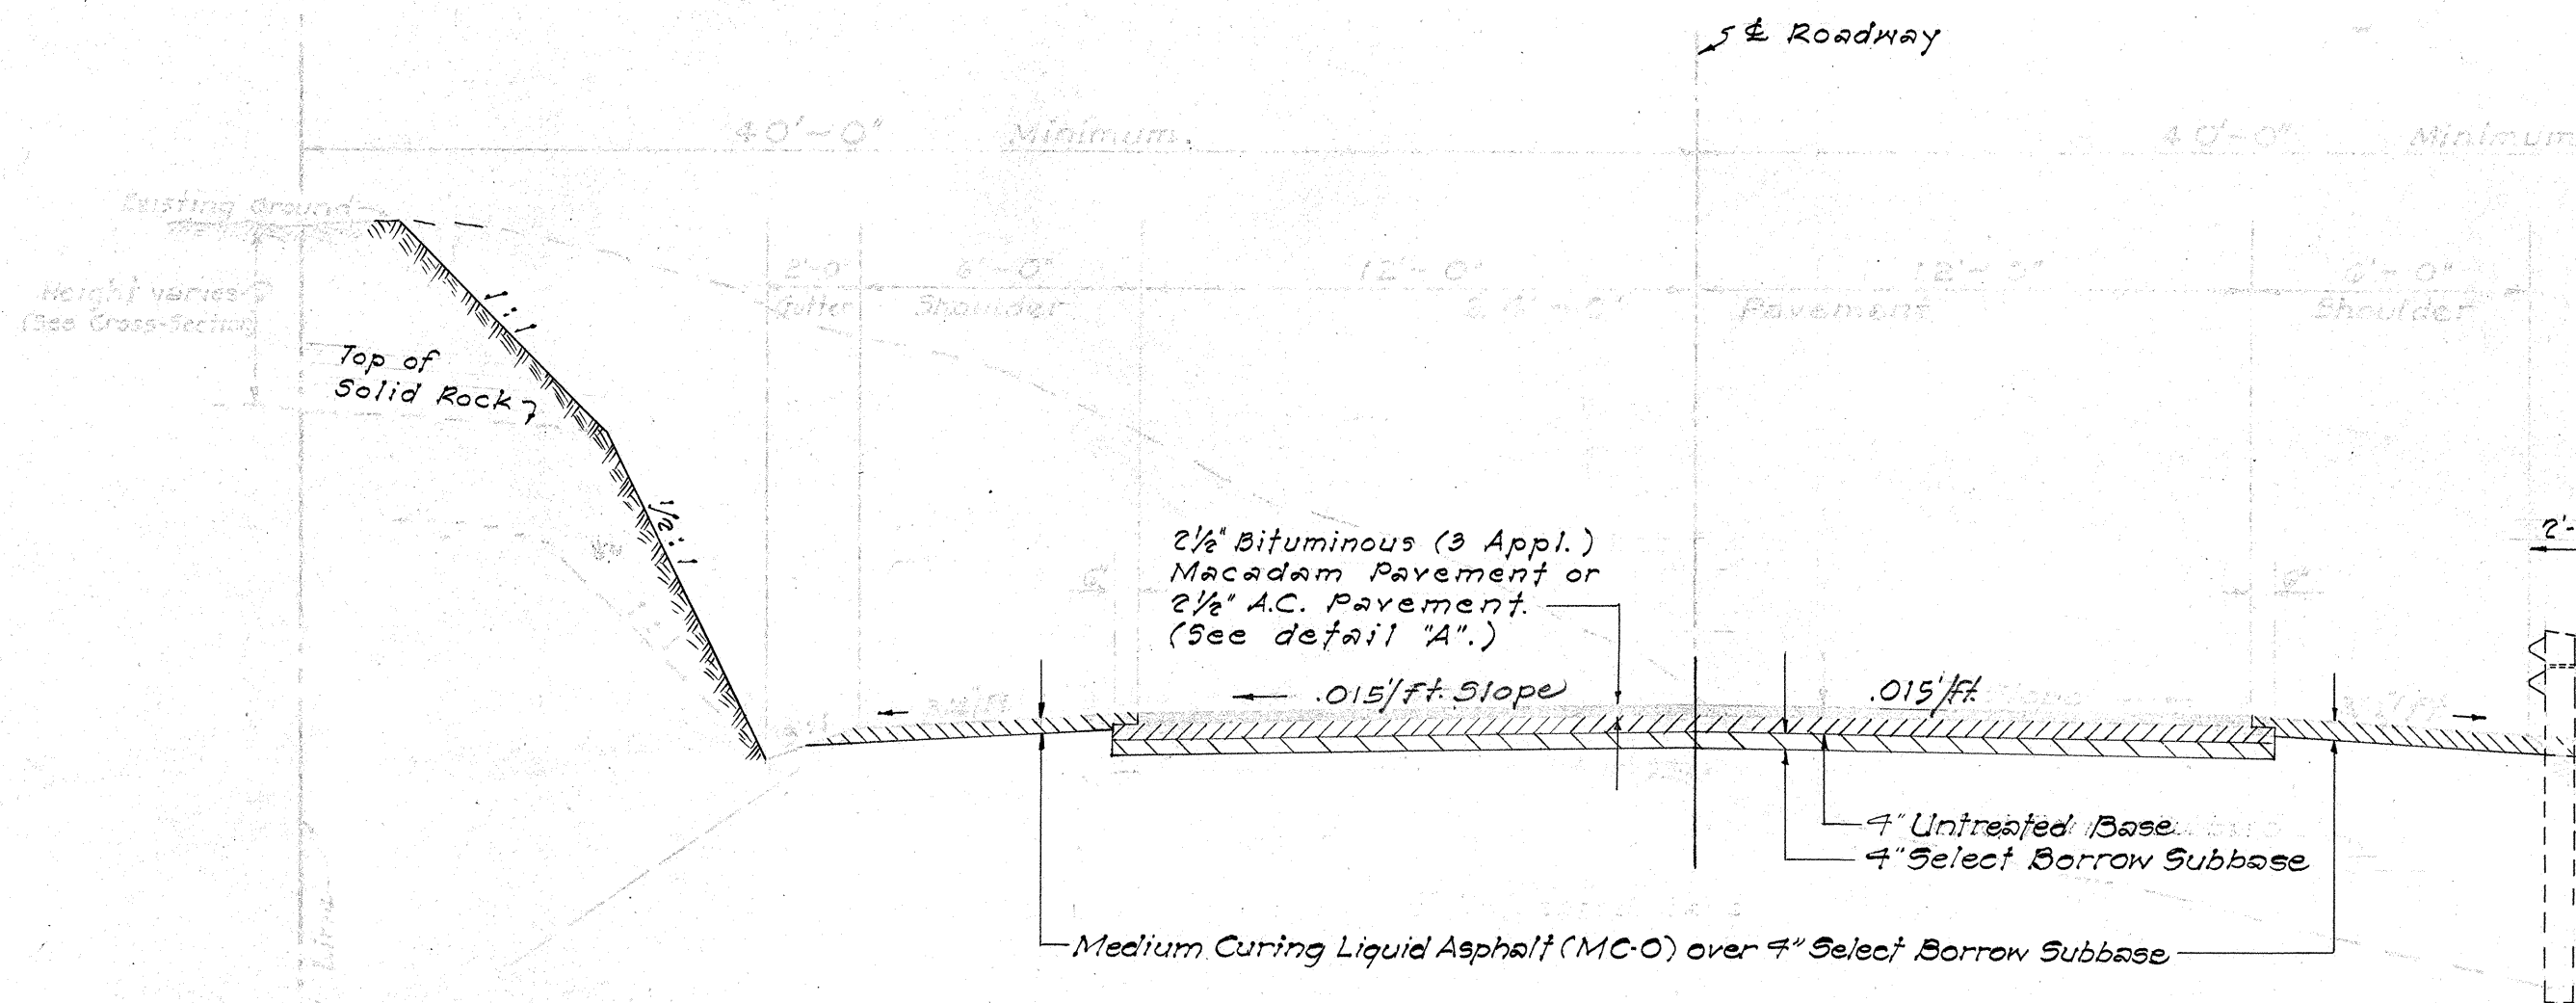

NOTE: Where Guard Rails or Reflector Markers are to be constructed, shoulders shall be widened 2 feet in all cases.


- NOTE:
1. Cut Slope varies. See Cross Sections.
 2. Cut Slope shall be finished in accordance with Class 'B' Excavation.

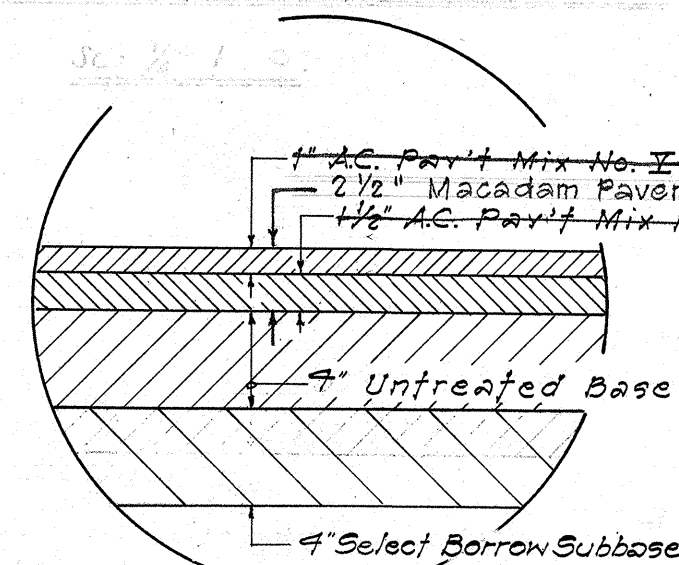

DETAIL 'A'
Scale: 1 1/2" = 1'-0"

- NOTE:
1. Fill slopes shall be flattened as per fill slope table with excess material where ordered by the Engineer.
 2. R/W requirements supersede above table.


Height of Fill	Fill Slope
0' to 4'	4:1
4' to 10'	3:1 to 2:1
10' to over	1 1/2:1

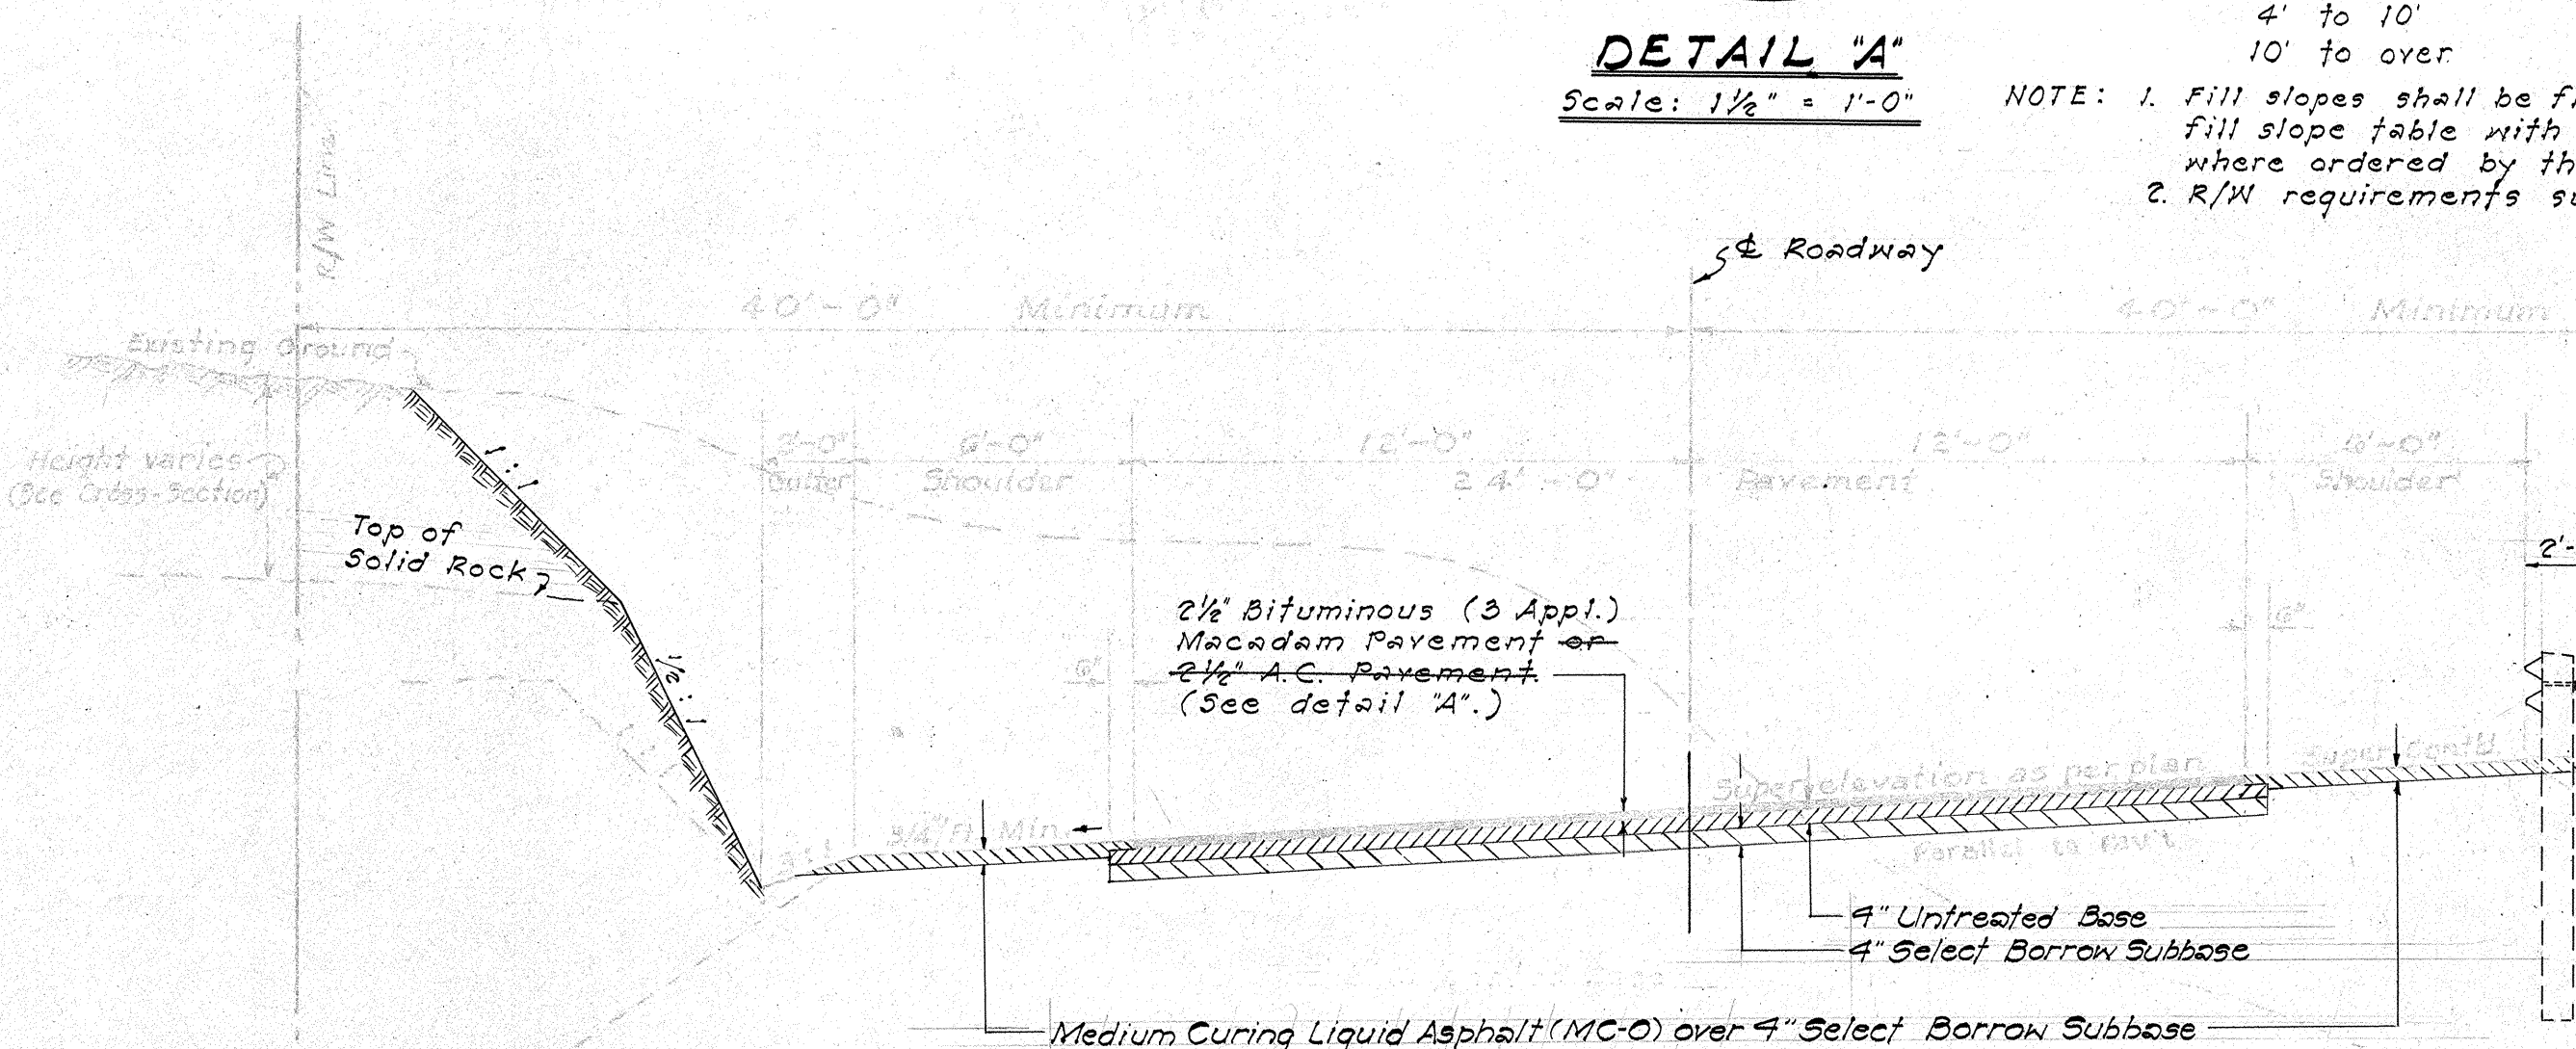


TYPICAL ROAD SECTION ON CURVE

GENERAL NOTES FOR CONSTRUCTION IDENTIFICATION SIGN


1. The Contractor shall construct, install, and maintain the Signs at the locations shown on the plans and as ordered by the Engineer.
2. All cost incurred in the construction, installing, and maintenance of the Signs will not be paid for separately, but shall be considered as included in the unit prices paid for the various items in the proposal.
3. The Signs shall be removed and stockpiled at the completion of the project as ordered by the Engineer and are to become State property.
4. The cost figure shall be furnished the Contractor at his request.

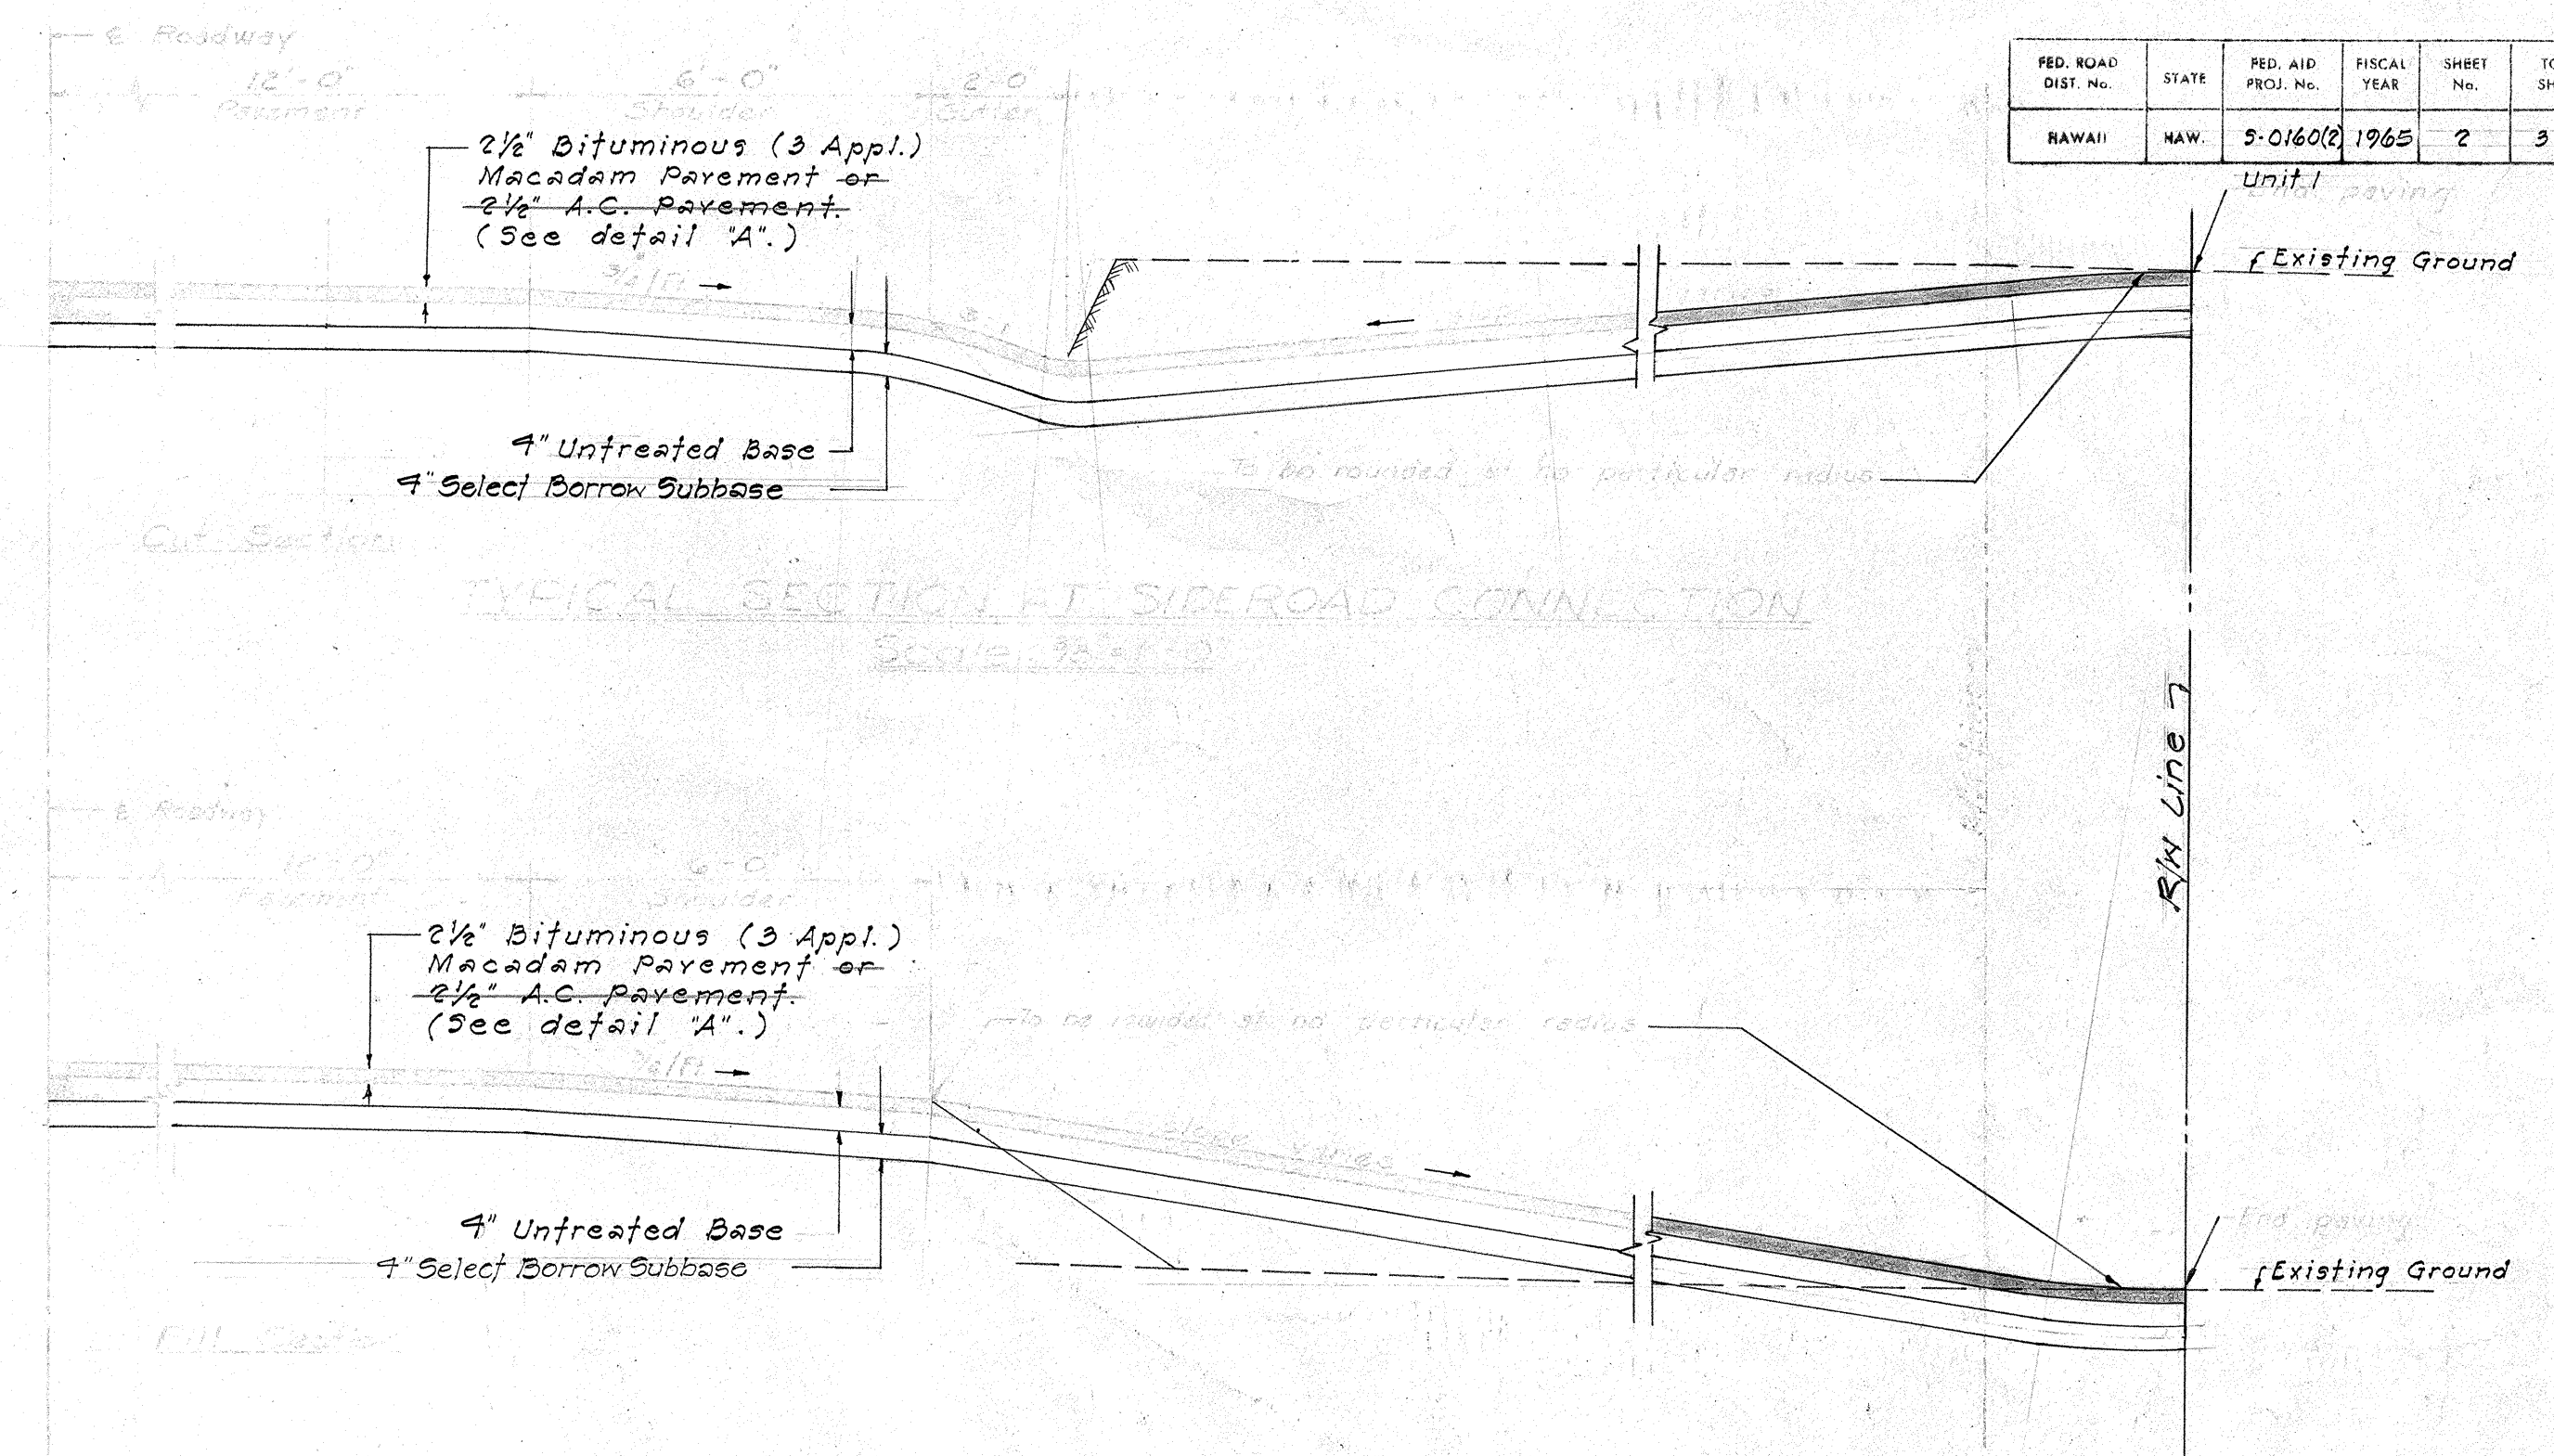


TYPICAL SECTION AT SIDEROAD CONNECTION
Scale: 1 1/2" = 1'-0"

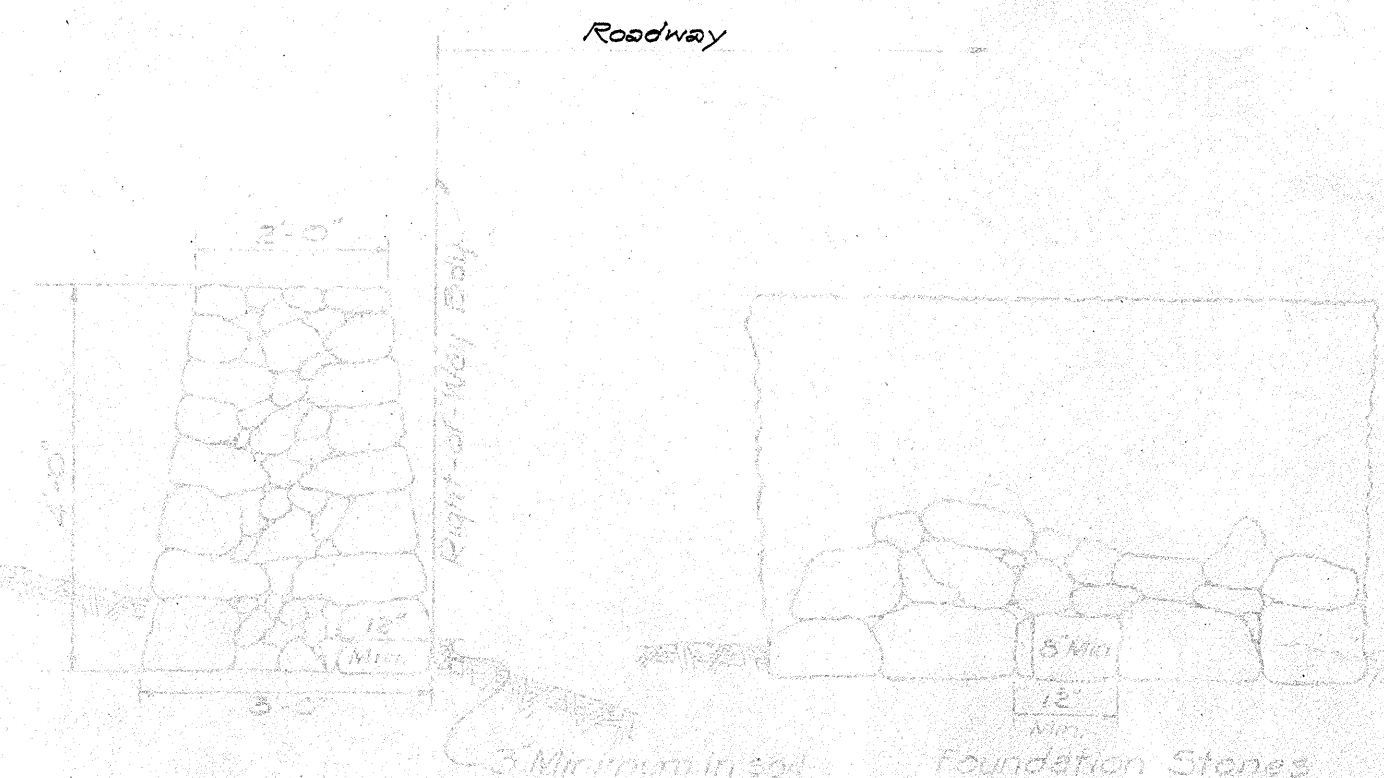


DETAIL OF RECONSTRUCTED STONEWALL FENCE
Scale: 1/2" = 1'-0"

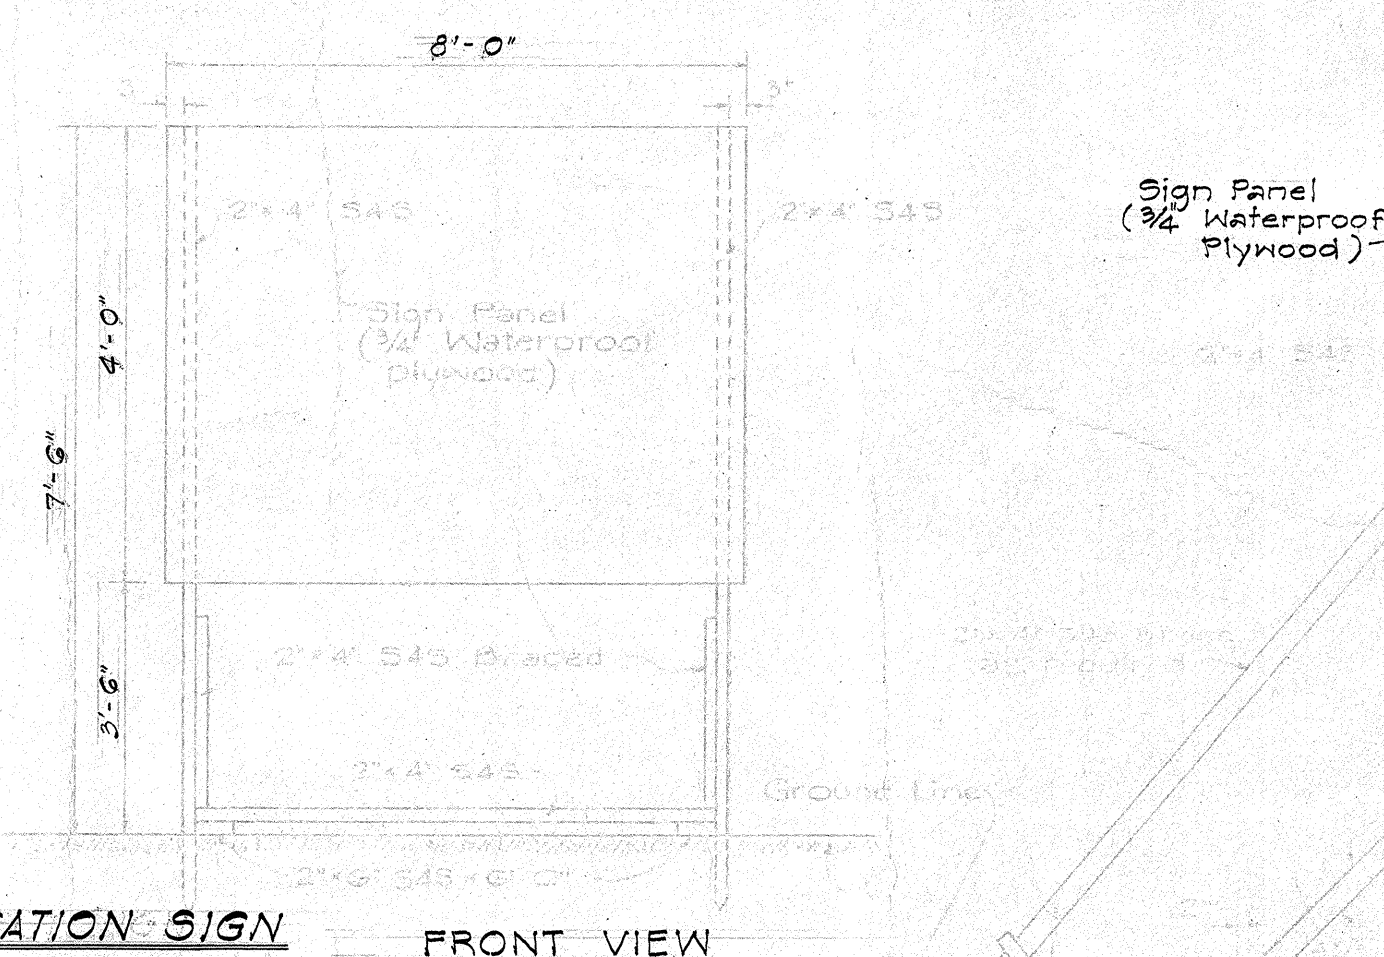

FRONT VIEW

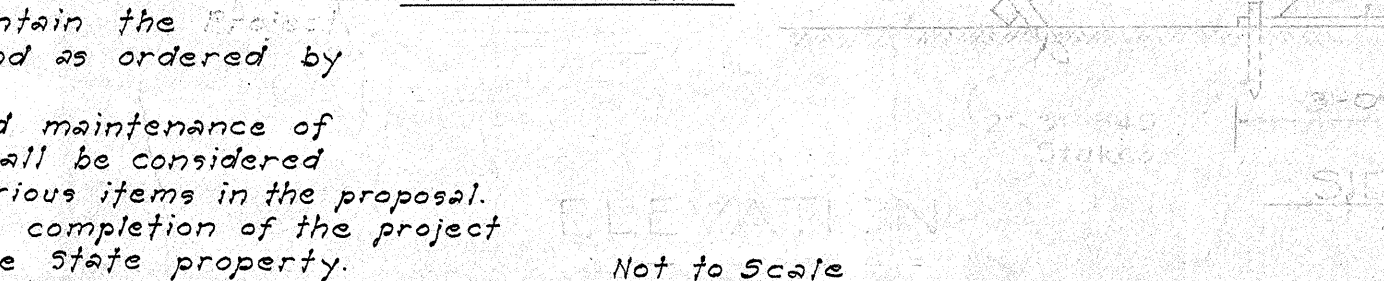


Not to Scale

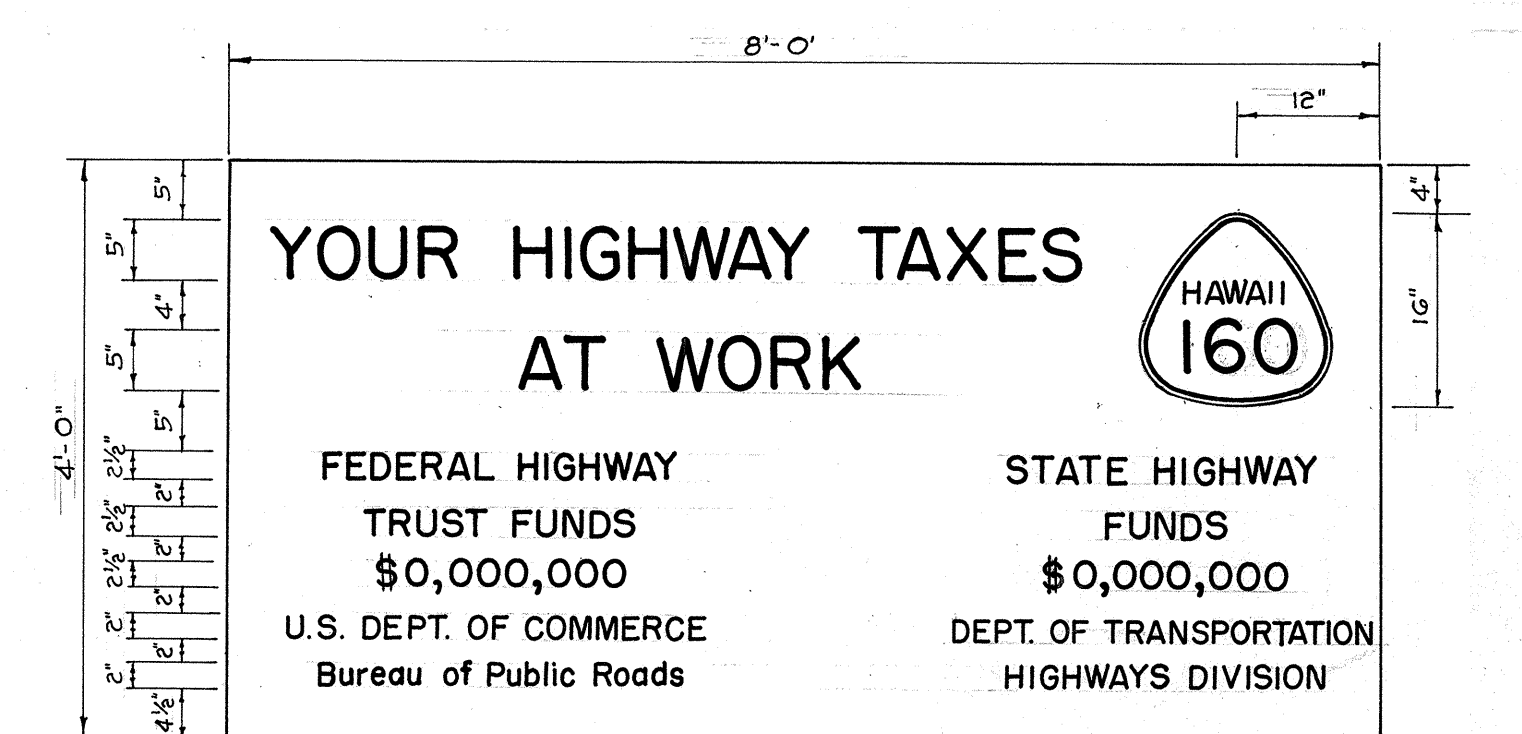

PLAN
CONSTRUCTION IDENTIFICATION SIGN
Not to Scale

- NOTE:
1. The locations of the Construction Identification Signs shown on the plans are approximate only. The Engineer shall determine the exact locations in the field.
 2. The legend shall be black letters on white background.
 3. The letters shall be of Series 'D' size and design, and shall conform with "Standard Alphabets for Highway Signs" as set forth by the Public Roads Administration Federal Work Agency.

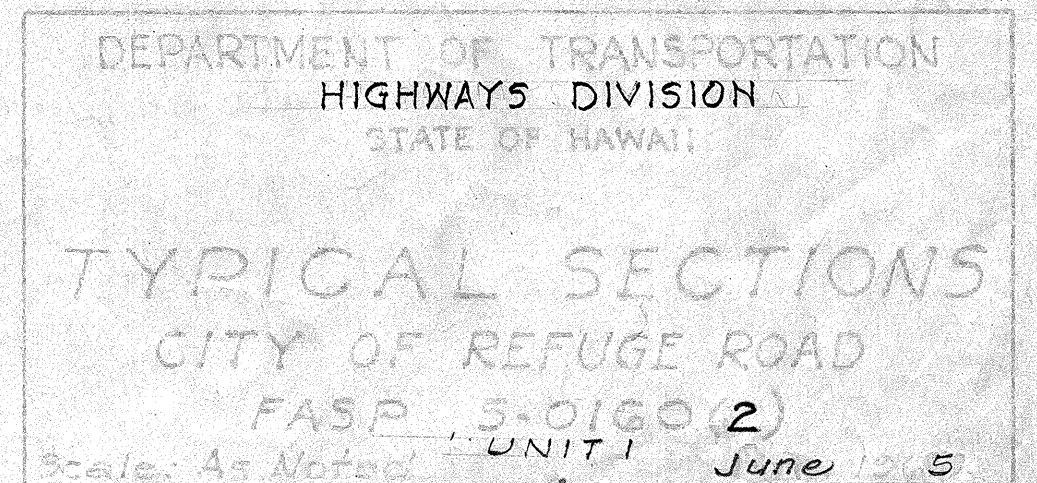

Scale: As Noted UNIT 1 June 1965