


FINAL SURVEY	BY	DATE
SURVEYED		
PLOTTED		
NOTE BOOK		
AREAS		
CHECKED		
NO.		

ORIGINAL SURVEY	BY	DATE
SURVEYED		
PLOTTED		
NOTE BOOK		
AREAS		
CHECKED		
NO.		


NO. AND NAME	PLAN	NO. AND NAME	PLAN	NO. AND NAME	PLAN	TOTAL SHEETS
1	PLAN	2	PLAN	3	PLAN	22

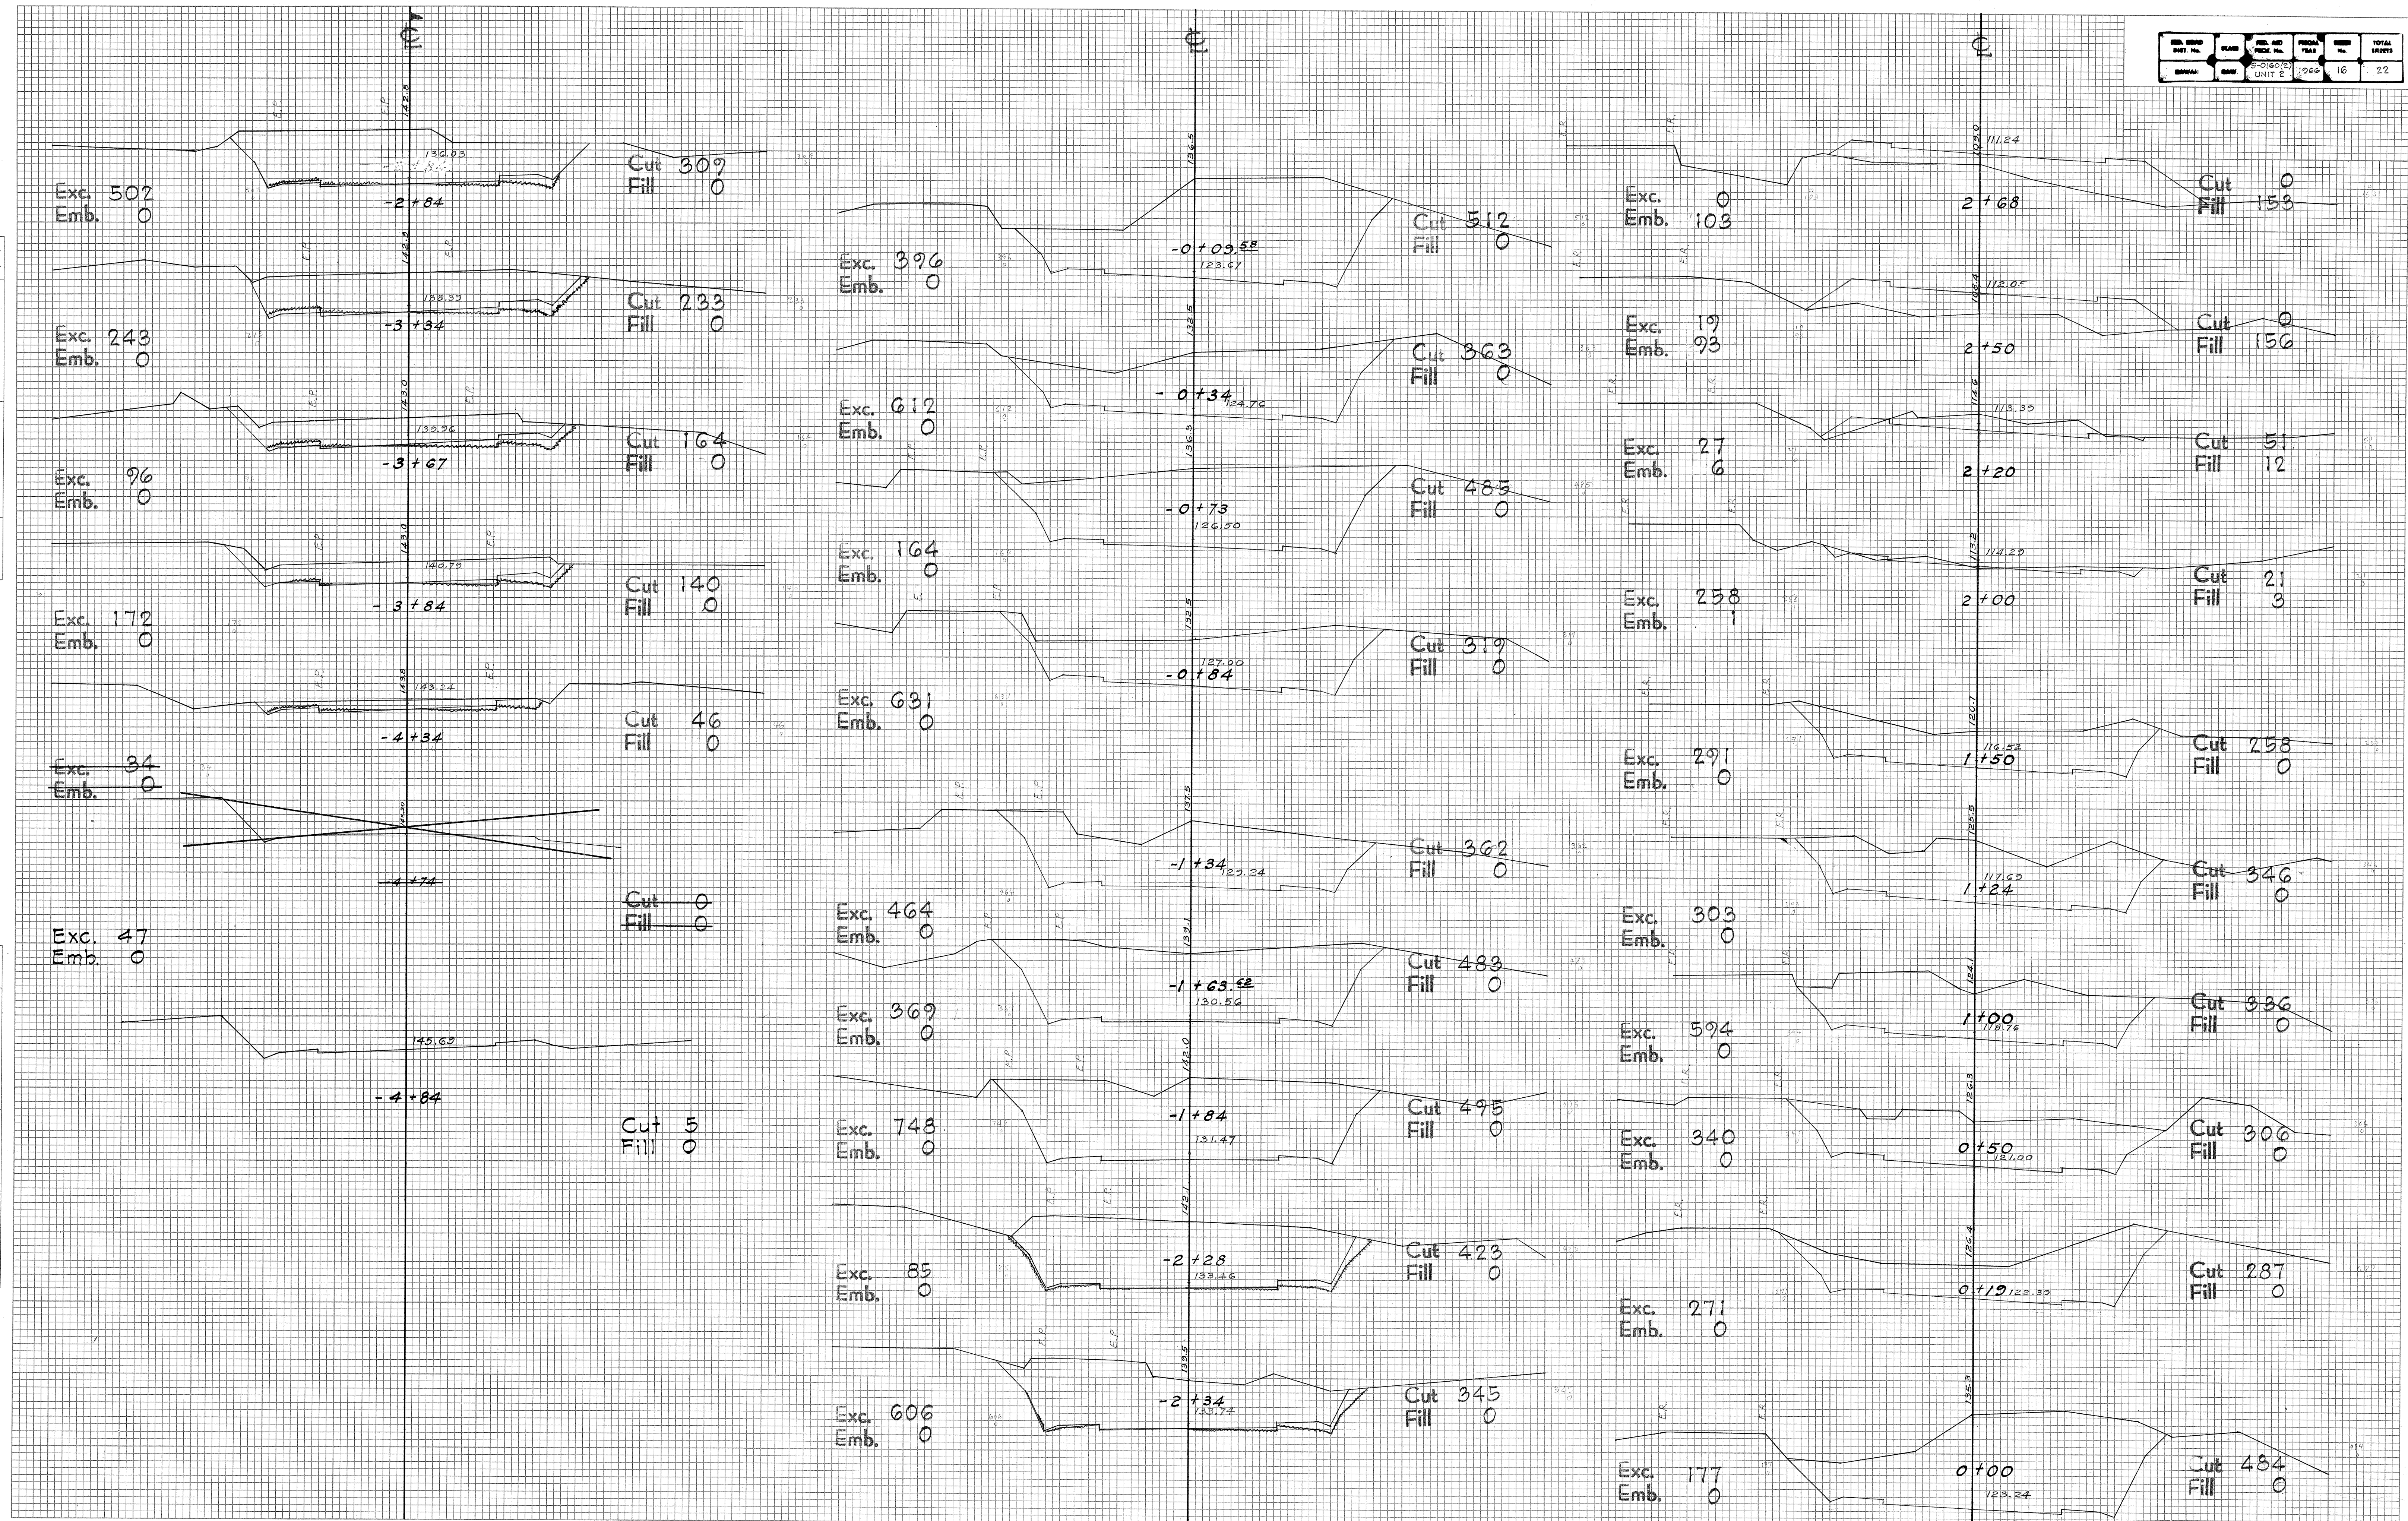

FED. ROAD DIST No.	STATE	FED. AID PROJ No.	FISCAL YEAR	SHEET No.	TOTAL SHEETS
SAWA	SAW	9-0160(2) UNIT 2	1966	17	22

FINAL SURVEY	BY	DATE
SURVED		
PLOTTED		
NOTE BOOK	EA	11/1/51
AREAS	1	11/1/51
AREAS CHECKED	40	11/1/51
NO.		


ORIGINAL SURVEY	SURVEYED _____	BY _____	DATE _____
NOTE BOOK	PLOTTED _____	<i>T.F.</i>	<i>7-8-63</i>
	TEMPLATE _____		
	AREAS _____		
NO. _____	AREAS CHECKED _____		

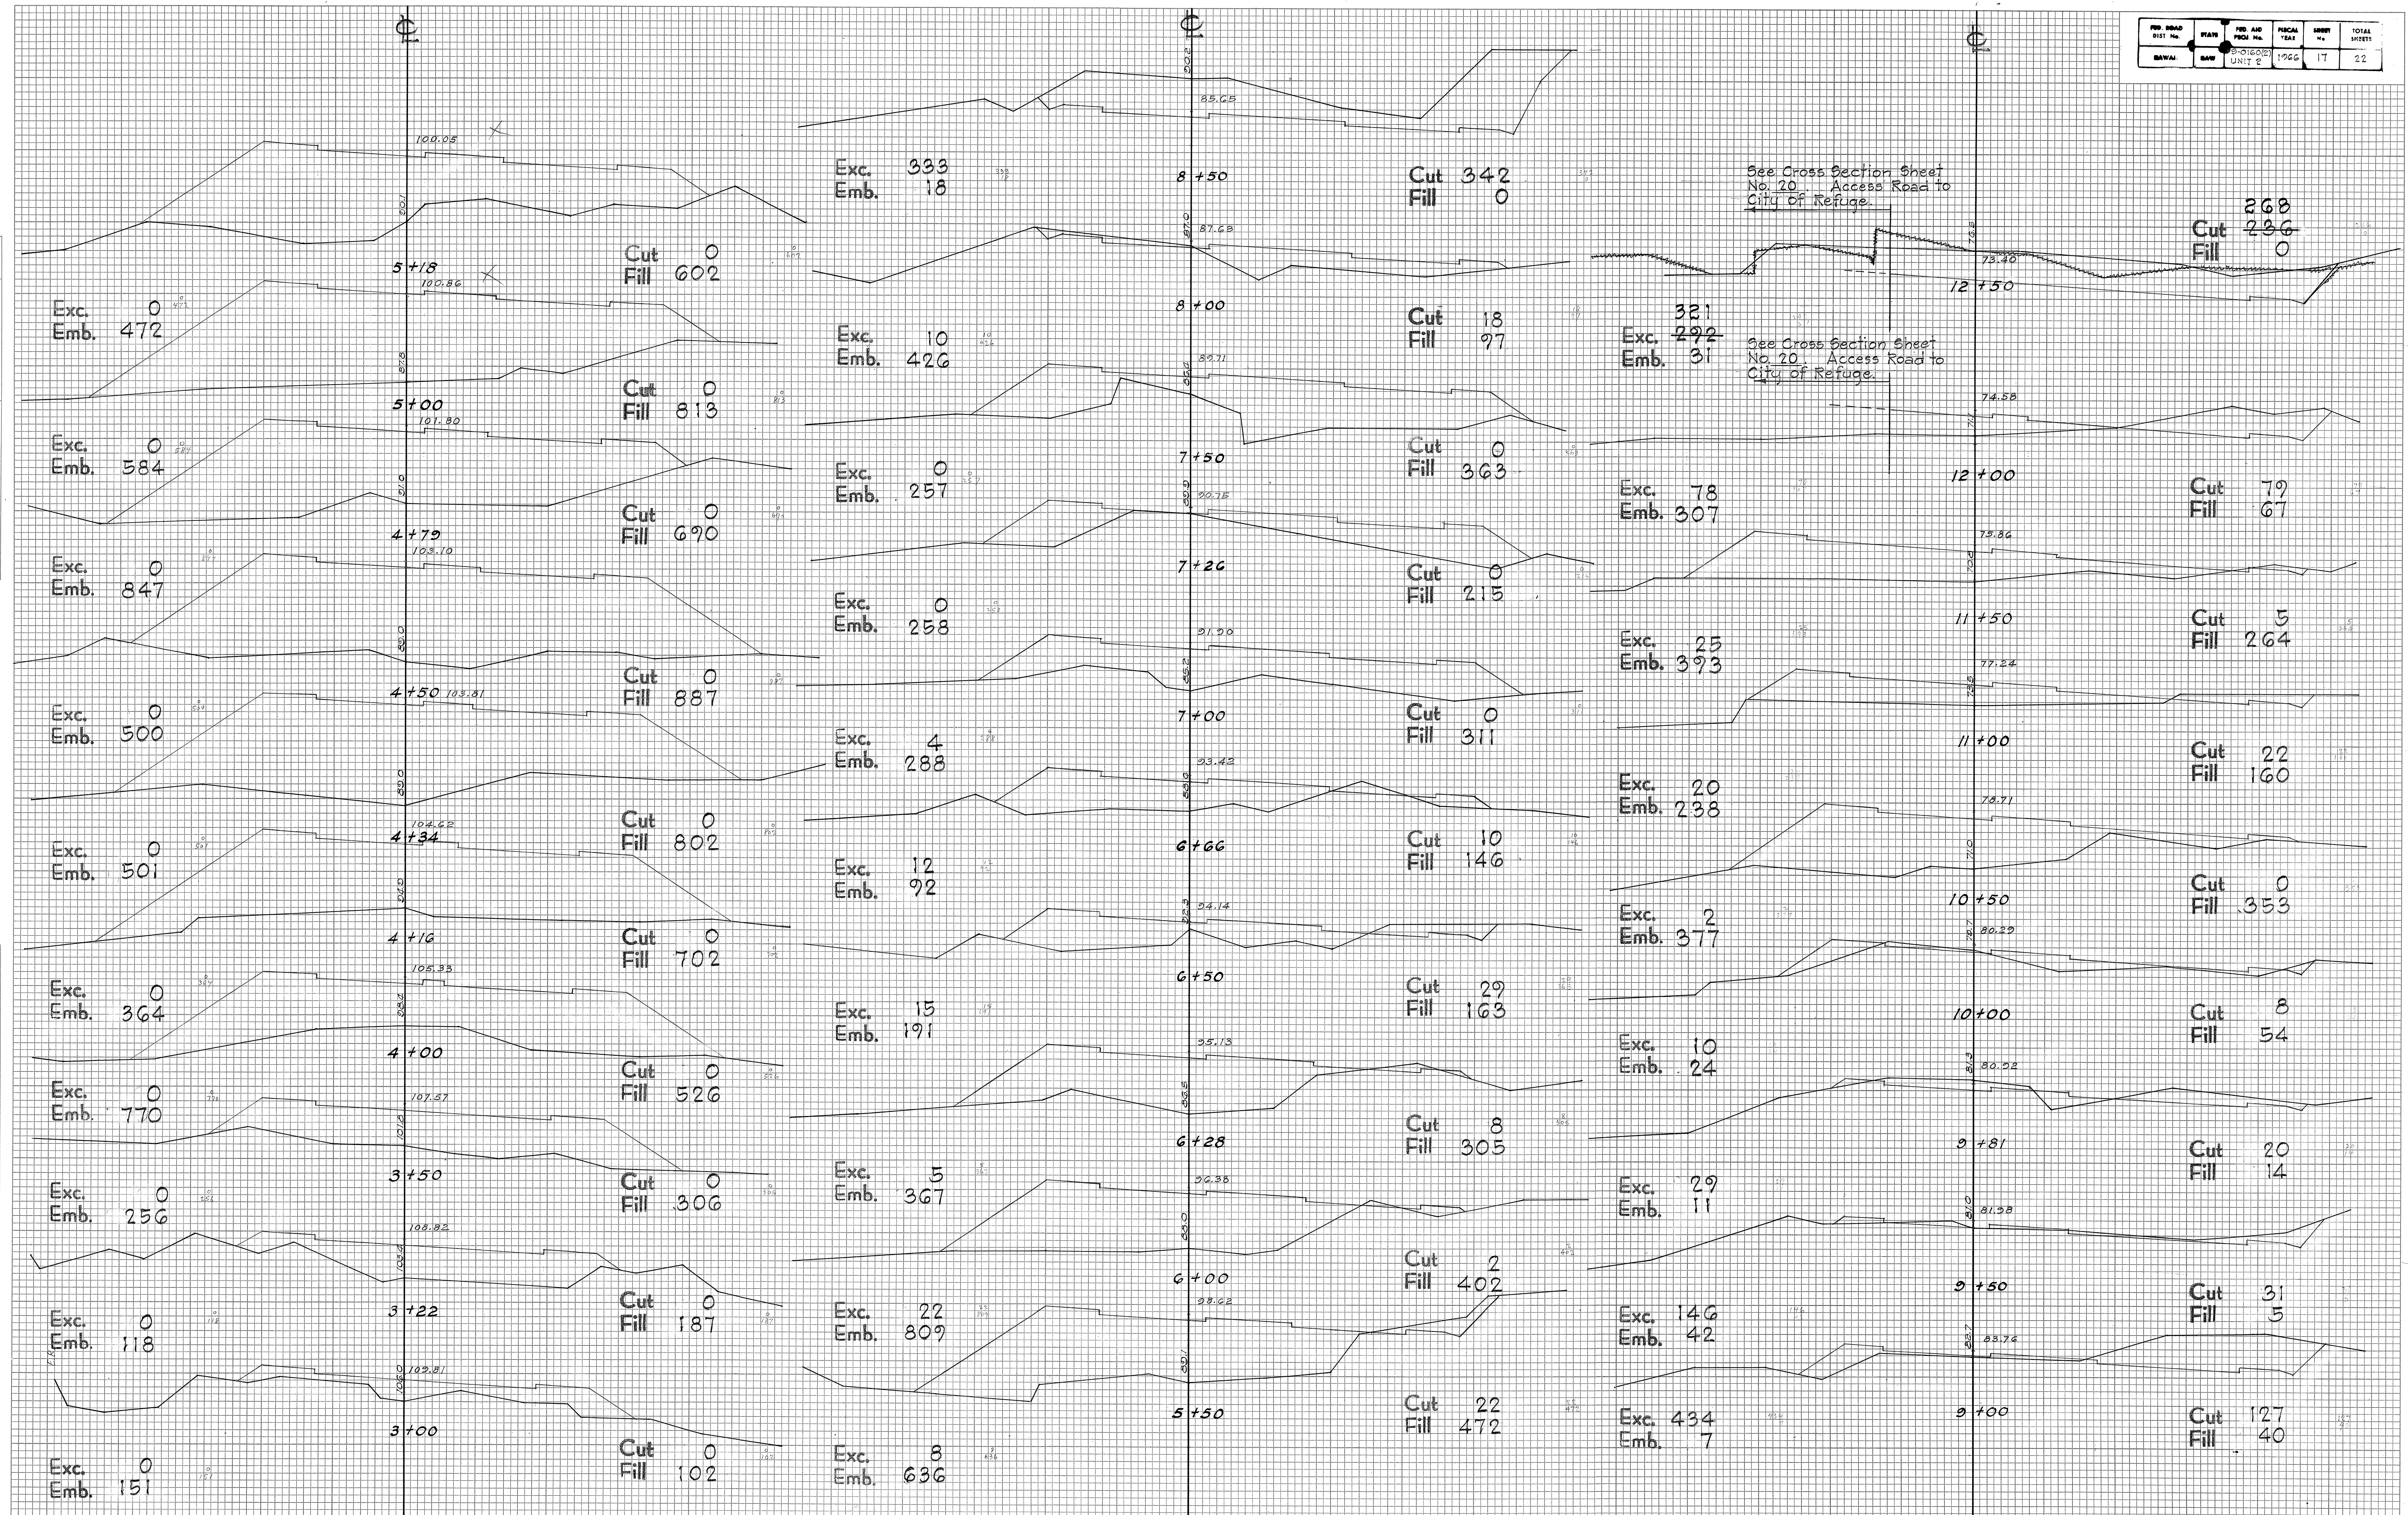

FED. ROAD DIST. NO.	STATE	FED. AID PROJ. NO.	FISCAL YEAR	SHEET NO.	TOTAL SHEETS
100	HA	100	1966	18	22

DATE	BY	SURVEYED	PLOTTED	NOTED	CHECKED
10/1/66	J. J.				
NO.					




DATE	BY	SURVEYED	PLOTTED	NOTED	CHECKED
10/1/66	T. E.				
NO.					

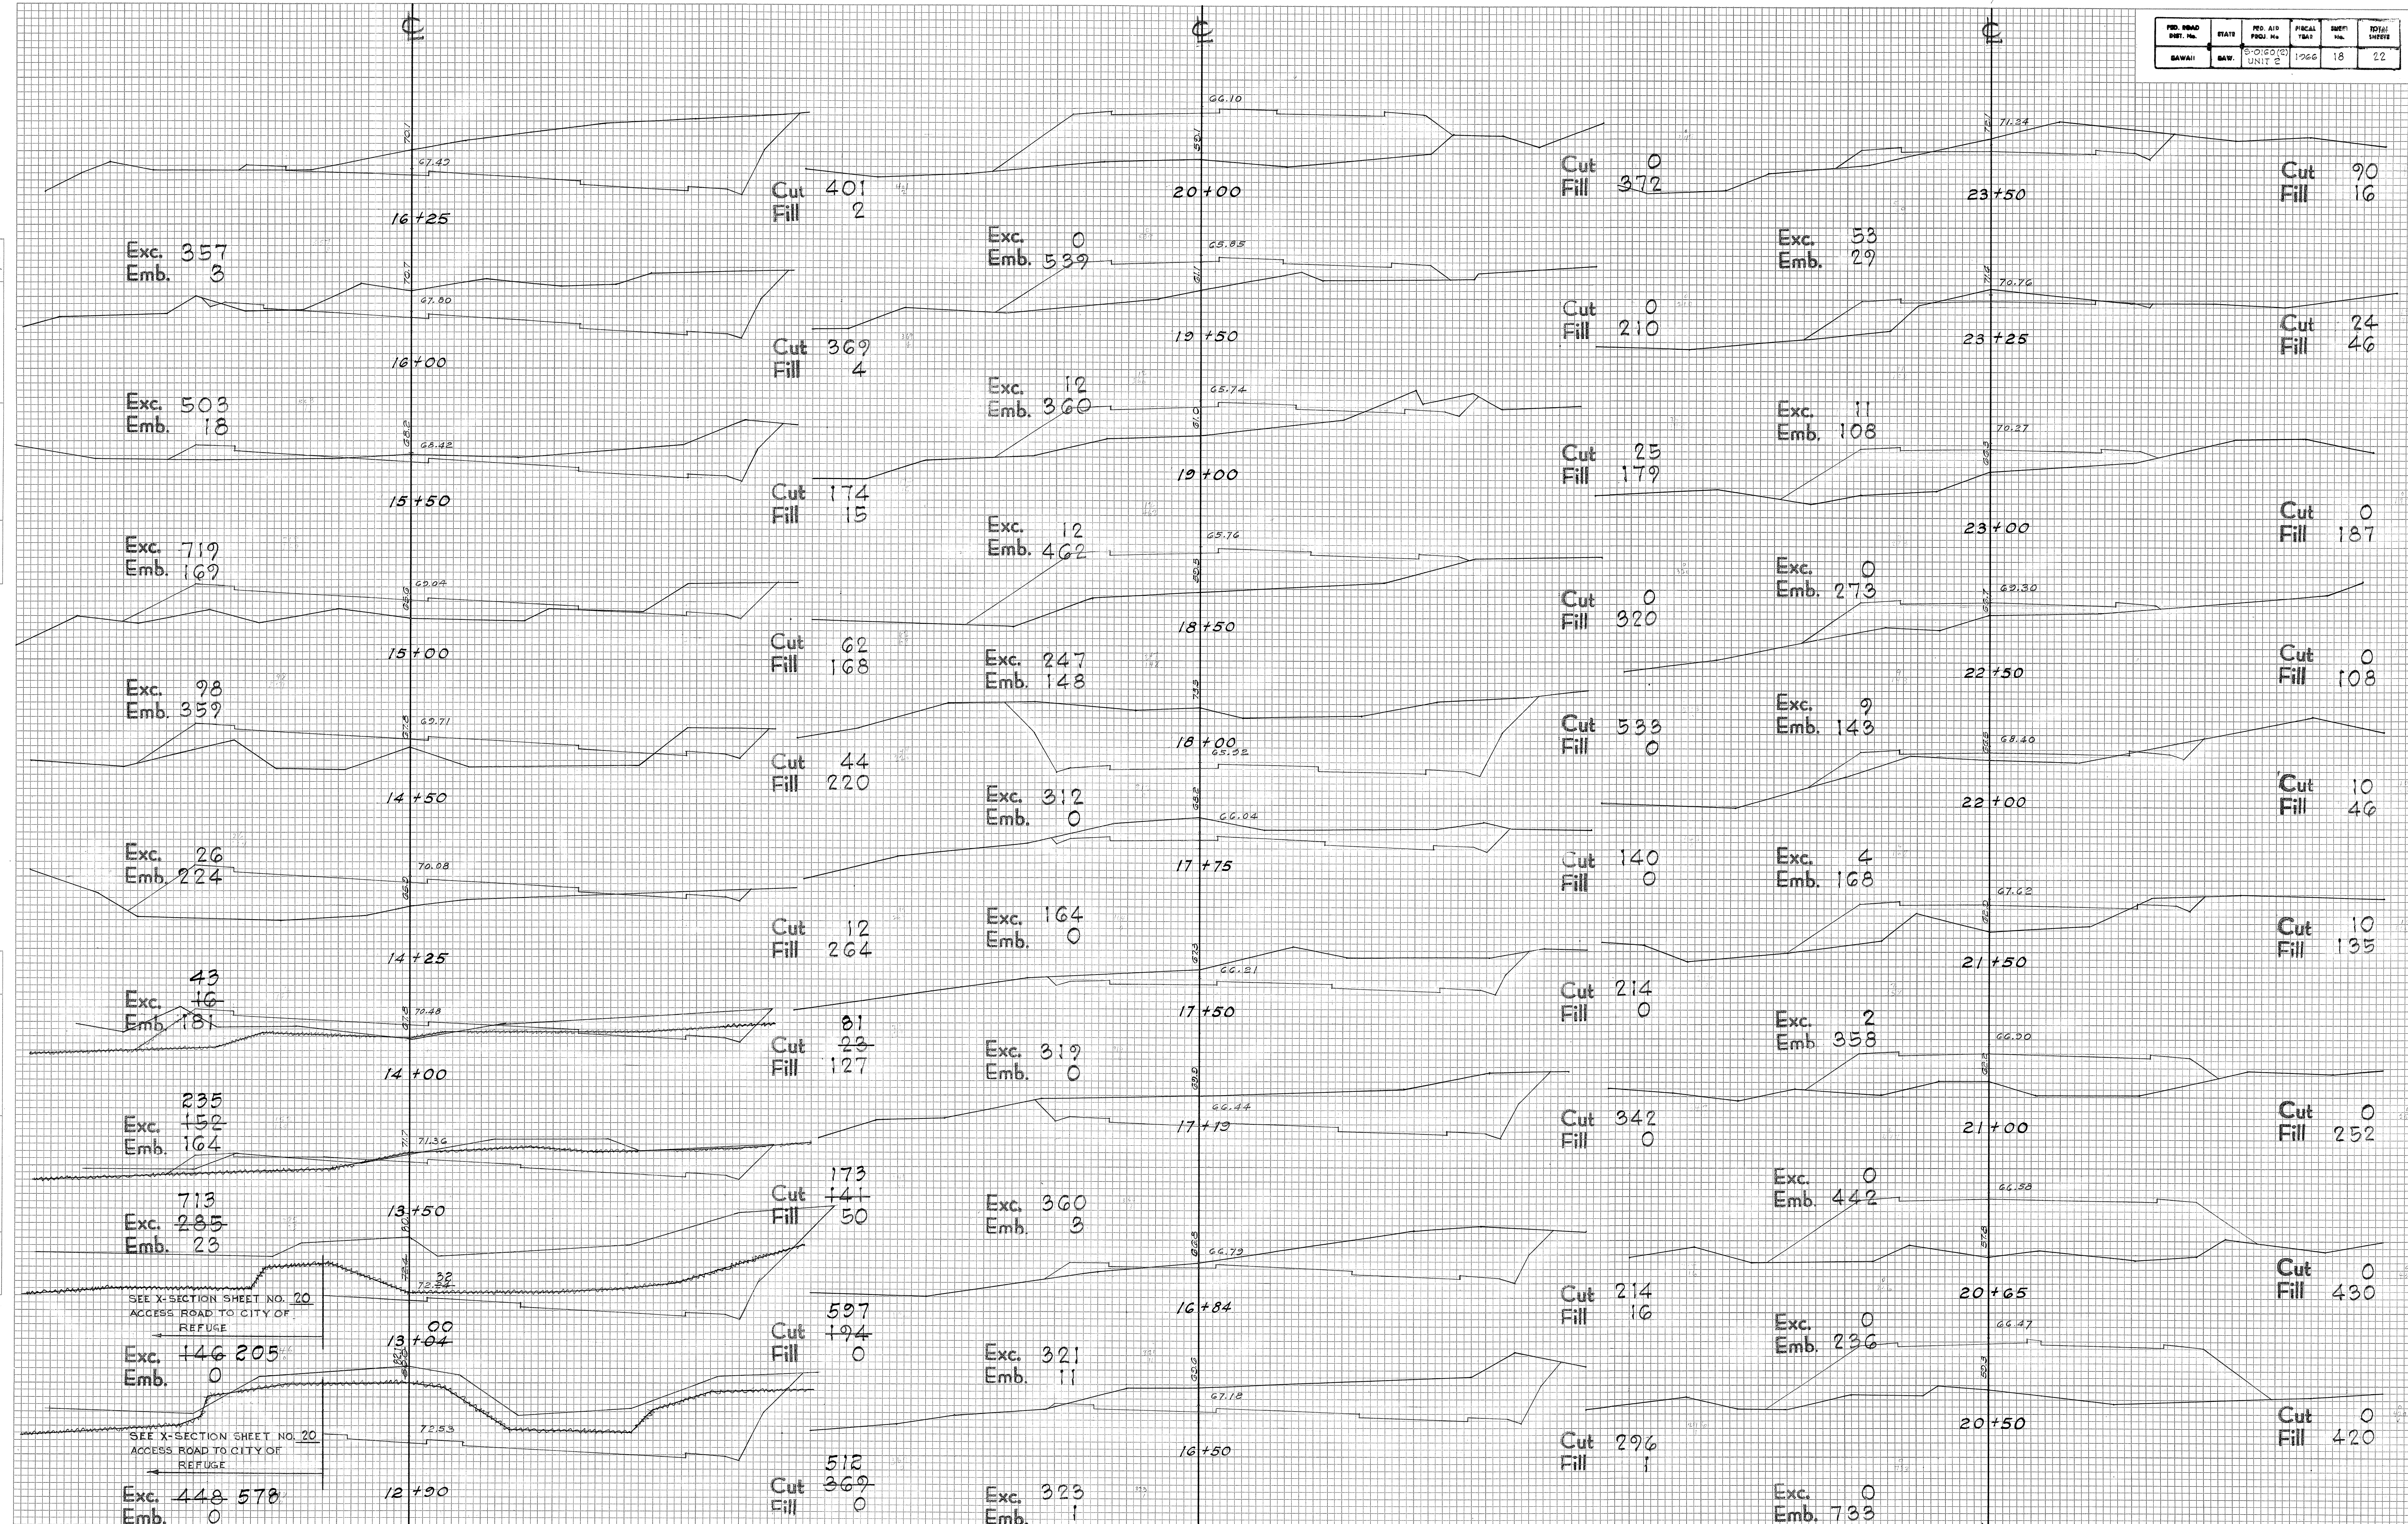

FINAL SURVEY	DATE	BY
SURVEYED		
PLOTTED		
NOTE BOOK		
AREAS CHECKED		
NO.		

ORIGINAL SURVEY	DATE	BY
SURVEYED		
PLOTTED		
NOTE BOOK		
AREAS CHECKED		
NO.		



PRO. ROAD DIST. No.	STATION	PRO. A/S PROJ. No.	FISCAL YEAR	SHEET No.	TOTAL SHEETS
BAWAI	BAW	5-0160(2) UNIT 2	1966	19	22

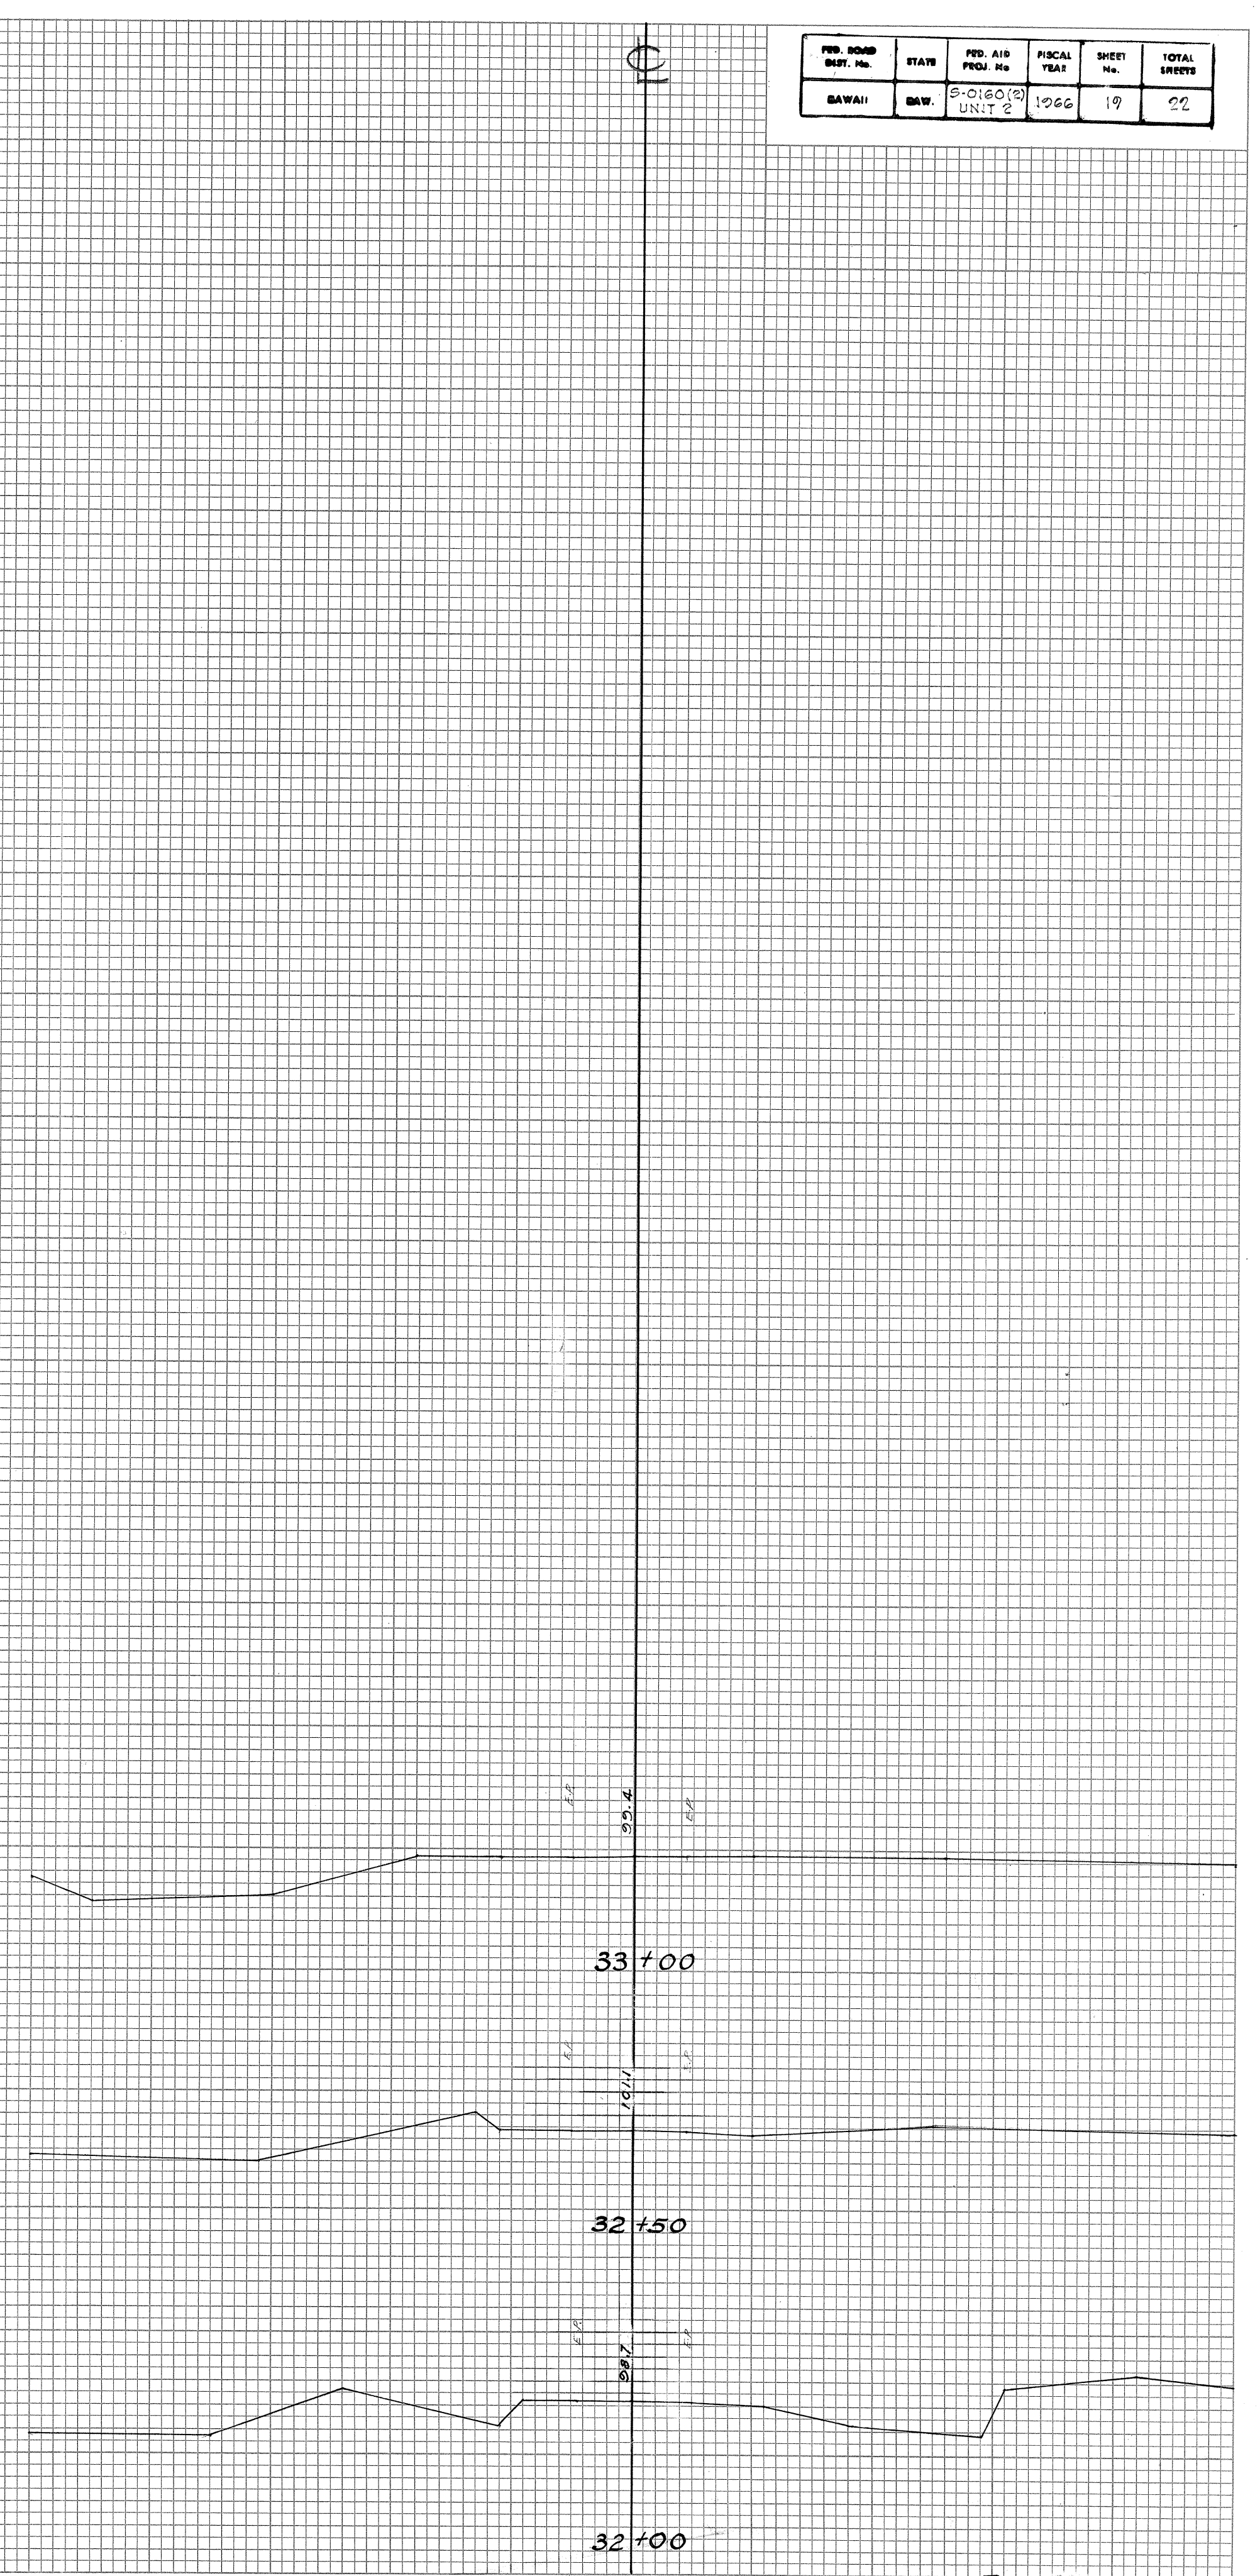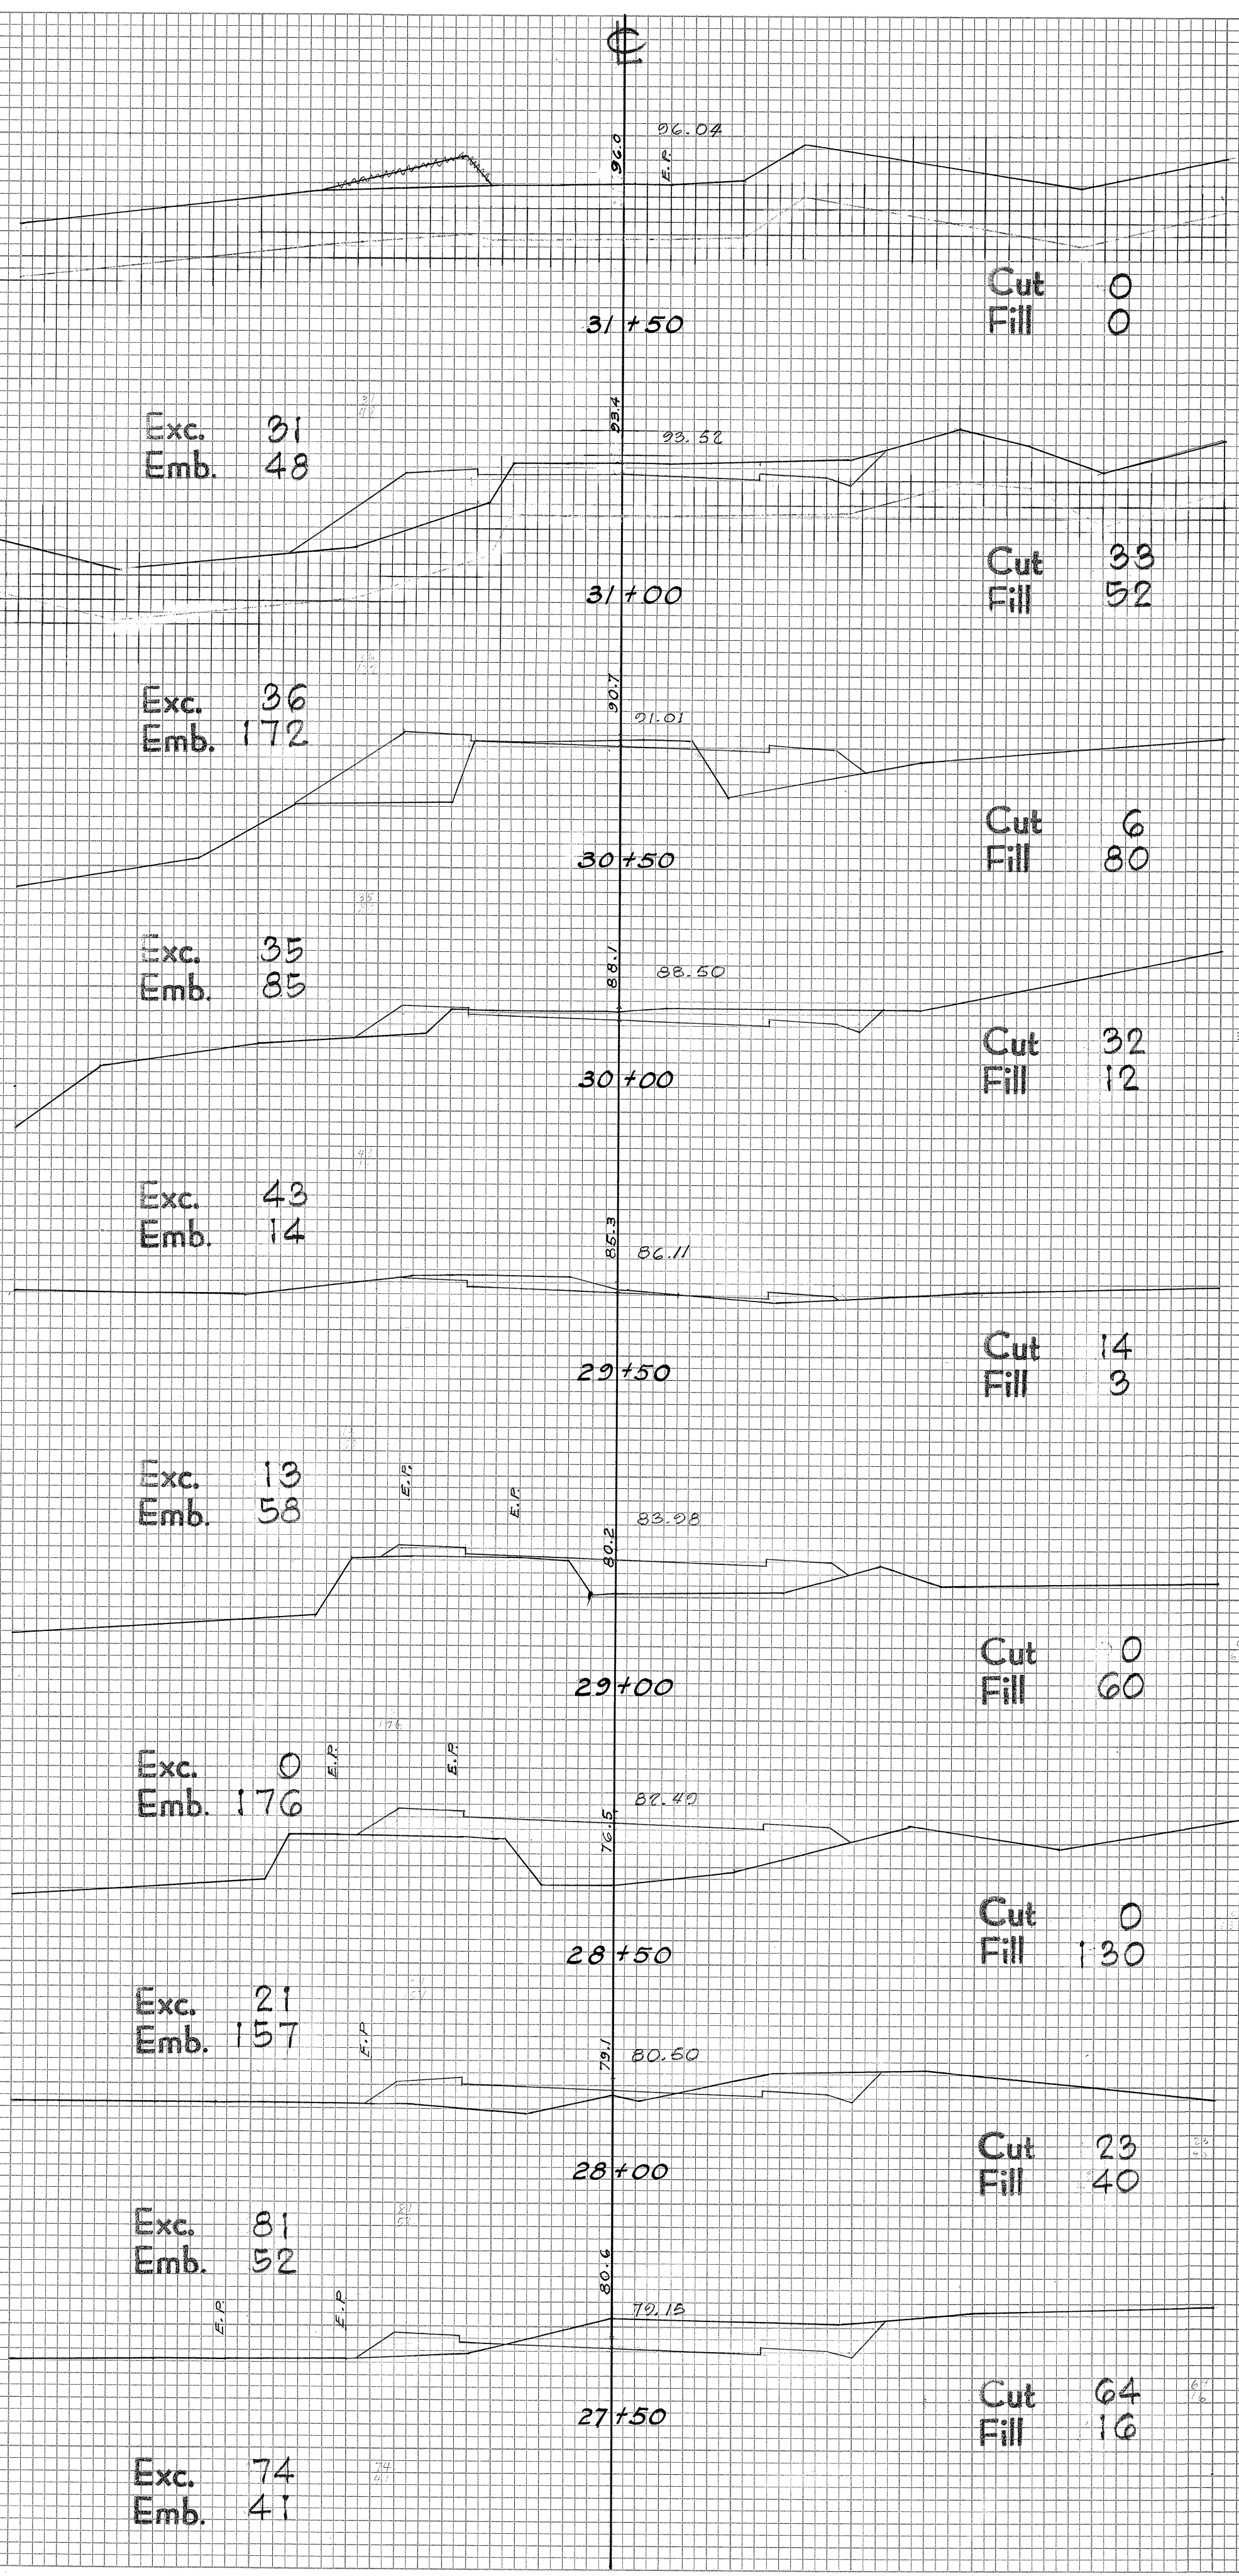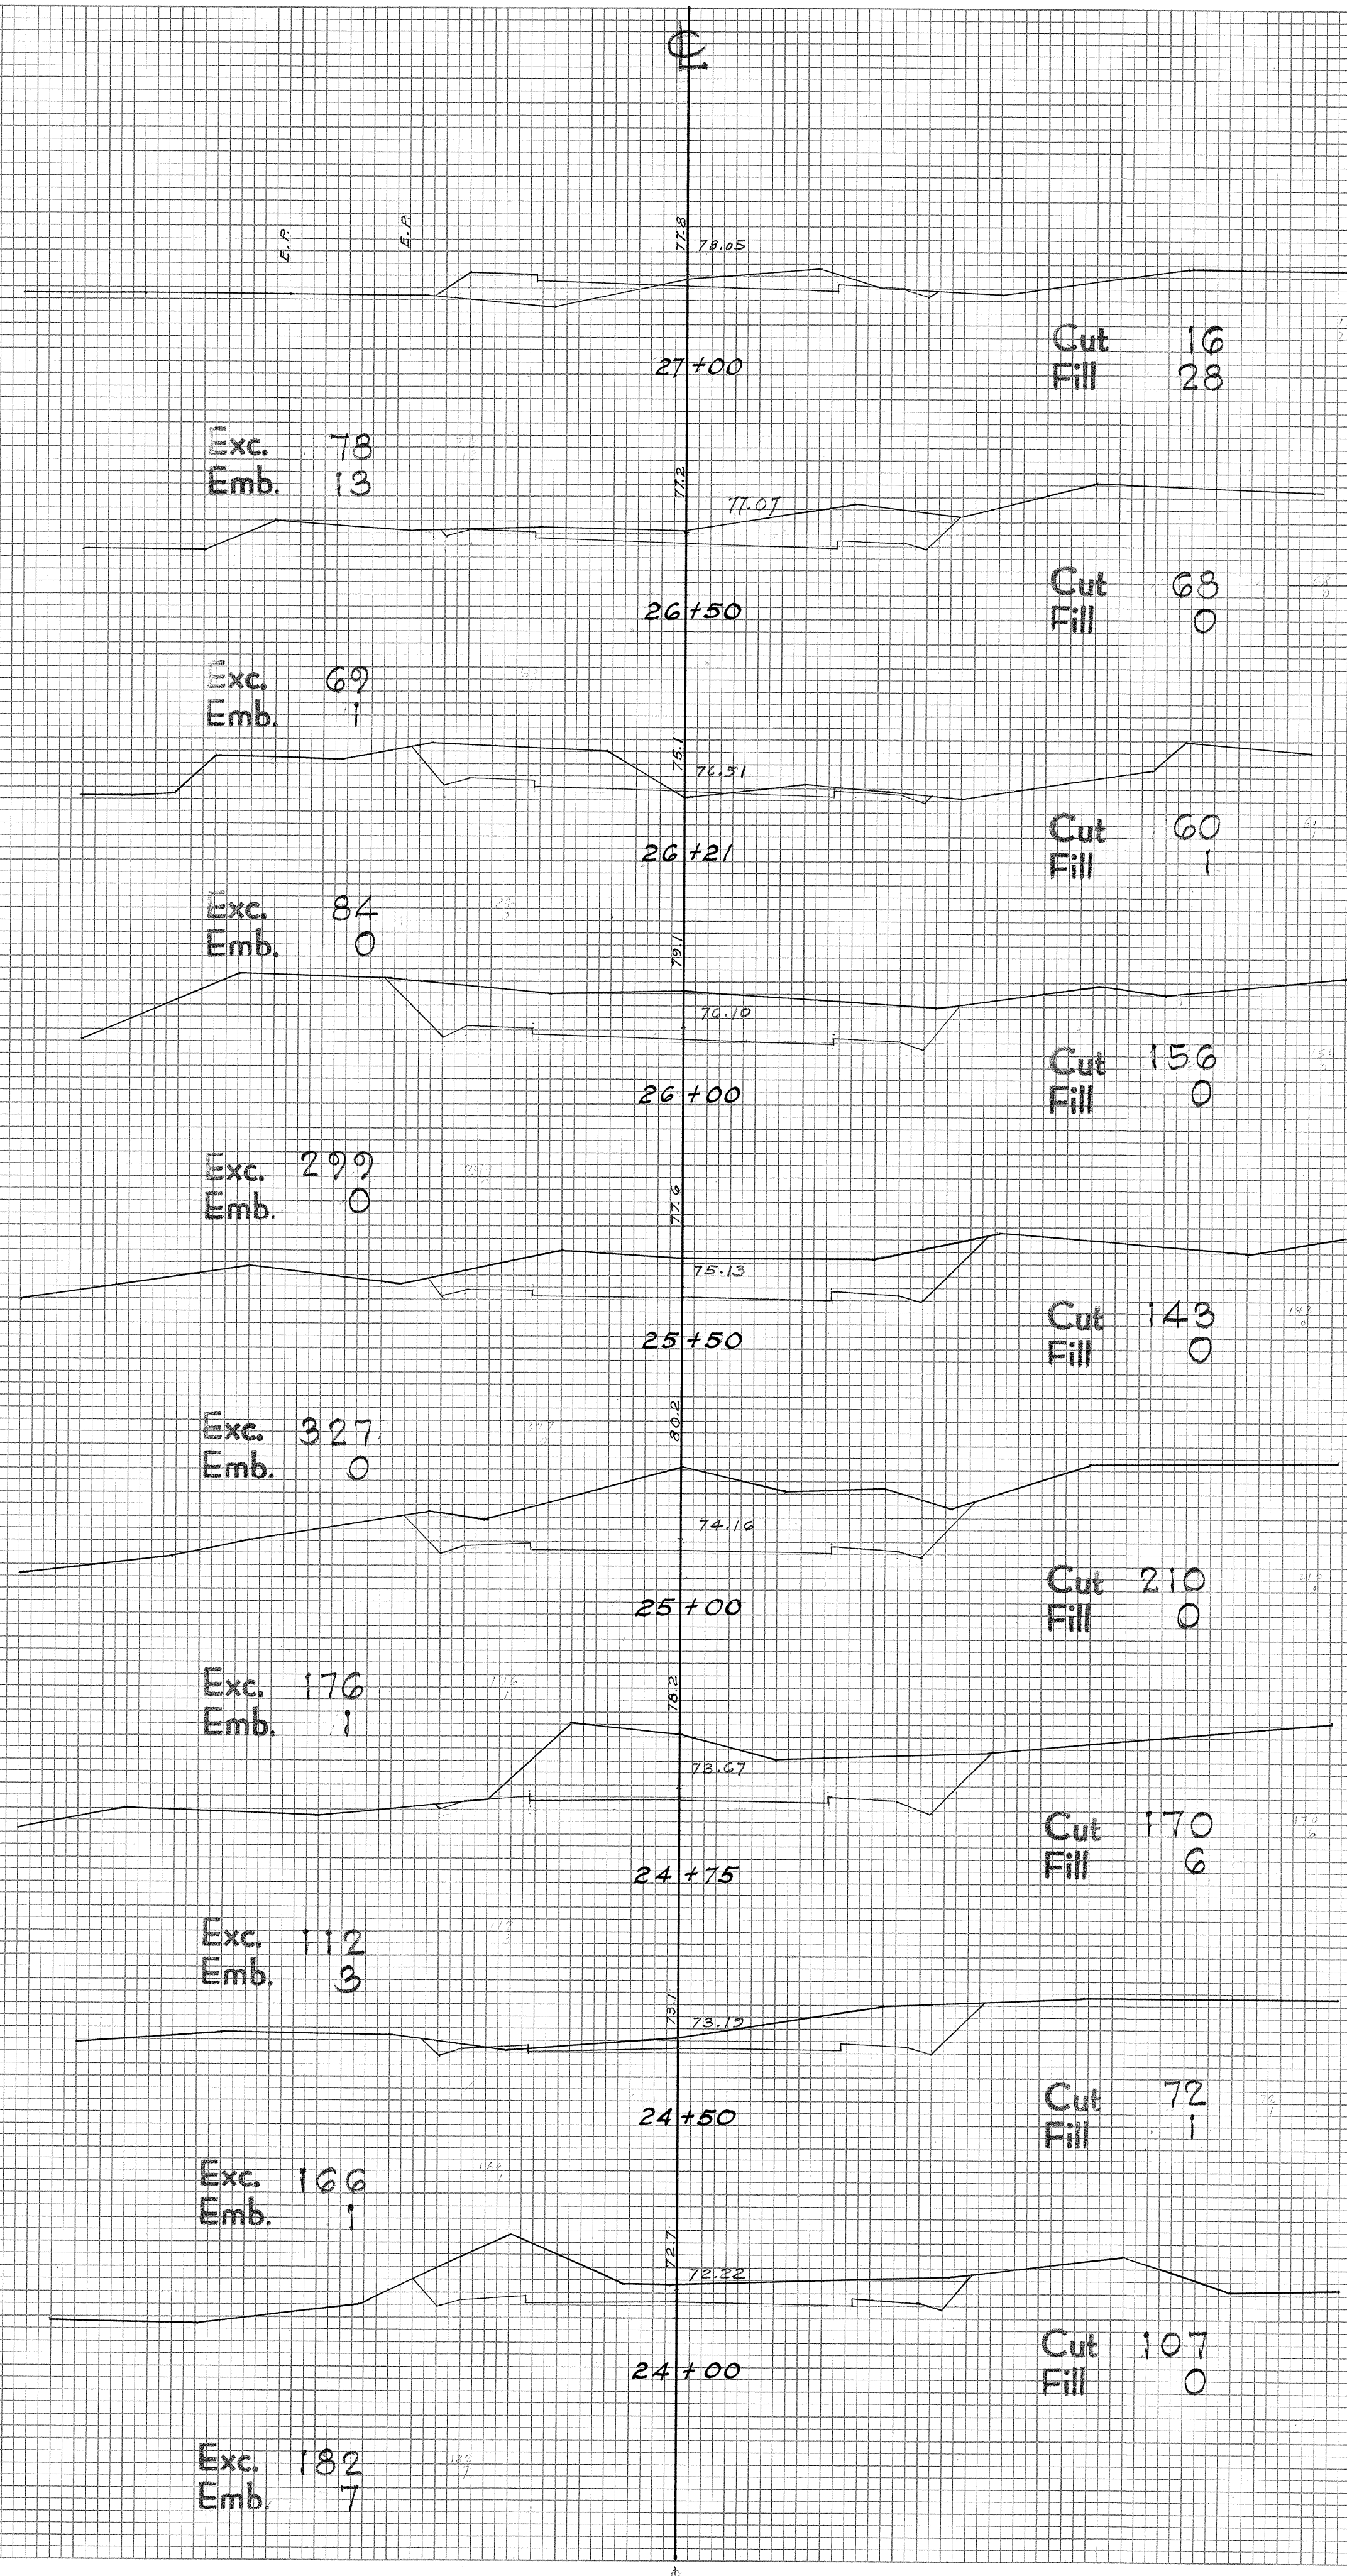

FINAL	SURVEY	DATE
NO.	BY	12/15/65
NOTE BOOK	PLOTTED	
AREAS CHECKED	DATE	

ORIGINAL	SURVEY	DATE
NO.	BY	
NOTE BOOK	PLOTTED	
AREAS CHECKED	DATE	

PRO. ROAD	STATE	PRO. AID	FISCAL	SHEET	TOTAL
DI. No.	NO.	NO.	YEAR	No.	SHEETS
SAVAH	SAV.	57012000	1966	20	22
		UNIT 2			

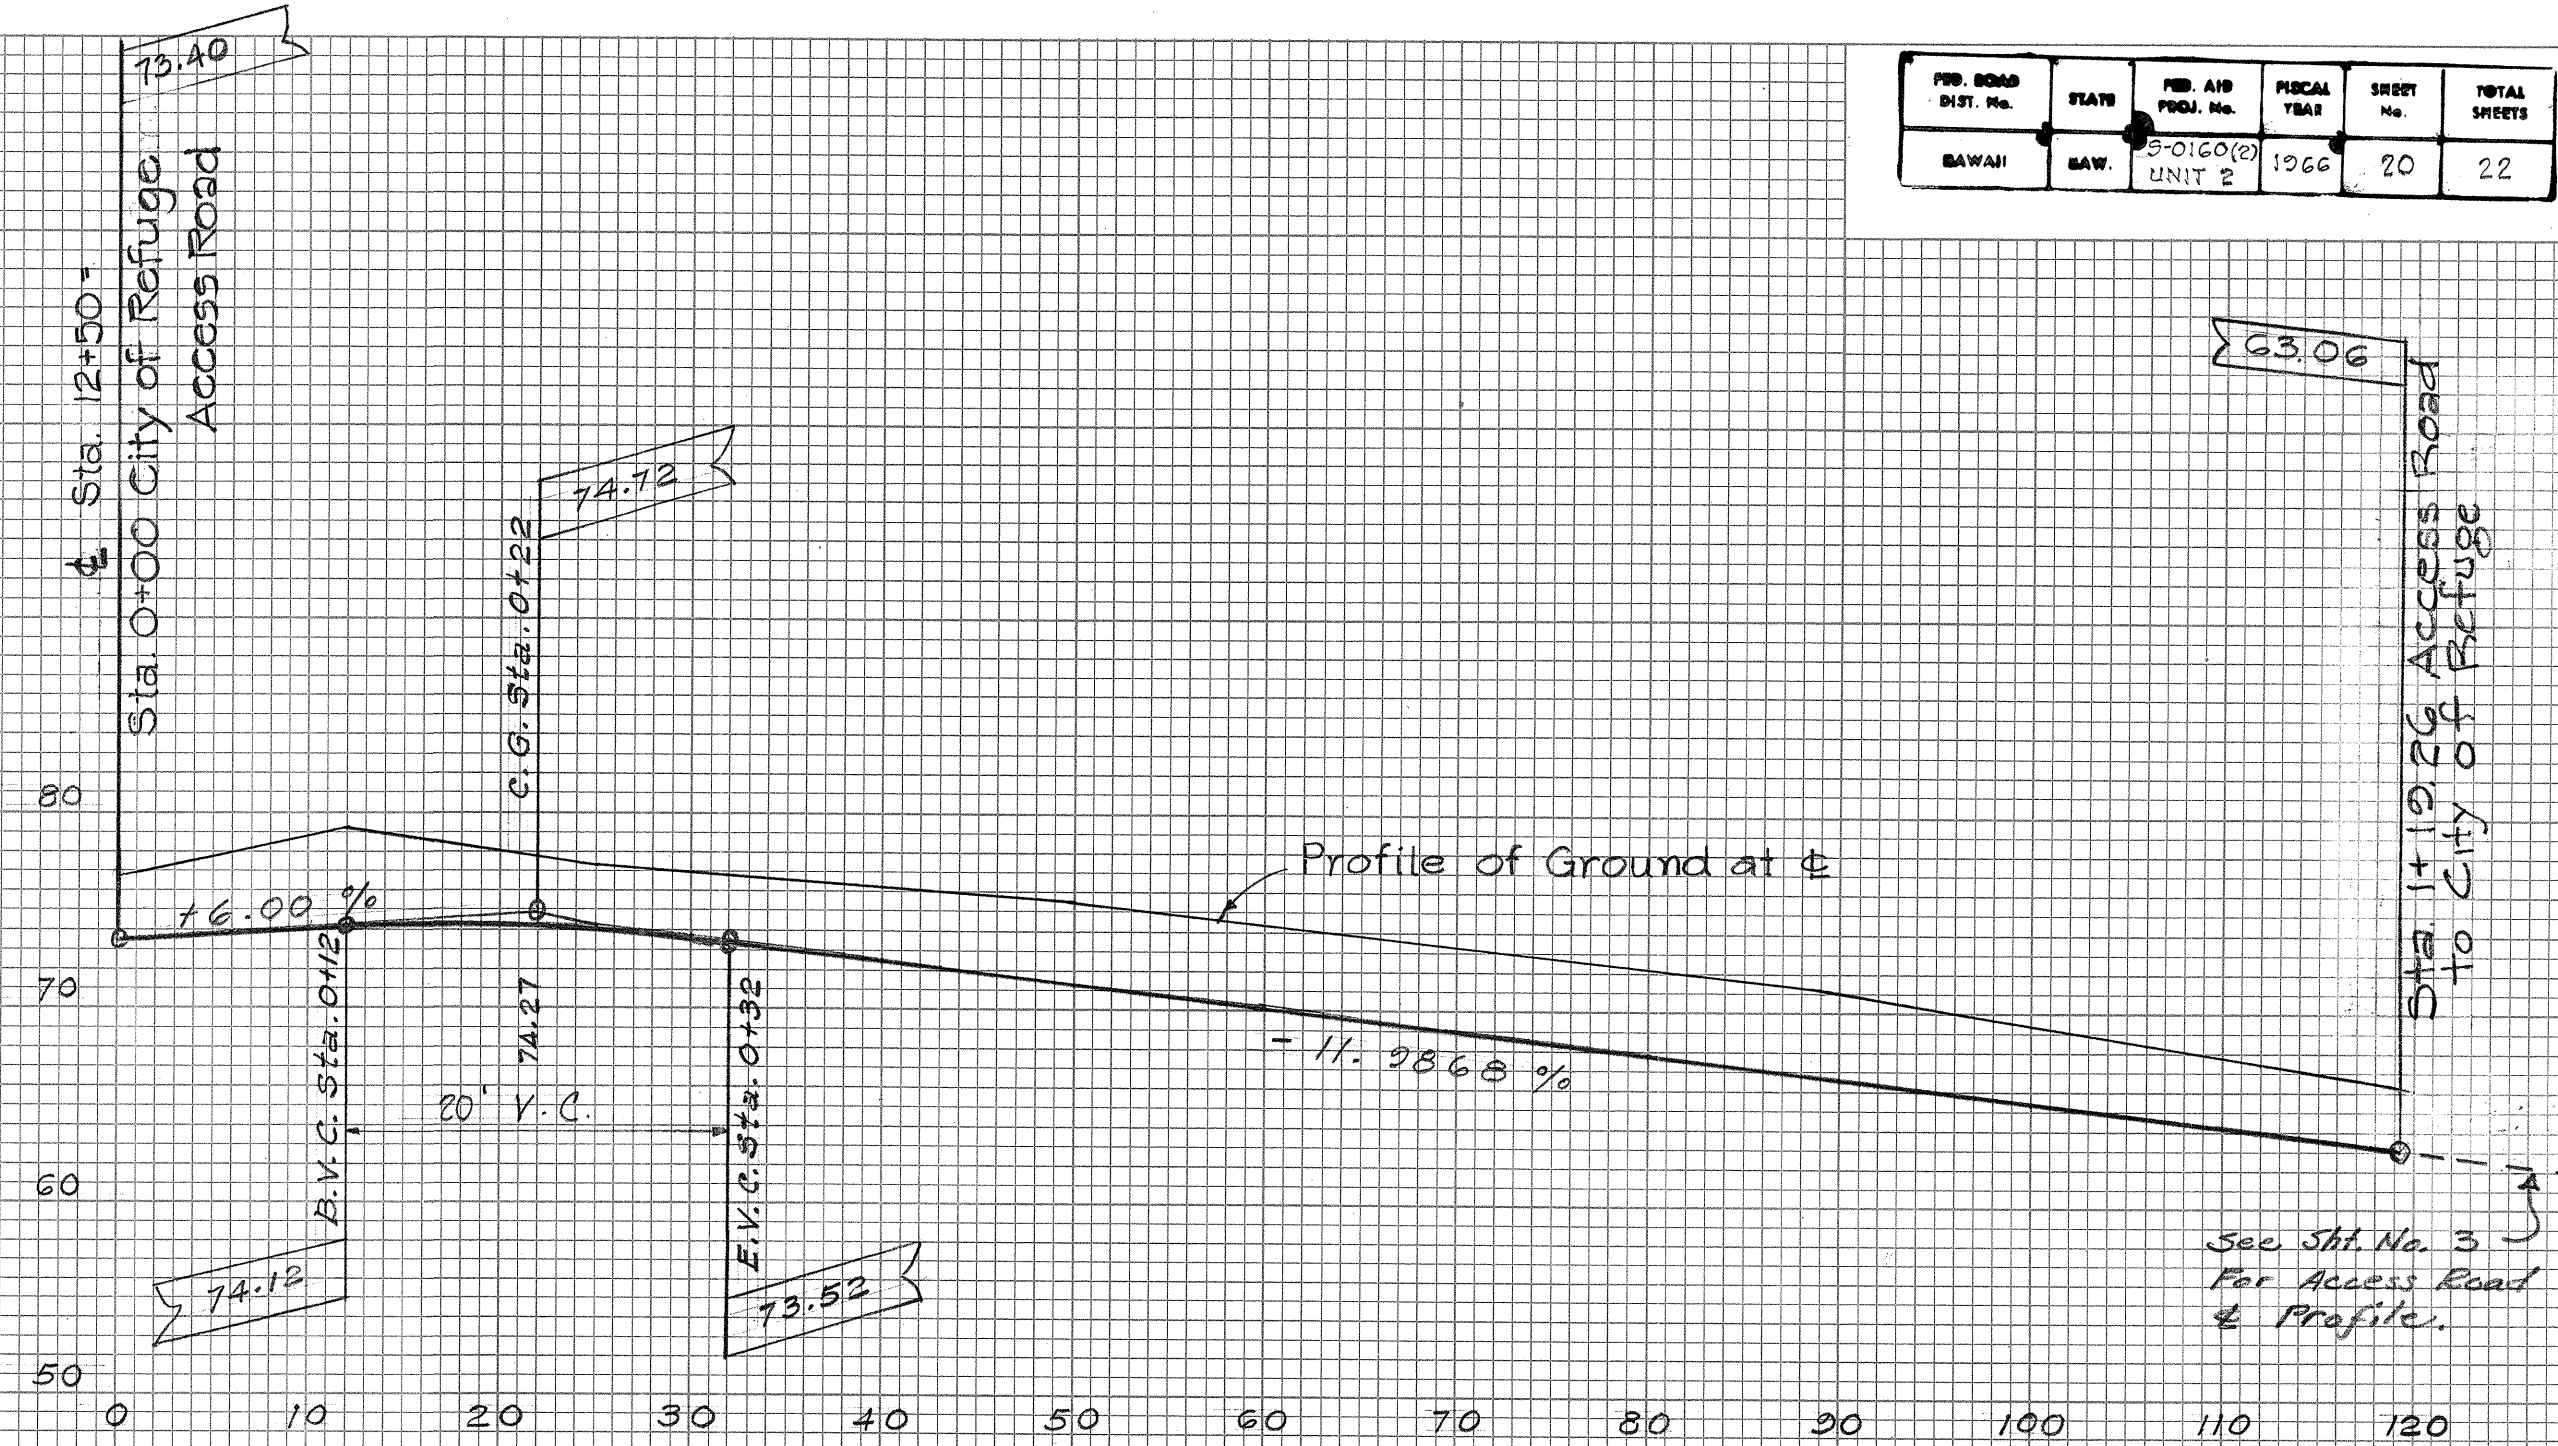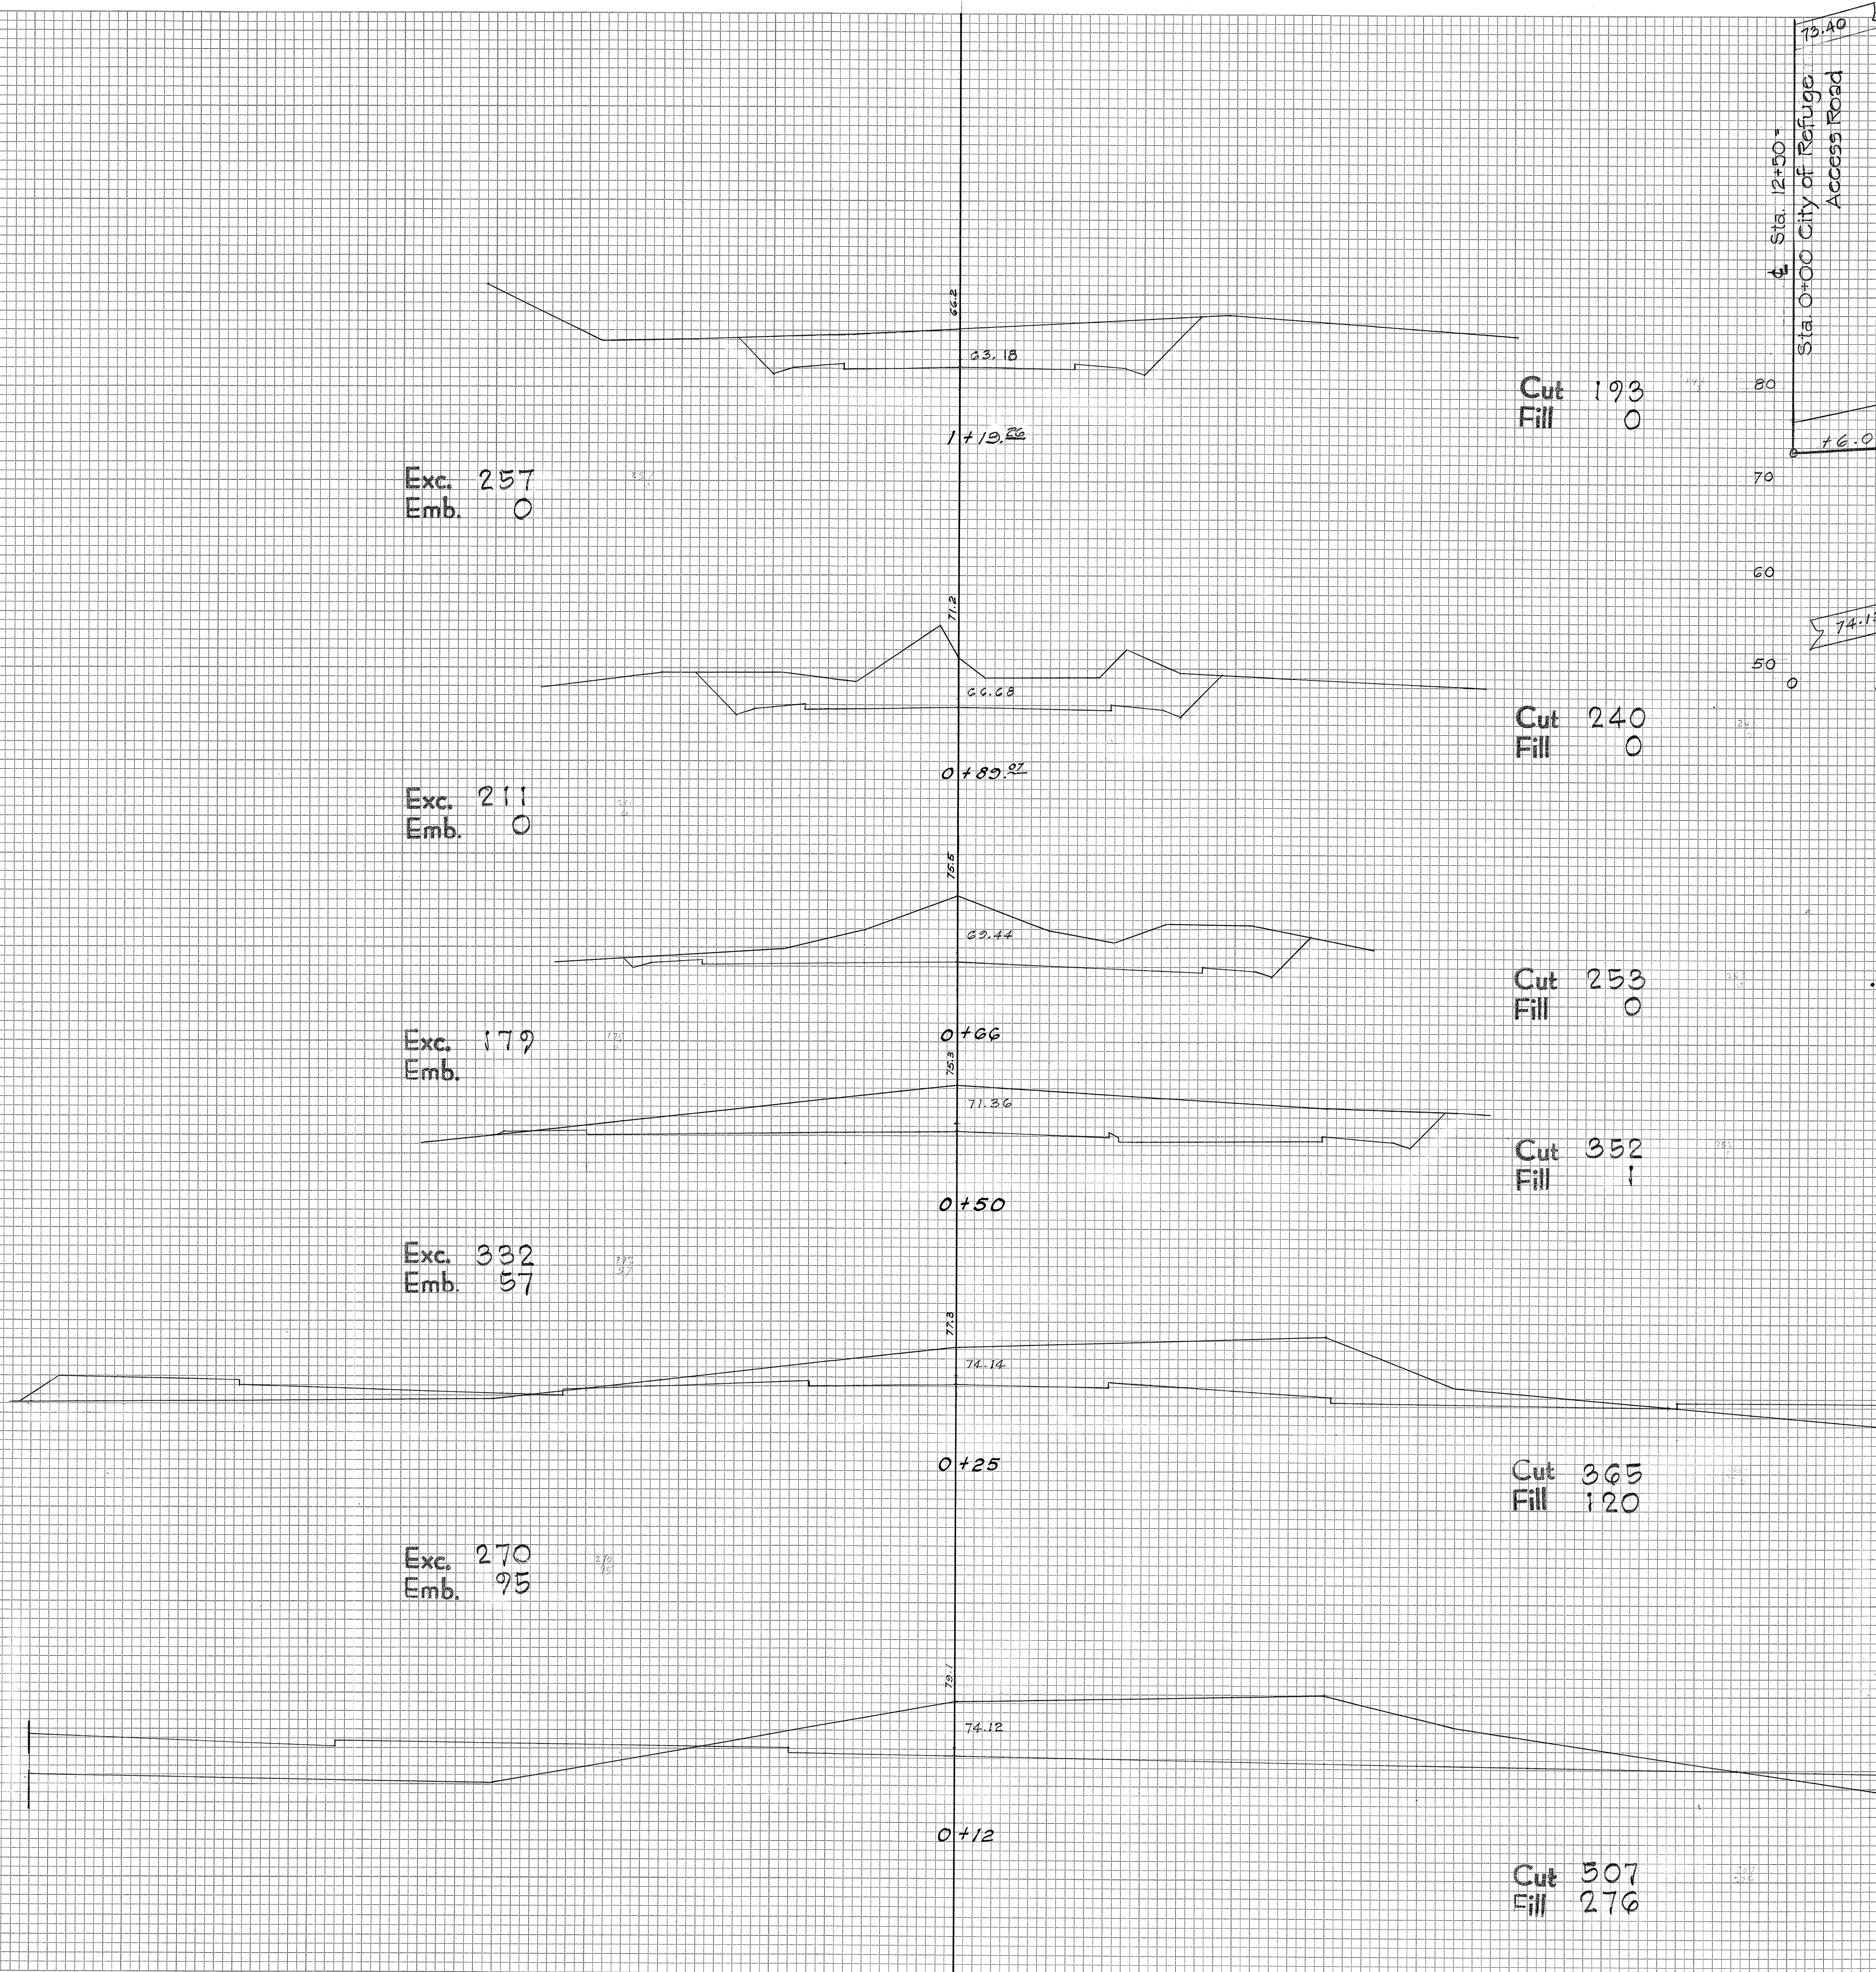

PROFILE FOR ACCESS ROAD INTERSECTION
Scale 1"=10' HORIZONTAL
1"=10' VERTICAL

NOTE: Access Road shall have the same typical section as show on sheet no. 2 of 22










ACCESS ROAD TO CITY OF REFUGE
CITY OF REFUGE ROAD

STA. 12+50

PROJ. NO.	DATE	PROJ. AND FUND. NO.	FISCAL YEAR	SHEET NO.	TOTAL SHEETS
0-01802	10/16/55	UNIT 2	1966	22	22

FINAL SURVEY	BY	DATE
SURVEYED		
PLOTTED		
NOTE BOOK		
AREAS		
AREAS CHECKED		
NO.		

ORIGINAL SURVEY	BY	DATE
SURVEYED		
NOTE BOOK		
AREAS		
AREAS CHECKED		
NO.		

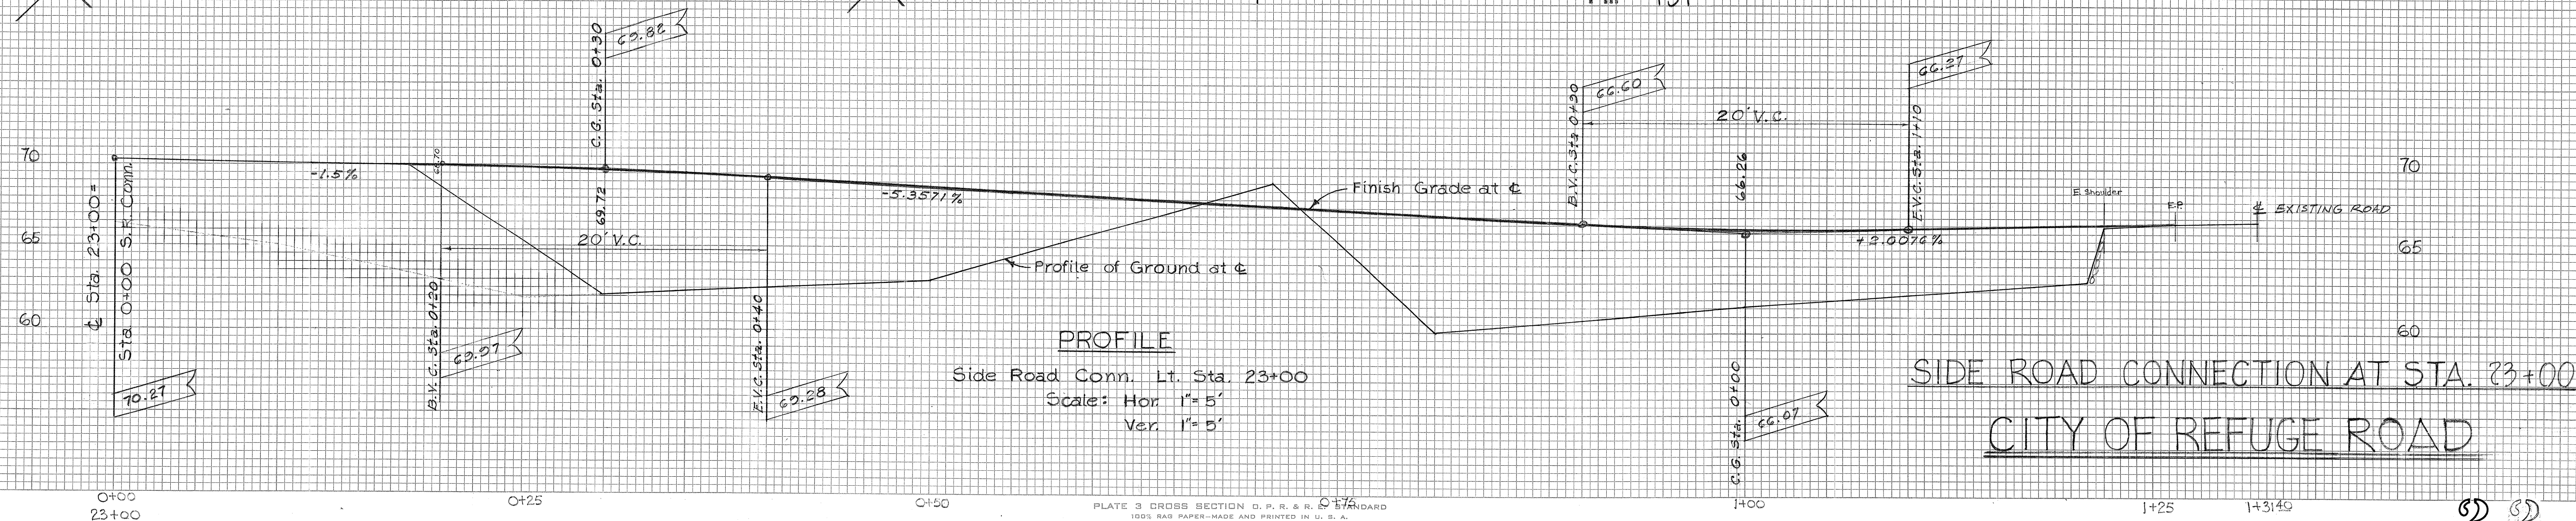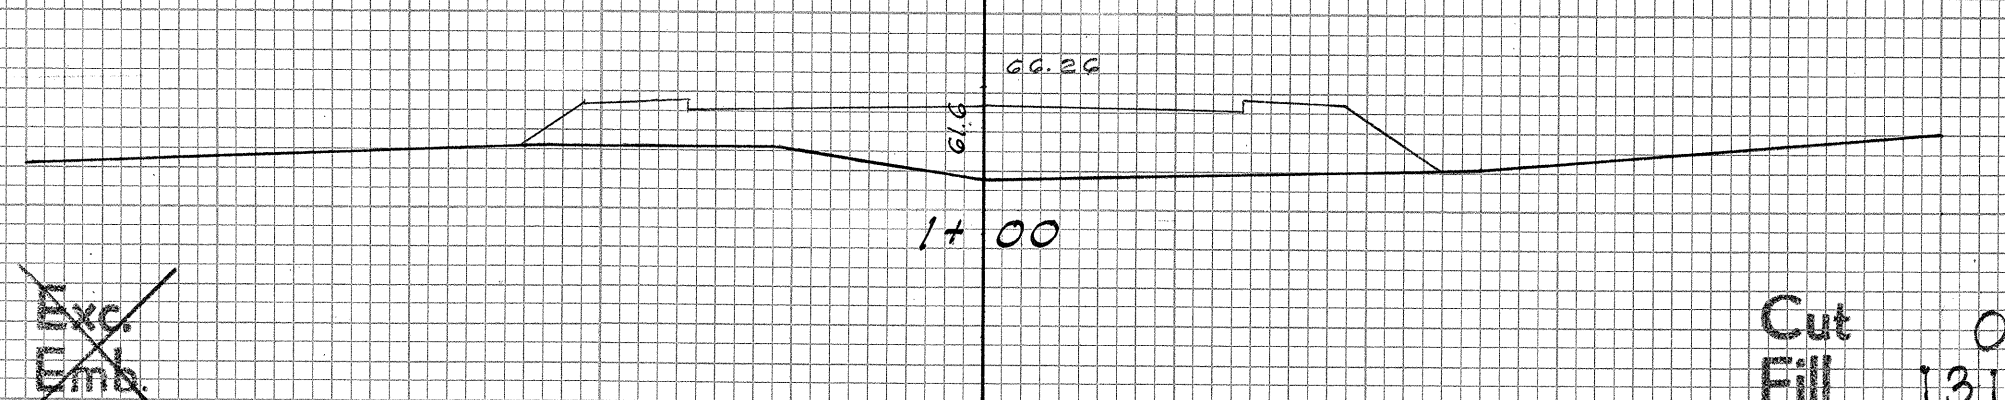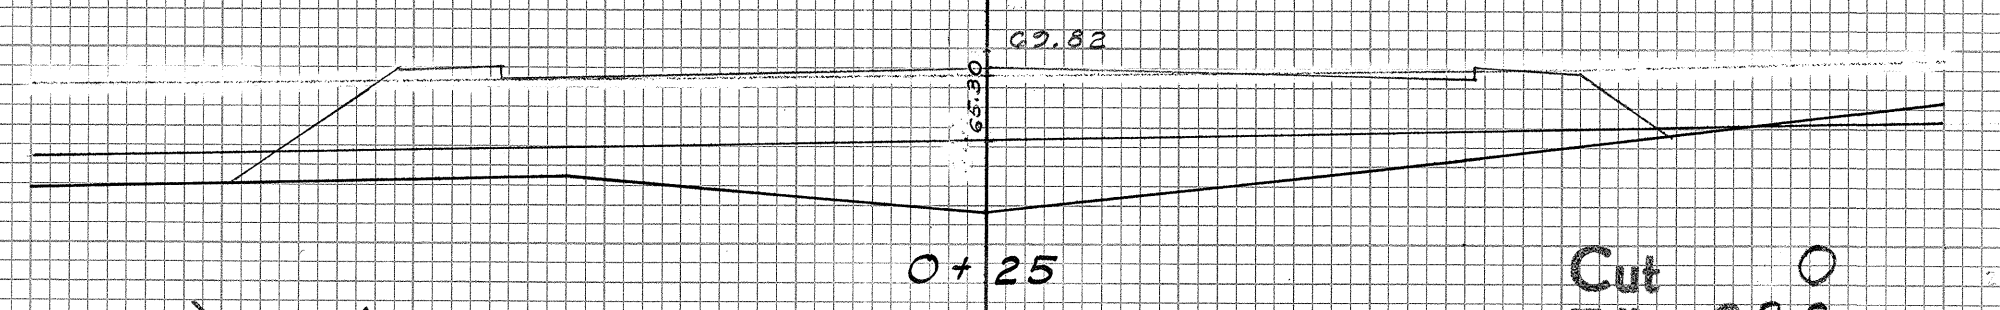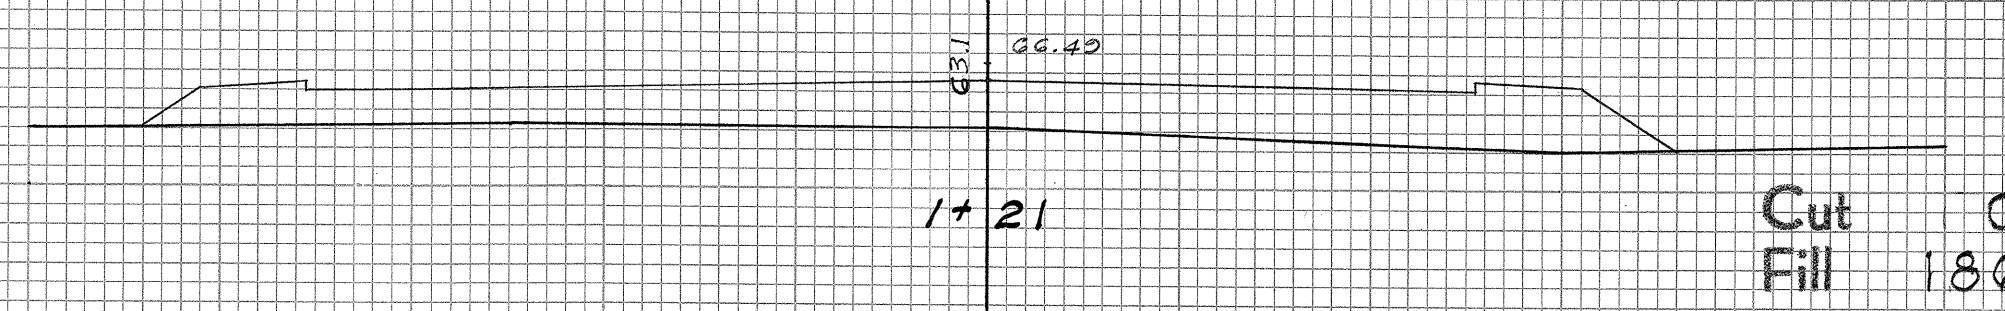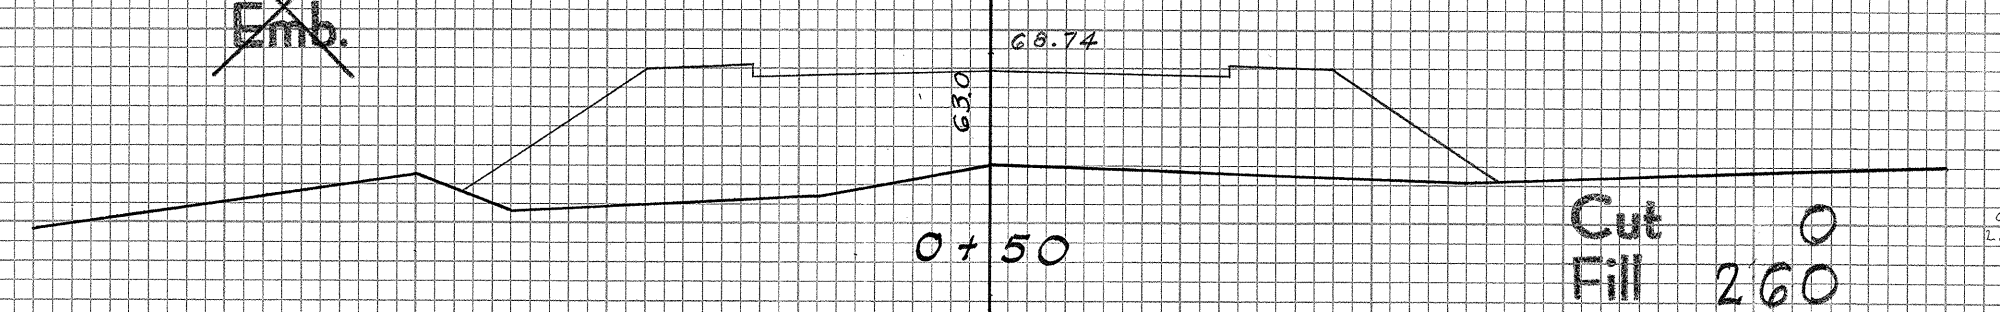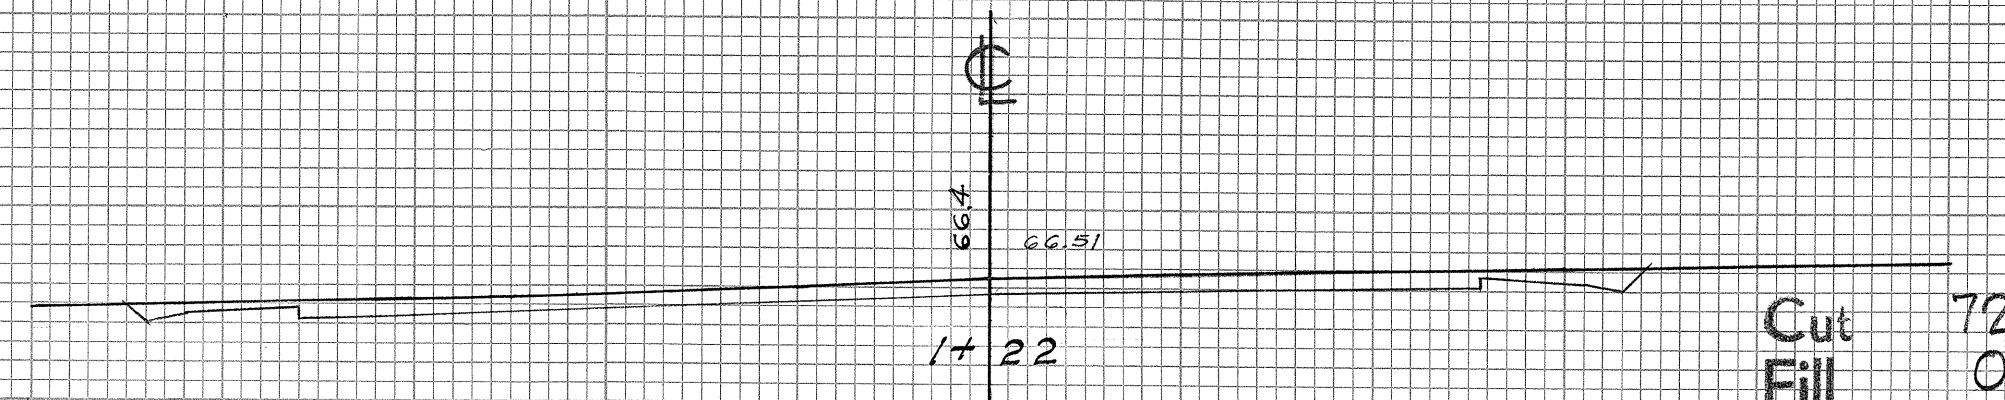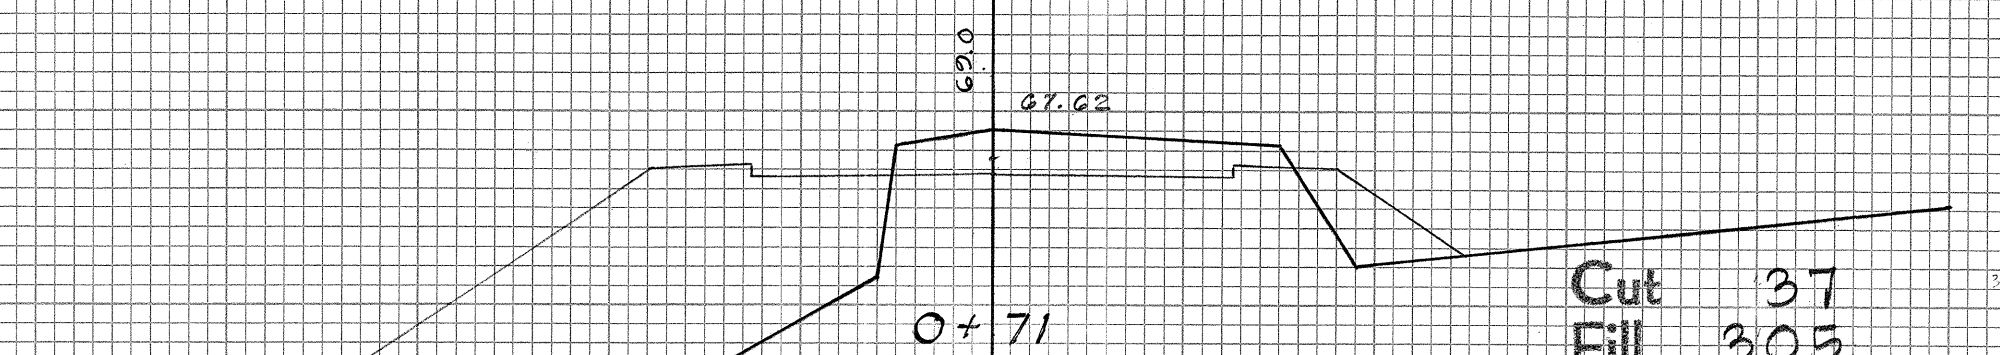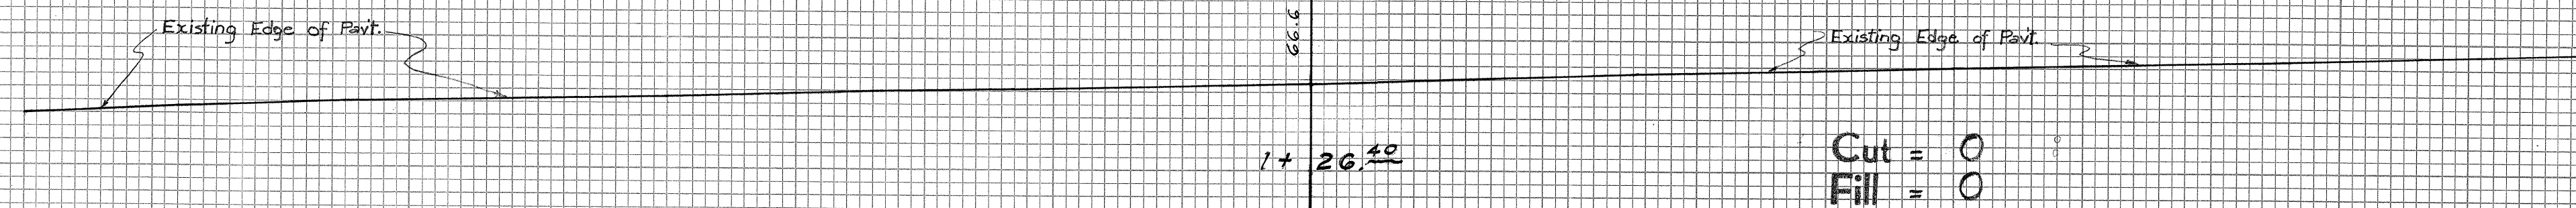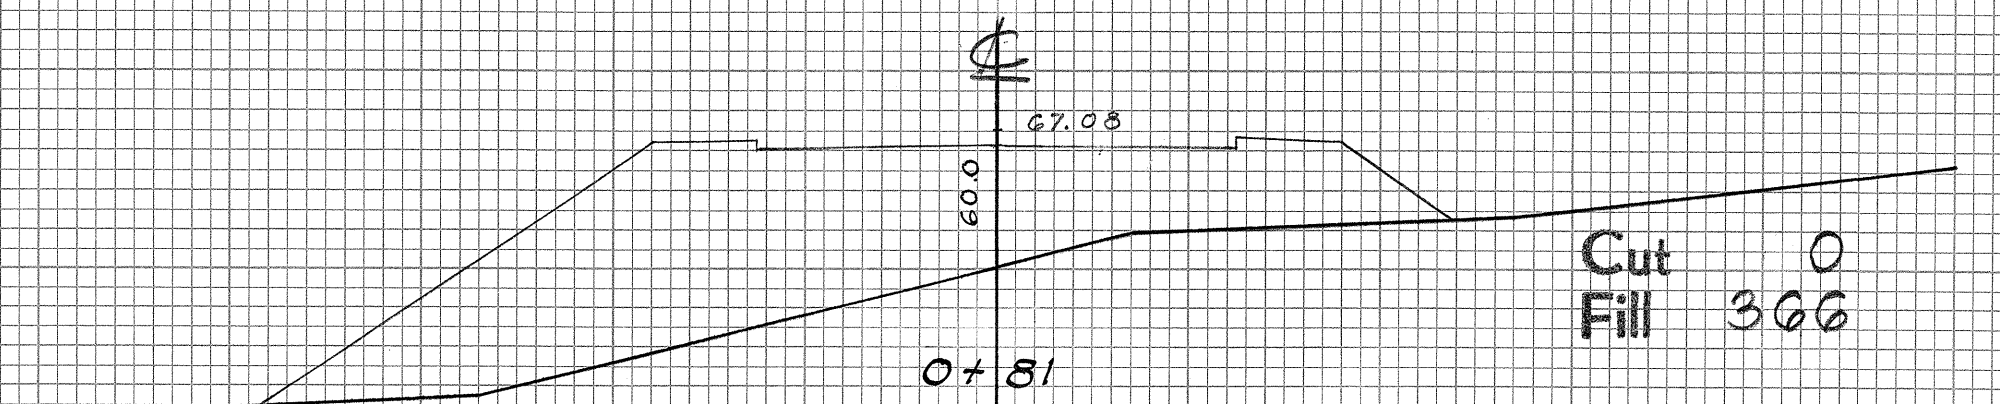

PROFILE
Side Road Conn. Lt. Sta. 23+00
Scale: Hor 1"=5'
Ver. 1"=5'

SIDE ROAD CONNECTION AT STA. 23+00
CITY OF REFUGE ROAD