


| PROJ. NO. | DIST. NO. | STATE  | PROJ. AID | SHEET NO. | TOTAL SHEETS |
|-----------|-----------|--------|-----------|-----------|--------------|
| 5-0160(2) | UNIT 2    | HAWAII | MAW       | 5         | 22           |

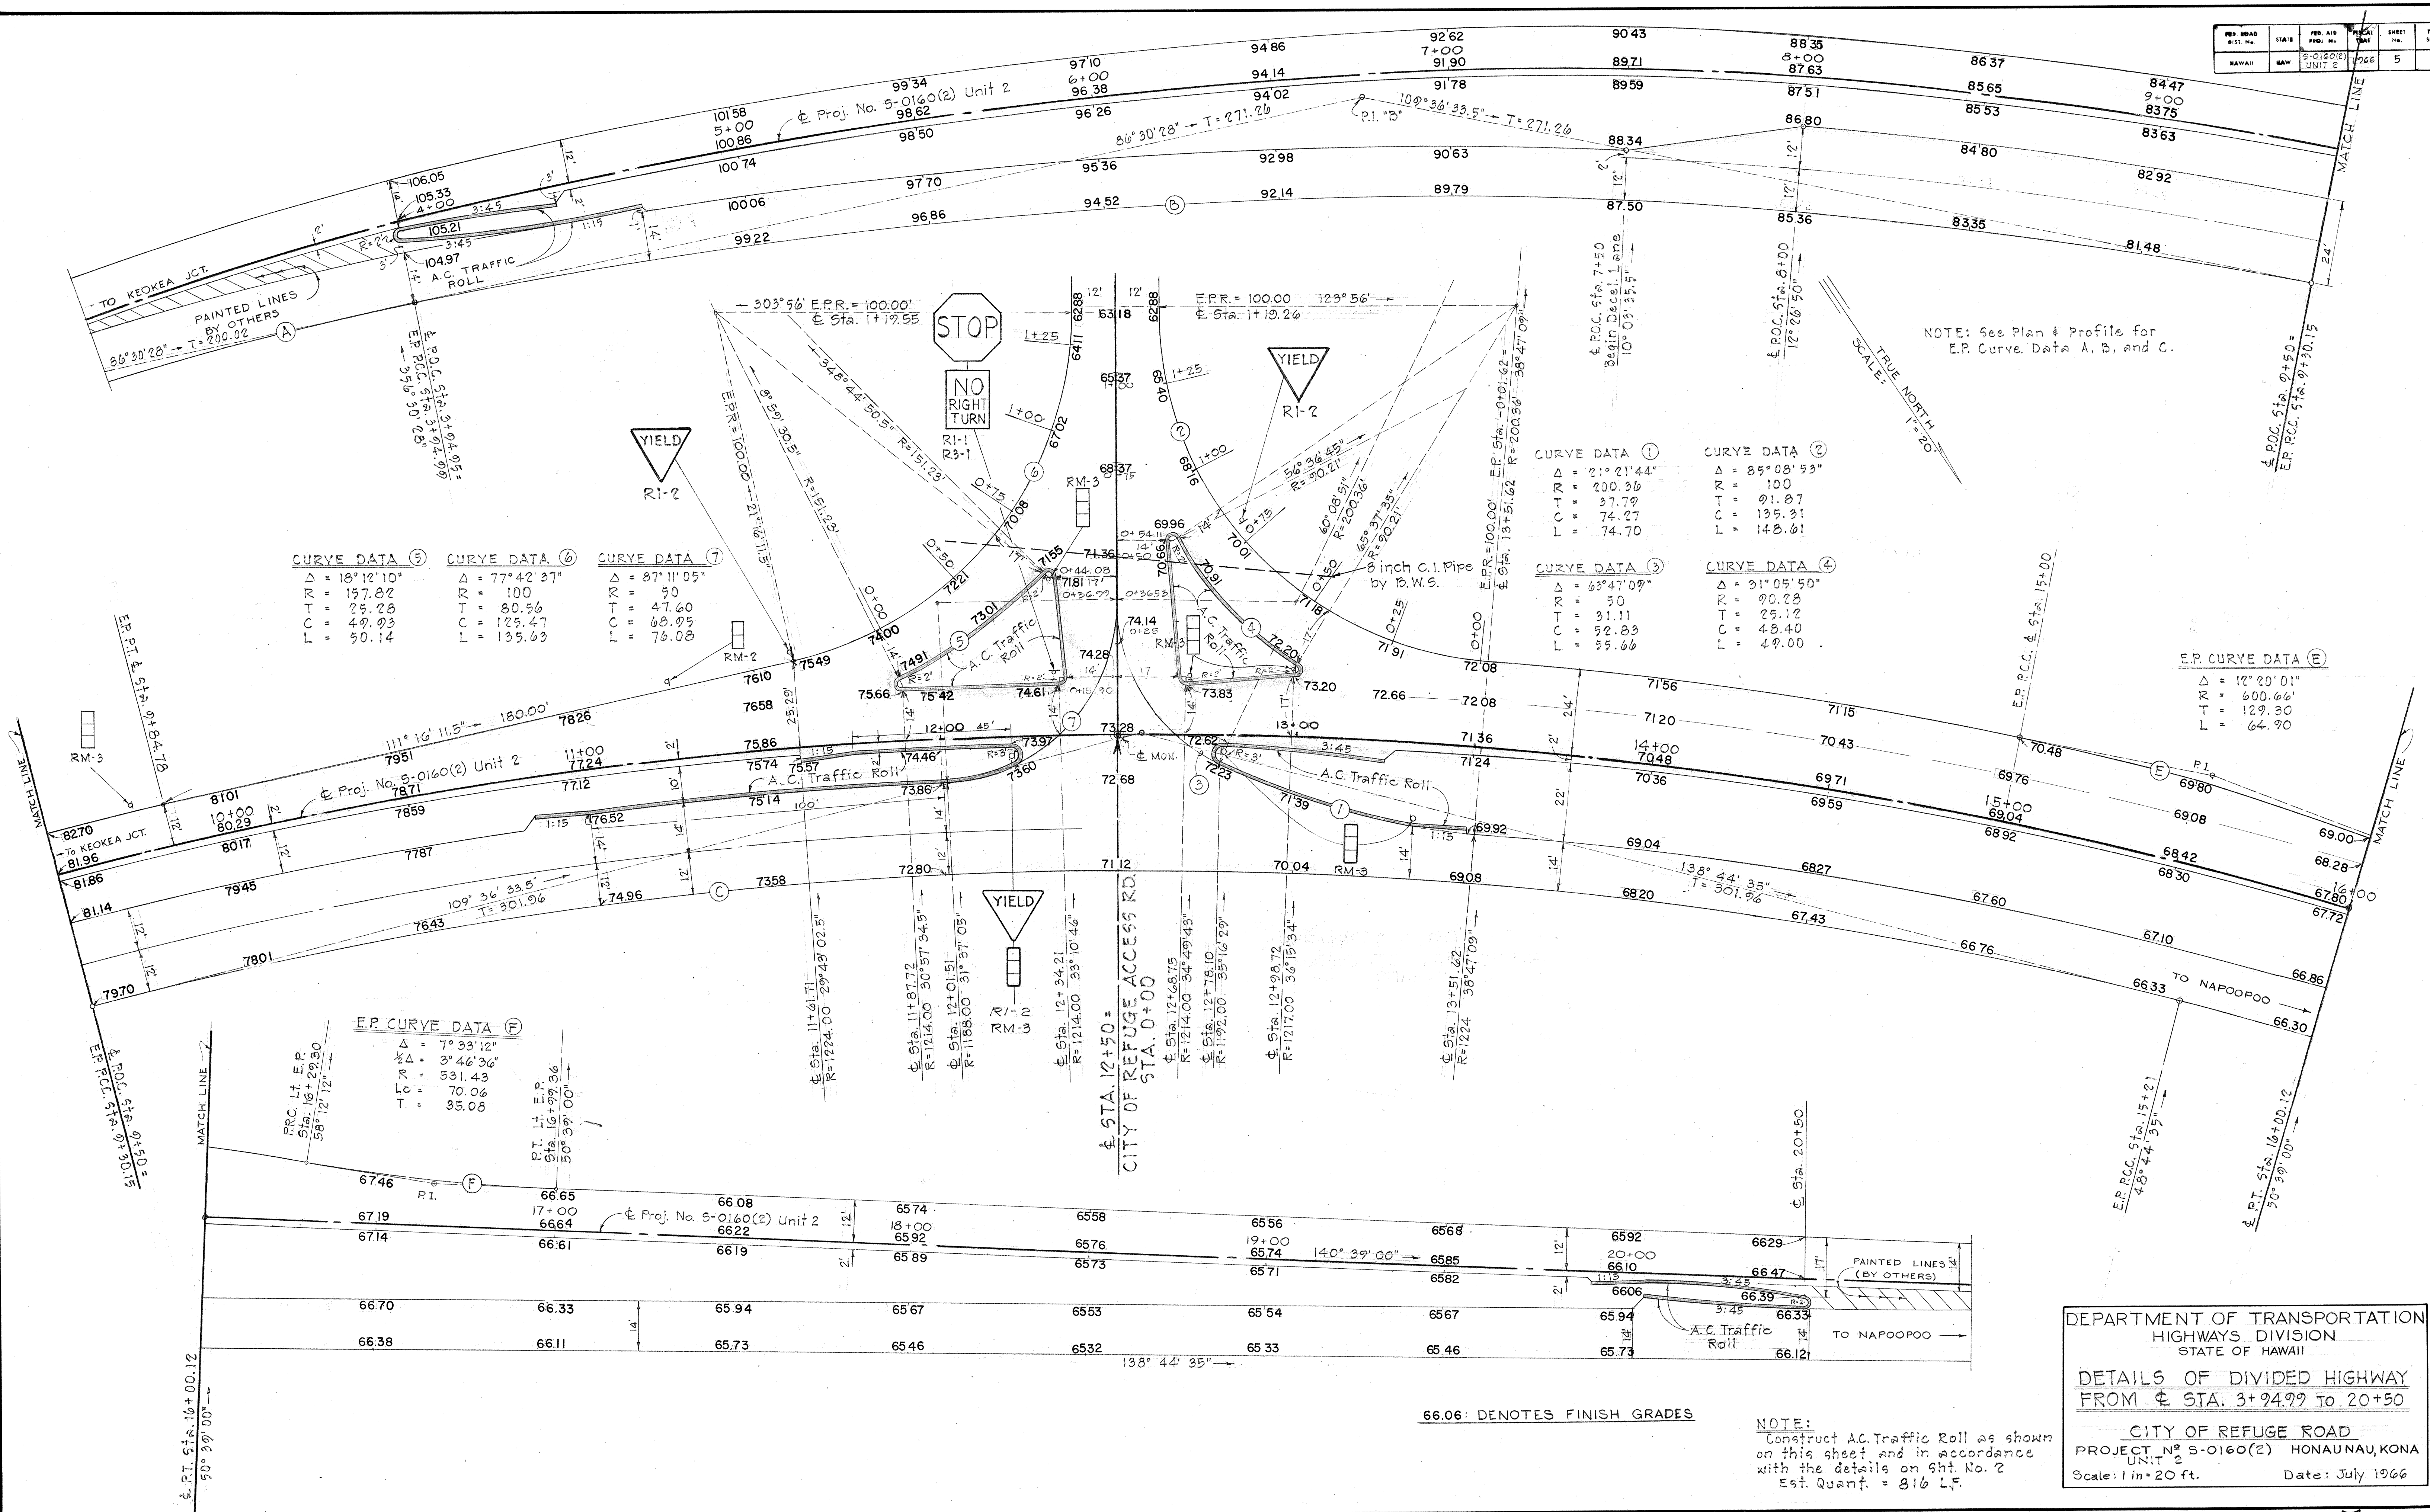

NOTE: See Plan & Profile for E.P. Curve Data A, B, and C.

DEPARTMENT OF TRANSPORTATION  
HIGHWAYS DIVISION  
STATE OF HAWAII

DETAILS OF DIVIDED HIGHWAY  
FROM STA. 3+24.77 TO 20+50

CITY OF REFUGE ROAD  
PROJECT NO. 5-0160(2) HONAU, KONA  
UNIT 2  
Scale: 1 in = 20 ft. Date: July 1966

NOTE:  
Construct A.C. Traffic Roll as shown on this sheet and in accordance with the details on Sht. No. 2  
Est. Quant. = 816 L.F.