

INDEX TO DRAWINGS	
SHEET	DESCRIPTION
1	Title Sheet
2	Typical Sections
3-4	Plan and Profile
5	Details of Divided Highway From Sta. 3+94.99 to 20+50
6	Construction Identification Sign
7-9	Metal Guard Rail With Posts
10-15	Destination, Regulatory and Warning Signs
16-22	Cross Sections

STATE OF HAWAII

DEPARTMENT OF TRANSPORTATION

"AS BUILT"

PLANS FOR

CONSTRUCTION OF

CITY OF REFUGE ROAD

(END OF PROJ. S-0160(I) TO CITY OF REFUGE NATIONAL HISTORICAL PARK)

FEDERAL AID SECONDARY PROJECT NO. S-0160(2)

UNIT 2

DISTRICT OF SOUTH KONA

ISLAND OF HAWAII

PLAN

PROFILE

CROSS SECTION

SCALES

1 INCH = 100 FT.

HOR. 1 INCH = 100 FT.

VER. 1 INCH = 10 FT.


HOR. 1 INCH = 10 FT.

VER. 1 INCH = 10 FT.

LOCATION

PROJ. NO. S-0160(2)

UNIT 2

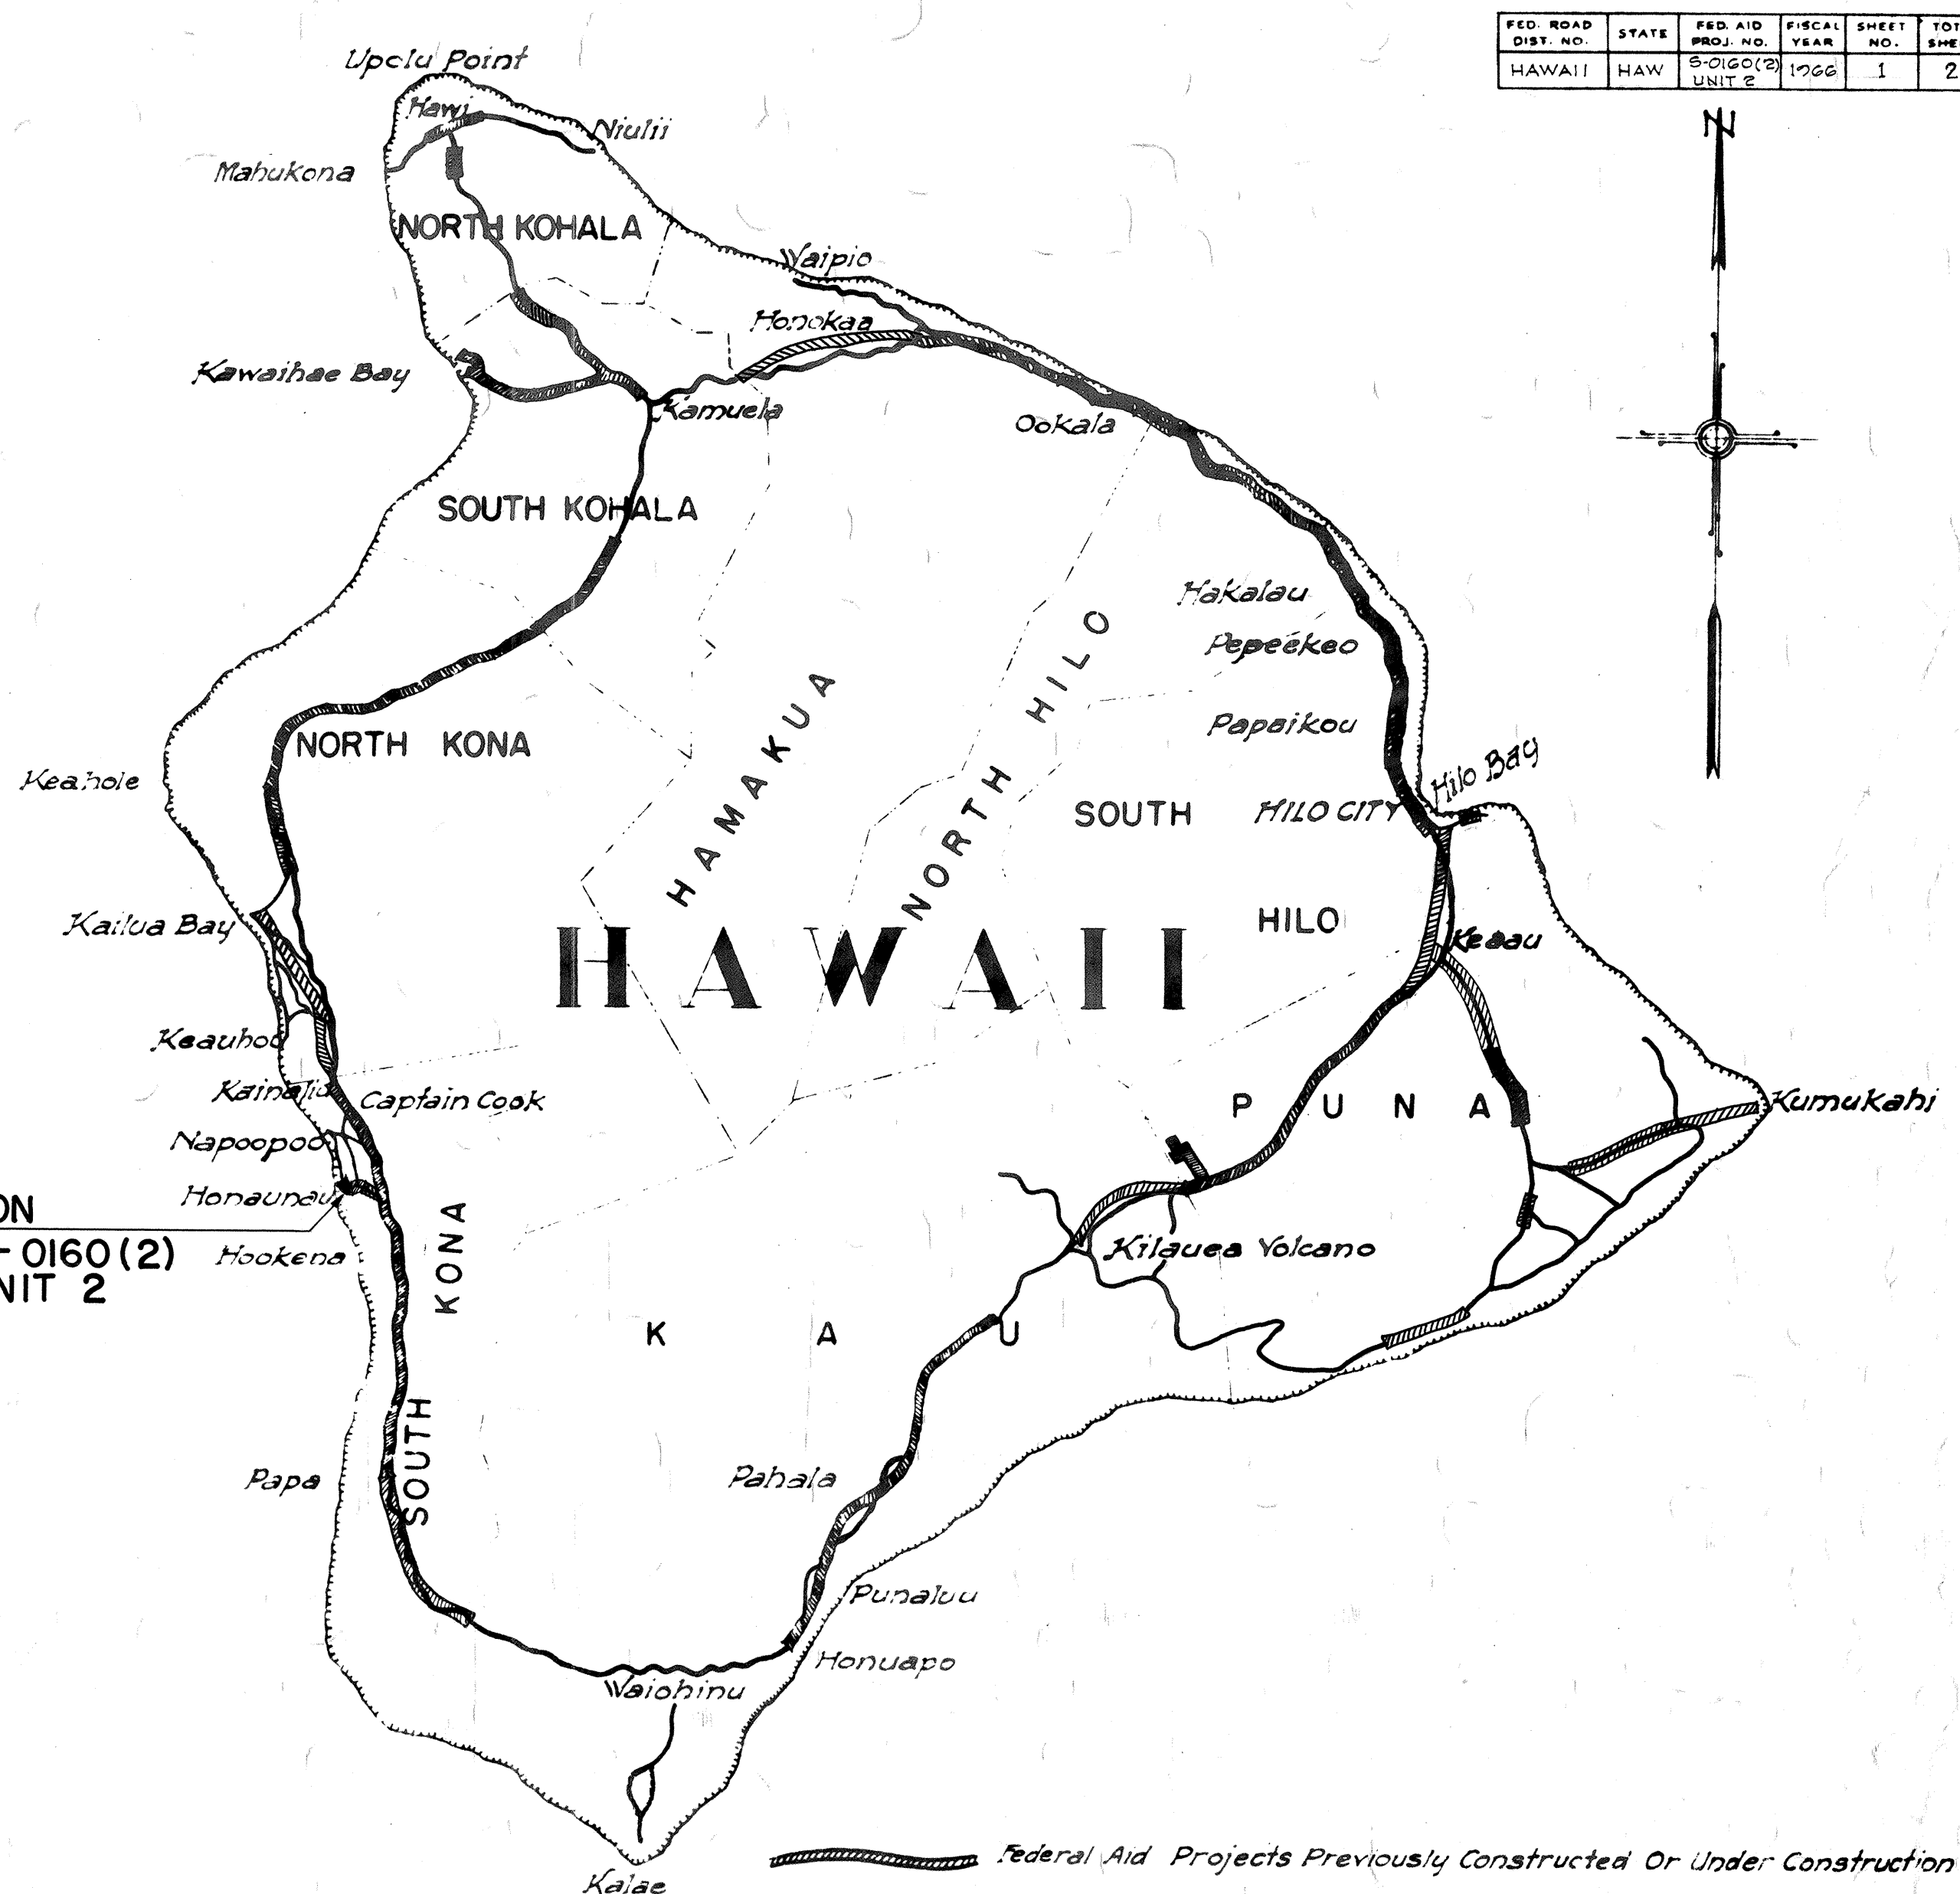

NOTE:

ALL CHANGES MADE DURING CONSTRUCTION HAVE BEEN NOTED ON THESE TRACINGS IN RED AND CHECKED BY:

Steve Nickimote

PROJECT ENGINEER

2-27-68

DATE

DESIGN CLASSIFICATION

ADT (1964)	150
Design ADT (1982)	1250
DHV	11 %
D	60/40
T	9 %
V	40 MPH

GENERAL LOCATION PLAN	
GROSS LENGTH OF PROJECT :	0.793 Miles
MAIN ROADWAY	0.660 Miles
ACCESS ROAD	0.133 Miles

APPROVED: DATE 8-3-66

for John M. Smith

DIRECTOR OF TRANSPORTATION

DEPARTMENT OF COMMERCE

BUREAU OF PUBLIC ROADS

APPROVED: 8-3-66

John B. Dalhorn

DIVISION ENGINEER DATE

SEAL

DESIGNED BY: A. Marutani

DATE: July 66

TRACED BY:

CHECKED BY:

NOTED BY:

OF UNITIES (REPAID BY)