


FED. ROAD DIST. NO.	STATE	PROJ. NO.	FISCAL YEAR	SHEET NO.	TOTAL SHEETS
HAWAII	HAW.	160A-01-96M	1996	15	29



ORIGINAL PLAN	DATE
DRAWN BY	
DESIGNED BY	
CHECKED BY	
NOTED BY	
DATE	

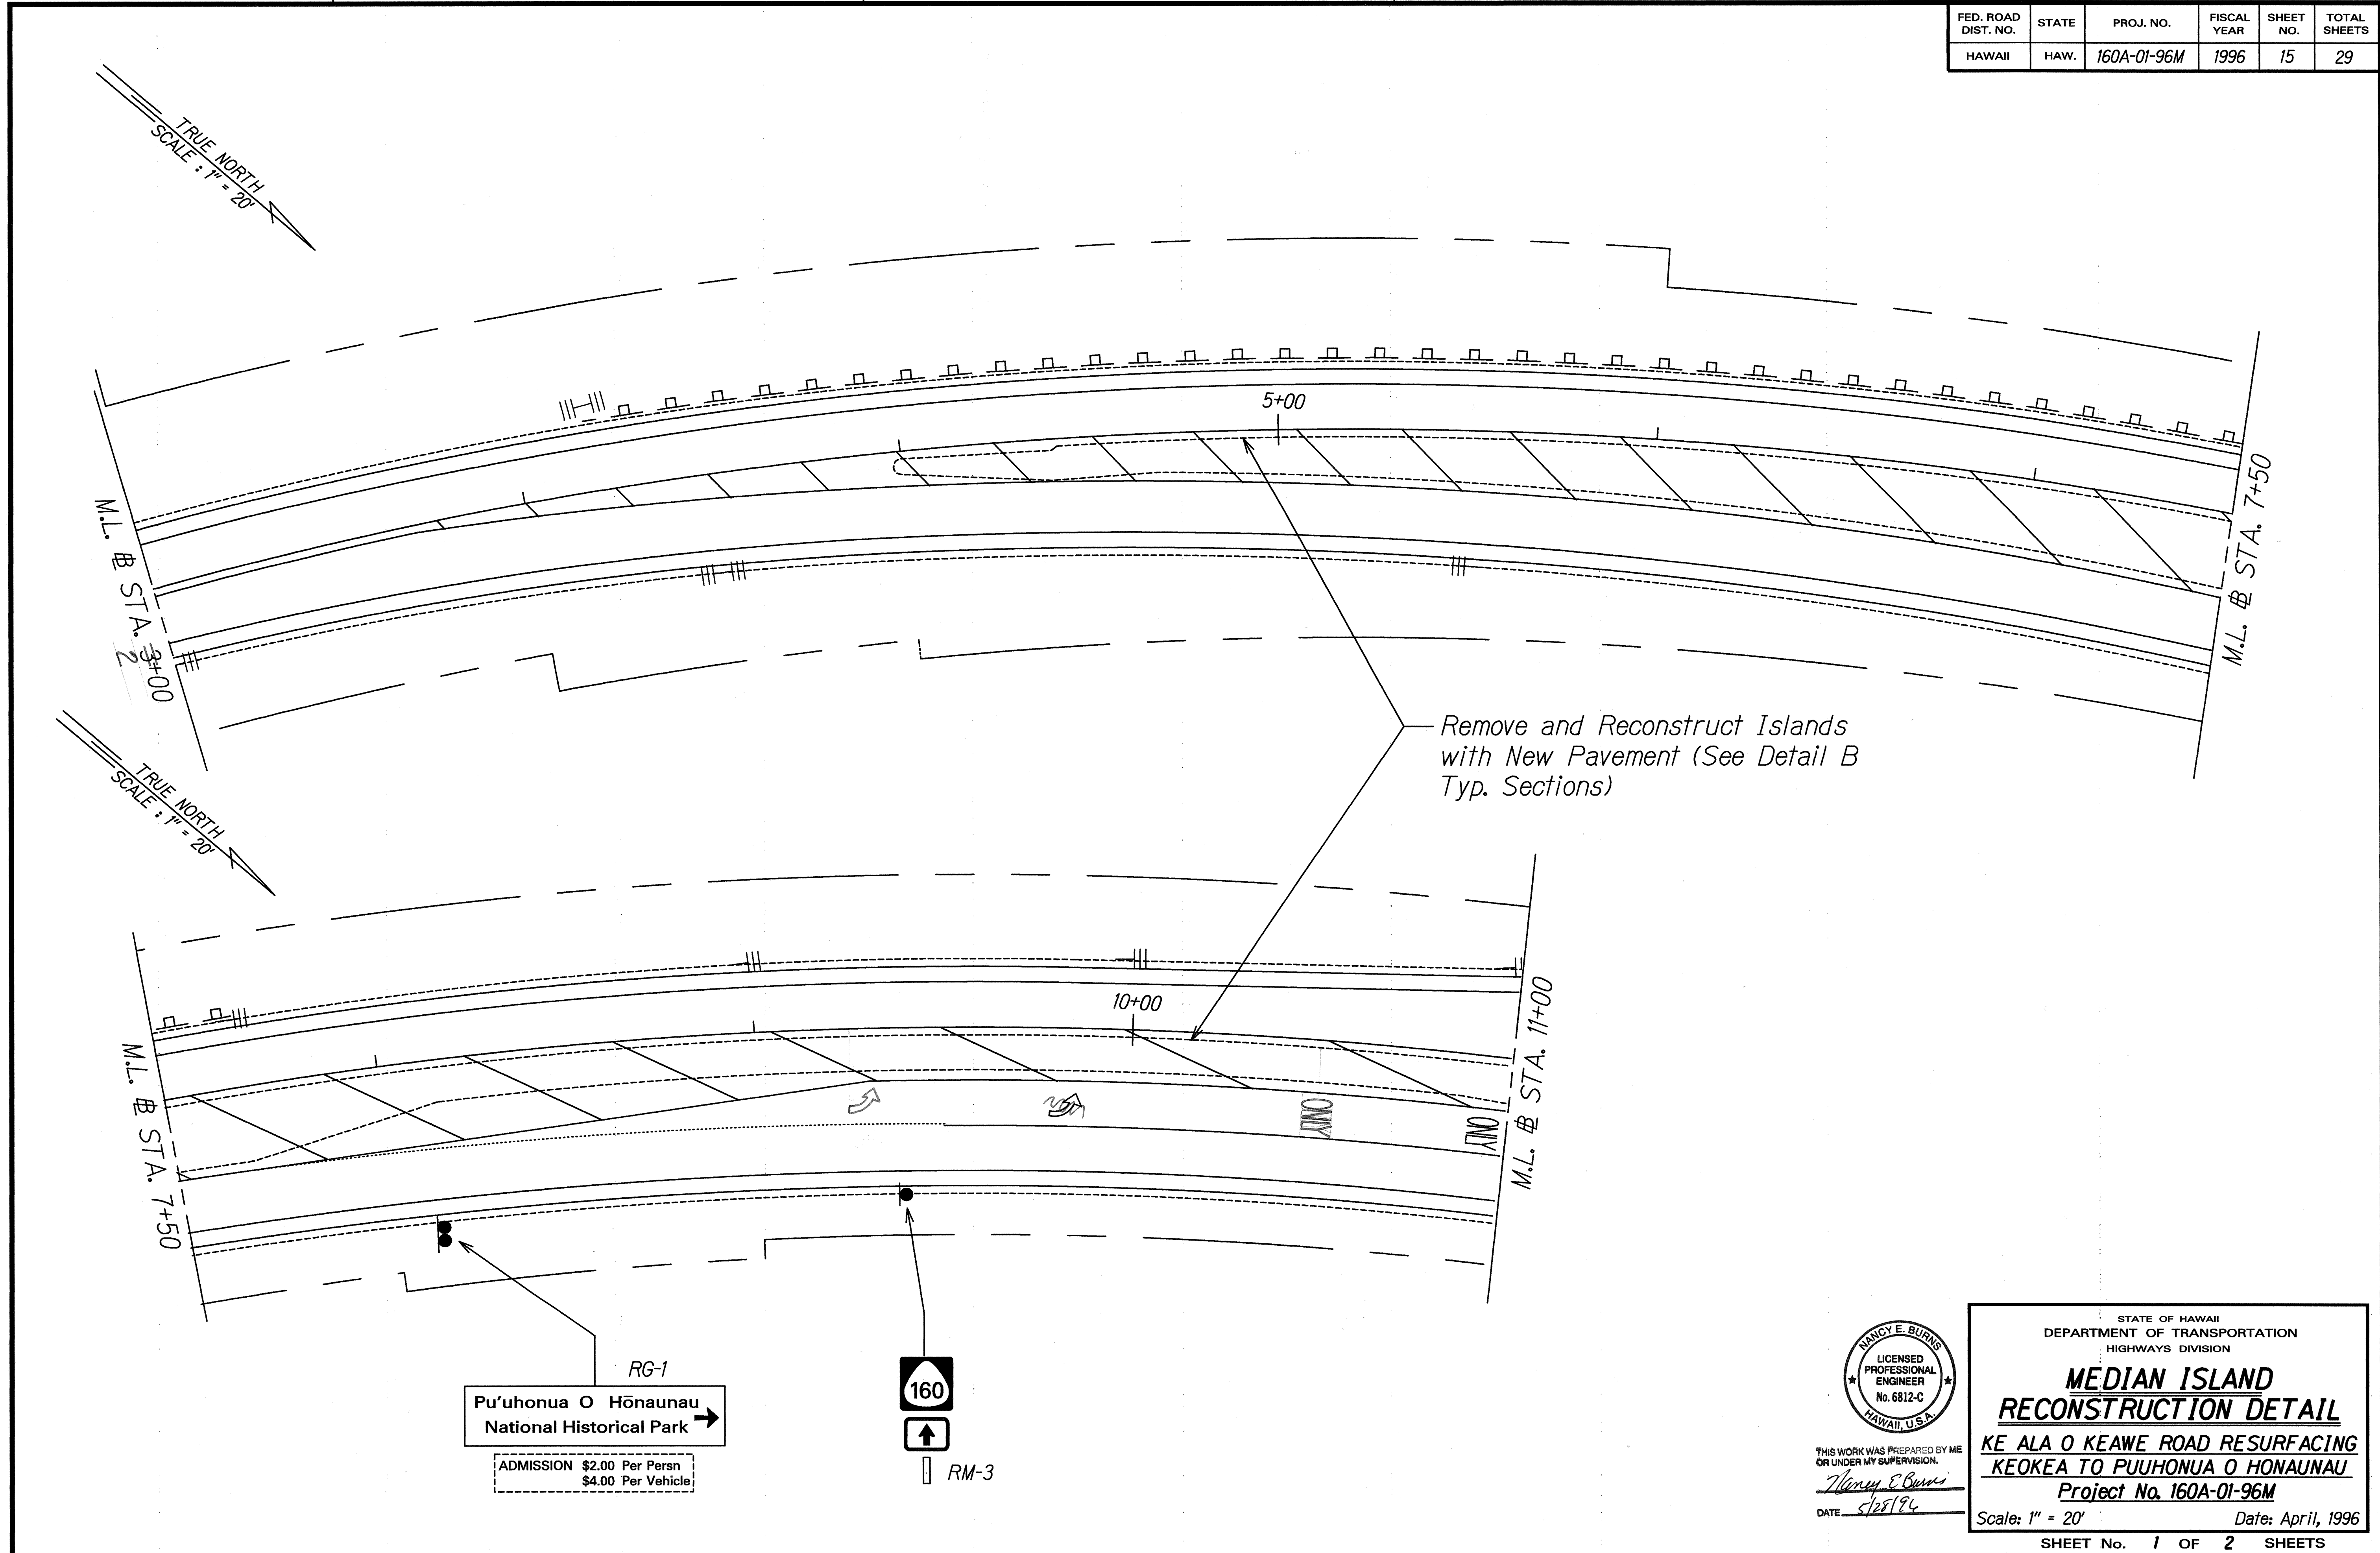

THIS WORK WAS PREPARED BY ME
OR UNDER MY SUPERVISION.
Nancy E. Burns
DATE 5/28/96

STATE OF HAWAII
DEPARTMENT OF TRANSPORTATION
HIGHWAYS DIVISION

**MEDIAN ISLAND
RECONSTRUCTION DETAIL**


KE ALA O KEAWE ROAD RESURFACING
KEOKEA TO PUUHONUA O HONAUNAU
Project No. 160A-01-96M

Scale: 1" = 20' Date: April, 1996

SHEET No. 1 OF 2 SHEETS

FED. ROAD DIST. NO.	STATE	PROJ. NO.	FISCAL YEAR	SHEET NO.	TOTAL SHEETS
HAWAII	HAW.	160A-01-96M	1996	16	29

RG-2
 Pu'u honua O Honaunau National Historical Park
 ADMISSION \$2.00 Per Person
 \$4.00 Per Vehicle

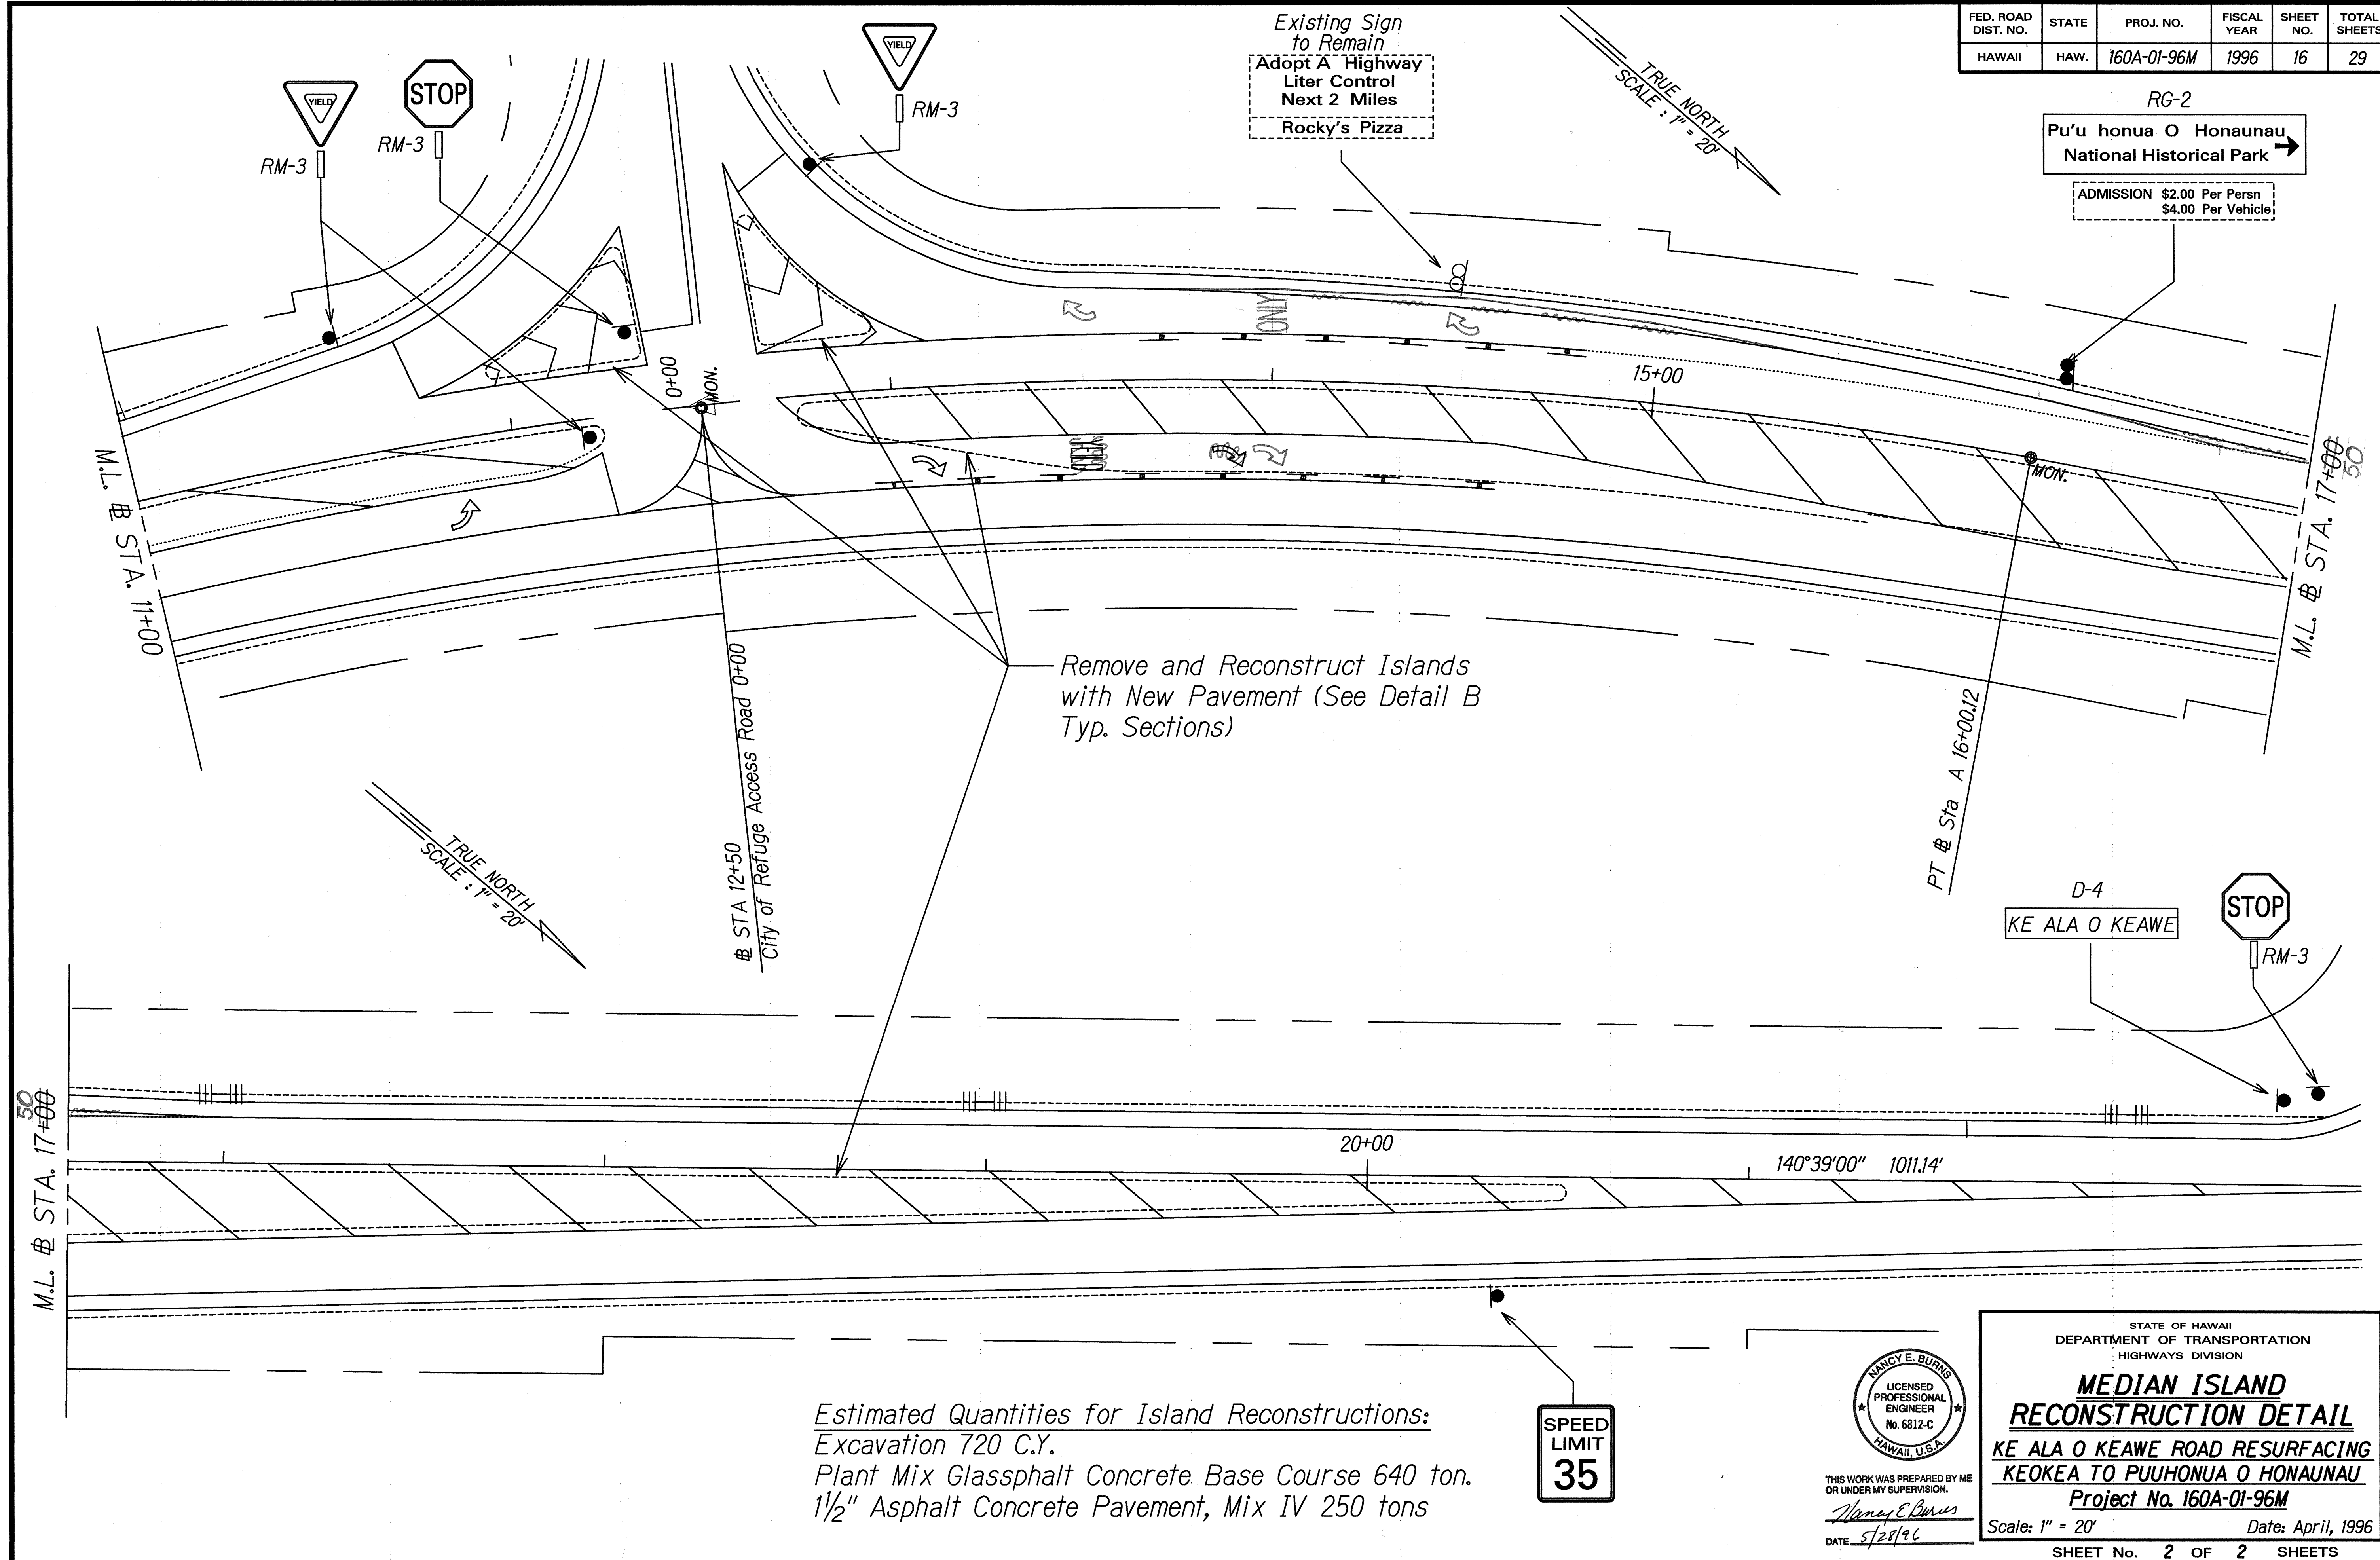

Estimated Quantities for Island Reconstructions:
 Excavation 720 C.Y.
 Plant Mix Glassphalt Concrete Base Course 640 ton.
 1 1/2" Asphalt Concrete Pavement, Mix IV 250 tons

SPEED
 LIMIT
 35



THIS WORK WAS PREPARED BY ME
 OR UNDER MY SUPERVISION.
Nancy E. Burns
 DATE 5/28/96

STATE OF HAWAII
 DEPARTMENT OF TRANSPORTATION
 HIGHWAYS DIVISION

**MEDIAN ISLAND
 RECONSTRUCTION DETAIL**

KE ALA O KEAWE ROAD RESURFACING
 KEOKEA TO PUUHONUA O HONAUNAU
 Project No. 160A-01-96M

Scale: 1" = 20' Date: April, 1996

SHEET No. 2 OF 2 SHEETS

ORIGINAL PLAN	DATE
DESIGNED BY	
DRAWN BY	
CHECKED BY	
NOTED BY	
DATE	