


FED. ROAD DIST. NO.	STATE	PROJ. NO.	FISCAL YEAR	SHEET NO.	TOTAL SHEETS
HAWAII	HAW.	160A-01-96M	1996	17	29

A.C. Pavement  
~~Paving Fabric; Apply with Tack Coat Below and Above Fabric~~

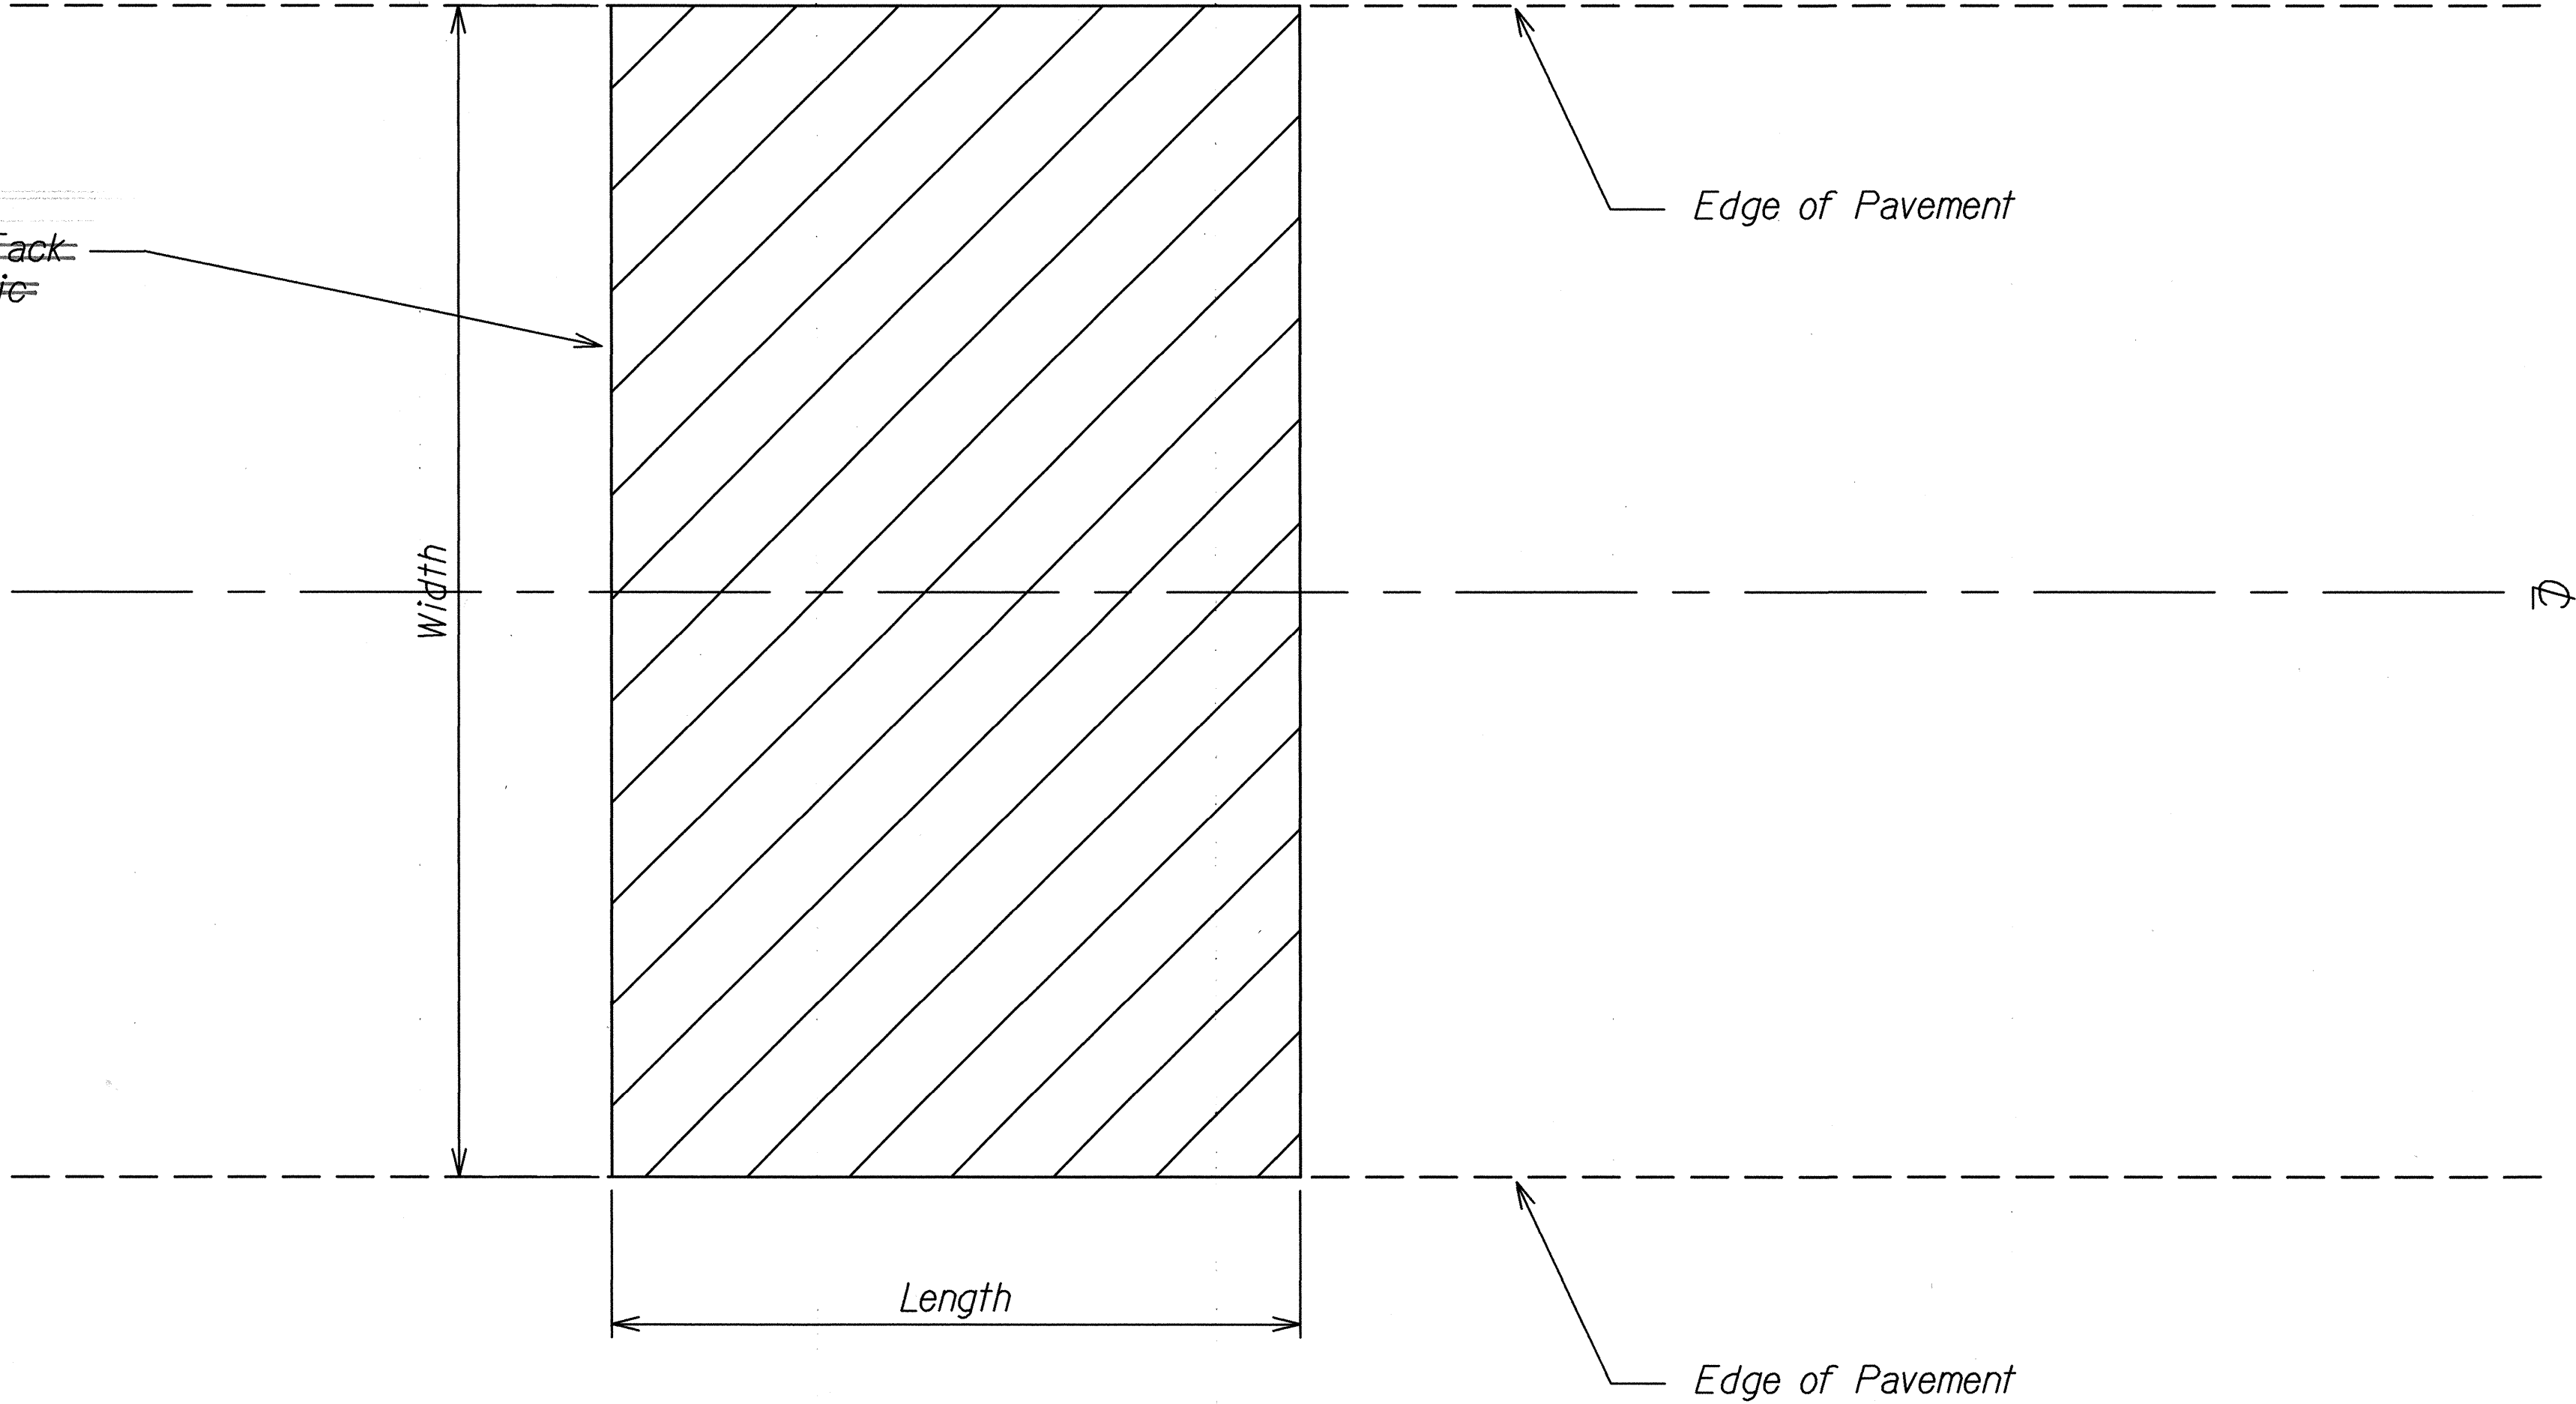

2 1/2" A.C. PAVEMENT MIX NO. IV

PAVING FABRIC SCHEDULE		
STATION FROM	TO	APPROX. AREA (SQ. YD.)
Ke Ala O Keawe Road 12+00	32+00	9530
City of Refuge Road 1+19	7+13	1600

Notes:  
~~For Paving Fabric Schedule, See This Sheet~~

A.C. PAVEMENT  
TYPICAL PAVING FABRIC DETAIL  
SCALE: Not to Scale



THIS WORK WAS PREPARED BY ME OR UNDER MY SUPERVISION.  
*Nancy E. Burns*  
DATE: 5/28/96

STATE OF HAWAII  
DEPARTMENT OF TRANSPORTATION  
HIGHWAYS DIVISION  
A.C. PAVEMENT  
PAVING FABRIC DETAIL

KE ALA O KEAWE ROAD RESURFACING  
KEOKEA TO PUUHONUA O HONAUNAU  
Project No. 160A-01-96M  
Scale: Not to Scale  
Date: April, 1996

SURVEY PLATTED BY	DATE
DRAWN BY	
TRACED BY	
NOTED BY	
CHECKED BY	
ORIGINAL PLAN	
NOTE BOOK	
No.	