


FED. ROAD DIST. NO.	STATE	PROJ. NO.	FISCAL YEAR	SHEET NO.	TOTAL SHEETS
HAWAII	HAW.	160A-01-96M	1996	22	29

SIGN SCHEDULES

STATION	LEFT	RIGHT	TYPE	SIGN TO REMAIN	REMOVE	INSTALL (10 SQ. FT. OR LESS)		INSTALL (GREATER THAN 10 SQ. FT.)		DESTINATION SIGN PANEL (S.F.)
						W/POST	WO/POST	W/POST	WO/POST	
S-0160 (1)										
0+20	●		R1-1		1	1				
0+20		●	"Left Turn Here"		1	1				
0+28	●		R5-1		1	1				
0+28	●		R1-2		1		1			
0+36		●	R1-2		1	1				
0+39	●		R8-3(B)-a (24"X36")			1				
0+57	●		"Do Not Pick or Cut Flowers"	1						
0+82		●	R8-3(B)-a (24"X36")		1	1				
1+43		●	"Adopt -a-Highway"	1						
1+43		●	"West Hawaii Kiwanis"	1						
2+22		●	R1-1		1	1				
2+43	●		D-1 ⇐Kailua/Volcano⇒ (102"X48")		1					34.00
2+70		●	"Buckle Up It's The Law"		1	1				
3+14 10		●	R2-1 (45)-a (36"X48")		1			1		
4+35 10		●	"Unlawful To Litter"			1				
4+86	●		R8-3(B)-a (24"X36")		1	1				
4+86		●	R8-3(B)-a (24"X36")			1				
6+18		●	R4-2		1					
6+80		●	R4-2			±				
9+30		●	R2-4 (30)-a (36"X48")		1			1		
13+90		●	R4-1			±				
16+79		●	R4-1		1					
21+66		●	"Do Not Pick or Cut Flowers"	1						
23+38	●		R4-2		1					
24+93	●		"Do Not Pick or Cut Flowers"	1						
32+25		●	R4-2			1				
38+78	●		R4-1		1					
41+25 41+25	●		R4-1			1				
51+45		●	R4-1			1				
53+72		●	W2-2		1	1				
54+00	●		R2-1 (45)-a (36"X48")					1		
56+70	●		HVB "Painted Church"	1						
56+75 78	●		R4-2			1				
60+00 80		●	R2-1 (45)-a (36"X48")					1		

STATION	LEFT	RIGHT	TYPE	SIGN TO REMAIN	REMOVE	INSTALL (10 SQ. FT. OR LESS)		INSTALL (GREATER THAN 10 SQ. FT.)		DESTINATION SIGN PANEL (S.F.)
						W/POST	WO/POST	W/POST	WO/POST	
Side Road - Painted Church Rd.										
2+47		●	"Narrow Winding Road"		1	1				
2+57	●		W3-1a		1	1				
S-0160 (2)										
57+16		●	R1-1		1	1				
60+50 55	●		W2-2		1	1				
64+32	●		HVB " Hawaiian Botanical..."	1						
65+00	●		R1-1		1	1				
67+91 75		●	W1-2L		1	1				
67+91 75		●	W13-1 (35)		1		1			
70+24		●	R4-1		1					
70+30	●		R4-1			±				
73+50		●	W1-8			1	1			
74+70		●	W1-8		1	1	1			
75+00	●		R4-2			±				
75+90 95		●	W1-8			1	1			
76+33	●		R4-2		1					
76+50		●	W1-8		1					
76+77 10-90		●	W1-8			1	1			
78+30		●	W1-8			1	1			
79+50		●	W1-8			1	1			
80+70		●	W1-8			1	1			
80+99		●	R4-2		1					
81+90		●	W1-8			1	1			
82+50		●	R4-2			1				
83+10		●	W1-8			1	1			
87+49	●		R4-1		1					
90+98	●		W1-2R		1	1				
90+98	●		W13-1 (35)		1		1			

DESIGNED BY	DATE
DRAWN BY	
CHECKED BY	
IN CHARGE	
NOTED BY	
DATE	

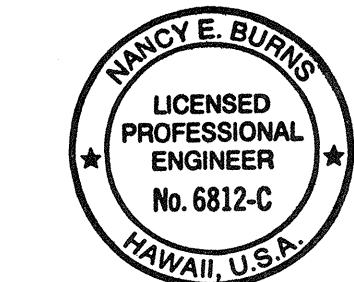

THIS WORK WAS PREPARED BY ME
OR UNDER MY SUPERVISION.
Nancy E. Burns
DATE 5/28/96

STATE OF HAWAII
DEPARTMENT OF TRANSPORTATION
HIGHWAYS DIVISION

SIGN SCHEDULE

KE ALA O KEAWE ROAD RESURFACING
KEOKEA TO PUUHONUA O HONAUNAU
Project No. 160A-01-96M

Scale: None Date: April, 1996

SHEET No. 1 OF 3 SHEETS

SIGN SCHEDULES

SIGN SCHEDULES										
STATION	LEFT	RIGHT	TYPE	SIGN TO REMAIN	REMOVE	INSTALL (10 SQ. FT. OR LESS)		INSTALL (GREATER THAN 10 SQ. FT.)		DESTINATION SIGN PANEL (S.F.)
						W/POST	WO/POST	W/POST	WO/POST	
S-0160 (2)										
92-91+70-20	●		R4-1			1				
100+40		●	R4-1			1				
105+70	●		R4-2			1				
105+94	●		R1-1		1	1				
106+10		●	R1-1		1	1				
106+30		●	R4-2			1				
106+47		●	"Adopt -a-Highway"	1						
106+47		●	"West Hawaii Kiwanis"	1						
106+50	●		"Adopt -a-Highway"	1						
106+50	●		"Rocky's Pizza"	1						
110+80	●		R4-1			1				
120+70		●	R4-1			1				
123+64		●	W1-2R		1	1				
123+64		●	W13-1 (35)		1		1			
125+64		●	R4-1		1					
128+50	●		W1-8			1	1			
130-129+90-00	●		R4-2			1				
130+00-20	●		W1-8			1	1			
131+44	●		R4-2		1					
131+50	●		W1-8			1	1			
133+00	●		W1-8			1	1			
134+50	●		W1-8			1	1			
136+00	●		W1-8			1	1			
137+50	●		W1-8			1	1			
138+84		●	D-8 "Scenic Point" (84"x36")		1			1*		21.00
139+00-10	●		W1-8			1	1			
139+87		●	R4-2		1					
140+50	●		W1-8			1	1			
142+00	●		W1-8			1	1			
143+98	●		R1-1		1	1				

STATION	LEFT	RIGHT	TYPE	SIGN TO REMAIN	REMOVE	INSTALL (10 SQ. FT. OR LESS)		INSTALL (GREATER THAN 10 SQ. FT.)		DESTINATION SIGN PANEL (S.F.)
						W/POST	WO/POST	W/POST	WO/POST	
144+57	●		R4-1		1					
145-144+57		●	W1-2L		1	1				
145-144+57-70		●	W13-1 (35)				1			
146+14	●		R1-1		1	1				
146+86	●		W1-2L		1	1				
146+86	●		W13-1 (35)		1		1			
149+00			W1-8			1	1			
151+00		●	W1-8			1	1			
151+02	●		D-9 "Scenic Point" (84"x36")		1			1*		21.00
153+00		●	W1-8			1	1			
155+00		●	W1-8			1	1			
157+00		●	W1-8			1	1			
159+00		●	W1-8			1	1			
161+00		●	W1-8			1	1			
163+00		●	W1-8			1	1			
165+00		●	W1-8			1	1			
166+28		●	R1-1		1	1				
166+77		●	W1-2R		1	1				
166+77-95		●	W13-1 (35)				1			
167+00		●	W1-8			1	1			
S-0160 (2) Unit 2										
-2+98	●		W6-1		1					
-2+98	●		"Divided Highway"		1					
-2+50	●		W1-8			1	1			
0+00	●		R2-1 (45)-a (36" X 48")					1		
3+00	●		"Do Not Pick or Cut Flowers"	1						
3+98		●	R4-7		1					
3+98		●	"Keep Right"		1					
4+01	●		W6-2		1					

GENERAL	DATE
PLAN	
DRAWN BY	
DESIGNED BY	
NOTED BY	
CHECKED BY	

WANCY E. BURNS
LICENSED PROFESSIONAL ENGINEER
No. 6812-C
HAWAII, U.S.A.

THIS WORK WAS PREPARED BY ME OR UNDER MY SUPERVISION.
Wancy E. Burns
DATE 5/28/96

STATE OF HAWAII
DEPARTMENT OF TRANSPORTATION
HIGHWAYS DIVISION

SIGN SCHEDULE

KE ALA O KEAWE ROAD RESURFACING
KEOKEA TO PUUHONUA O HONAUNAU
Project No. 160A-01-96M

Scale: None Date: April, 1996

SHEET No. 2 OF 3 SHEETS

SIGN SCHEDULES


STATION	LEFT	RIGHT	TYPE	SIGN TO REMAIN	REMOVE	INSTALL (10 SQ. FT. OR LESS)		INSTALL (GREATER THAN 10 SQ. FT.)		DESTINATION SIGN PANEL (S.F.)
						W/POST	WO/POST	W/POST	WO/POST	
S-0160 (2) Unit 2										
4+01	●		"Divided Highway"		1					
8+13		●	RG-1 "Pu'uhonua ..." (192"X48")	1	1					64.00
8+13		●	"Admission \$2.00"	1						
11+62	●		R1-2		1	1				
12+12		●	R1-2		1	1				
14+41	●		"Adopt -a-Highway"	1						
14+41	●		"Rocky's Pizza"	1						
15+16+03+90	●		RG-2 "Pu'uhonua ..." (192"X48")	1	1					64.00
16+03	●		"Admission \$2.00"	1						
20+11+25		●	R2-5b (35)-a (36"X48")					1		
20+42		●	R4-7		1					
20+42		●	"Keep Right"		1					
20+44		●	W6-2		1					
20+44		●	"Divided Highway"		1					
22+49	●		R1-1		1	1				
22+49	●		D-4 "Keala O Keawe" (24"X6")		1	1				
25+11+45		●	R2-1 (35)-a (36"X48")					1		
26+11		●	W5-1		1	1				
27+00	●		W6-1		1					
27+00	●		"Divided Highway"		1					
29+19+25	●		R2-4 (30)-a (36"X48")		1			1		
30+43+30	●		R2-1 (45)-a (36"X48")		1			1		
30+43		●	"End 45 Mile Speed"		1					
30+55+50		●	R-2 "End State Highway" (24"X30")		1	1				
30+61	●		R-1"Begin State Highway" (24"X30")		1	1				
32+00		●	"One Lane Road"	1						
32+00		●	W13-1 (25)				1			

SIGN SCHEDULES

STATION	LEFT	RIGHT	TYPE	SIGN TO REMAIN	REMOVE	INSTALL (10 SQ. FT. OR LESS)		INSTALL (GREATER THAN 10 SQ. FT.)		DESTINATION SIGN PANEL (S.F.)
						W/POST	WO/POST	W/POST	WO/POST	
Side Road, City of Refuge										
0+21	●		R1-1		1	1				
0+60		●	R1-2		1	1				
1+05	●		D-5 "Napoopoo" (114"X66")		1					52.25
5+77	●		R8-3(B)-a (24"X36")		1	1				
5+88		●	S1-1		1	1				
5+88		●	W13-1 (15)		1		1			
6+23		●	R1-1		1	1				
			TOTALS	17-19	80-84	86-82	39	11	0	256.25

* Install (3) flange channel posts per standard plan TE-02.
Installation of the flange channel sign posts will be paid under Item No. 621.5300,
Regulatory and Warning Sign (Greater than 10 Sq. Ft.) with post. Signs will be paid by the sq. ft.

DESIGNED BY	DATE
DRAWN BY	
CHECKED BY	
NOTED BY	
DATE	

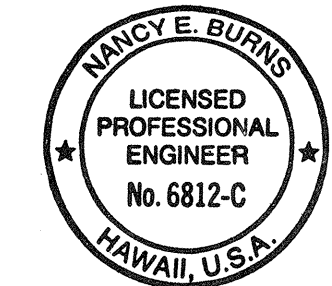

THIS WORK WAS PREPARED BY ME
OR UNDER MY SUPERVISION.
Nancy E. Burns
DATE 5/24/96

STATE OF HAWAII DEPARTMENT OF TRANSPORTATION HIGHWAYS DIVISION
SIGN SCHEDULE
KE ALA O KEAWE ROAD RESURFACING KEOKEA TO PUUHONUA O HONAUNAU Project No. 160A-01-96M
Scale: None Date: April, 1996
SHEET No. 3 OF 3 SHEETS