


INDEX TO DRAWINGS	
SHEET NO.	DESCRIPTION
1	TITLE SHEET
2	STANDARD PLANS SUMMARY
3	GENERAL NOTES AND LEGENDS
4	TYPICAL SECTION AND DETAILS
5-14	ROADWAY PLANS
15-16	MEDIAN ISLAND RECONSTRUCTION DETAIL
17	PAVING FABRIC DETAIL
18	PAVEMENT MARKING LEGEND AND NOTES
19-21	SIGN DETAILS AND NOTES
22-24	SIGN SCHEDULE
① 25-27	REFLECTOR AND OBJECT MARKER SCHEDULE
28	MISCELLANEOUS SCHEDULES
29	CONSTRUCTION SIGN PLAN AND SCHEDULE

Sheet Nos. ① 255-1 and 255-2 are supplementary sheets to this project. Total sheet count after "AS-BUILT" posting 31 shts.


STATE OF HAWAII
DEPARTMENT OF TRANSPORTATION
HIGHWAYS DIVISION
HONOLULU, HAWAII
"AS-BUILT"
PLANS FOR
KE ALA O KEAWE ROAD RESURFACING
KEOKEA TO PUUHONUA O HONAUNAU
PROJECT NO. 160A-01-96M

DISTRICT OF SOUTH KONA
ISLAND OF HAWAII



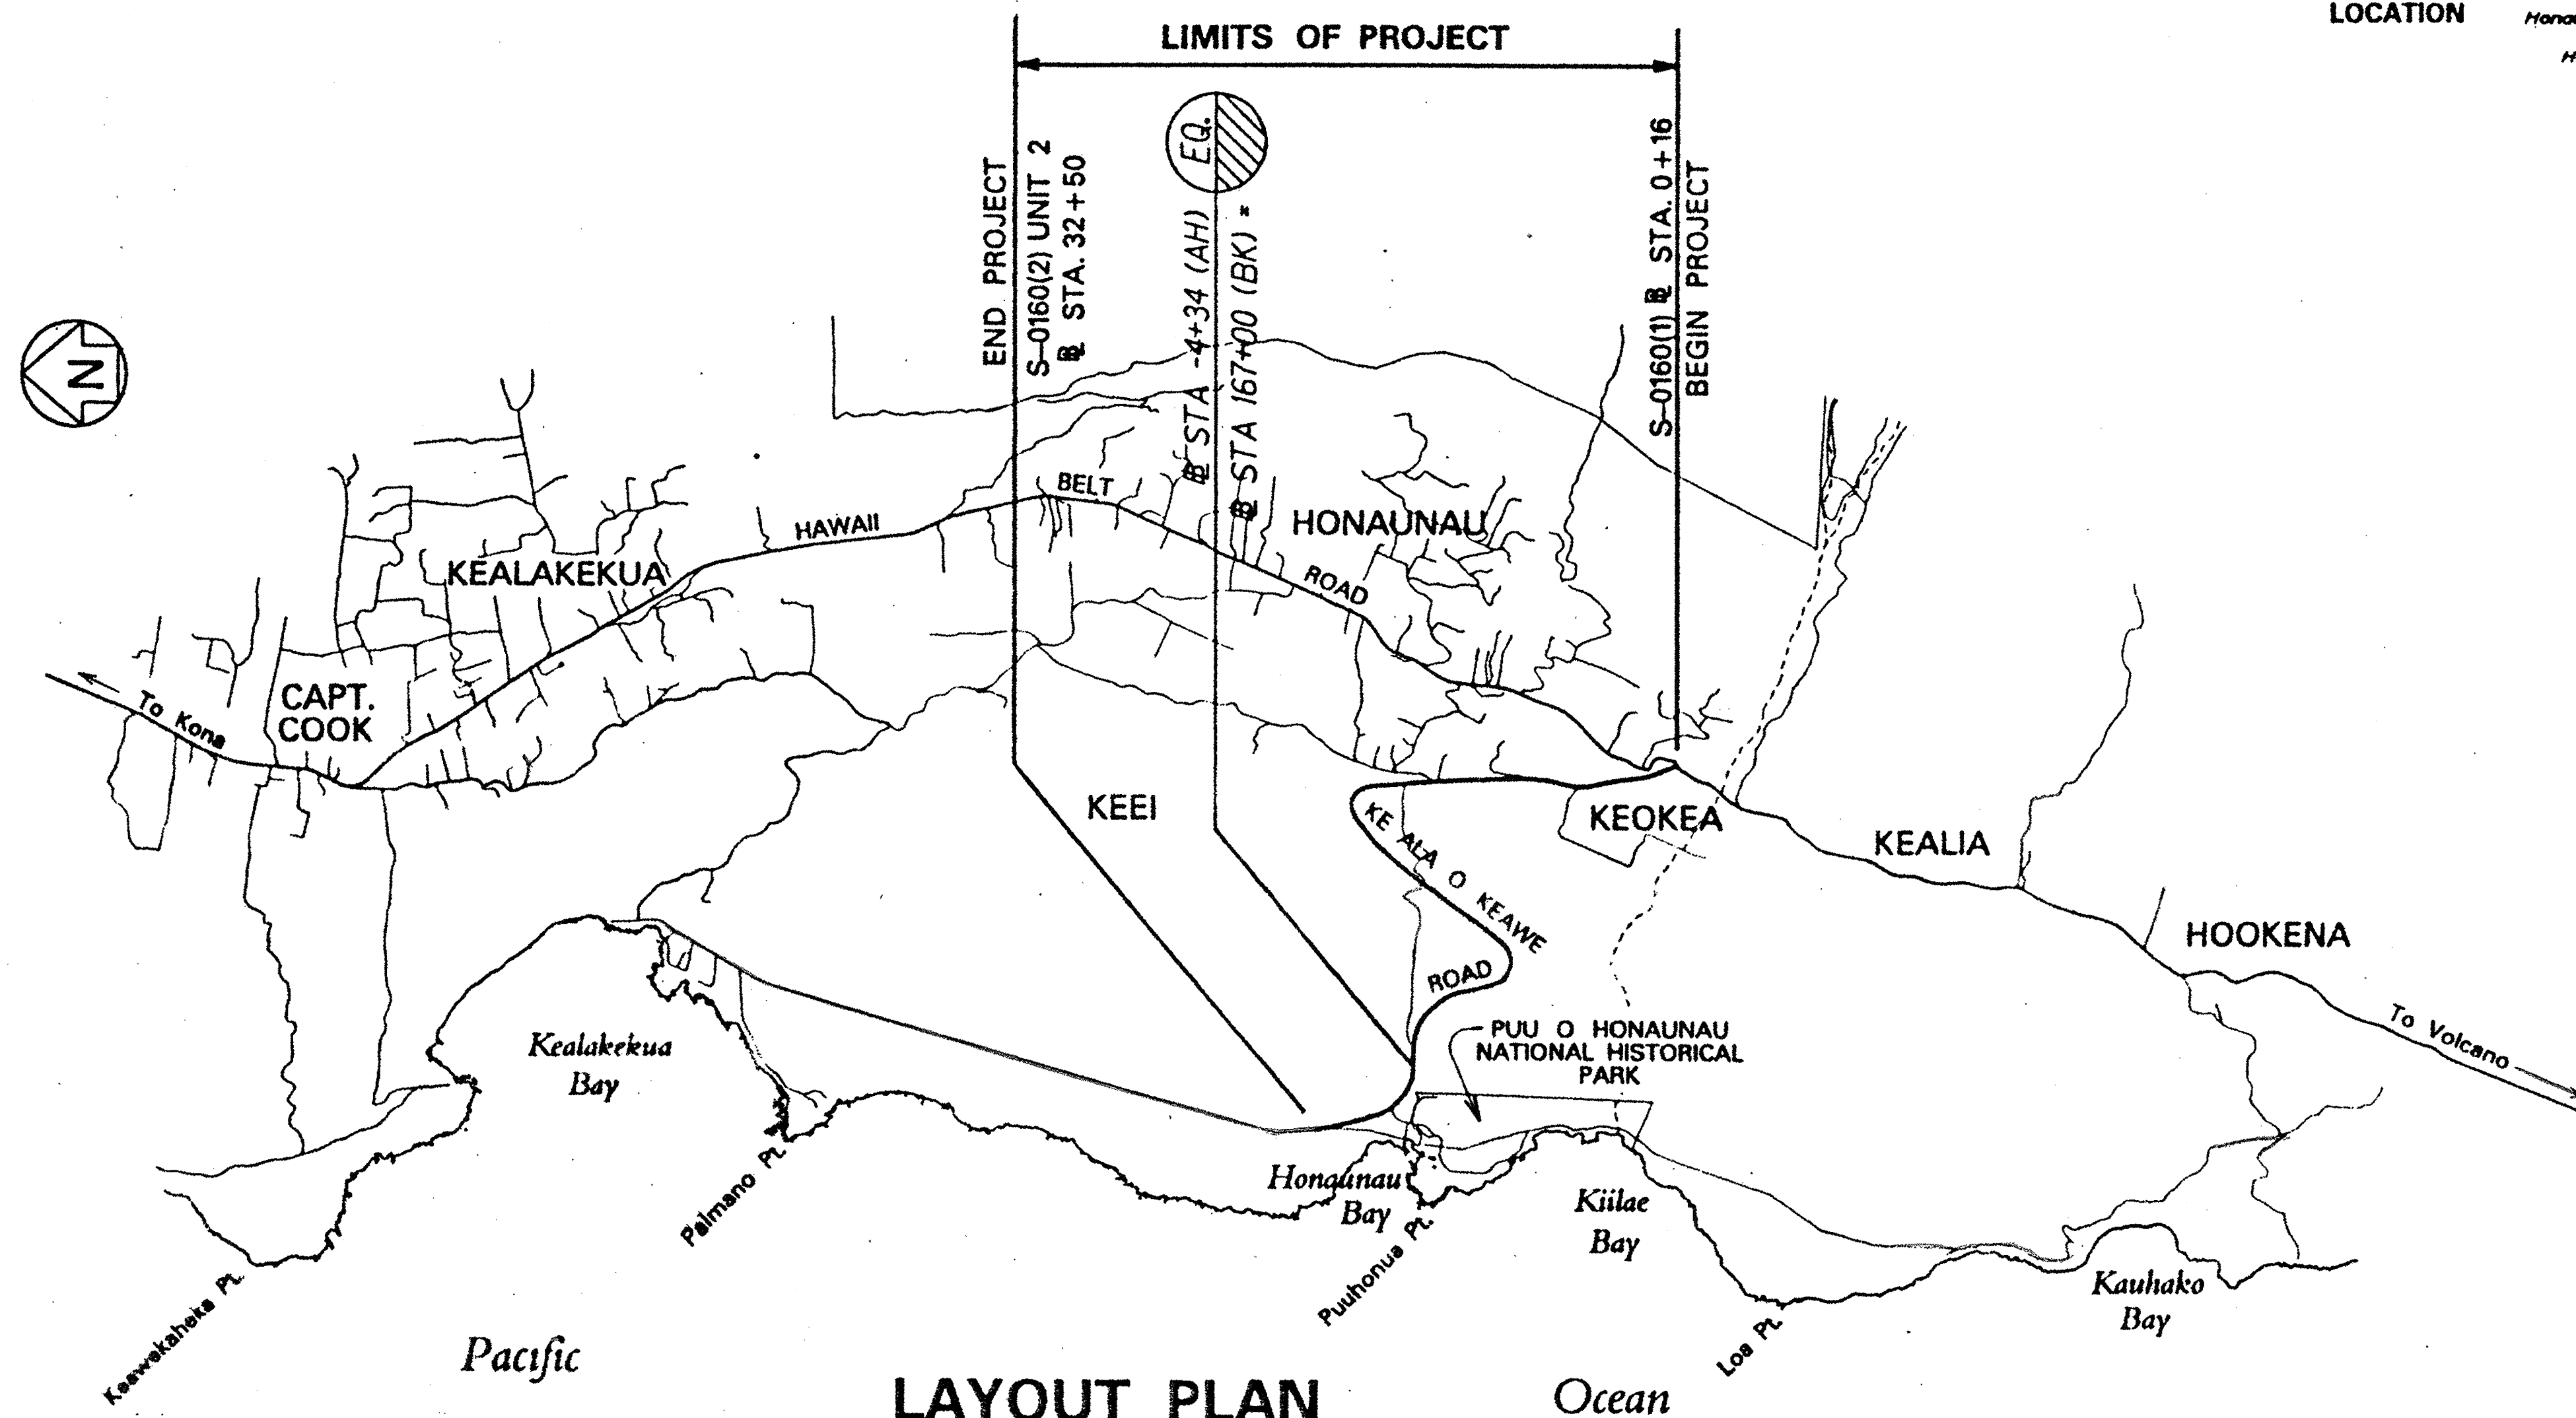


LAYOUT PLAN

NET LENGTH OF PROJECT.....3.85 MILES

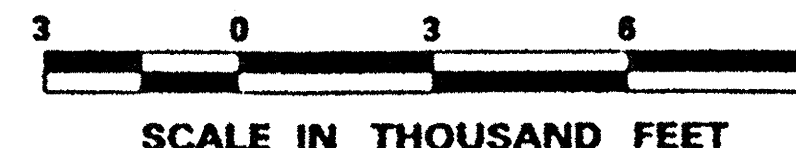

FED. ROAD DIST. NO.	STATE	PROJ. NO.	FISCAL YEAR	SHEET NO.	TOTAL SHEETS
HAWAII	HAW.	160A-01-96M	1996	1	29

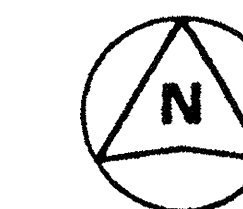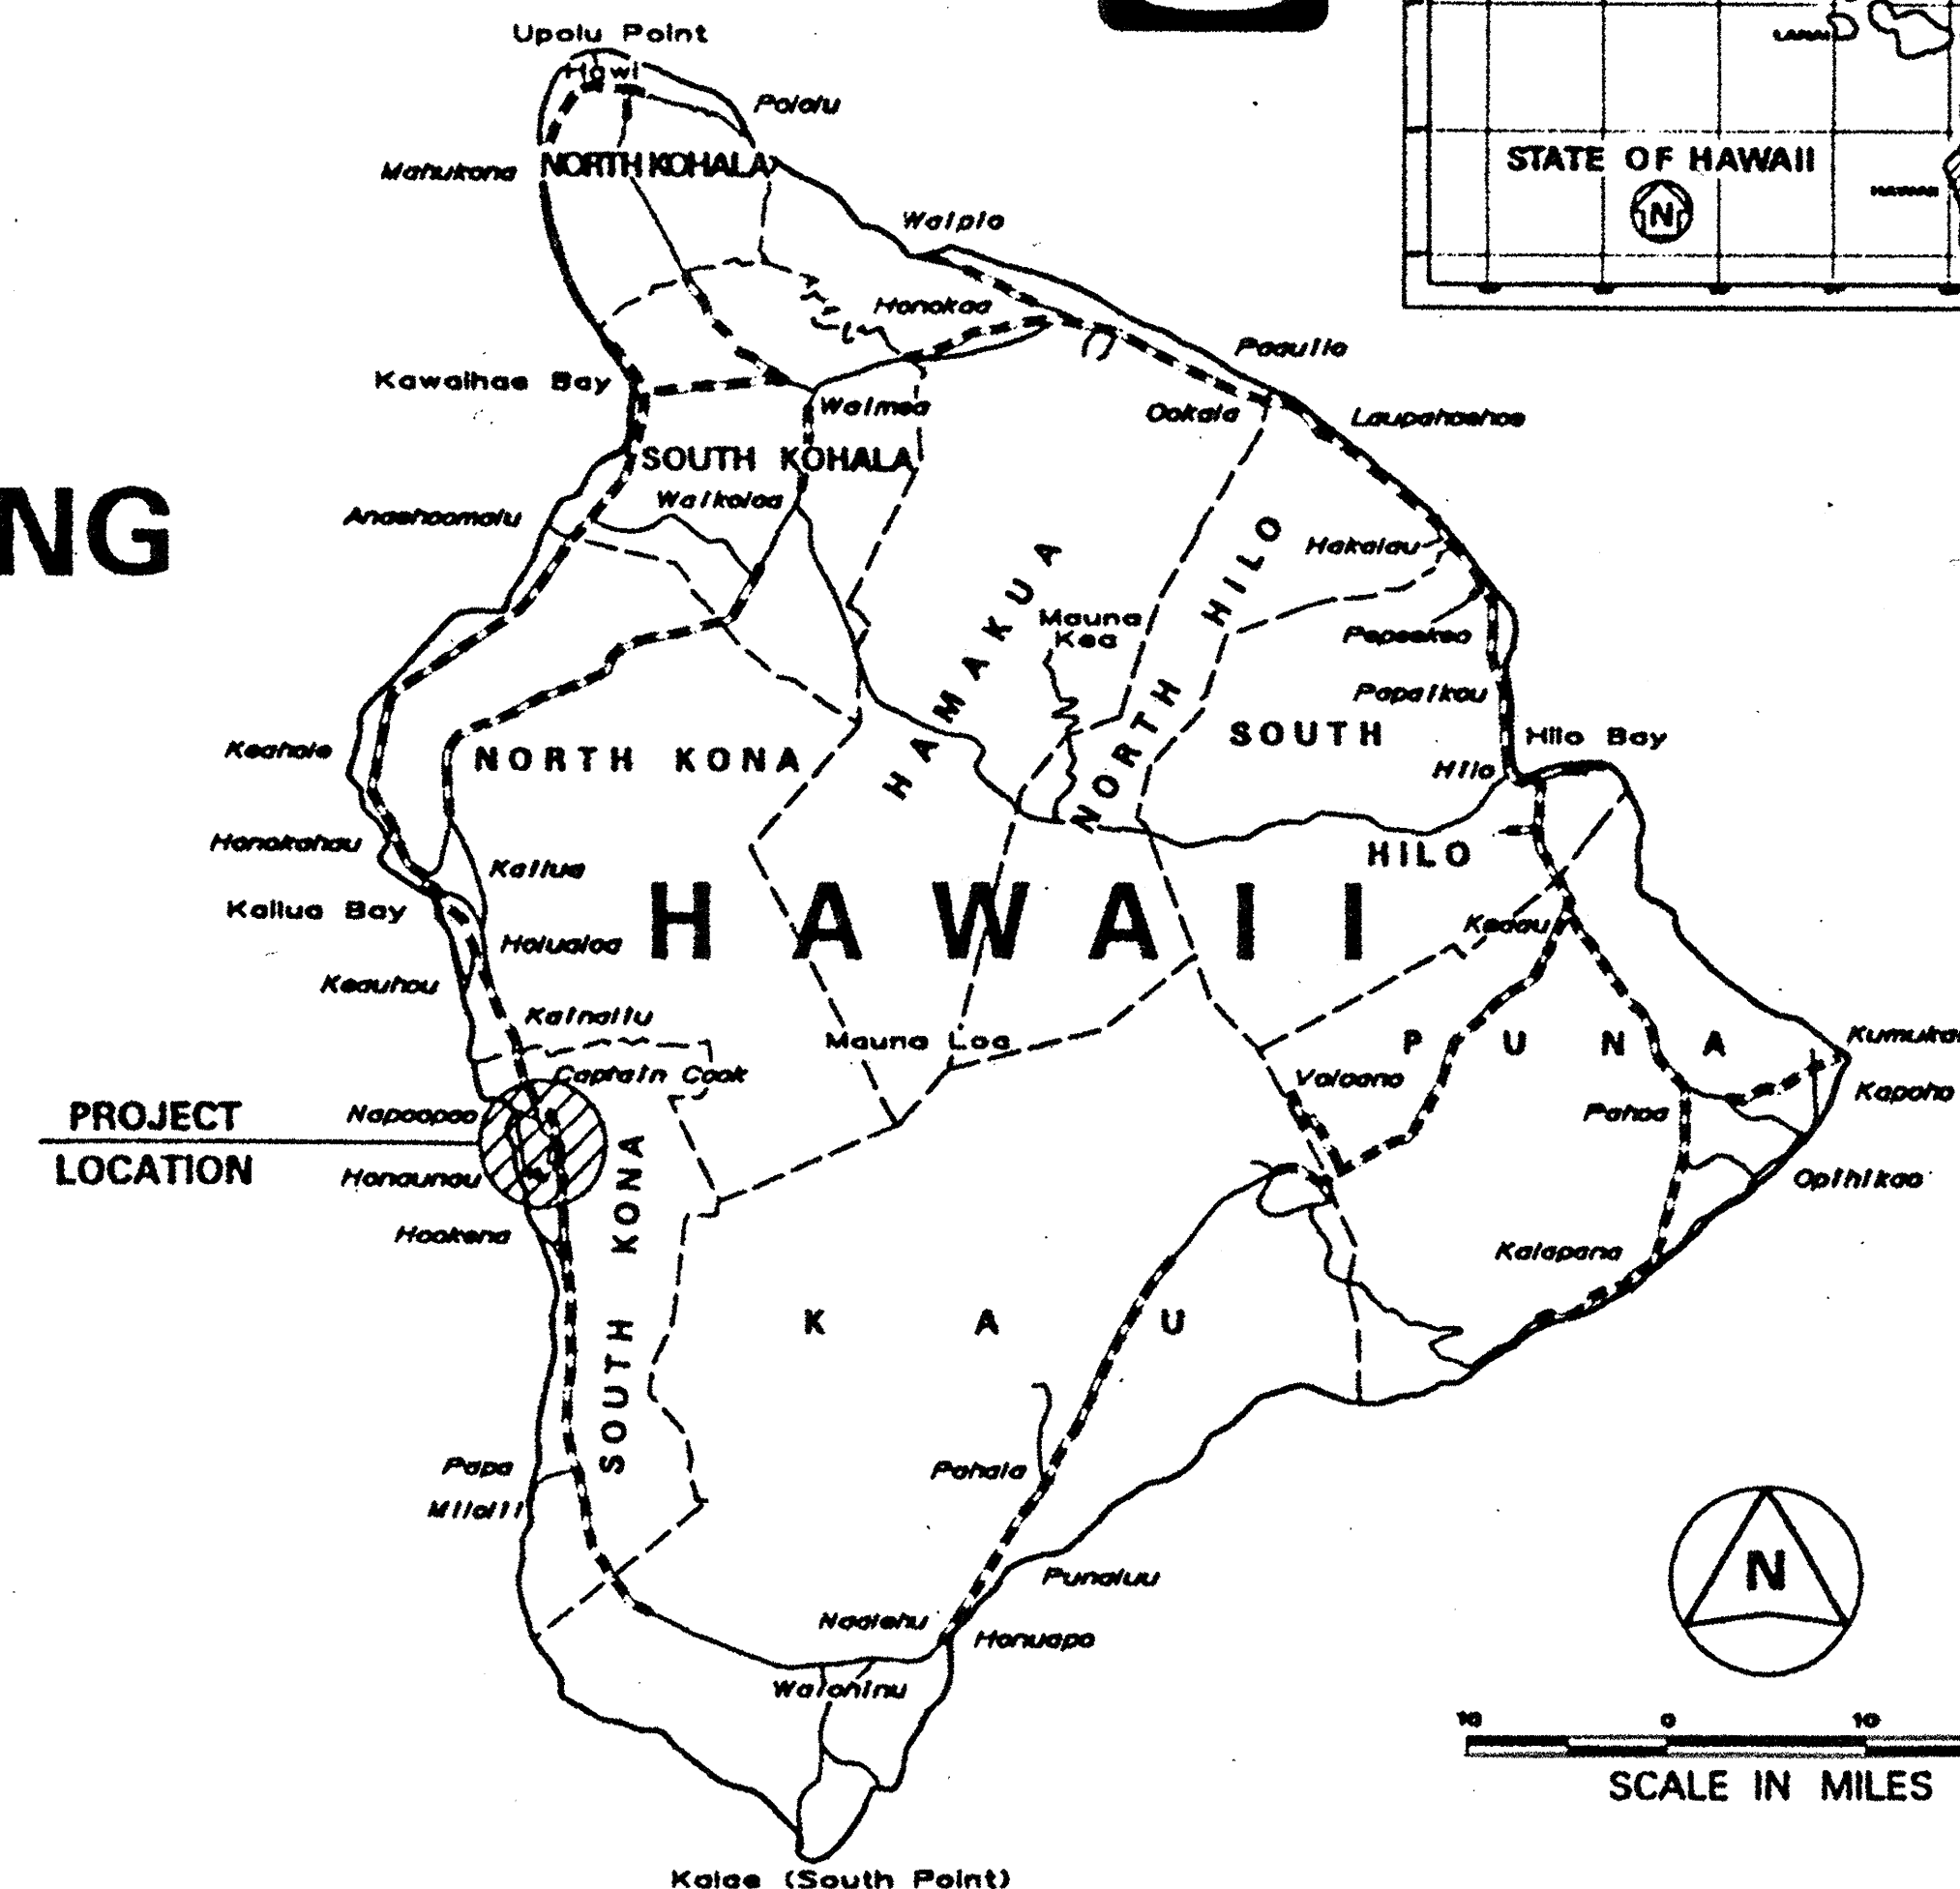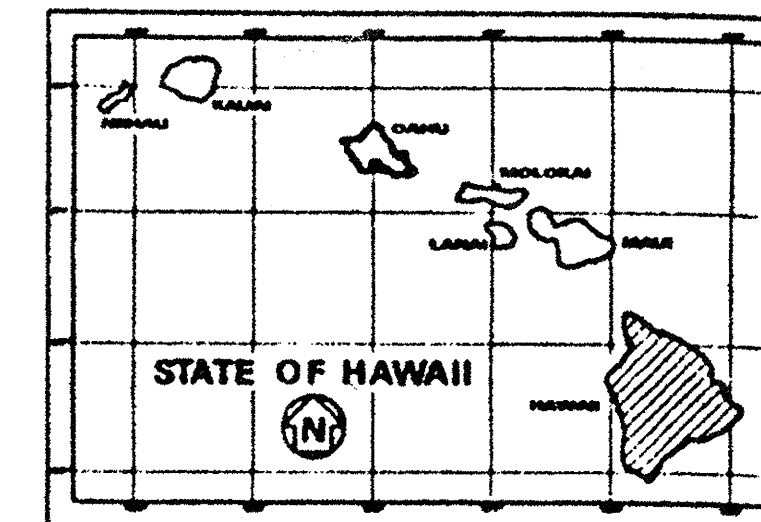

SCALE IN MILES

----- FEDERAL AID PROJECTS PREVIOUSLY CONSTRUCTED OR UNDER CONSTRUCTION

MILE POST 0.00 TO MILE POST 3.85

DESIGN DESIGNATION

ADT (1996).....1600
ADT(2006).....2100
DHV.....230
D.....55/45
T.....3.5%
V.....45 M.P.H.

CHANGES MADE DURING CONSTRUCTION HAVE BEEN INCORPORATED ON THESE PLANS EXCEPT CHANGES IN THE ORIGINAL THEORETICAL QUANTITIES. FOR ACTUAL QUANTITIES, REFER TO PROJECT LEDGER AND/OR COMPUTATION BOOK.

4-13-06
DATE

DEPARTMENT OF TRANSPORTATION
STATE OF HAWAII

APPROVED:
Karyn Kuykendall 5/29/96
DIR. OF TRANSPORTATION DATE

OKAHARA & ASSOC.
DESIGNED BY
R. TAIRA
P. S. & E. BY
933-4640
PHONE
APRIL, 1996
DATE