



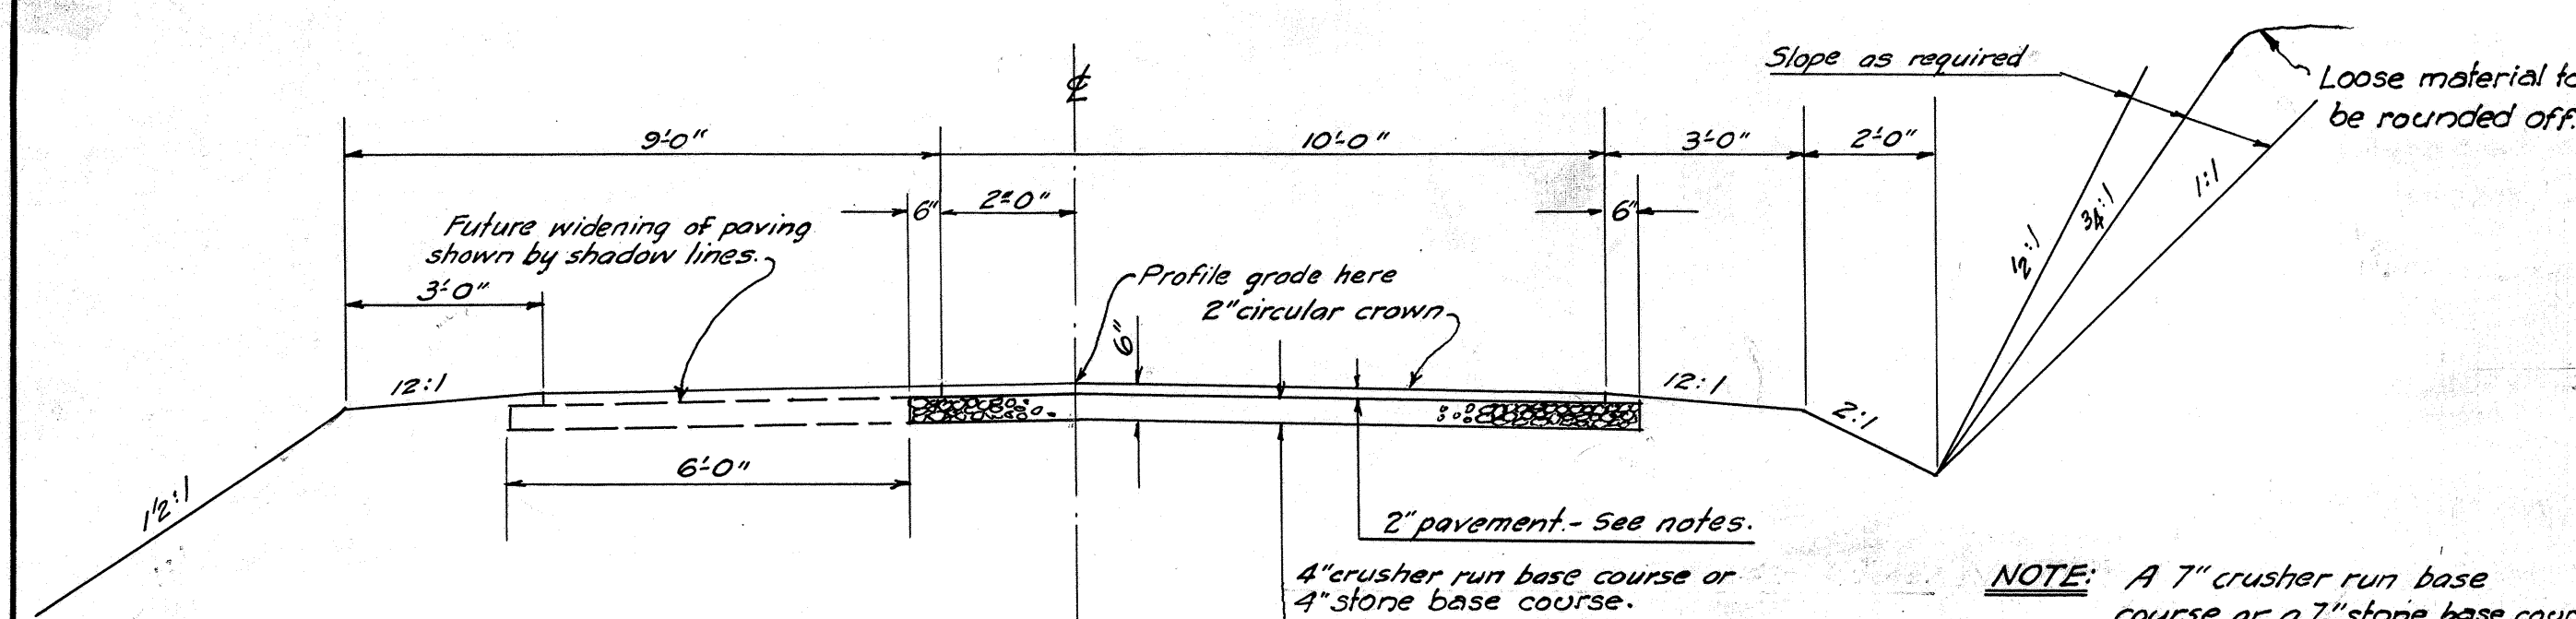

TYPICAL SECTION "A" ON TANGENTS
ALSO USED ON CURVES HAVING NO SUPERELEVATION OR EXTRA WIDTH

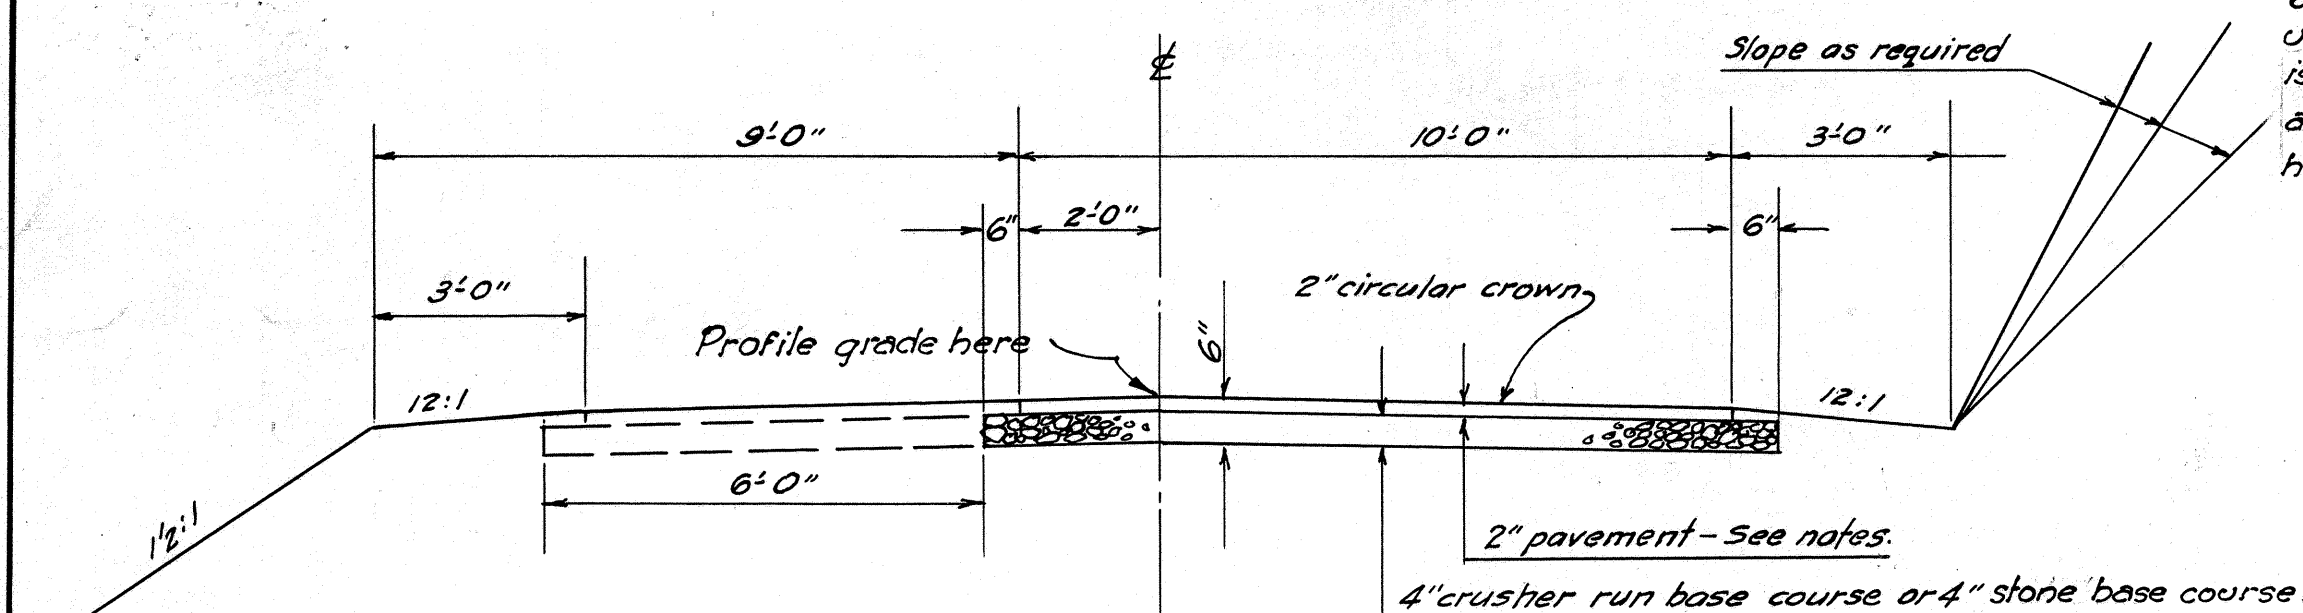


TYPICAL SECTION "B" ON TANGENTS
TO BE USED IN BARE ROCK COUNTRY WHERE DRAINAGE IS NOT REQUIRED — SEE TABULATION OF STATIONS

LOCATION OF SECTION "B"	
Sta. 34+00 to Sta. 395+00	
Sta. 451+00 to Sta. 455+00	
Sta. 464+00 to Sta. 636+00	

NOTES RE PAVEMENT.
PAVEMENT: The 2" Pavement shall be either the "Asphaltic Macadam Surface Course" and "Seal Coat" or a "Cold Emulsified Asphalt Pavement," these being noted below.
ASPHALTIC MACADAM SURFACE COURSE: 2" (compacted thickness) No. 2 Crushed Rock (2" to 1"); 10 lbs. per sq. yd. Asphalt (85-100) and sufficient No. 3 Crushed Rock (1" to 3/8") to cover.
SEAL COAT: 3 to 4 lbs. per sq. yd. Asphalt (85-100) and sufficient No. 6 Crushed Rock (1/4" to 3/8") to cover.
COLD EMULSIFIED ASPHALT PAVEMENT: 2" (compacted thickness) No. 2 Crushed Rock (2" to 1") filled to within one inch of its top with No. 5 Crushed Rock (3/8" to 1/2"); 7 1/2 gal. per sq. yd. of Emulsion; sufficient No. 4 Crushed Rock (1/2" to 3/4") to key surface; 1 to 1 1/2 gal. per sq. yd. of Emulsion; sufficient No. 5 Crushed Rock (3/8" to 1/2") to complete surface keying; 2 1/2 gal. per sq. yd. of Emulsion and sufficient No. 6 Crushed Rock (1/4" to 3/8") to cover.
NOTE: Particular reference is made to the specifications covering these items of work.


TYPICAL SECTION ON CURVES
SHOWING SUPERELEVATION AND EXTRA WIDTH WITH PAVED SECTION ON OUTSIDE

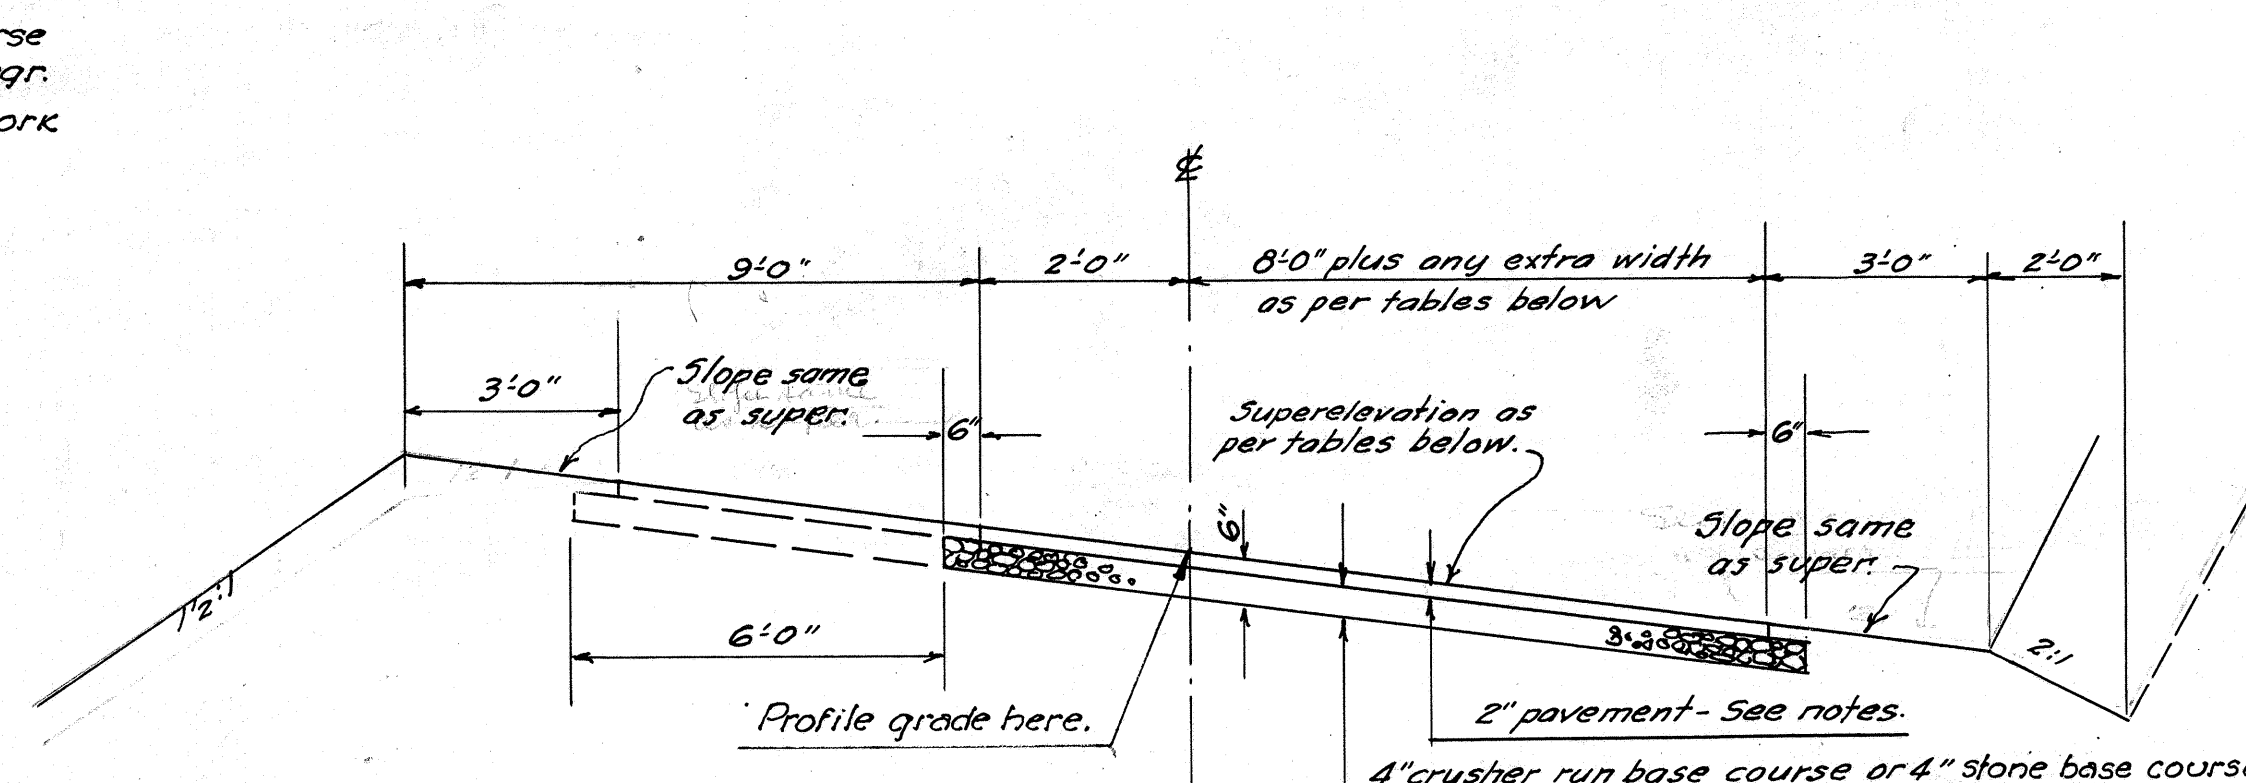


TYPICAL SECTION ON CURVES
SHOWING SUPERELEVATION AND EXTRA WIDTH WITH PAVED SECTION ON INSIDE




DETAIL SHOWING TREATMENT OF CUT SLOPES WITH HAND LAID RIPRAP.

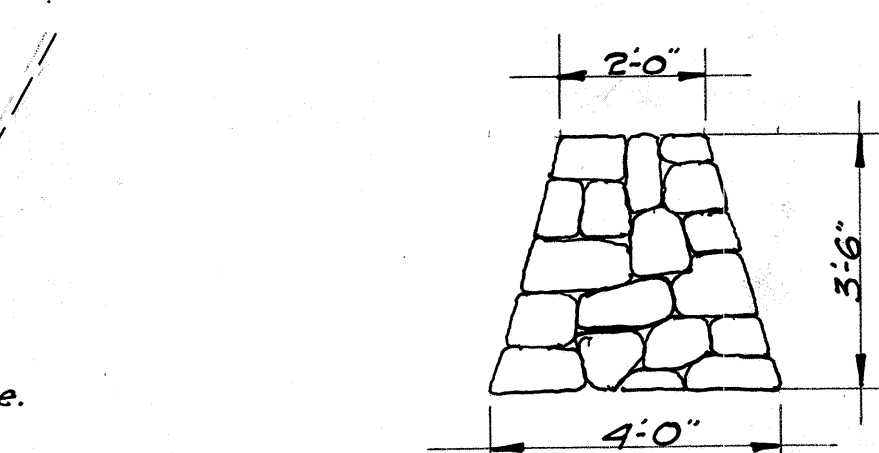

DETAIL OF NEW STONE WALL FENCE ALSO RECONSTRUCTED STONE WALL FENCE.

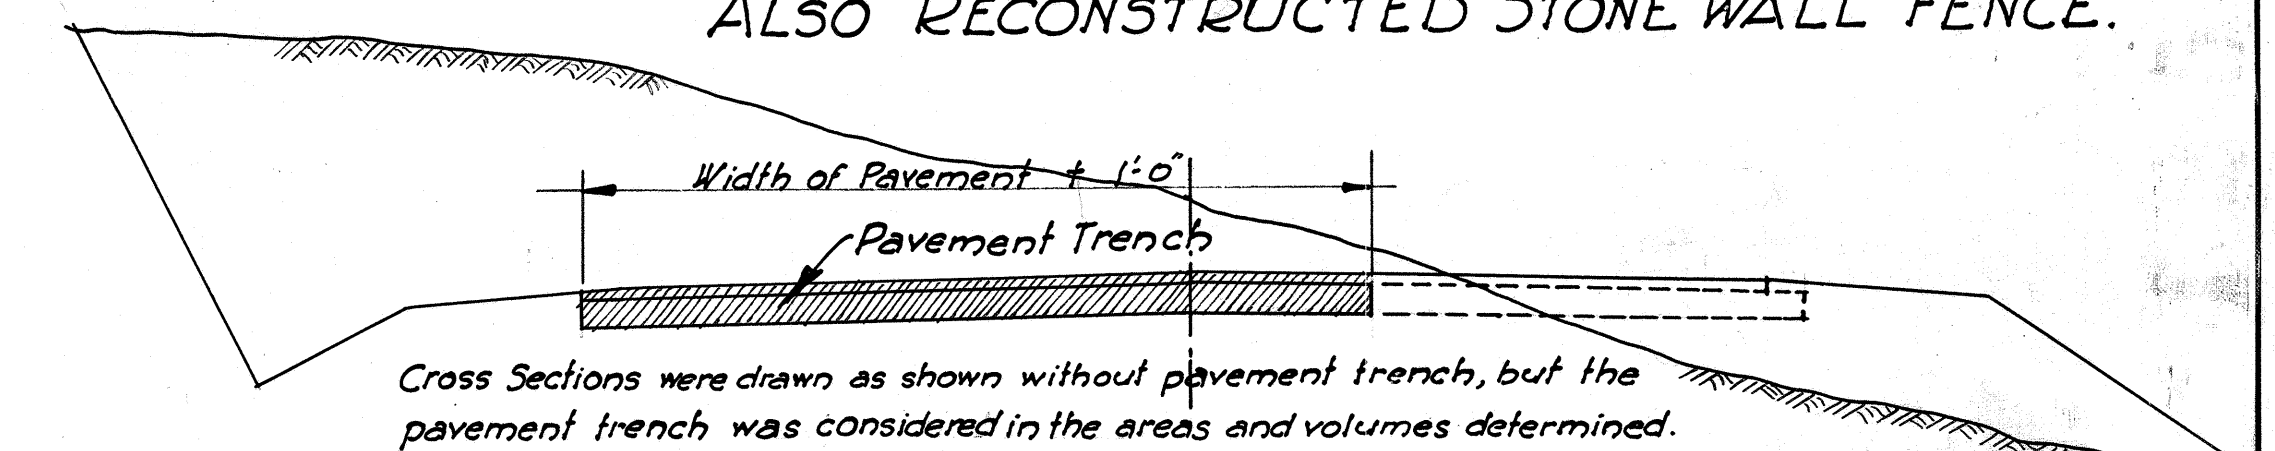

EXPLANATION OF CROSS-SECTIONS.

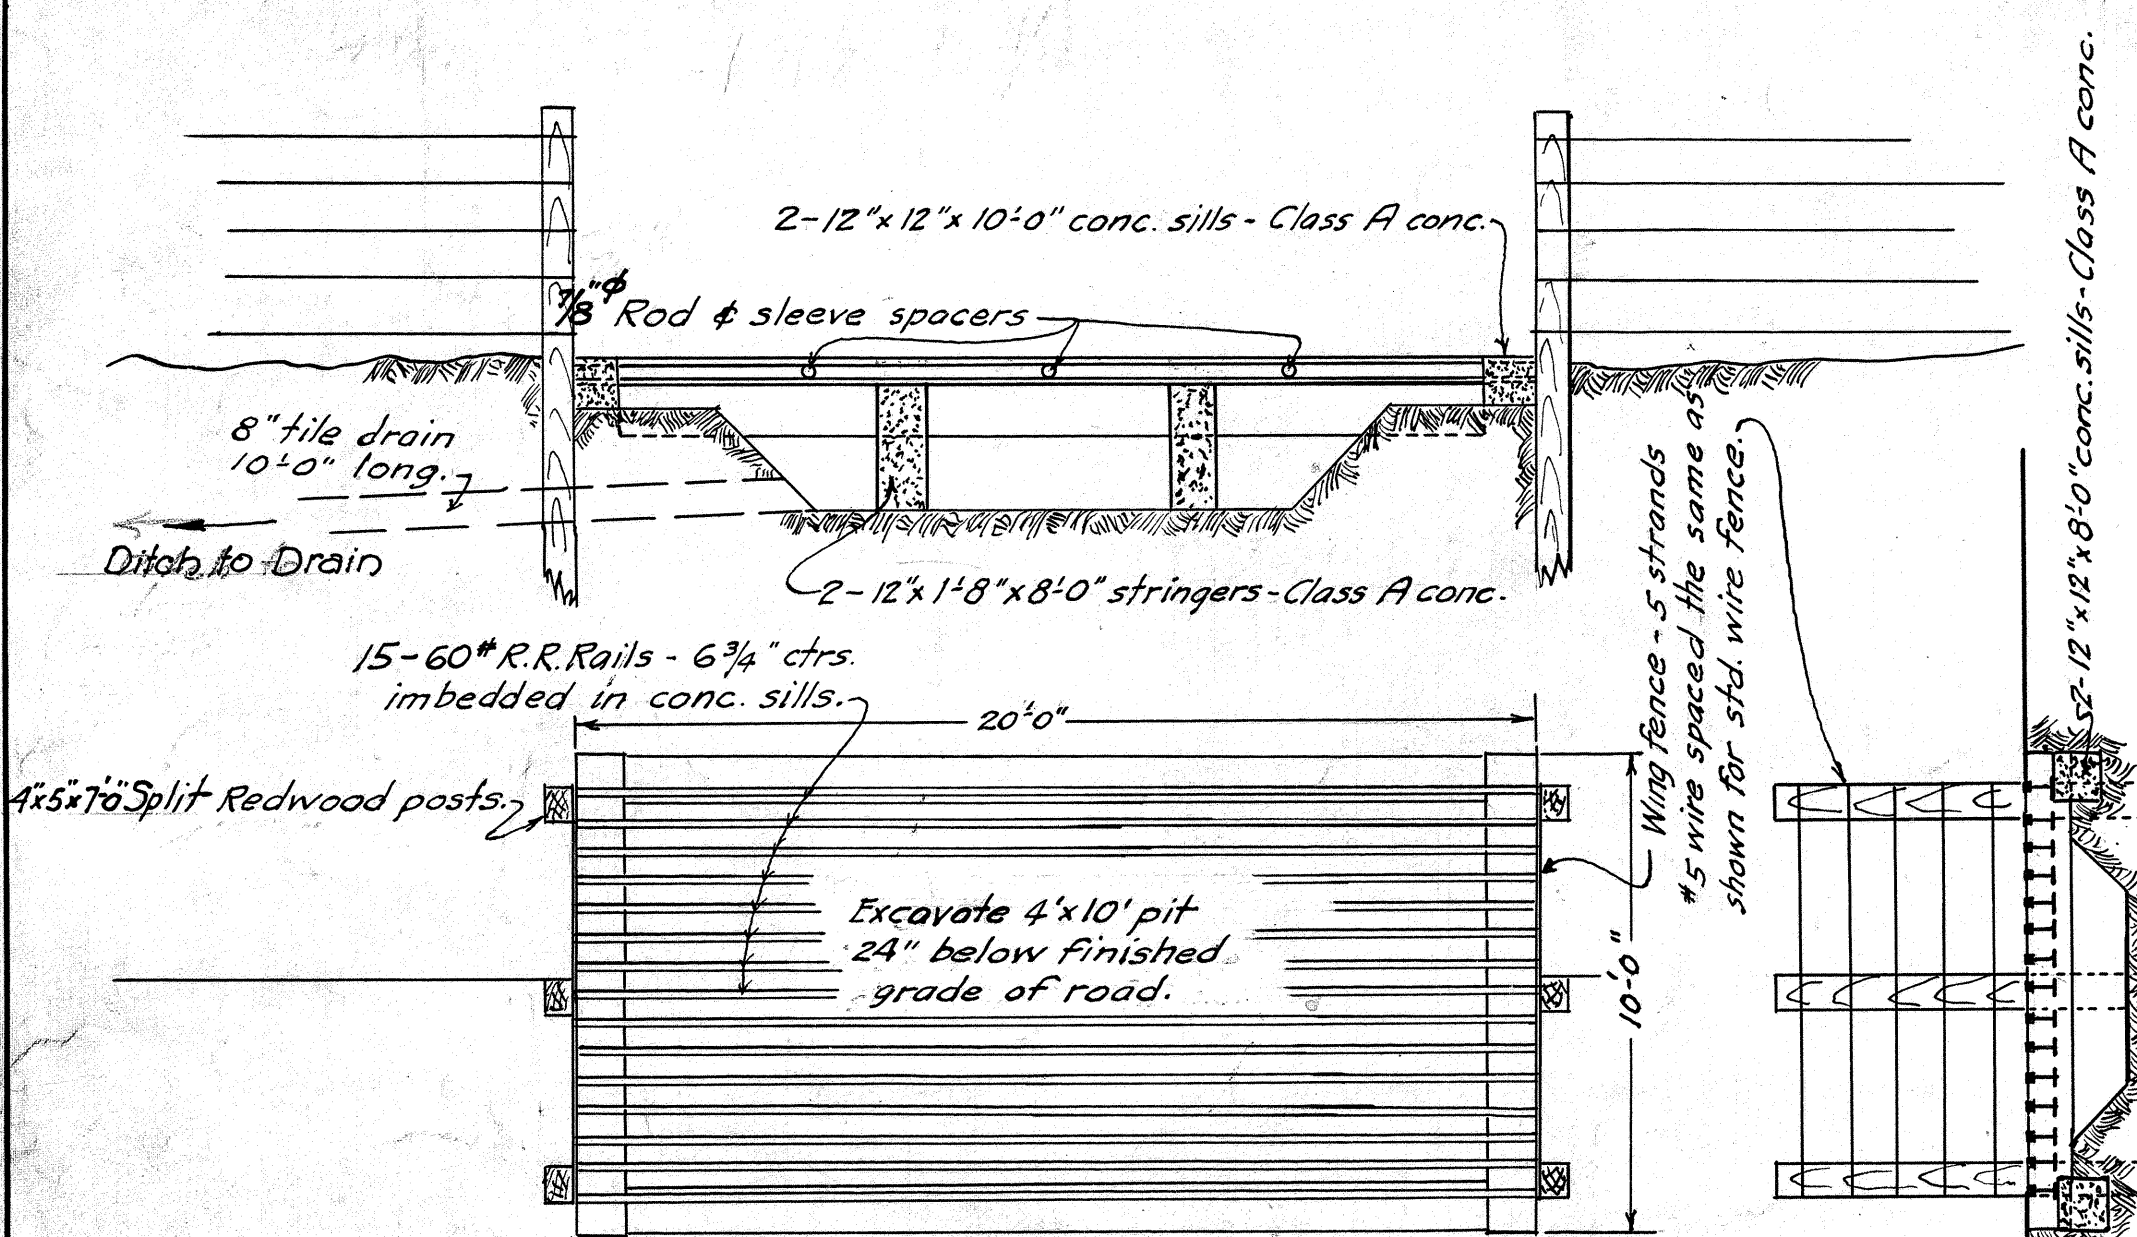

DETAILS OF CATTLE GUARD