
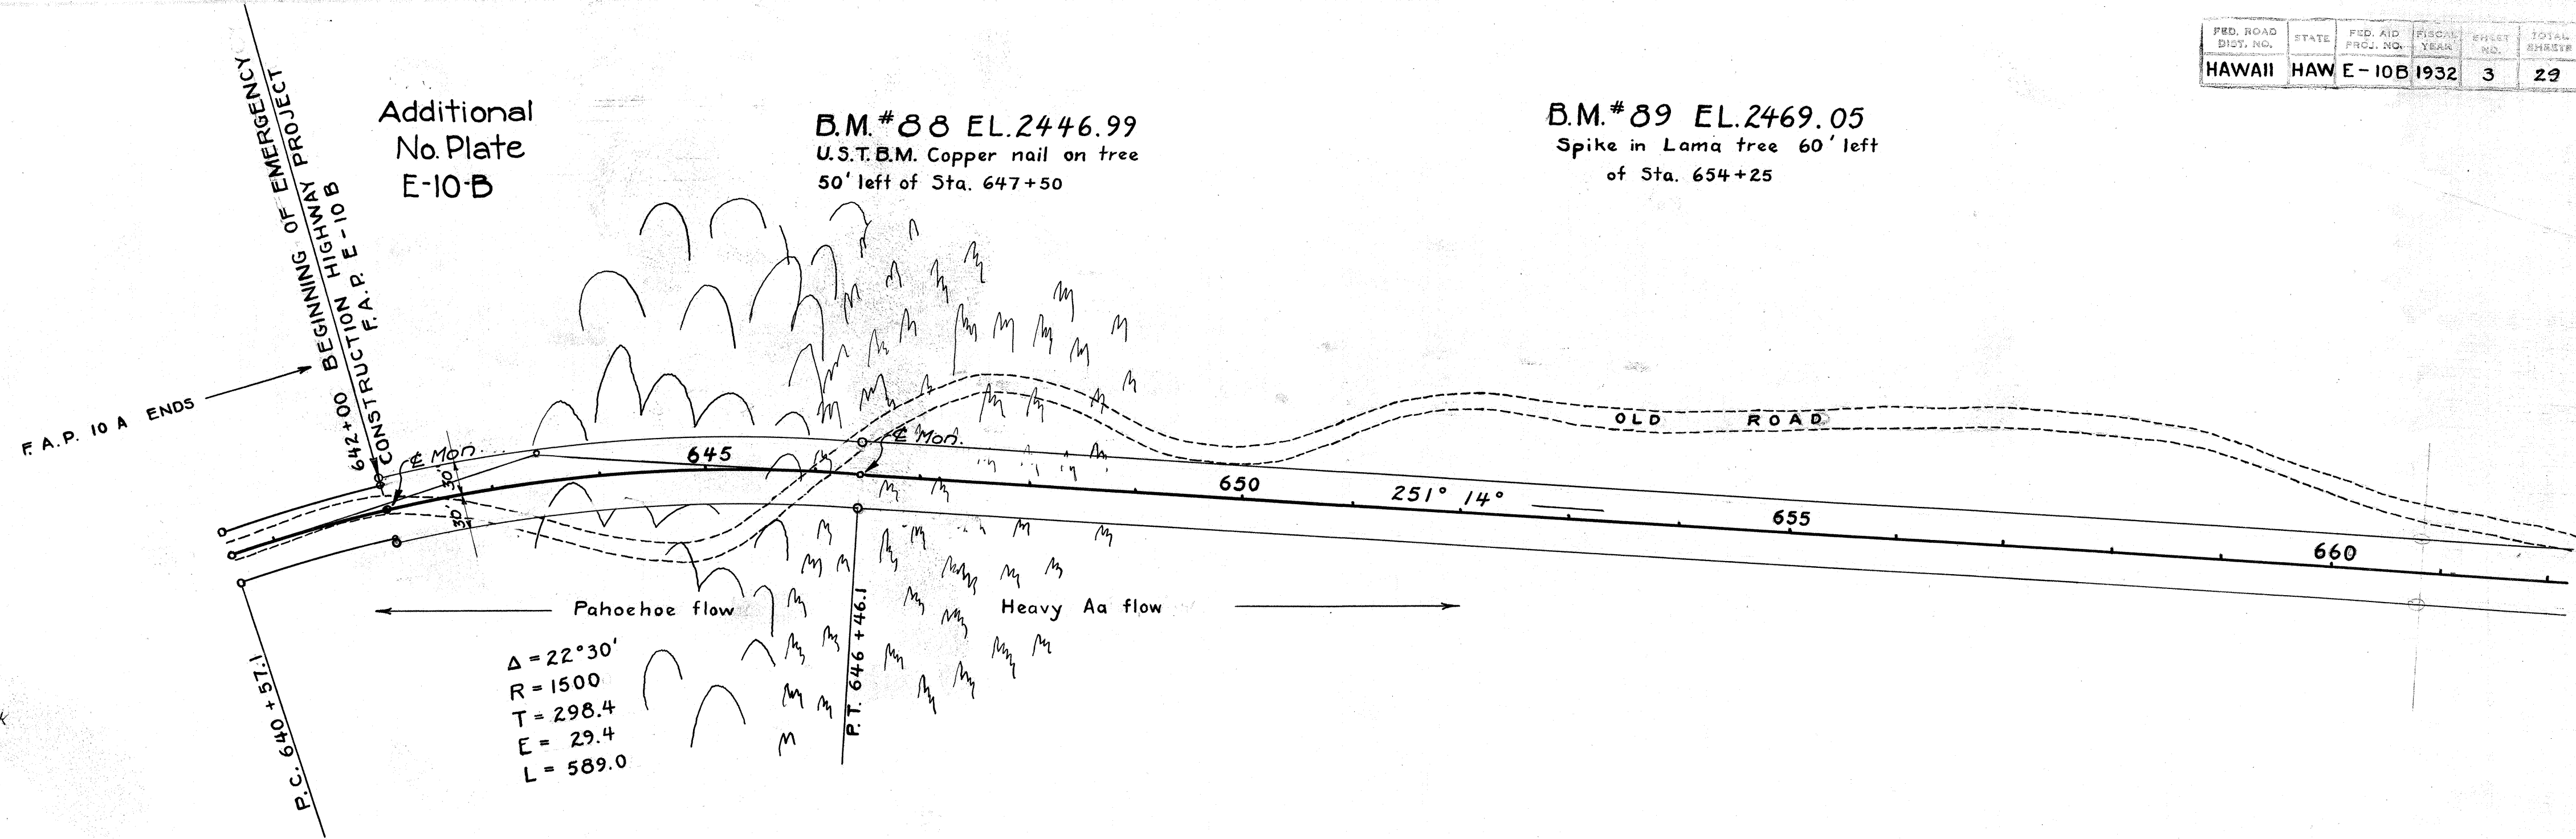



FED. ROAD DIST. NO.	STATE	FED. AID PROJ. NO.	FISCAL YEAR	SHEET NO.	TOTAL SHEETS
HAWAII	HAW	E-10B	1932	3	29

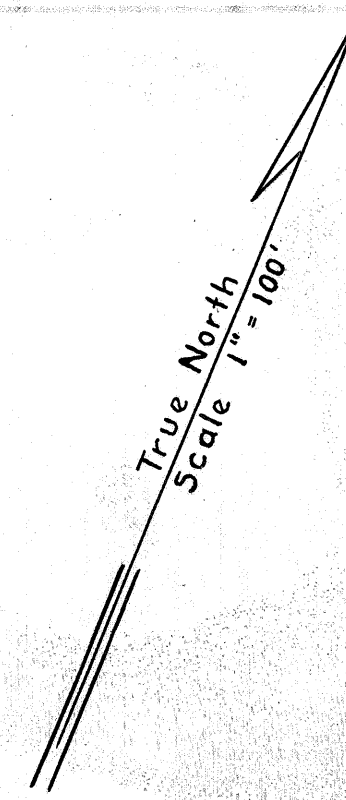

Note:
All notations in red ink
indicate changes during
construction.

Pahoe flow 636+00 to 646+00 +20%

Heavy Aa flow 646+00 to 698+00

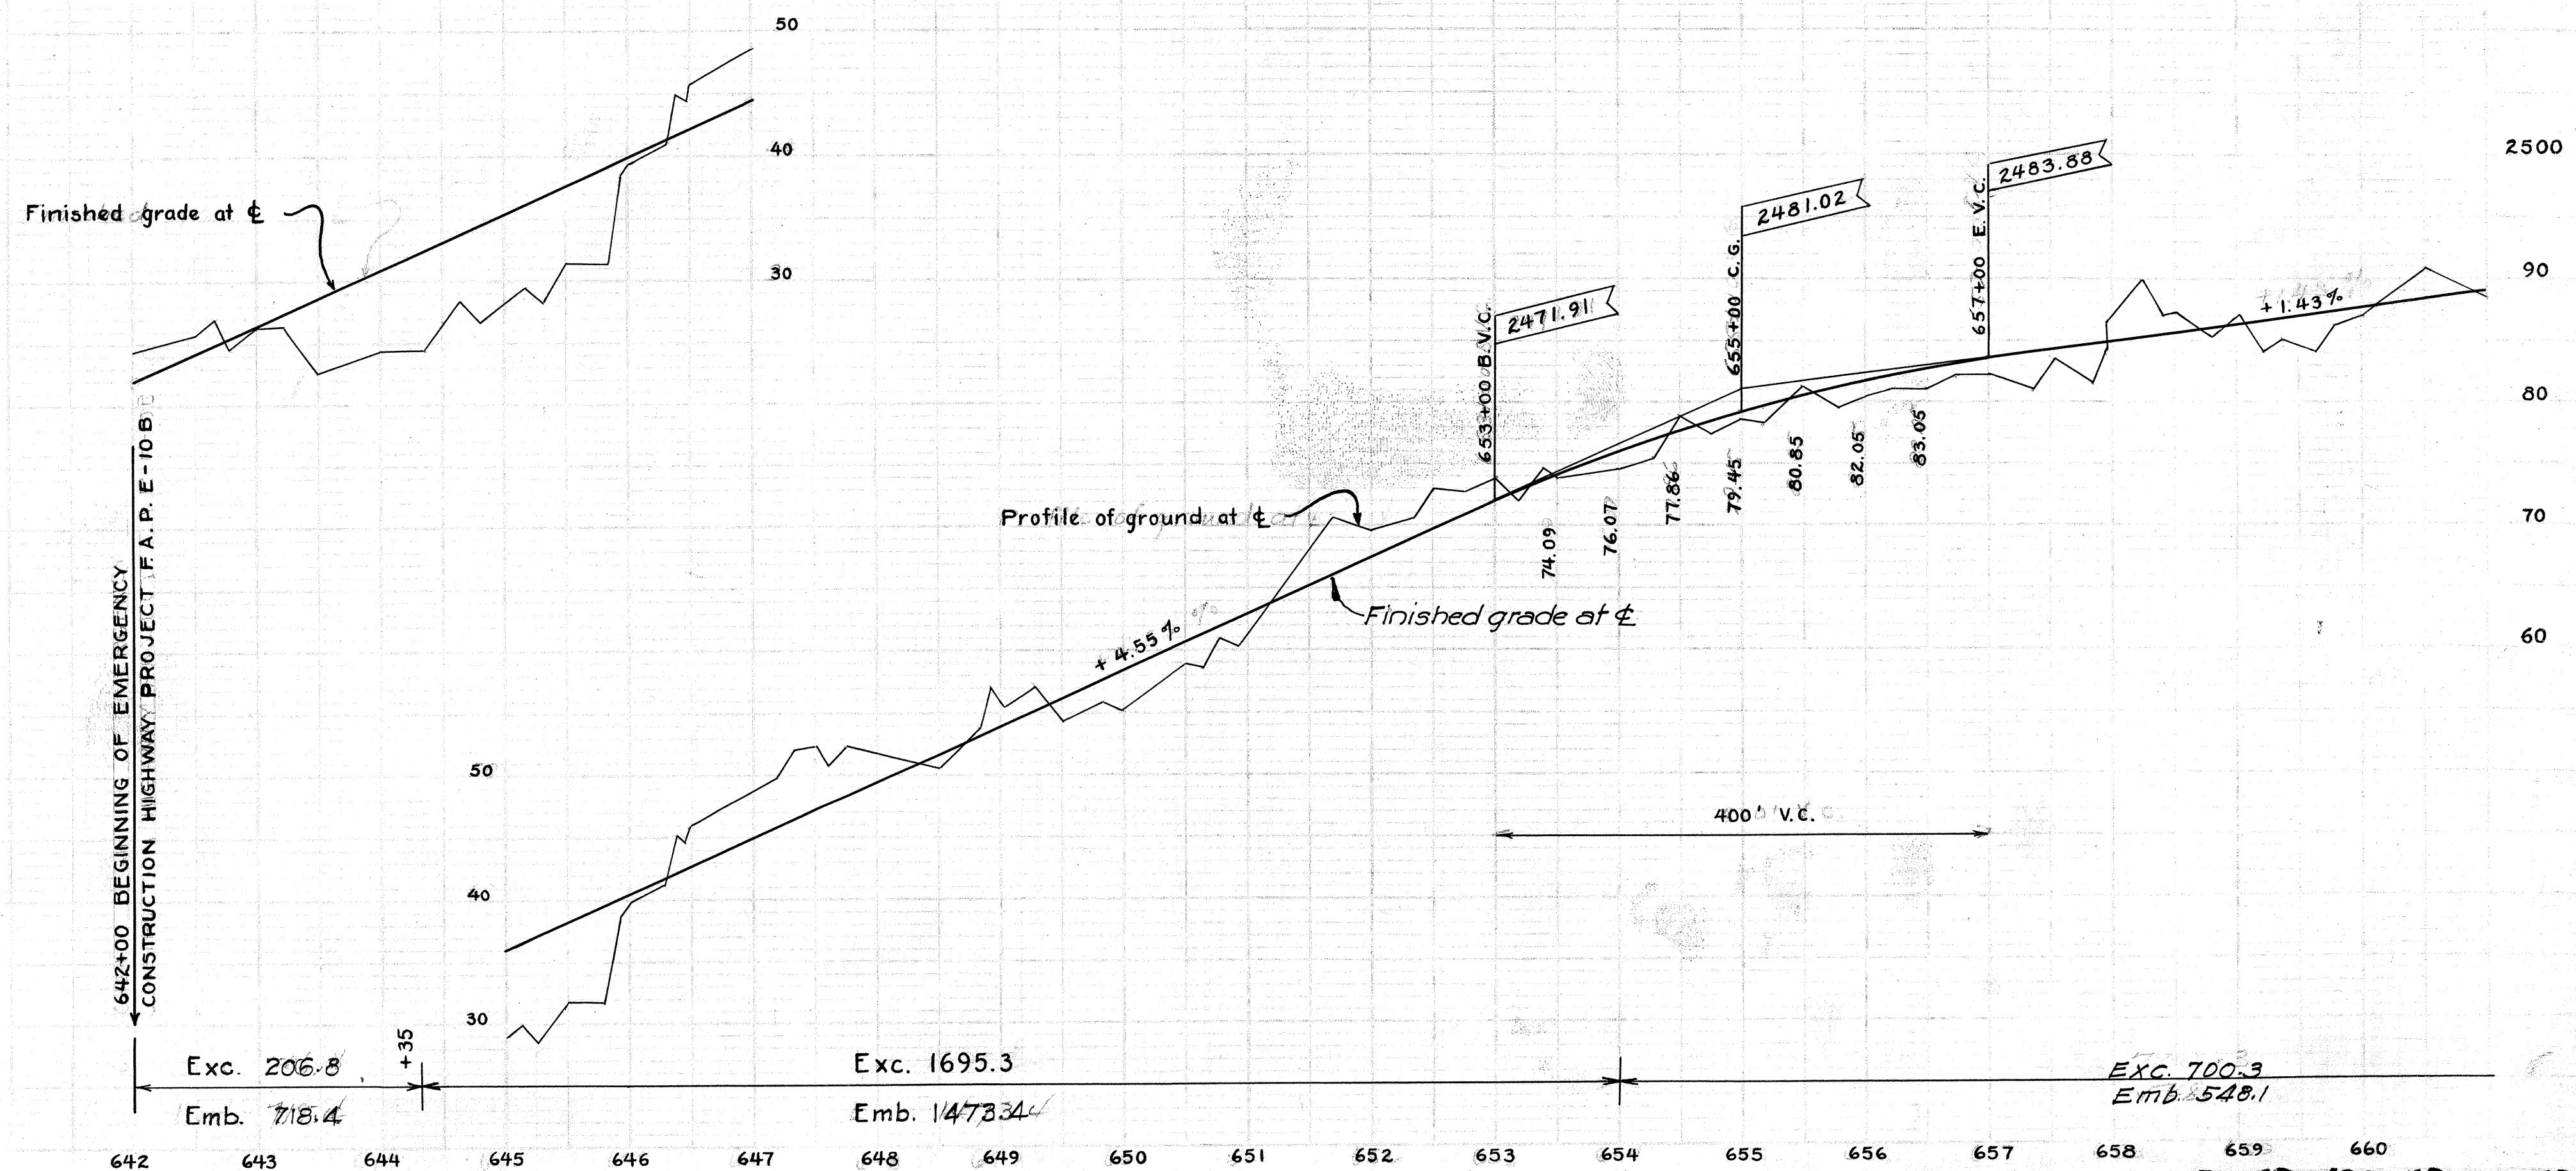

Exc. 700.3
Emb. 548.1



4273.3

4 2 7 3 . 4

FED. ROAD DIST. NO.	STATE	FED. AID PROJ. NO.	FISCAL YEAR	SHEET NO.	TOTAL SHEETS
HAWAII	HAW	E-10B	1932	5	29



PLAN
SURVEYED BY
DATE
BY
CHECKED BY
DATE
BY

PROFILE
SURVEYED BY
DATE
BY
CHECKED BY
DATE
BY

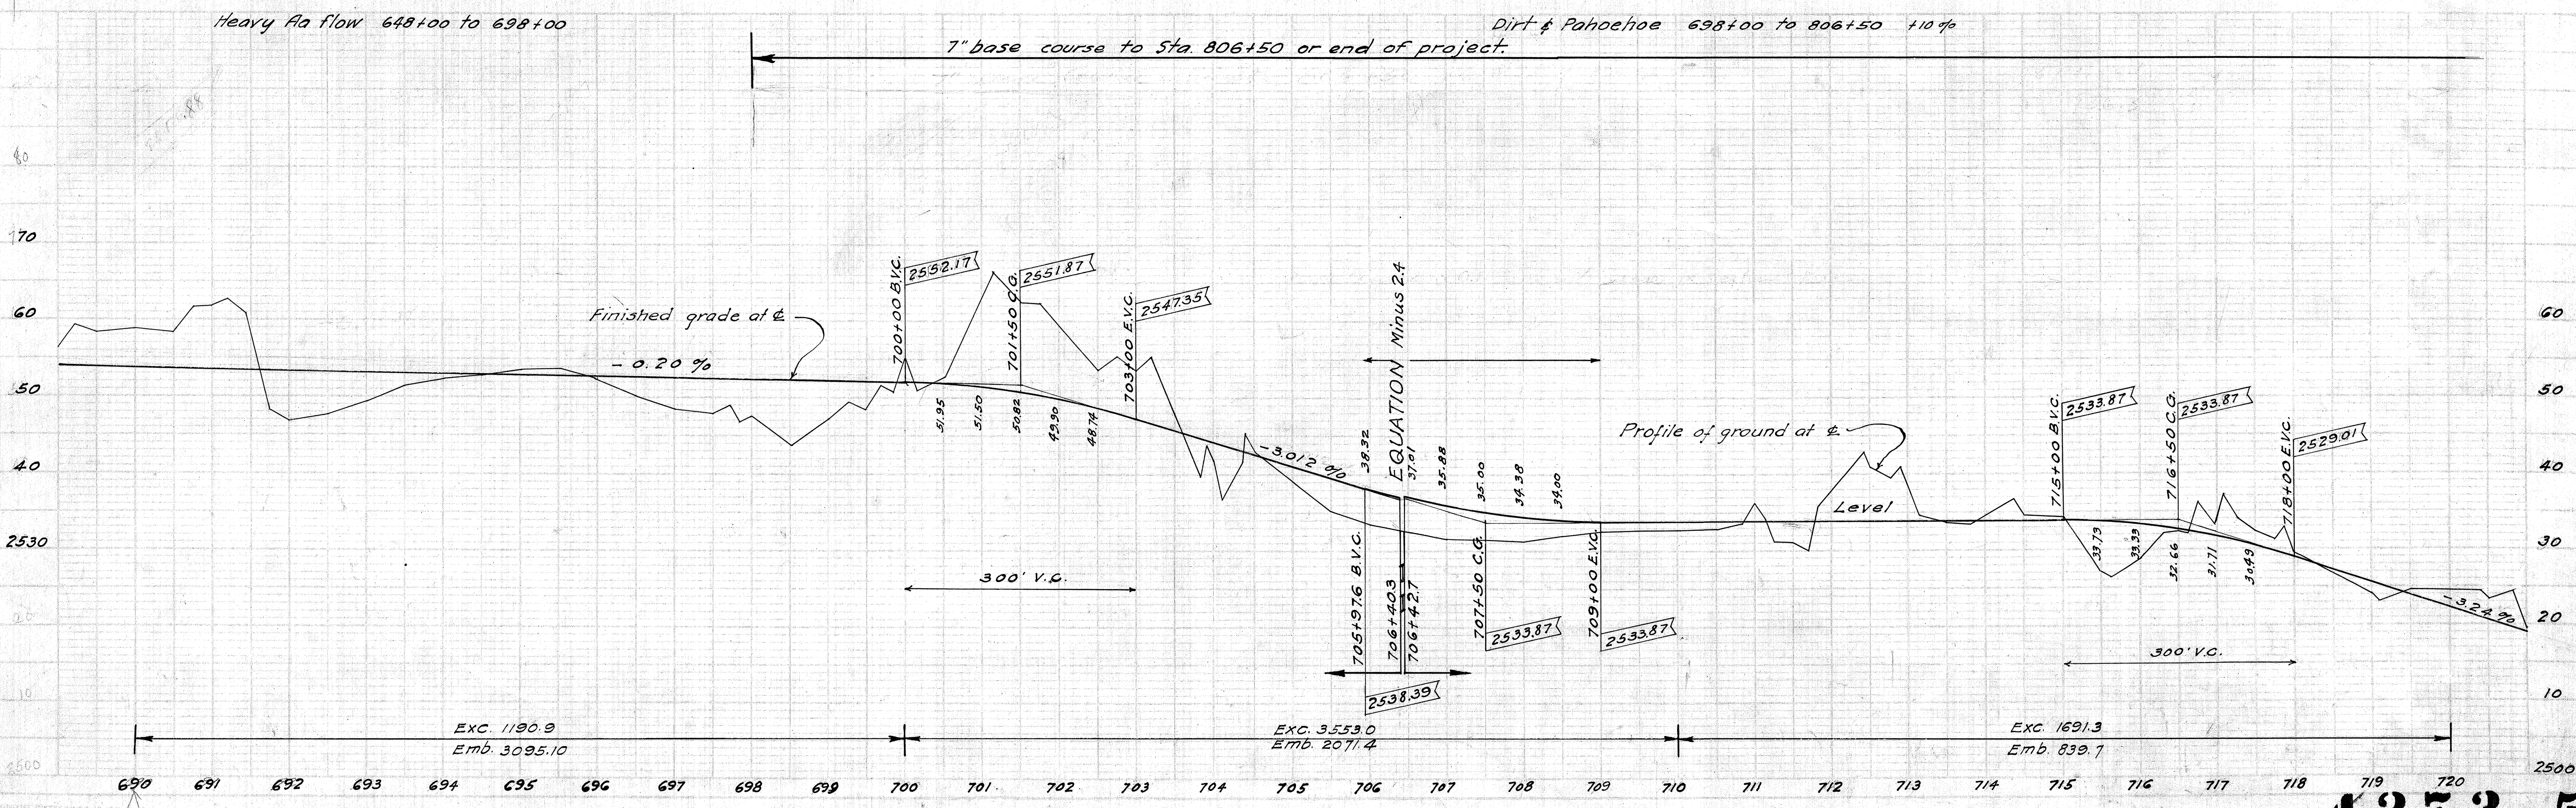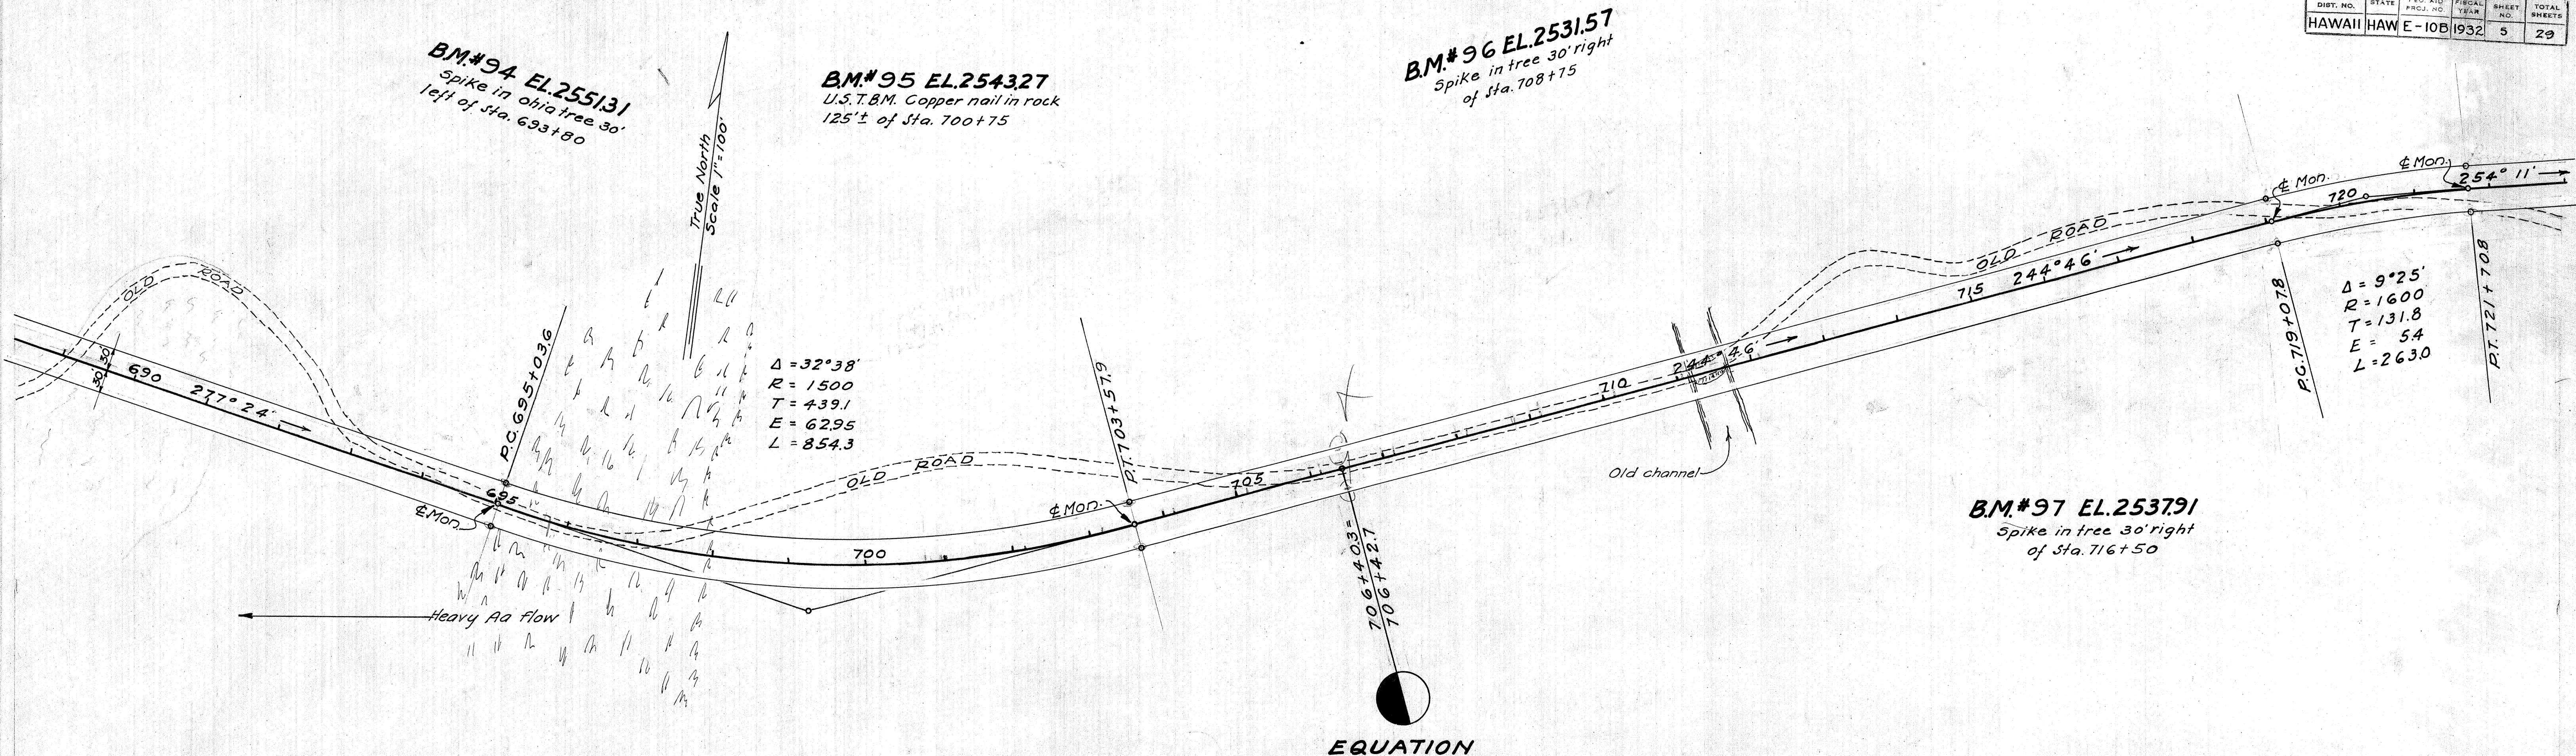



4273.5

FED. ROAD DIST. NO.	STATE	FED. AID PROJ. NO.	FISCAL YEAR	SHEET NO.	TOTAL SHEETS
HAWAII	HAW	E-10B	1932	6	29

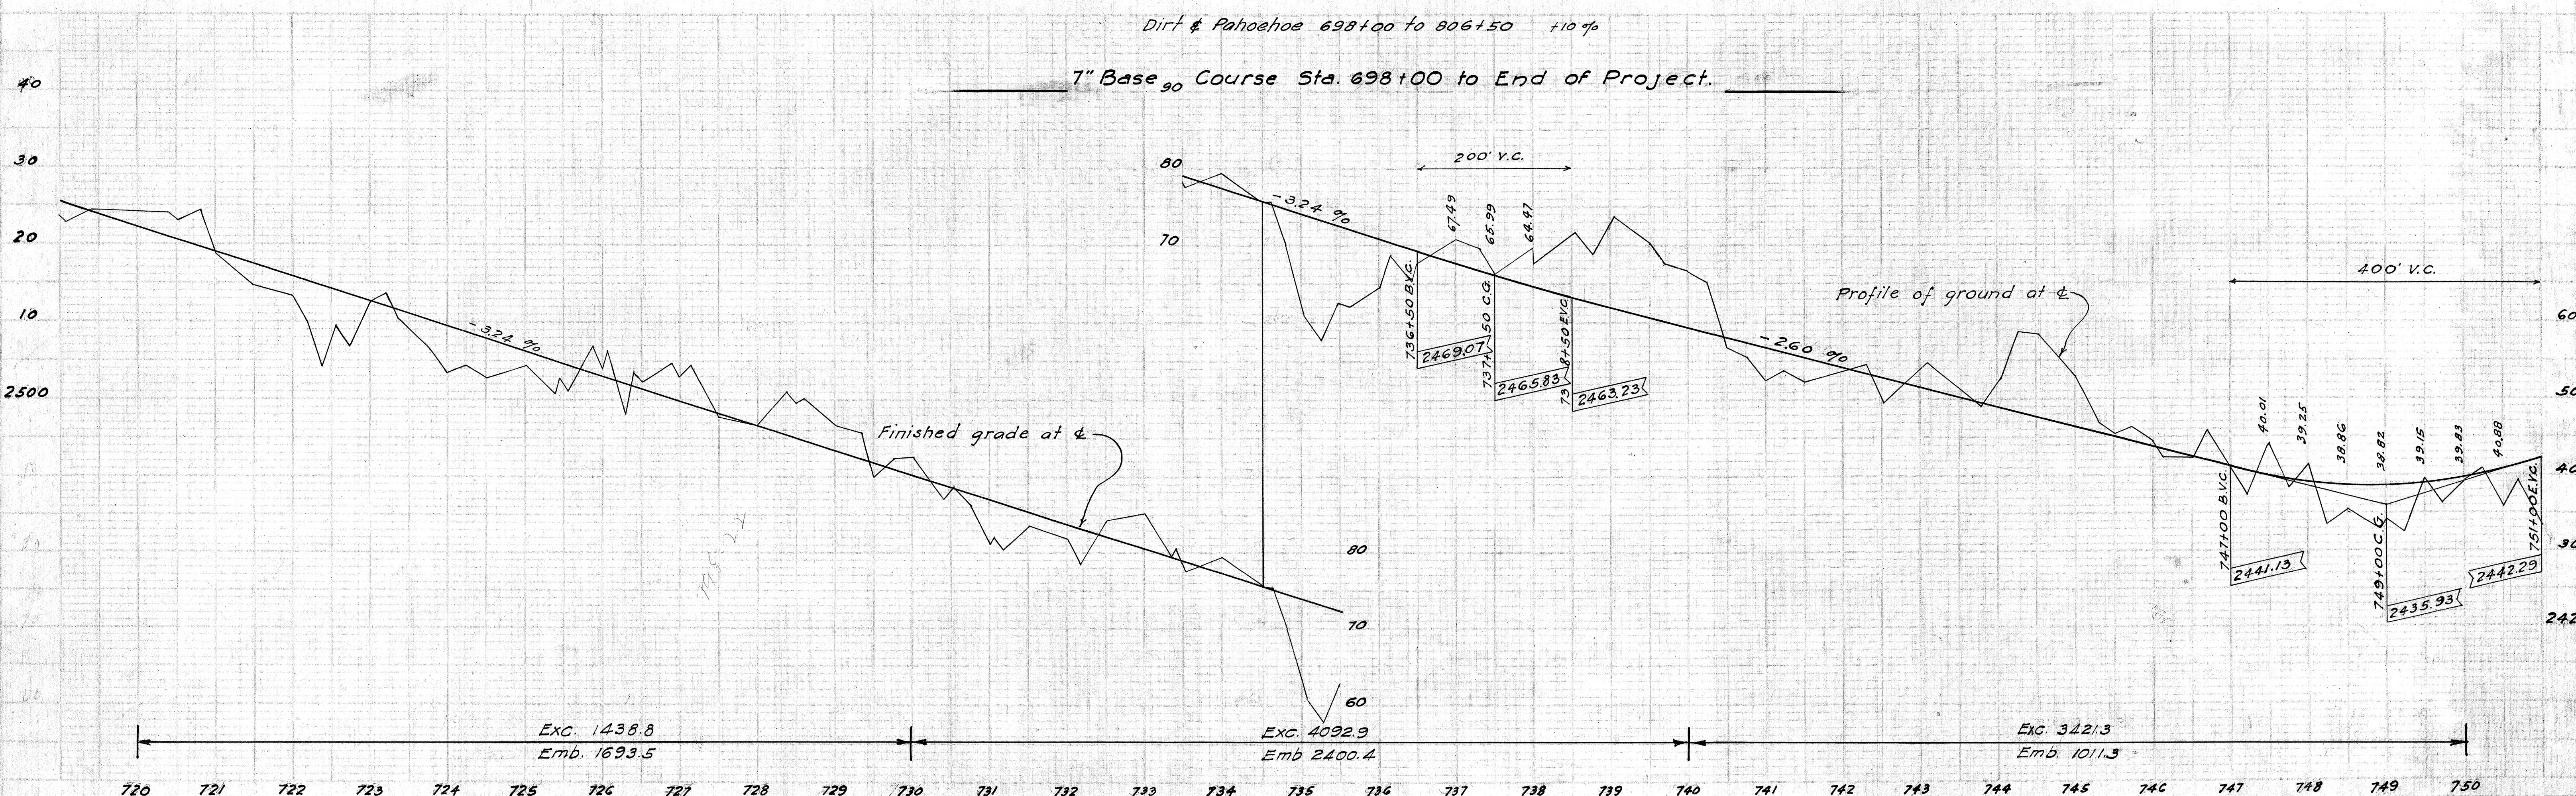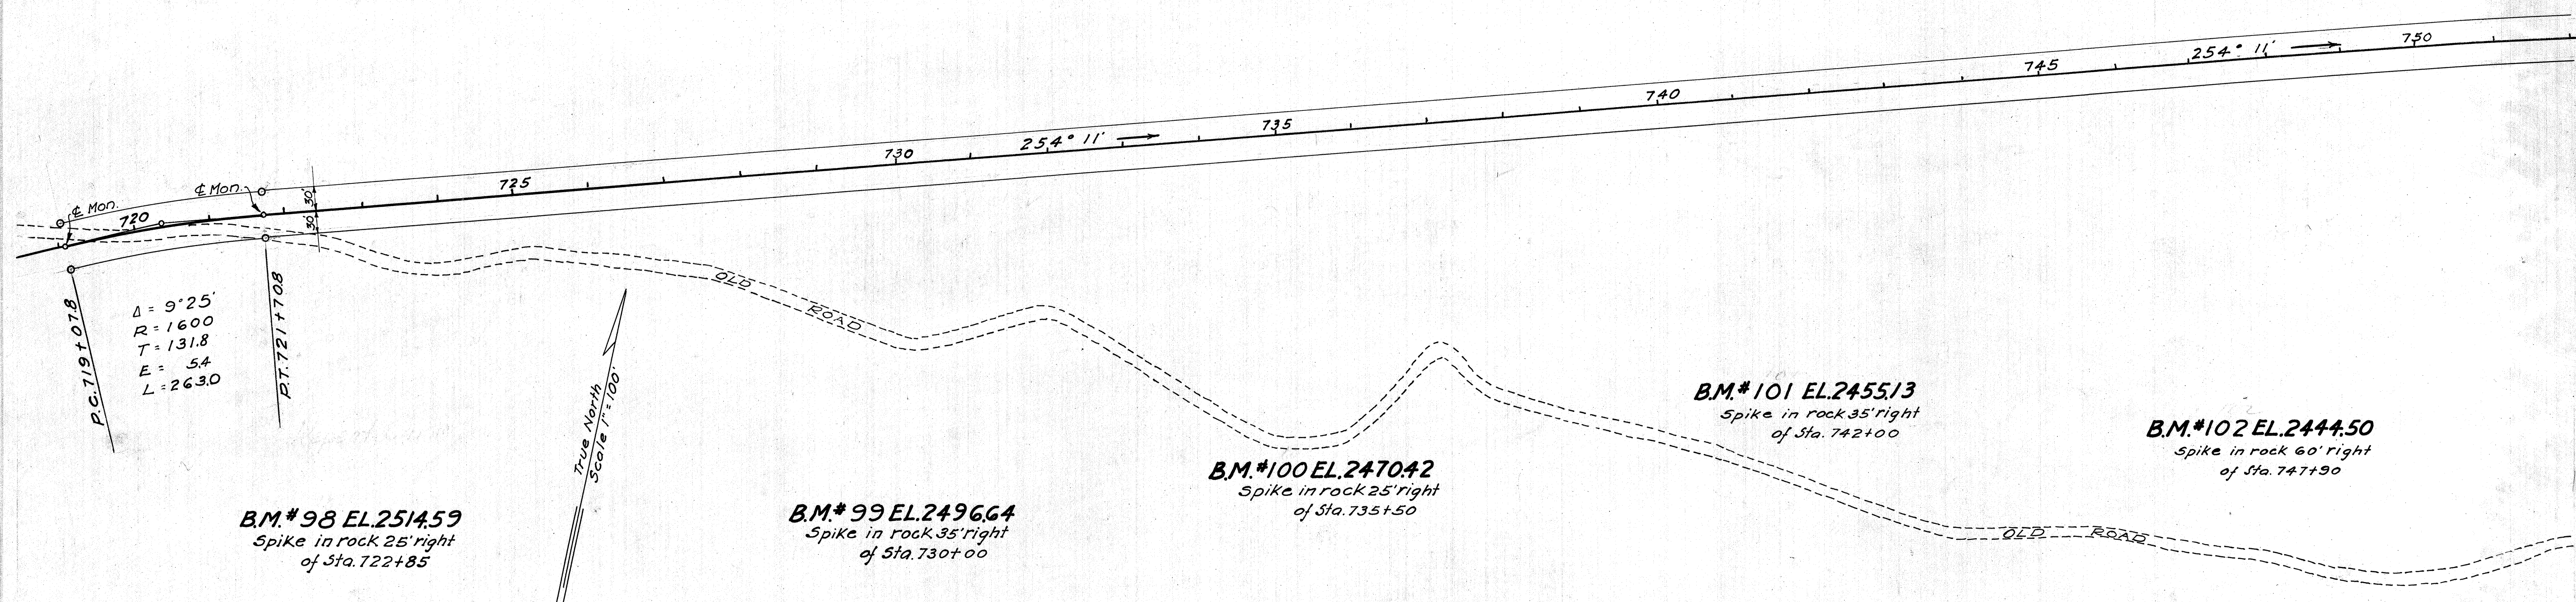

4273.6

FED. ROAD DIST. NO.	STATE	FED. AID PROJ. NO.	FISCAL YEAR	SHEET NO.	TOTAL SHEETS
HAWAII	HAW	E-106	1932	7	29

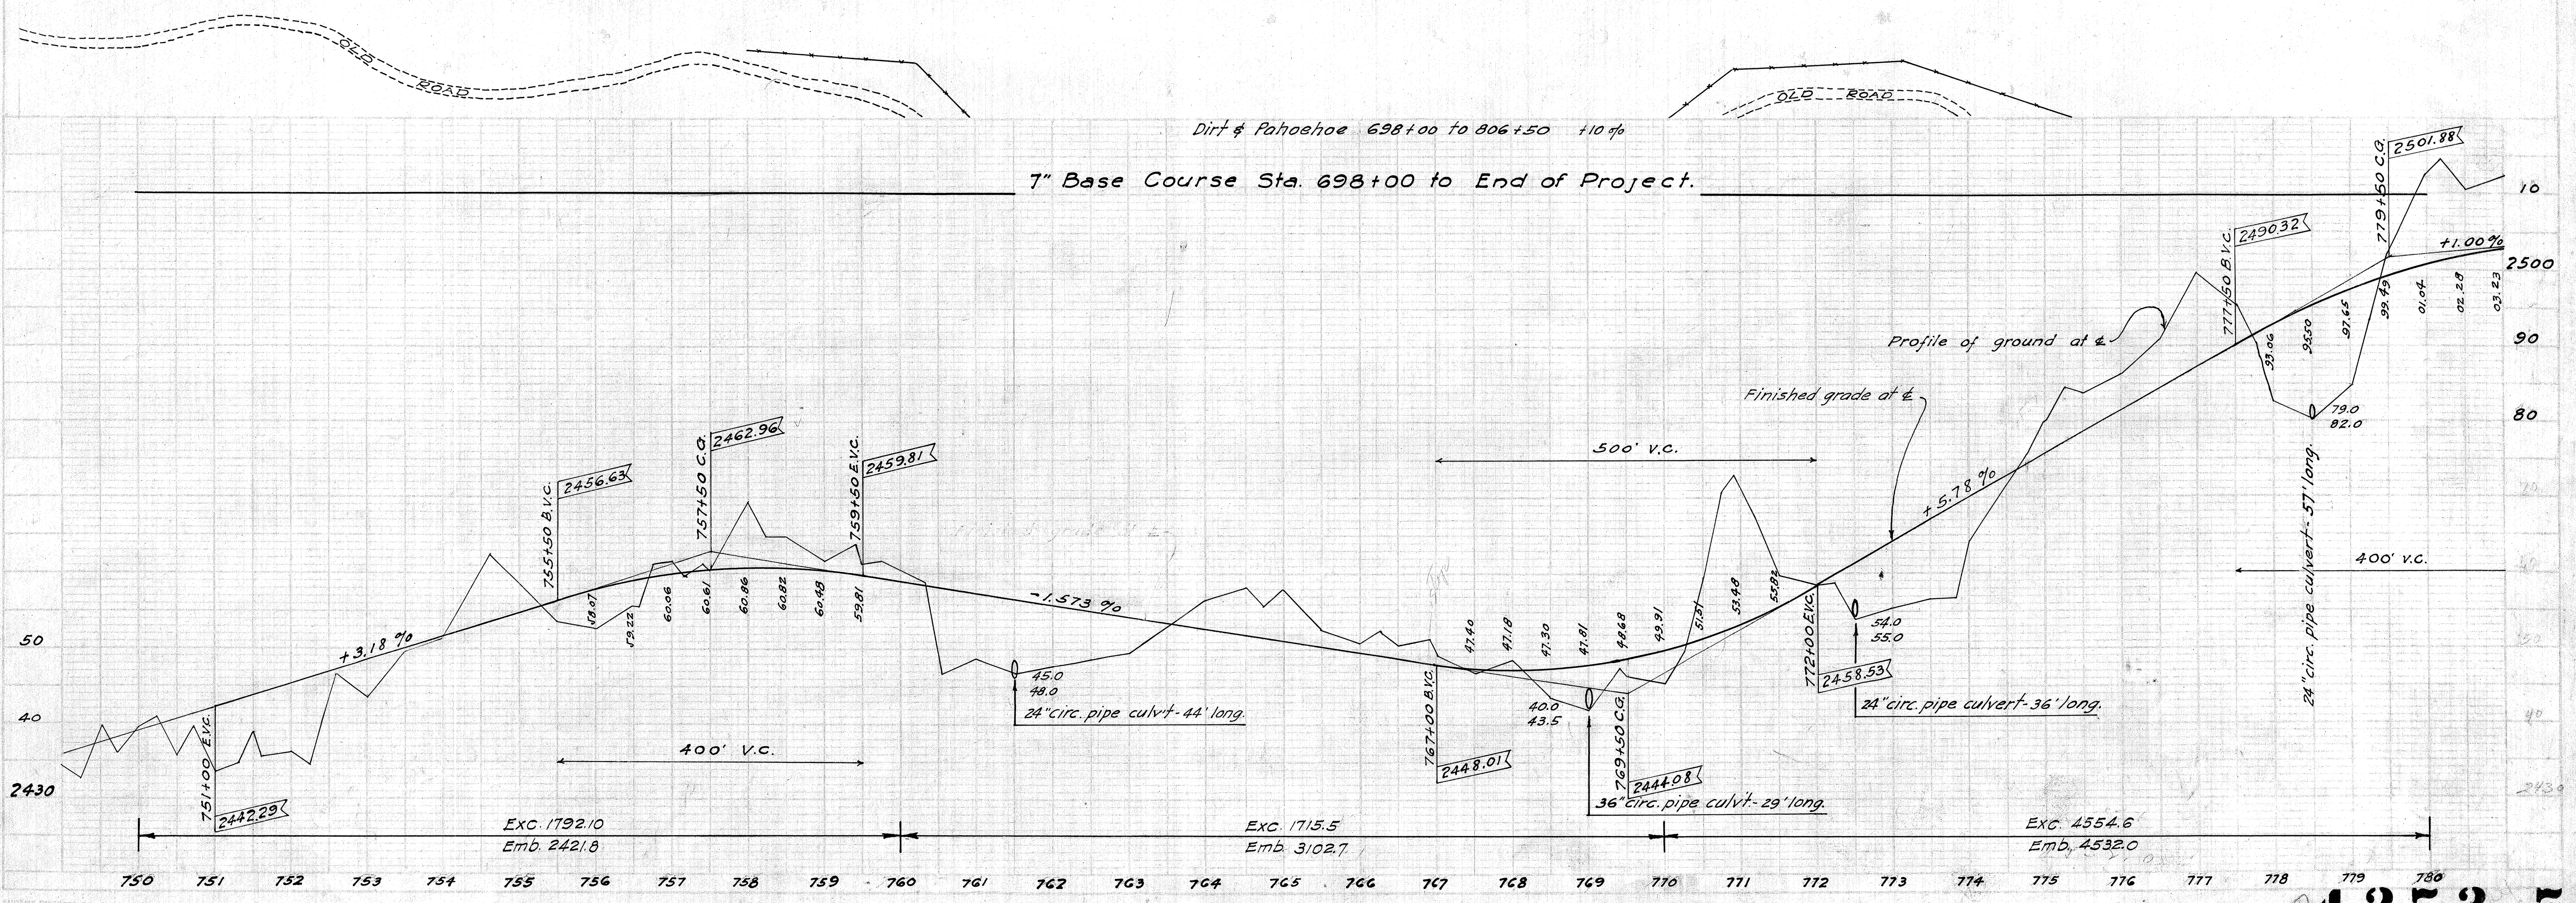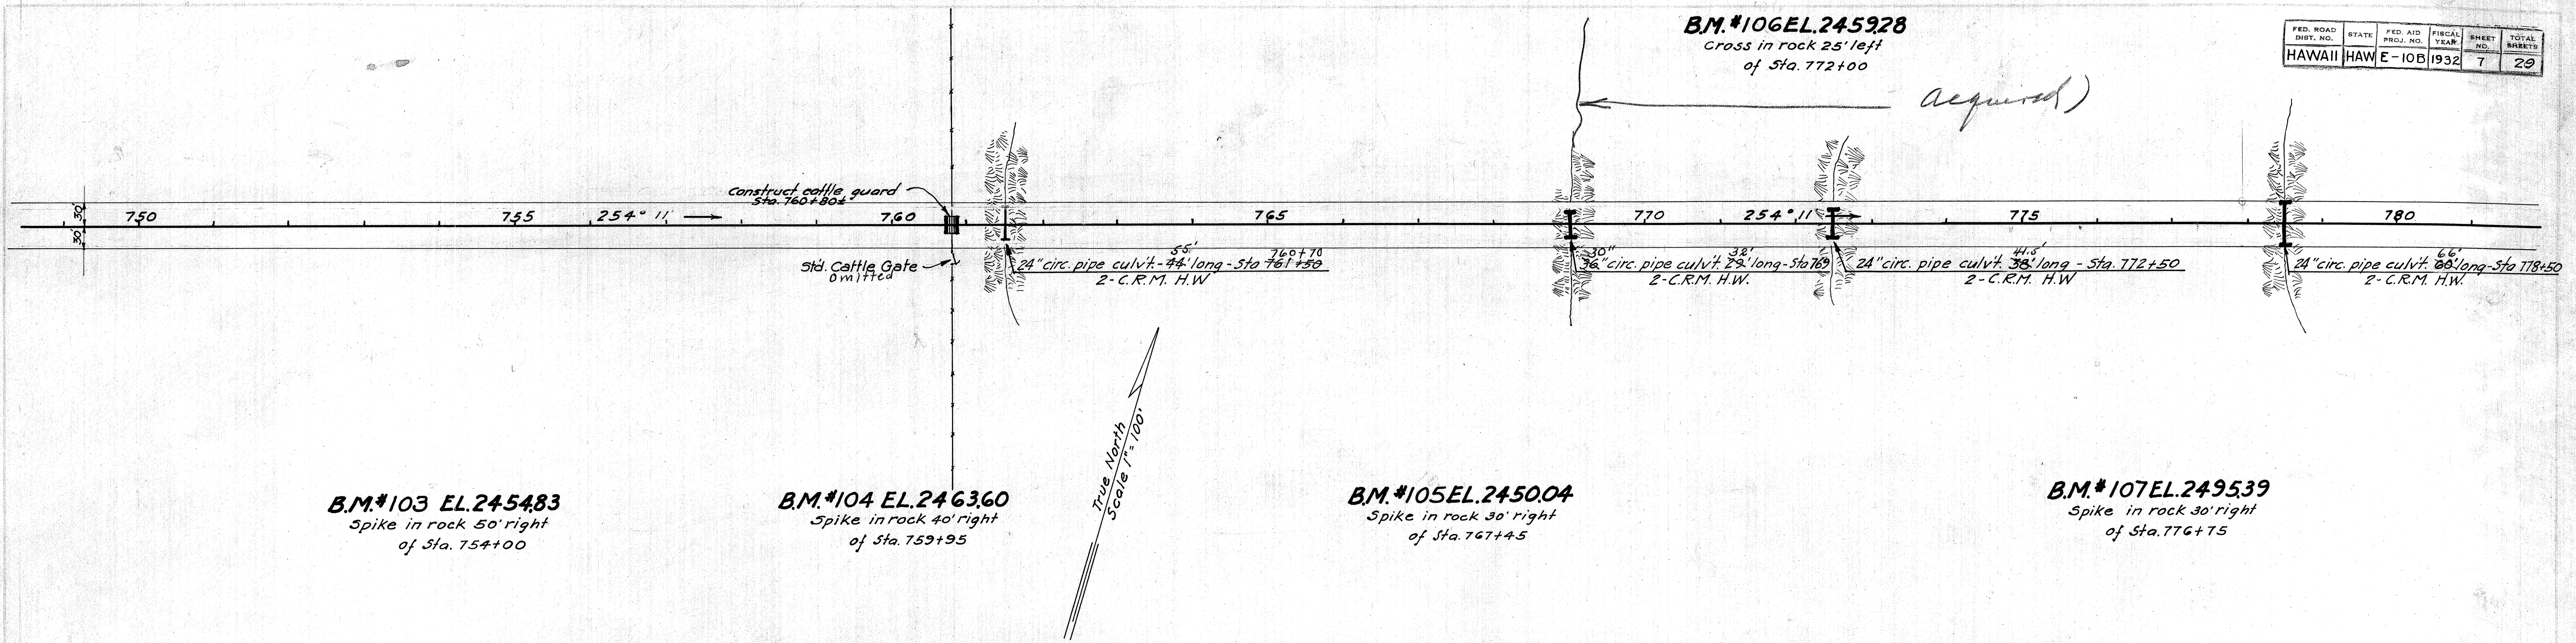

4273.7

FED. ROAD DIST. NO.	STATE	FILE NO.	FISCAL YEAR	SHEET NO.	TOTAL SHEETS
HAWAII	HAW	E-10B	1932	8	28

