
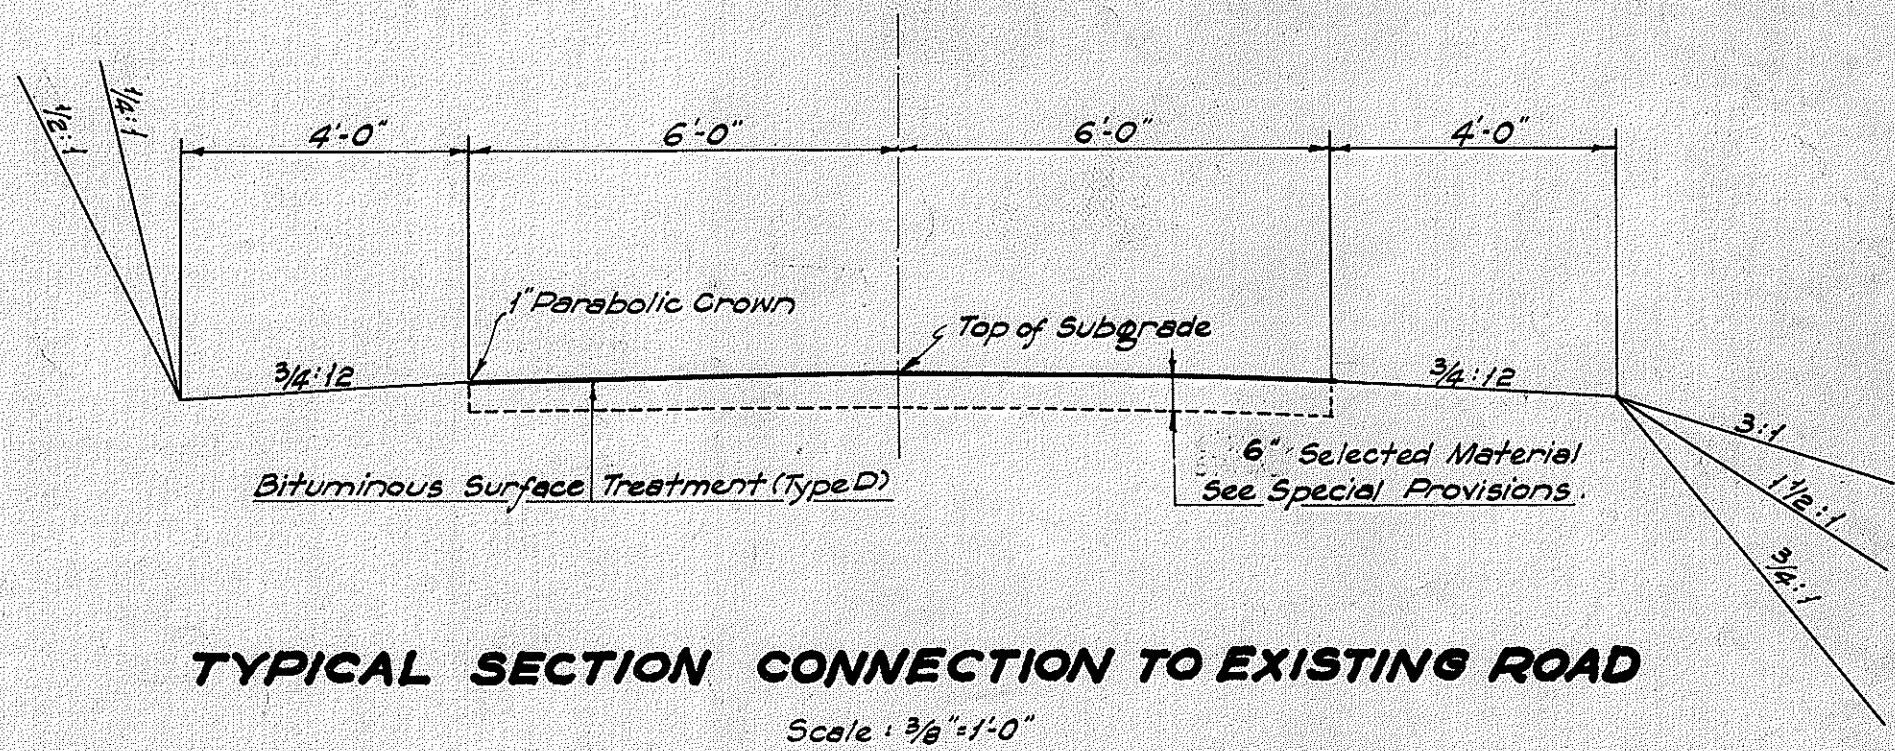
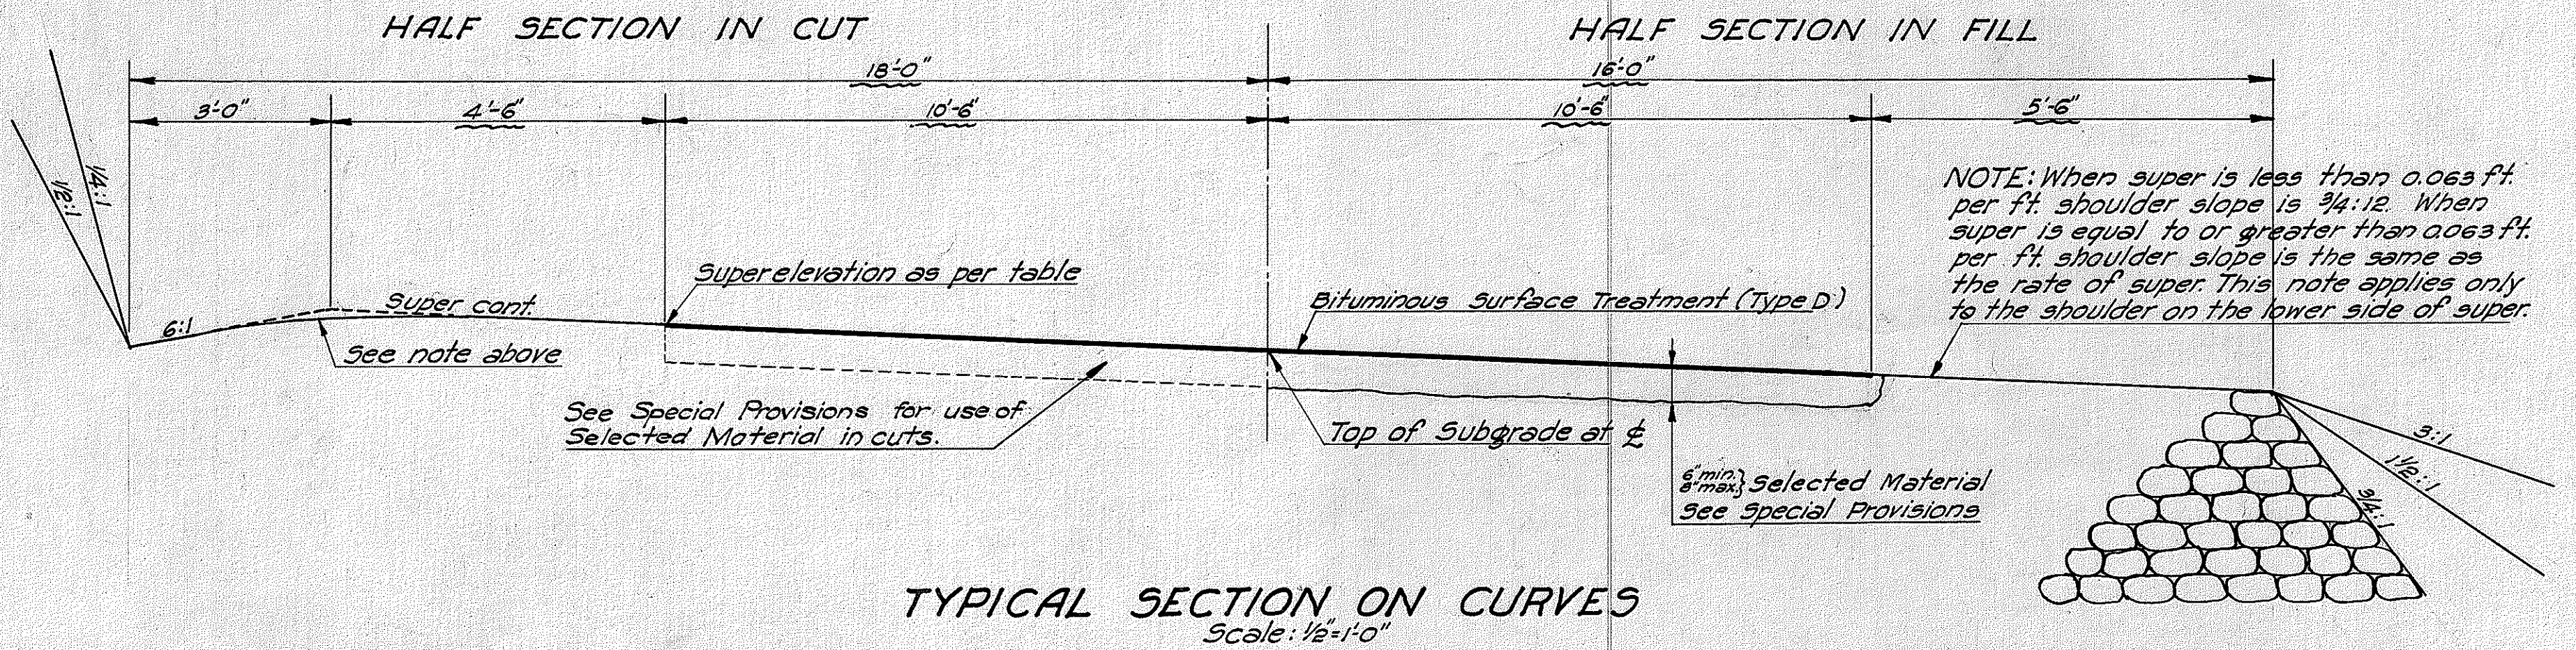
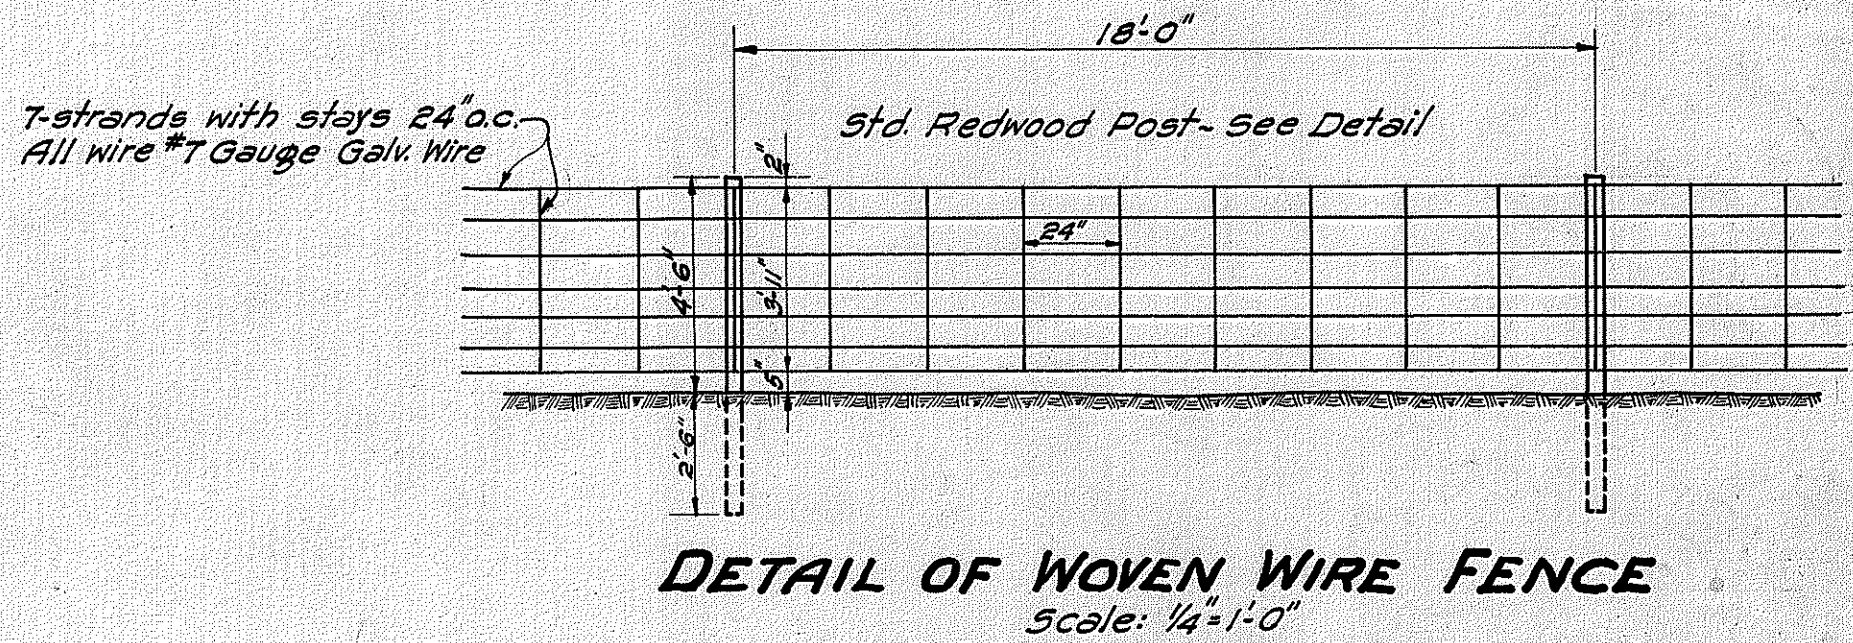


FED. ROAD DIST. NO.	STATE	FED. AID PROJ. NO.	FISCAL YEAR	SHEET NO.	TOTAL SHEETS
HAWAII	HAW.	10-C(1)	1938	2	46
HAWAII	HAW.	10-B(2)	1938	2	7

NOTE: No rounding of Cut Slopes required.

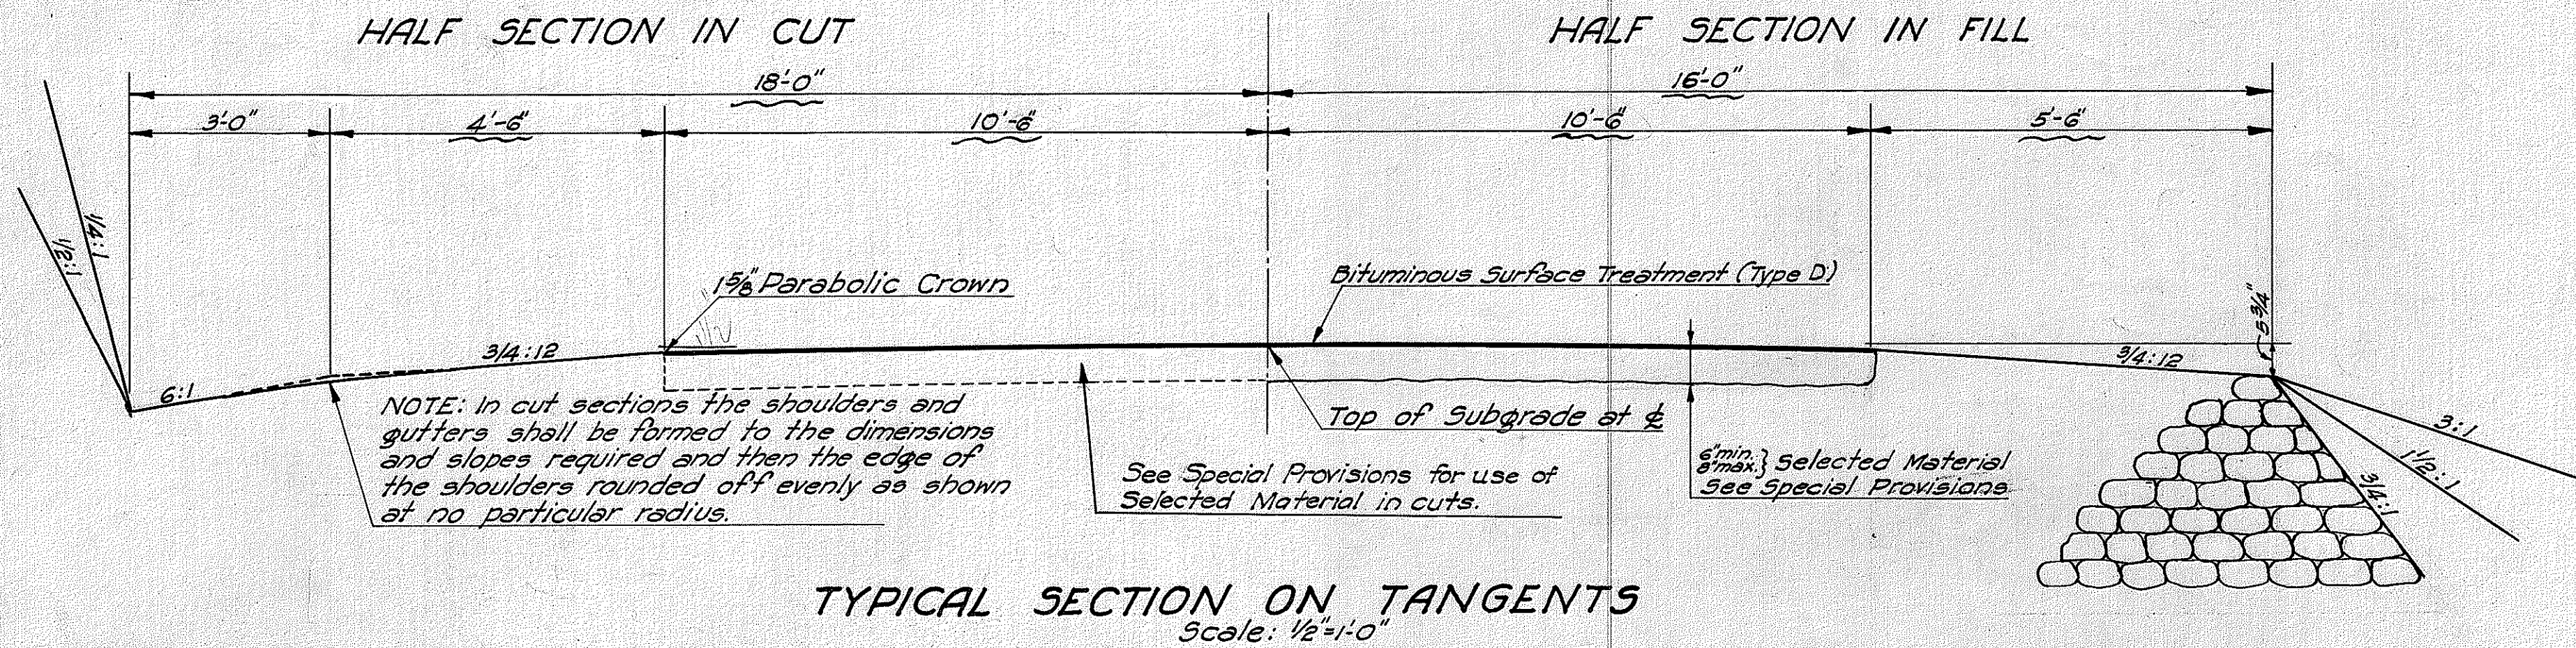

ORIGINAL PLAN	DATE
DESIGNED BY	11/30
DRAWN BY	LF
CHECKED BY	LF
QUANTITIES CHECKED BY	
CHECKED BY	
NOTE BOOK	
No.	