

FINAL SURVEY NOTE BOOK NO.	DATE
	BY
	SURVEYED PLOTED TEMPLATE AREAS CHECKED




ORIGINAL SURVEY NOTE BOOK NO.	DATE
	BY
	SURVEYED PLOTED TEMPLATE AREAS CHECKED

FED. ROAD DIST. NO.	STATE	FED. AID PROJ. NO.	FISCAL YEAR	SHEET NO.	TOTAL SHEETS
HAWAII	HI	106	1953	10	12



FINAL SURVEY PLOTTED
NOTE BOOK NO. _____
DATE _____ BY _____

ORIGINAL SURVEY PLOTTED
NOTE BOOK NO. _____
DATE _____ BY _____

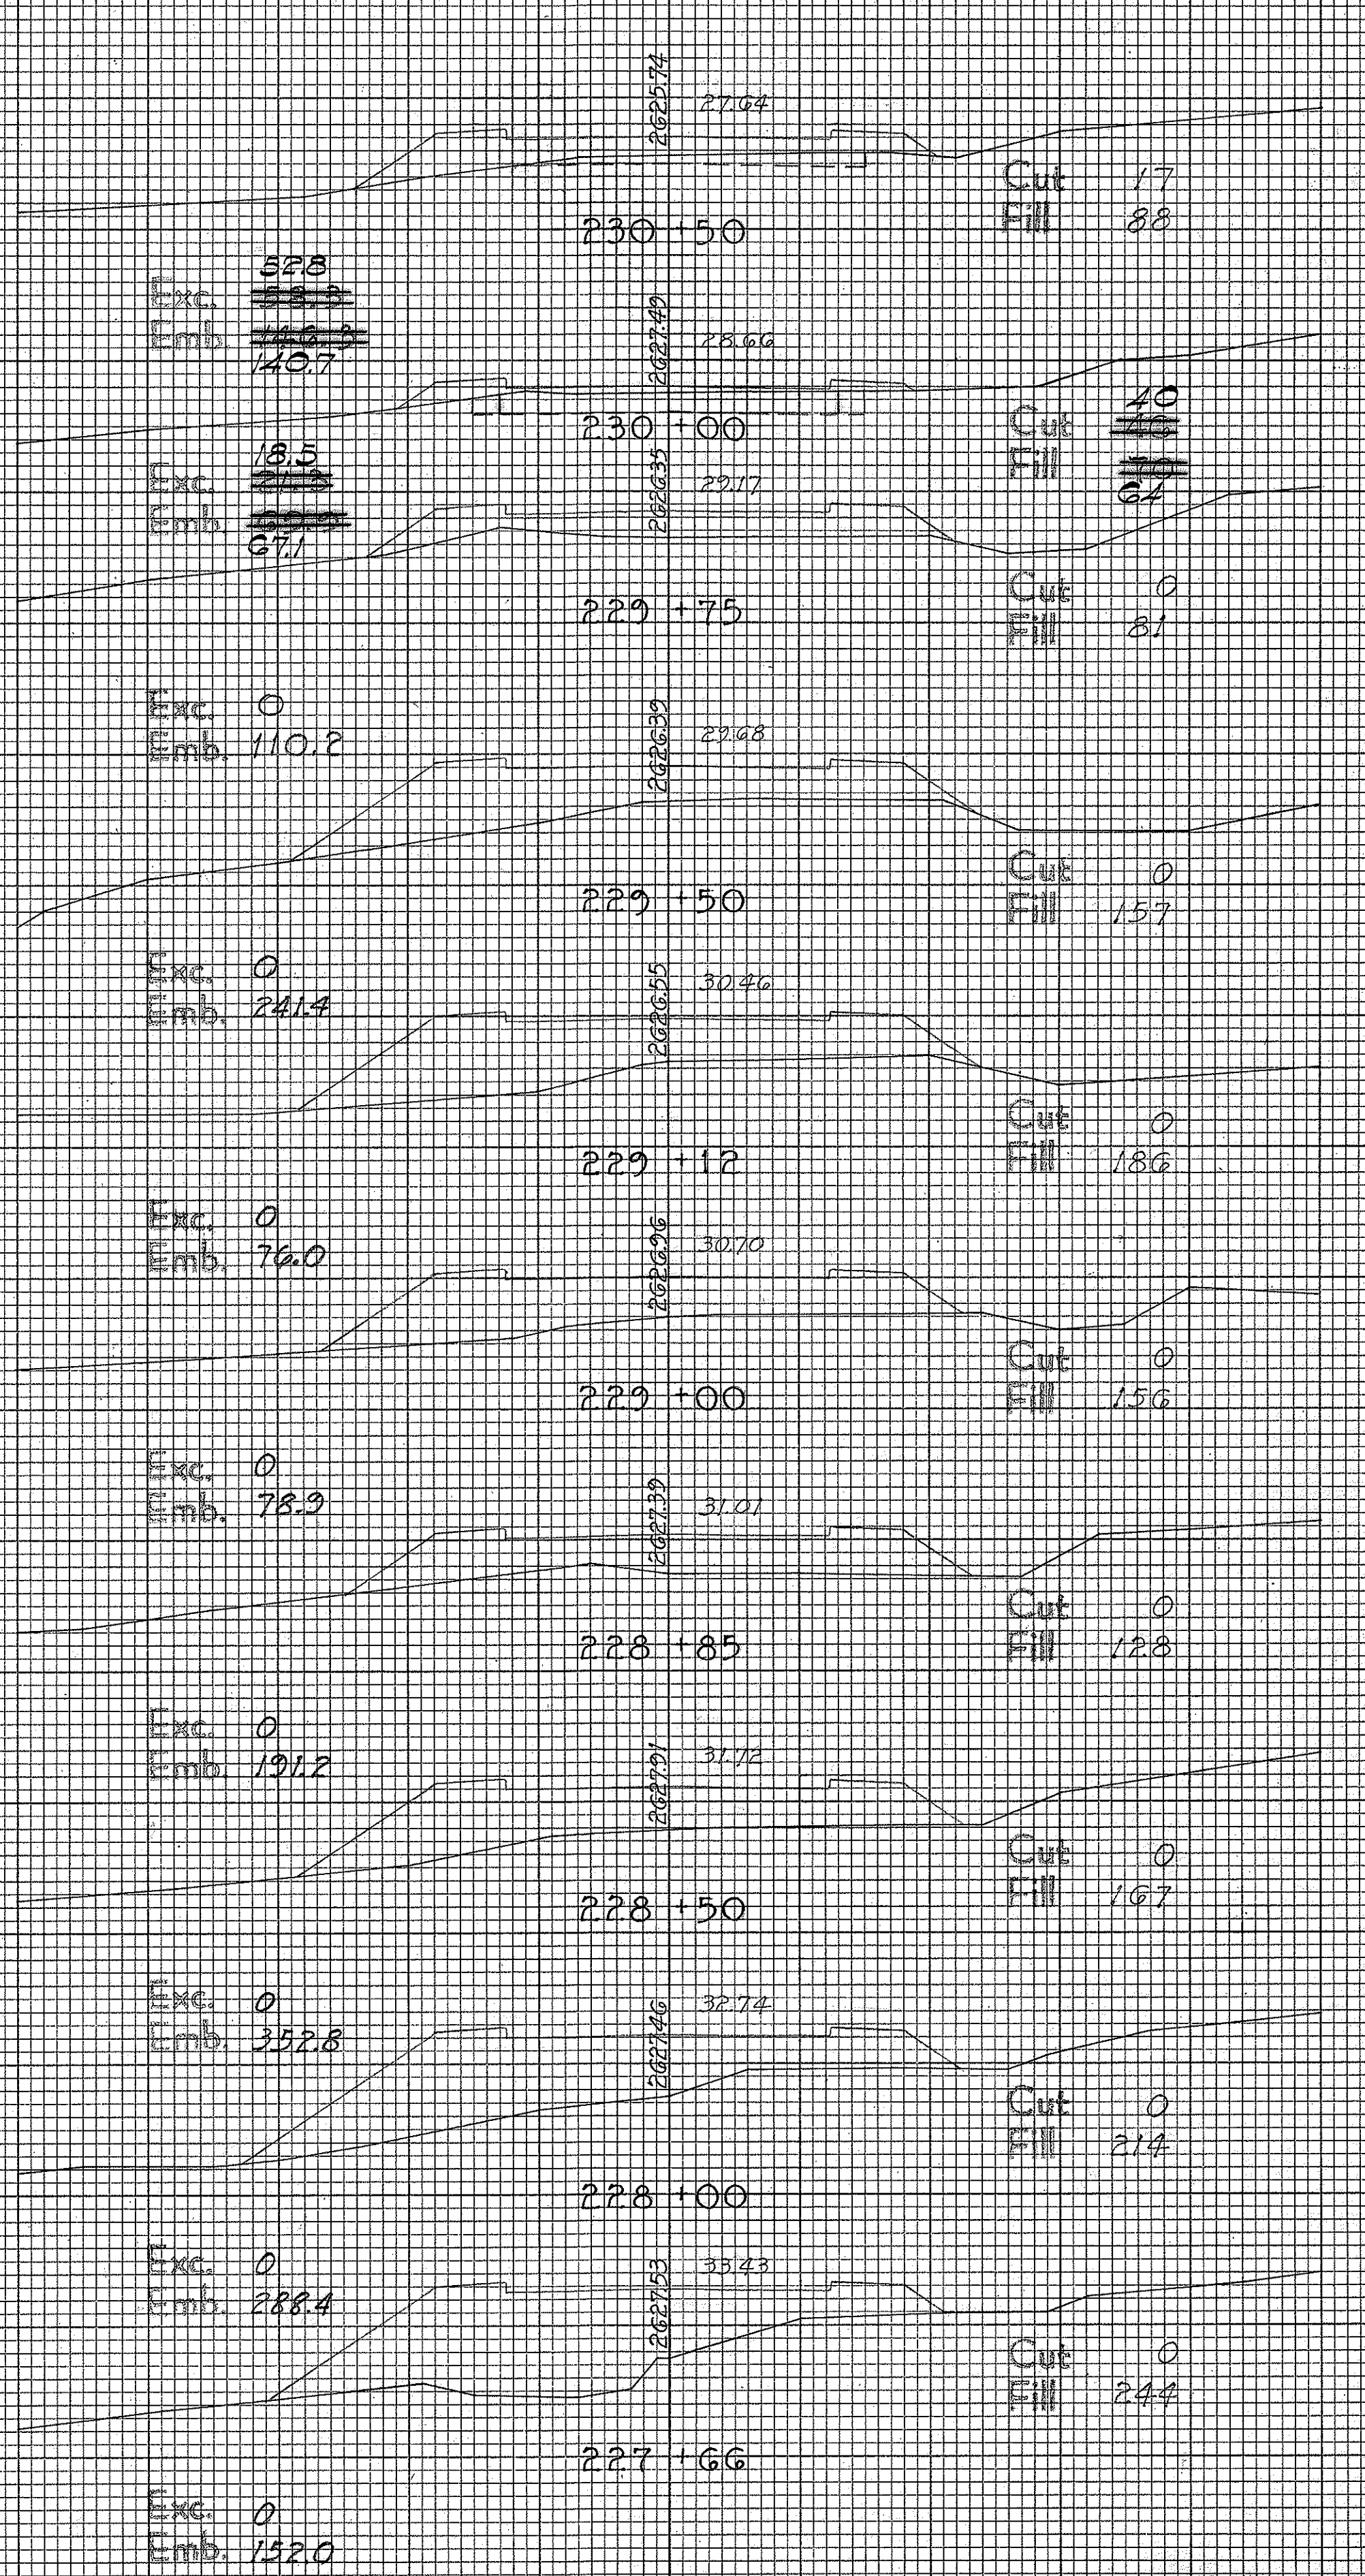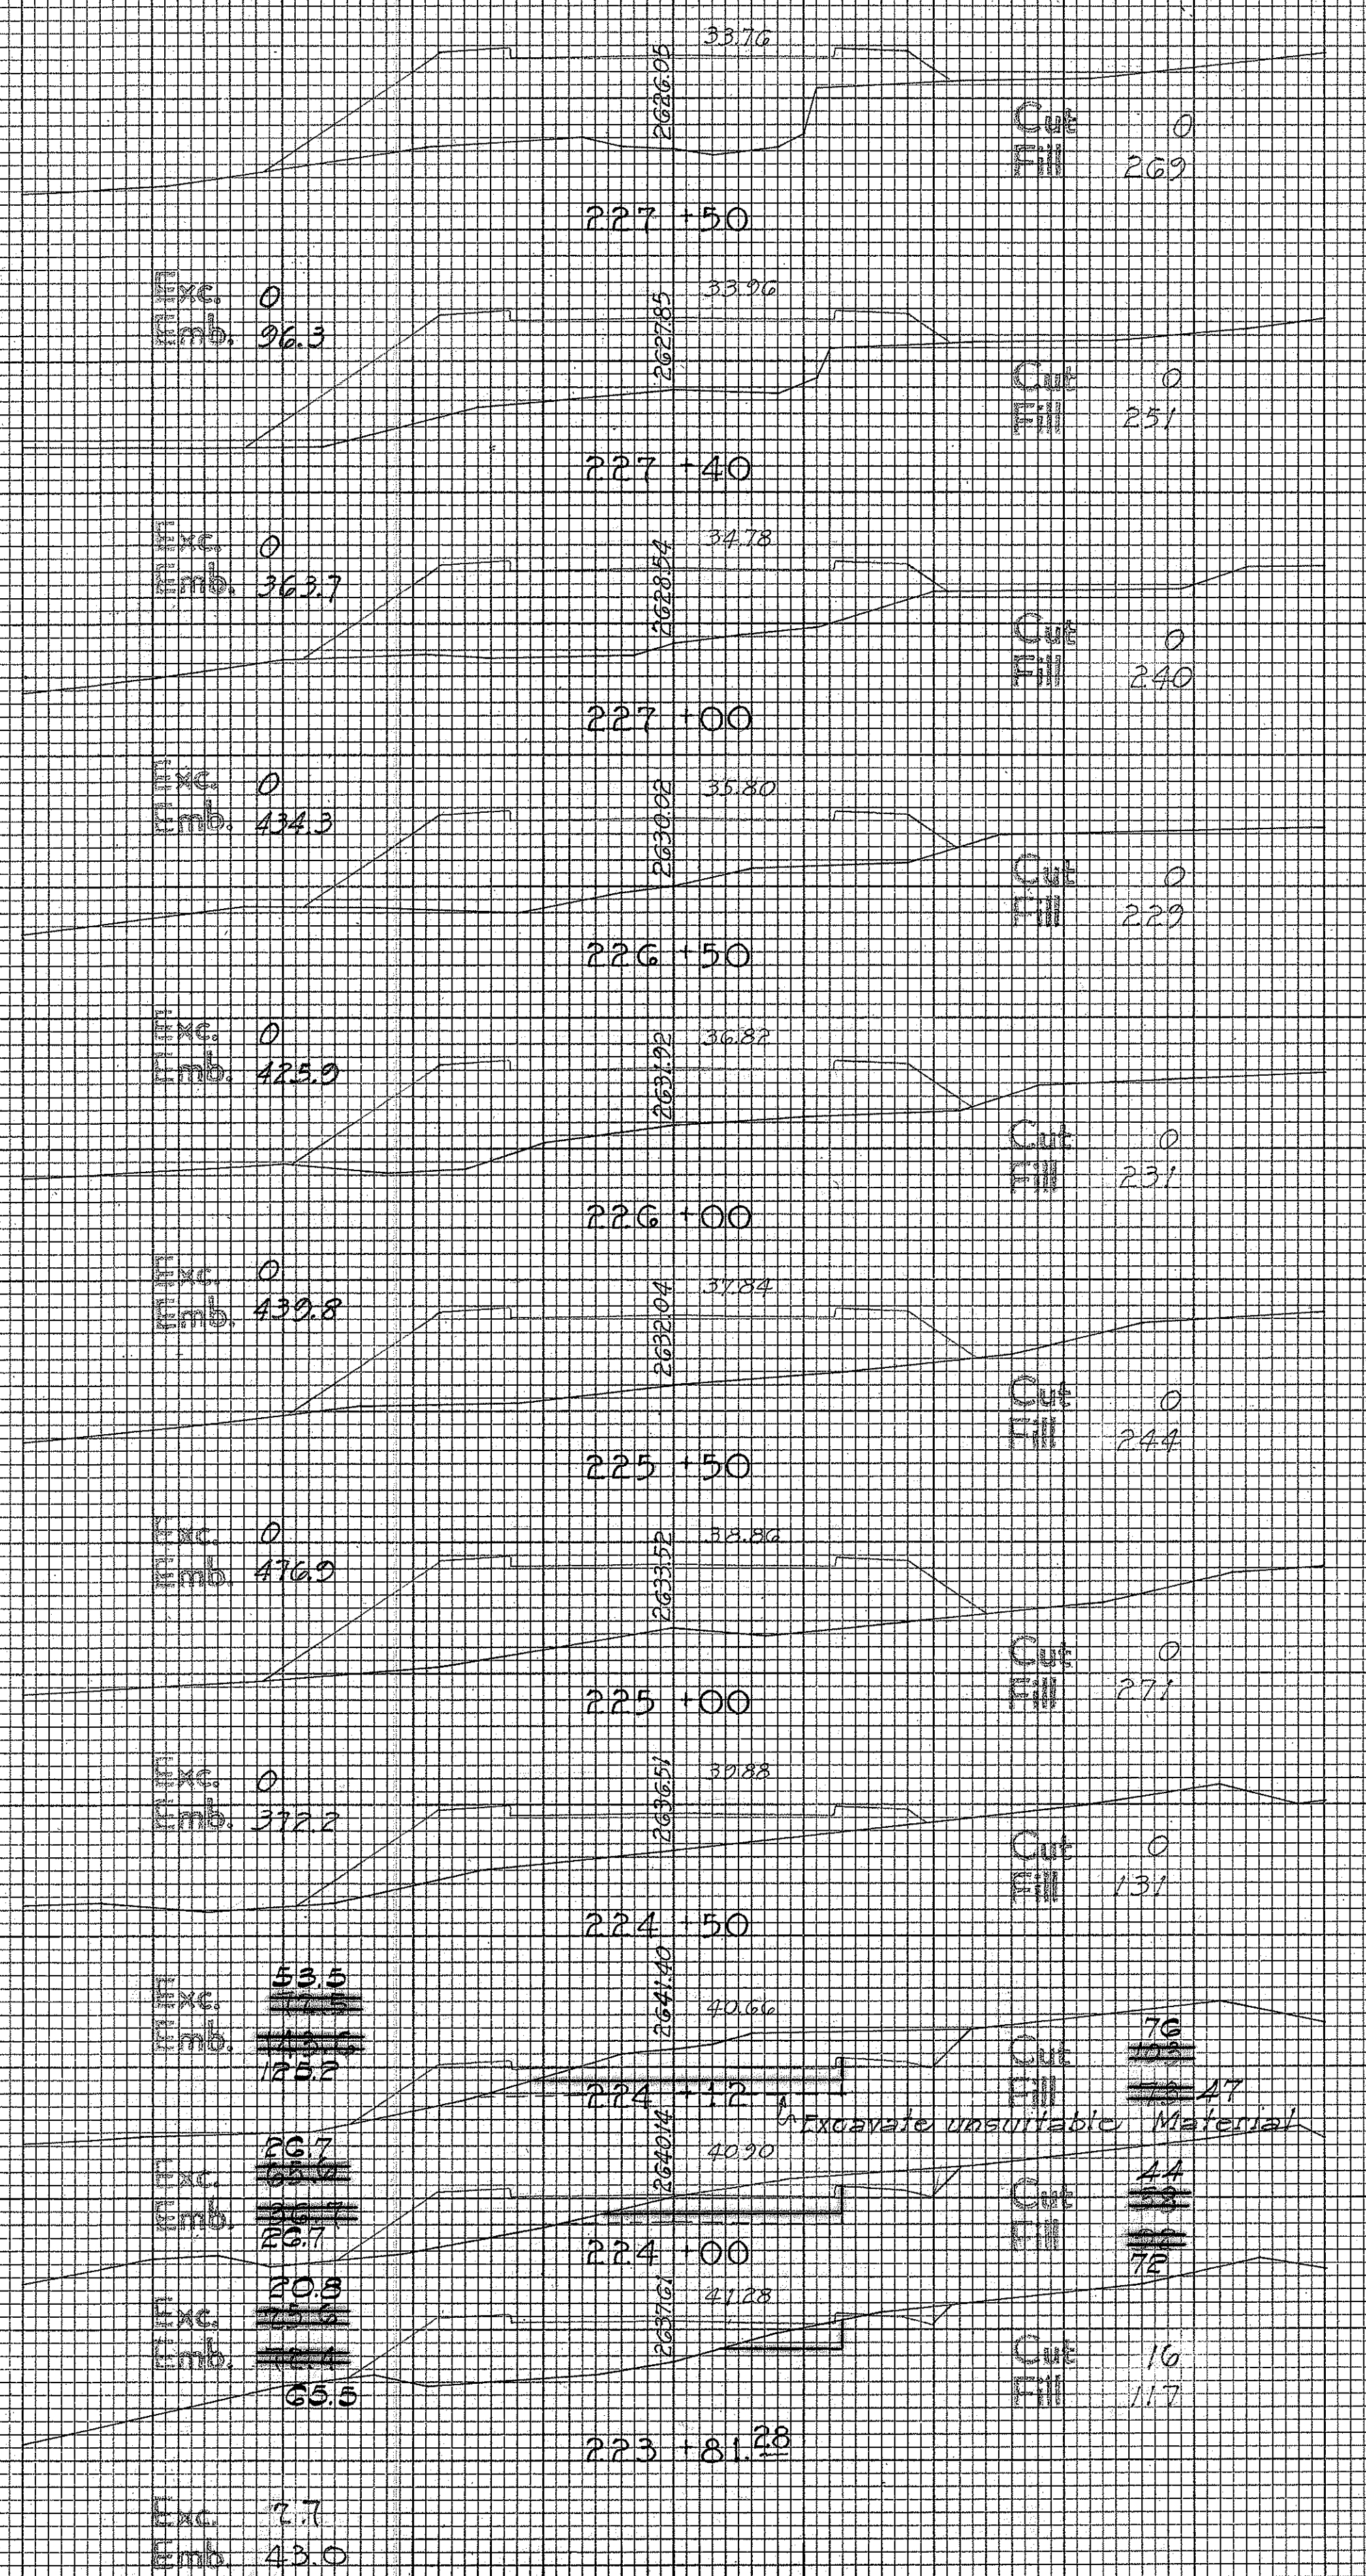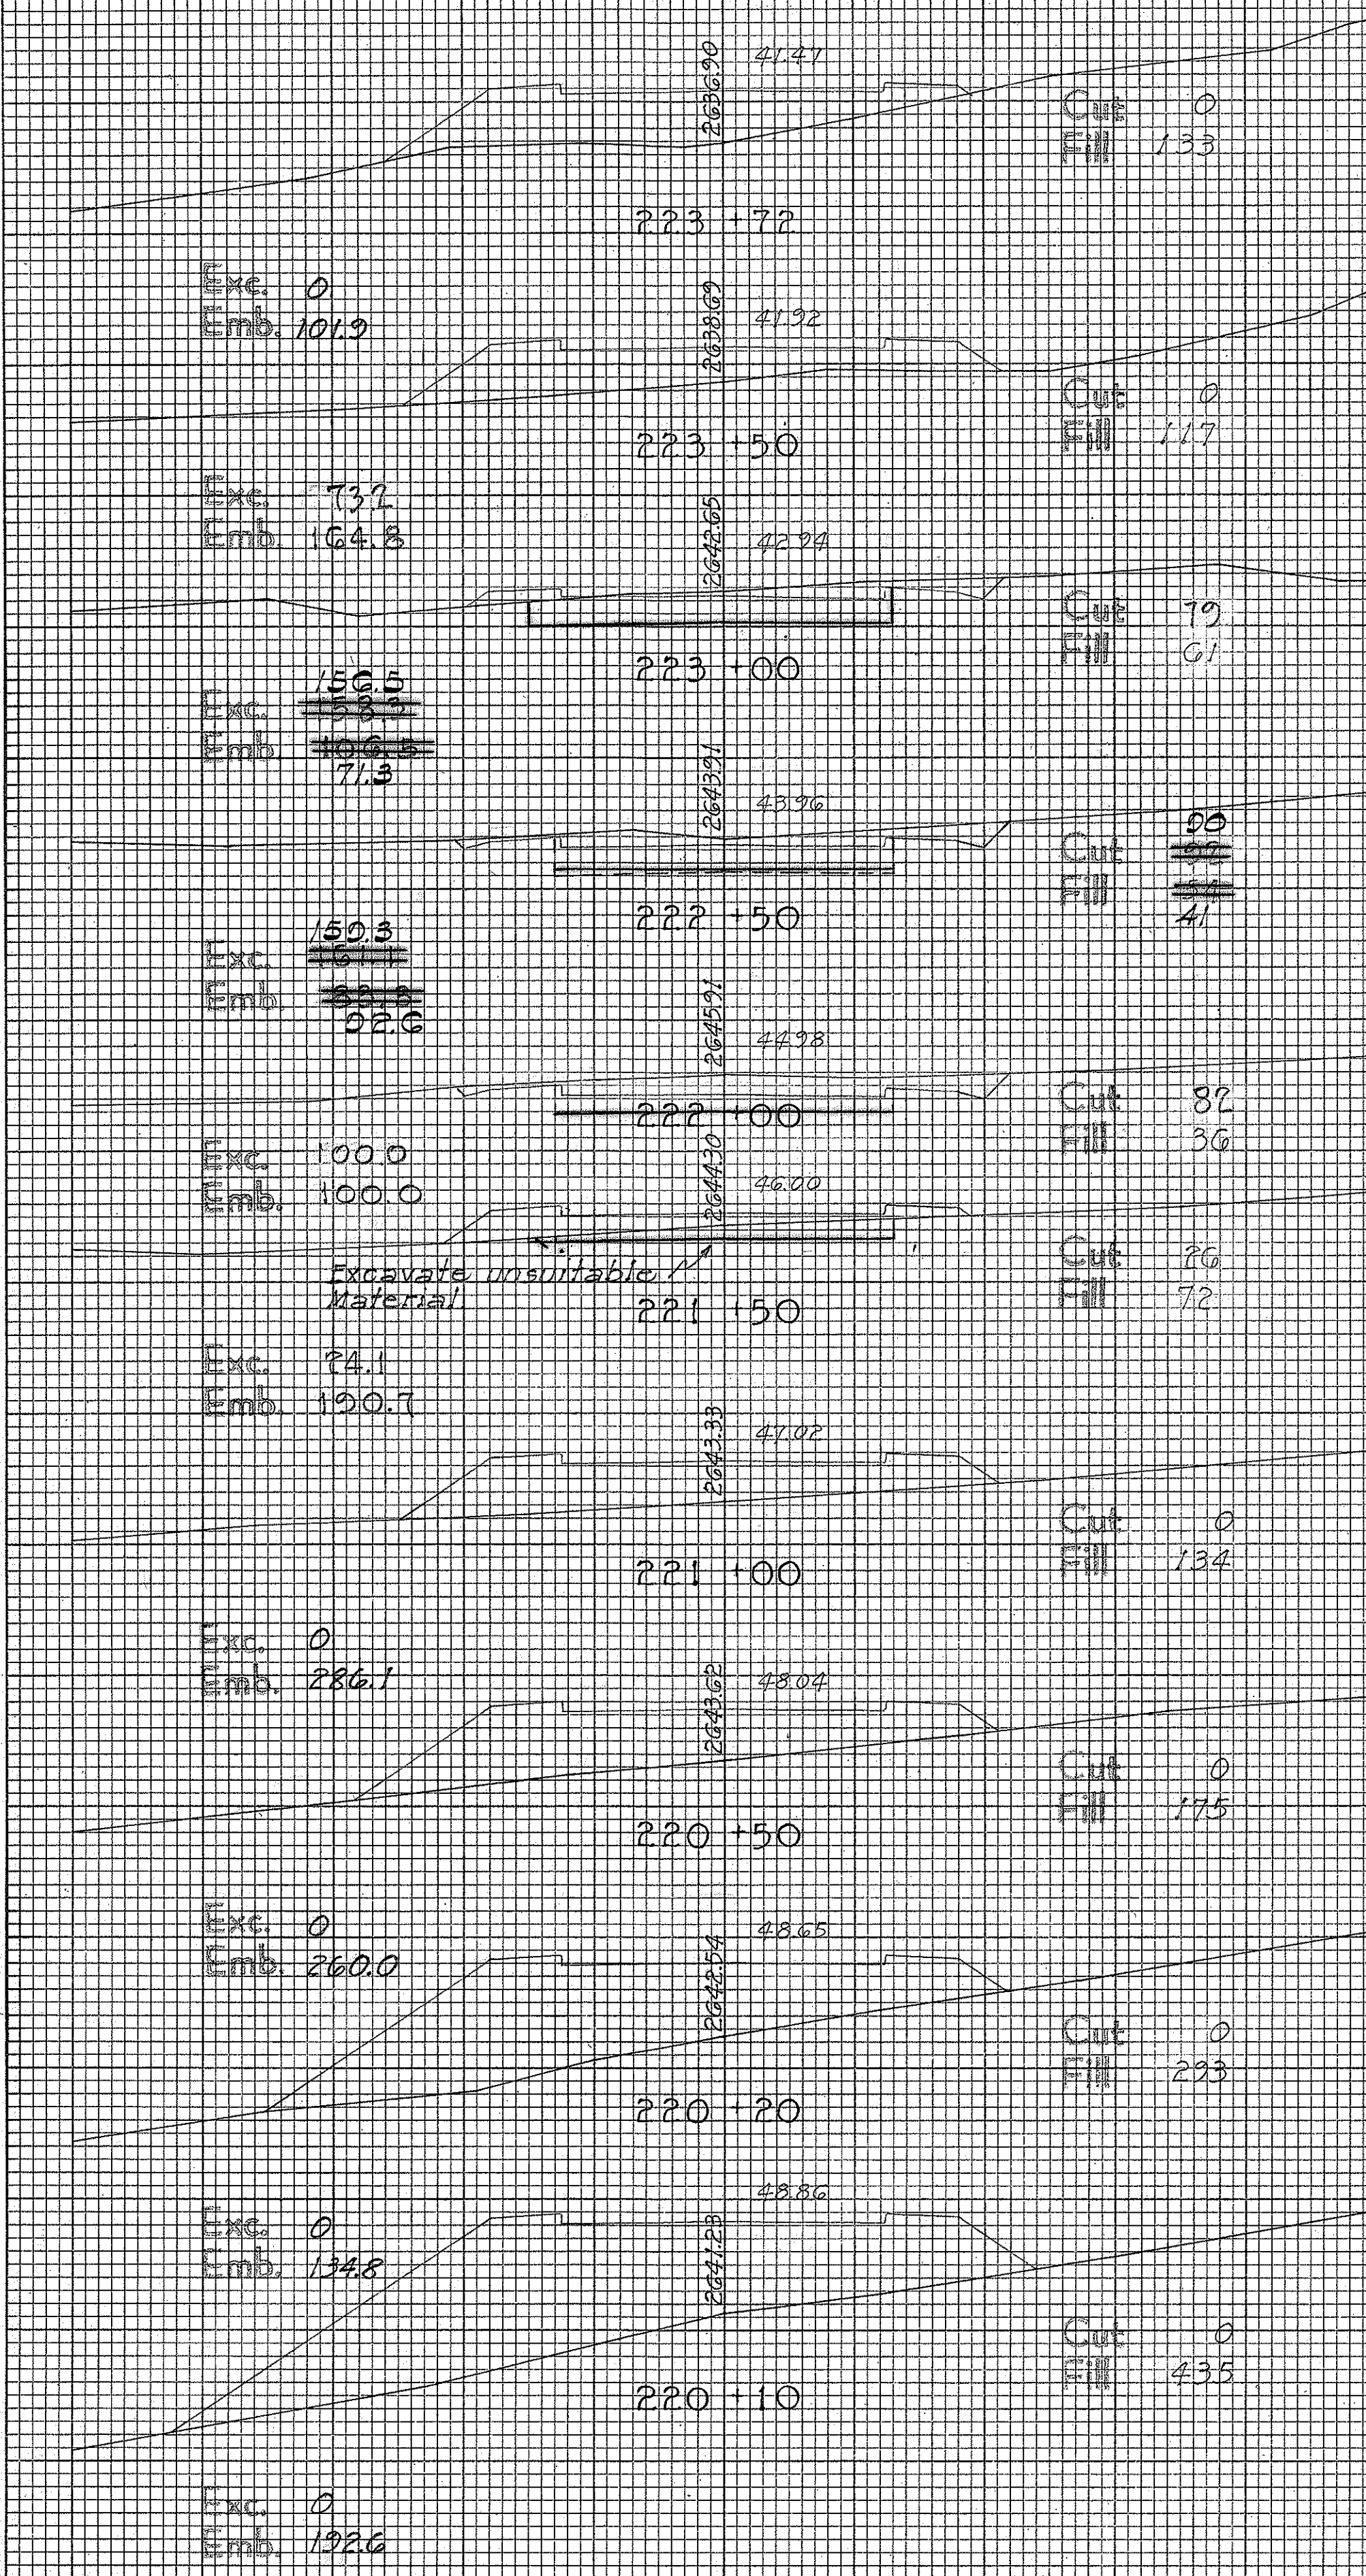

FINAL SURVEY NOTE BOOK NO.	BY	DATE

ORIGINAL SURVEY NOTE BOOK NO.	BY	DATE

