
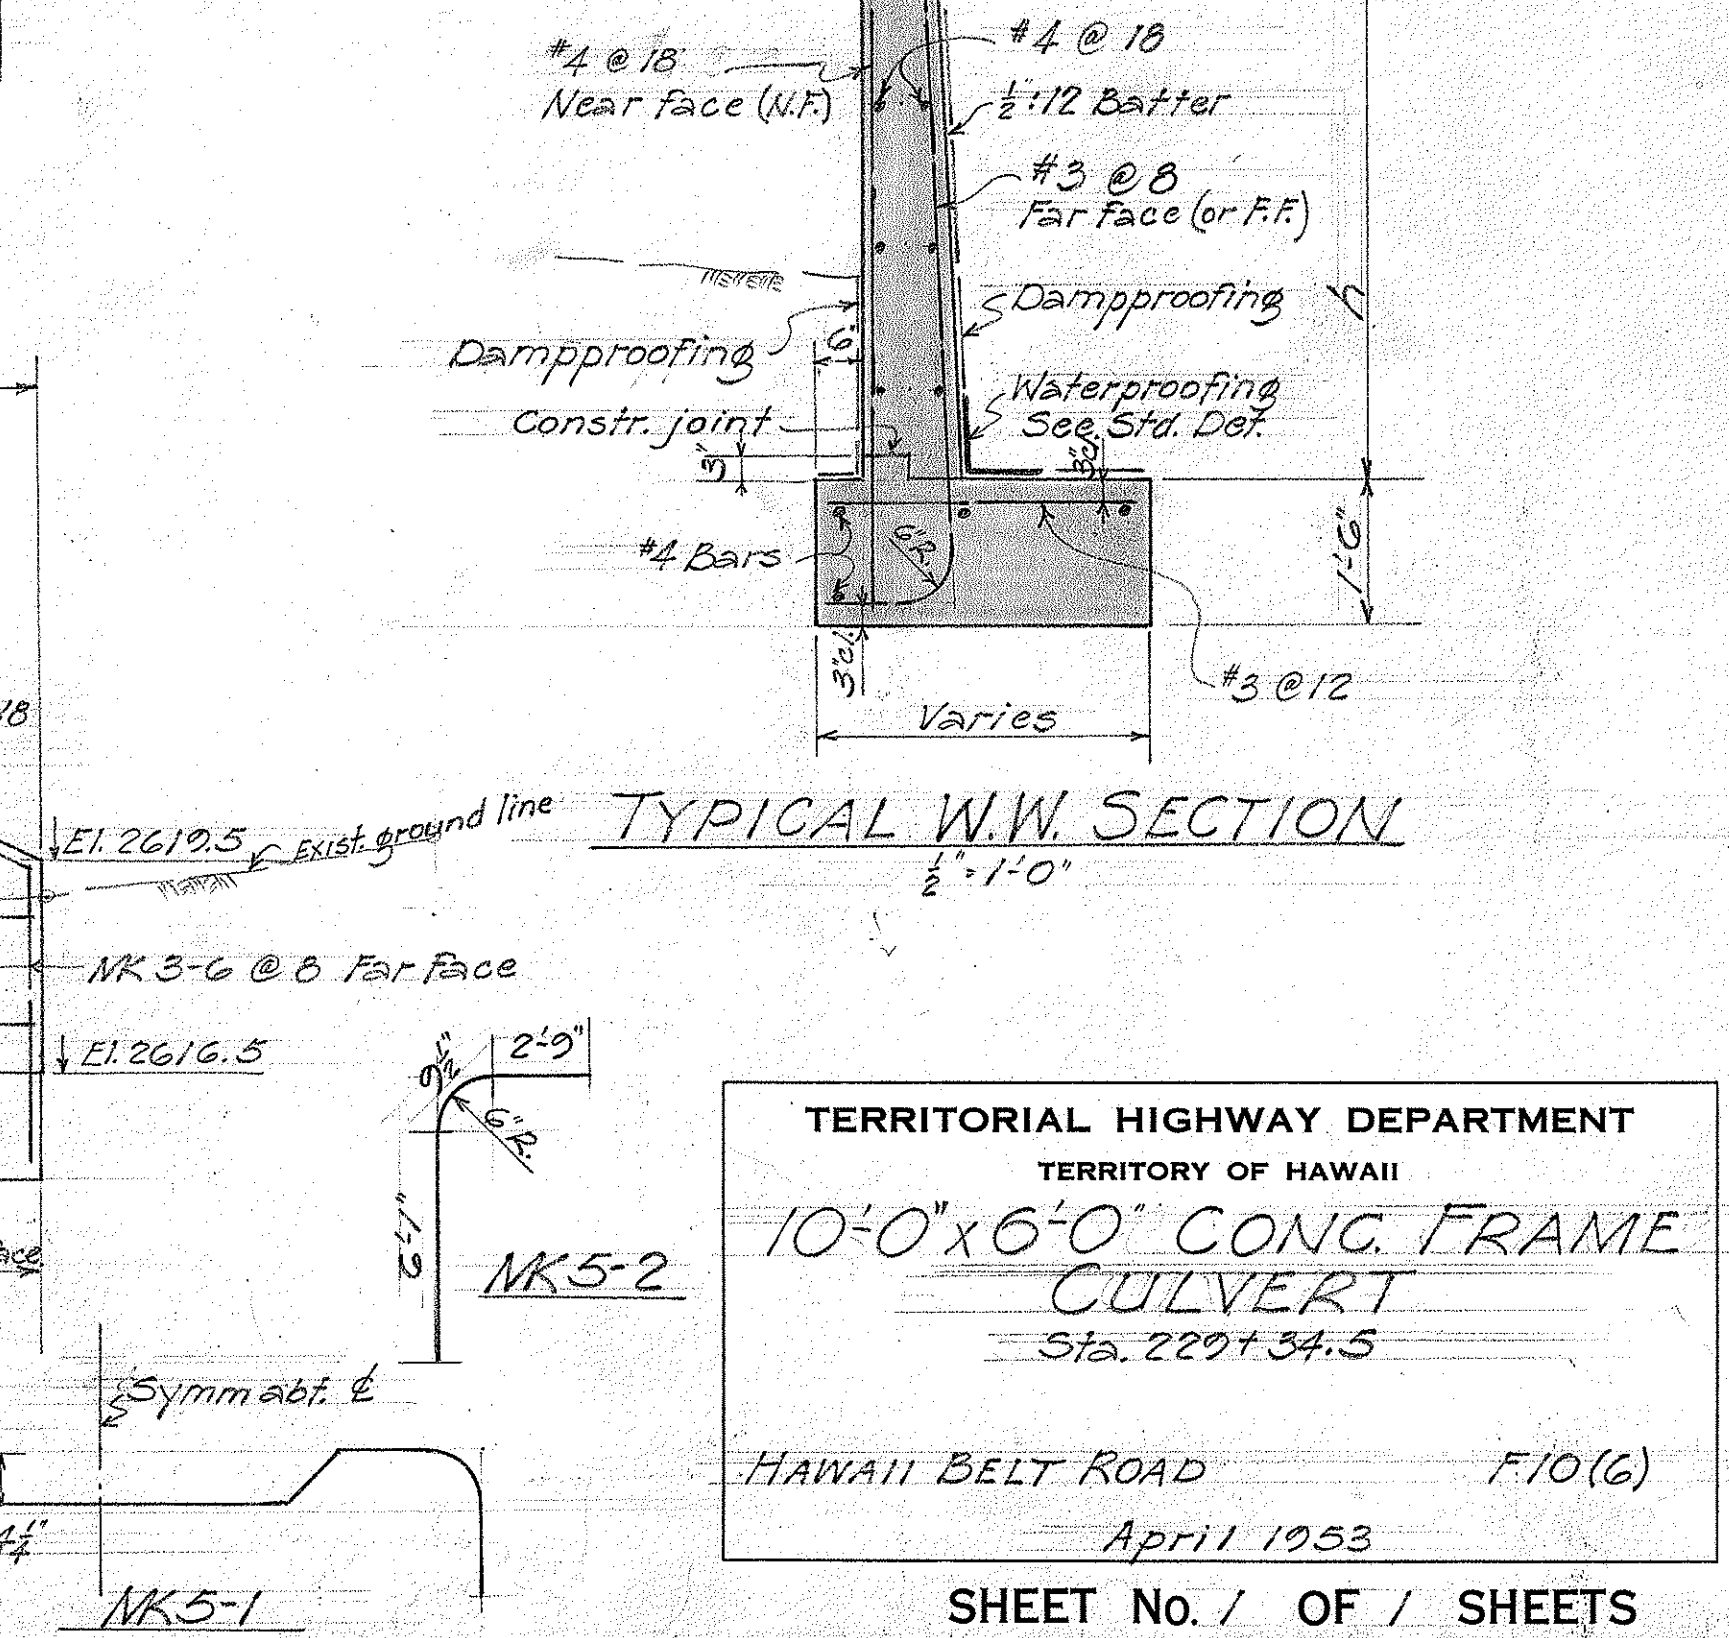
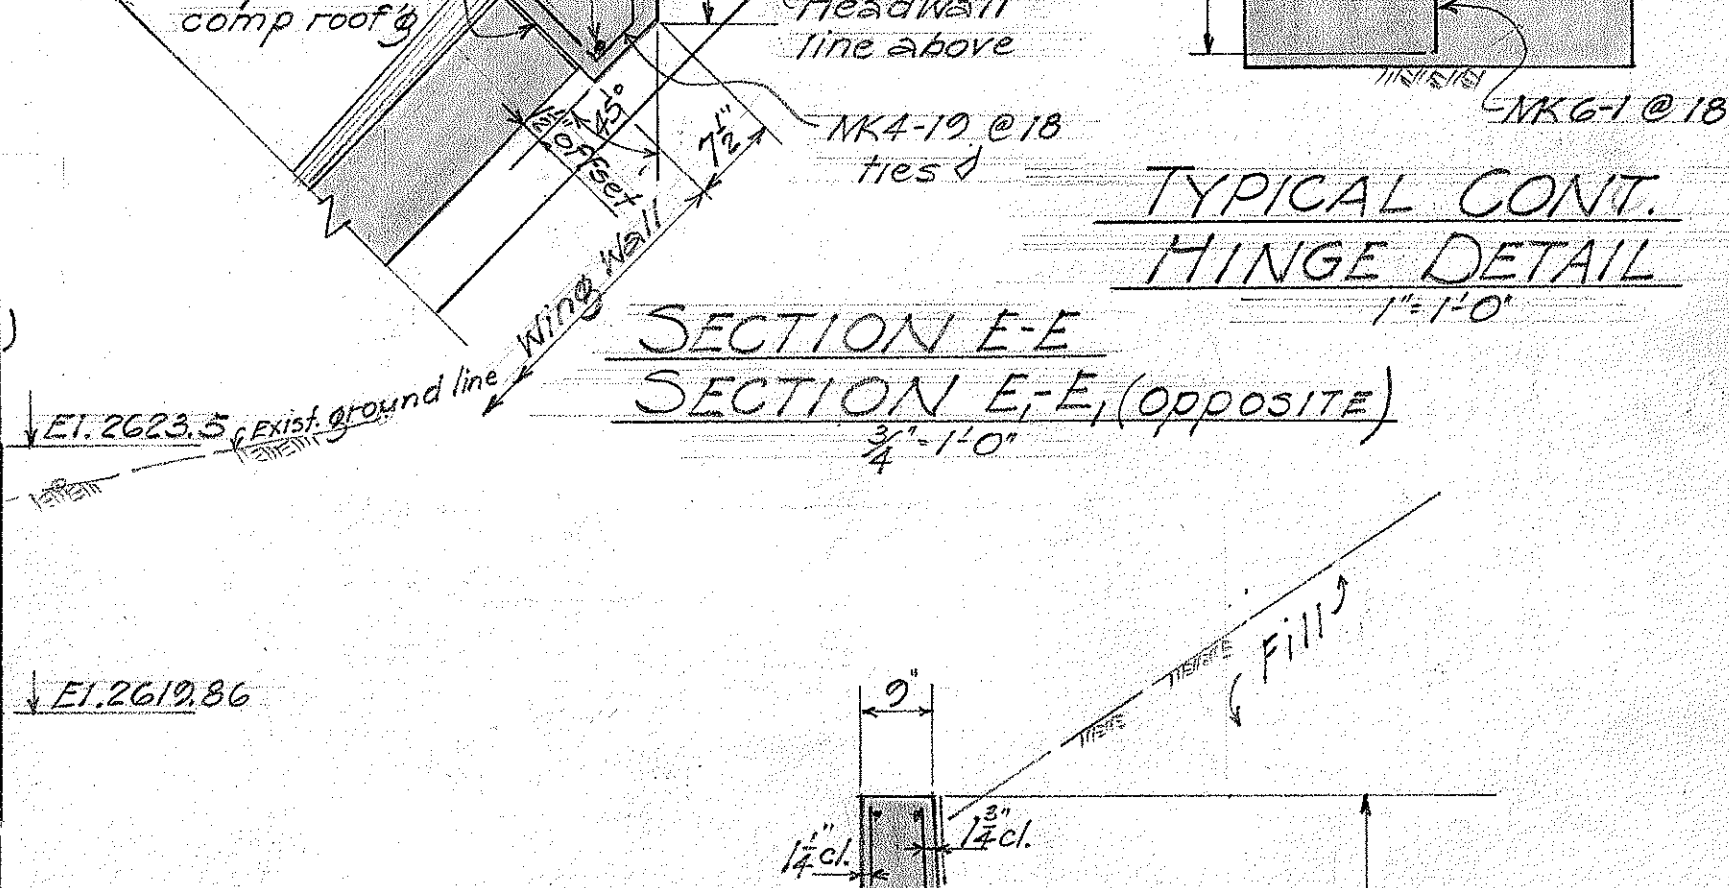
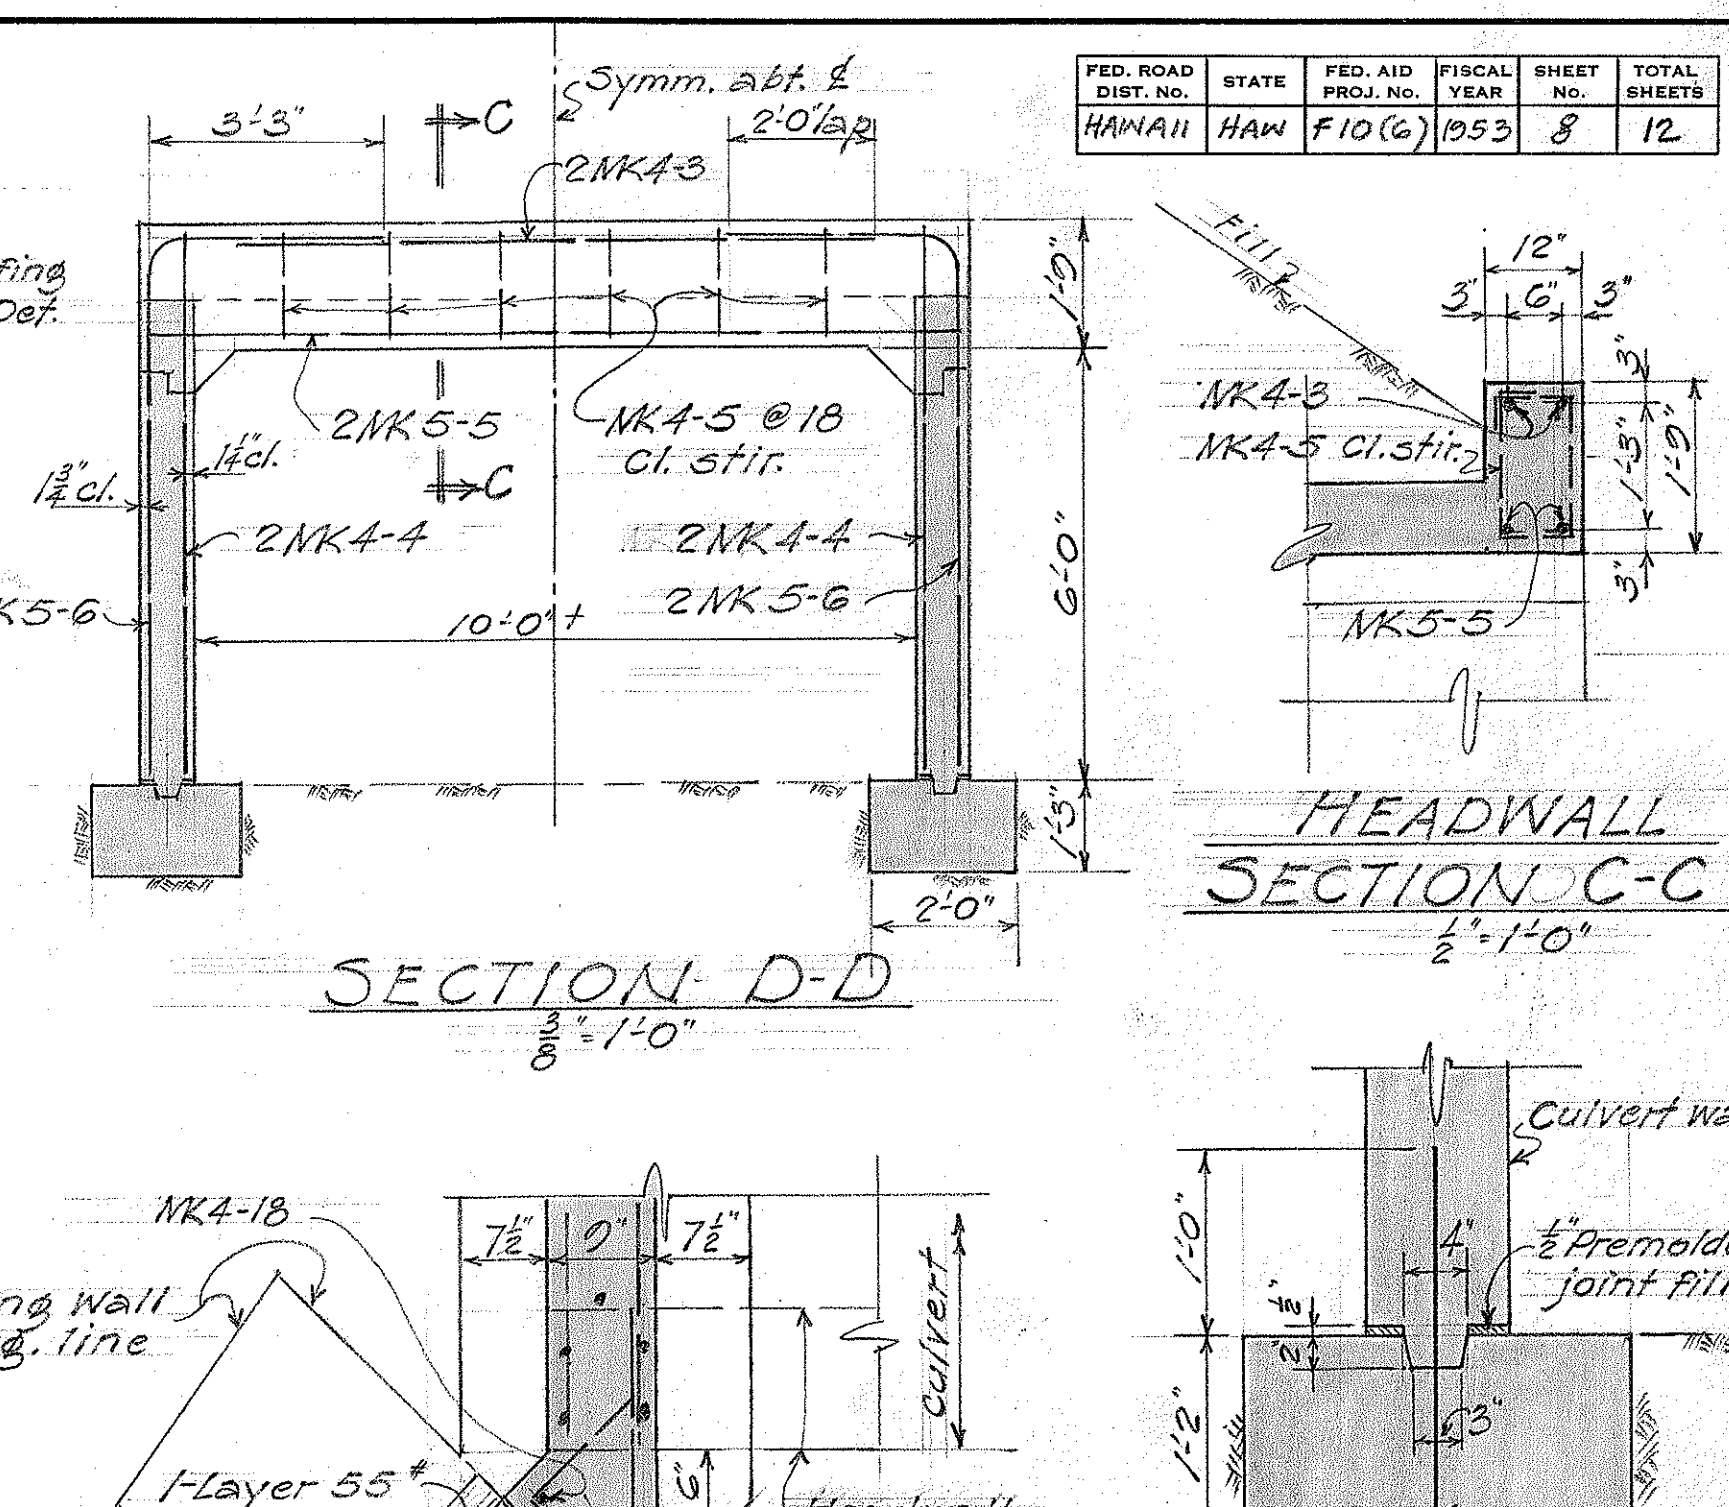
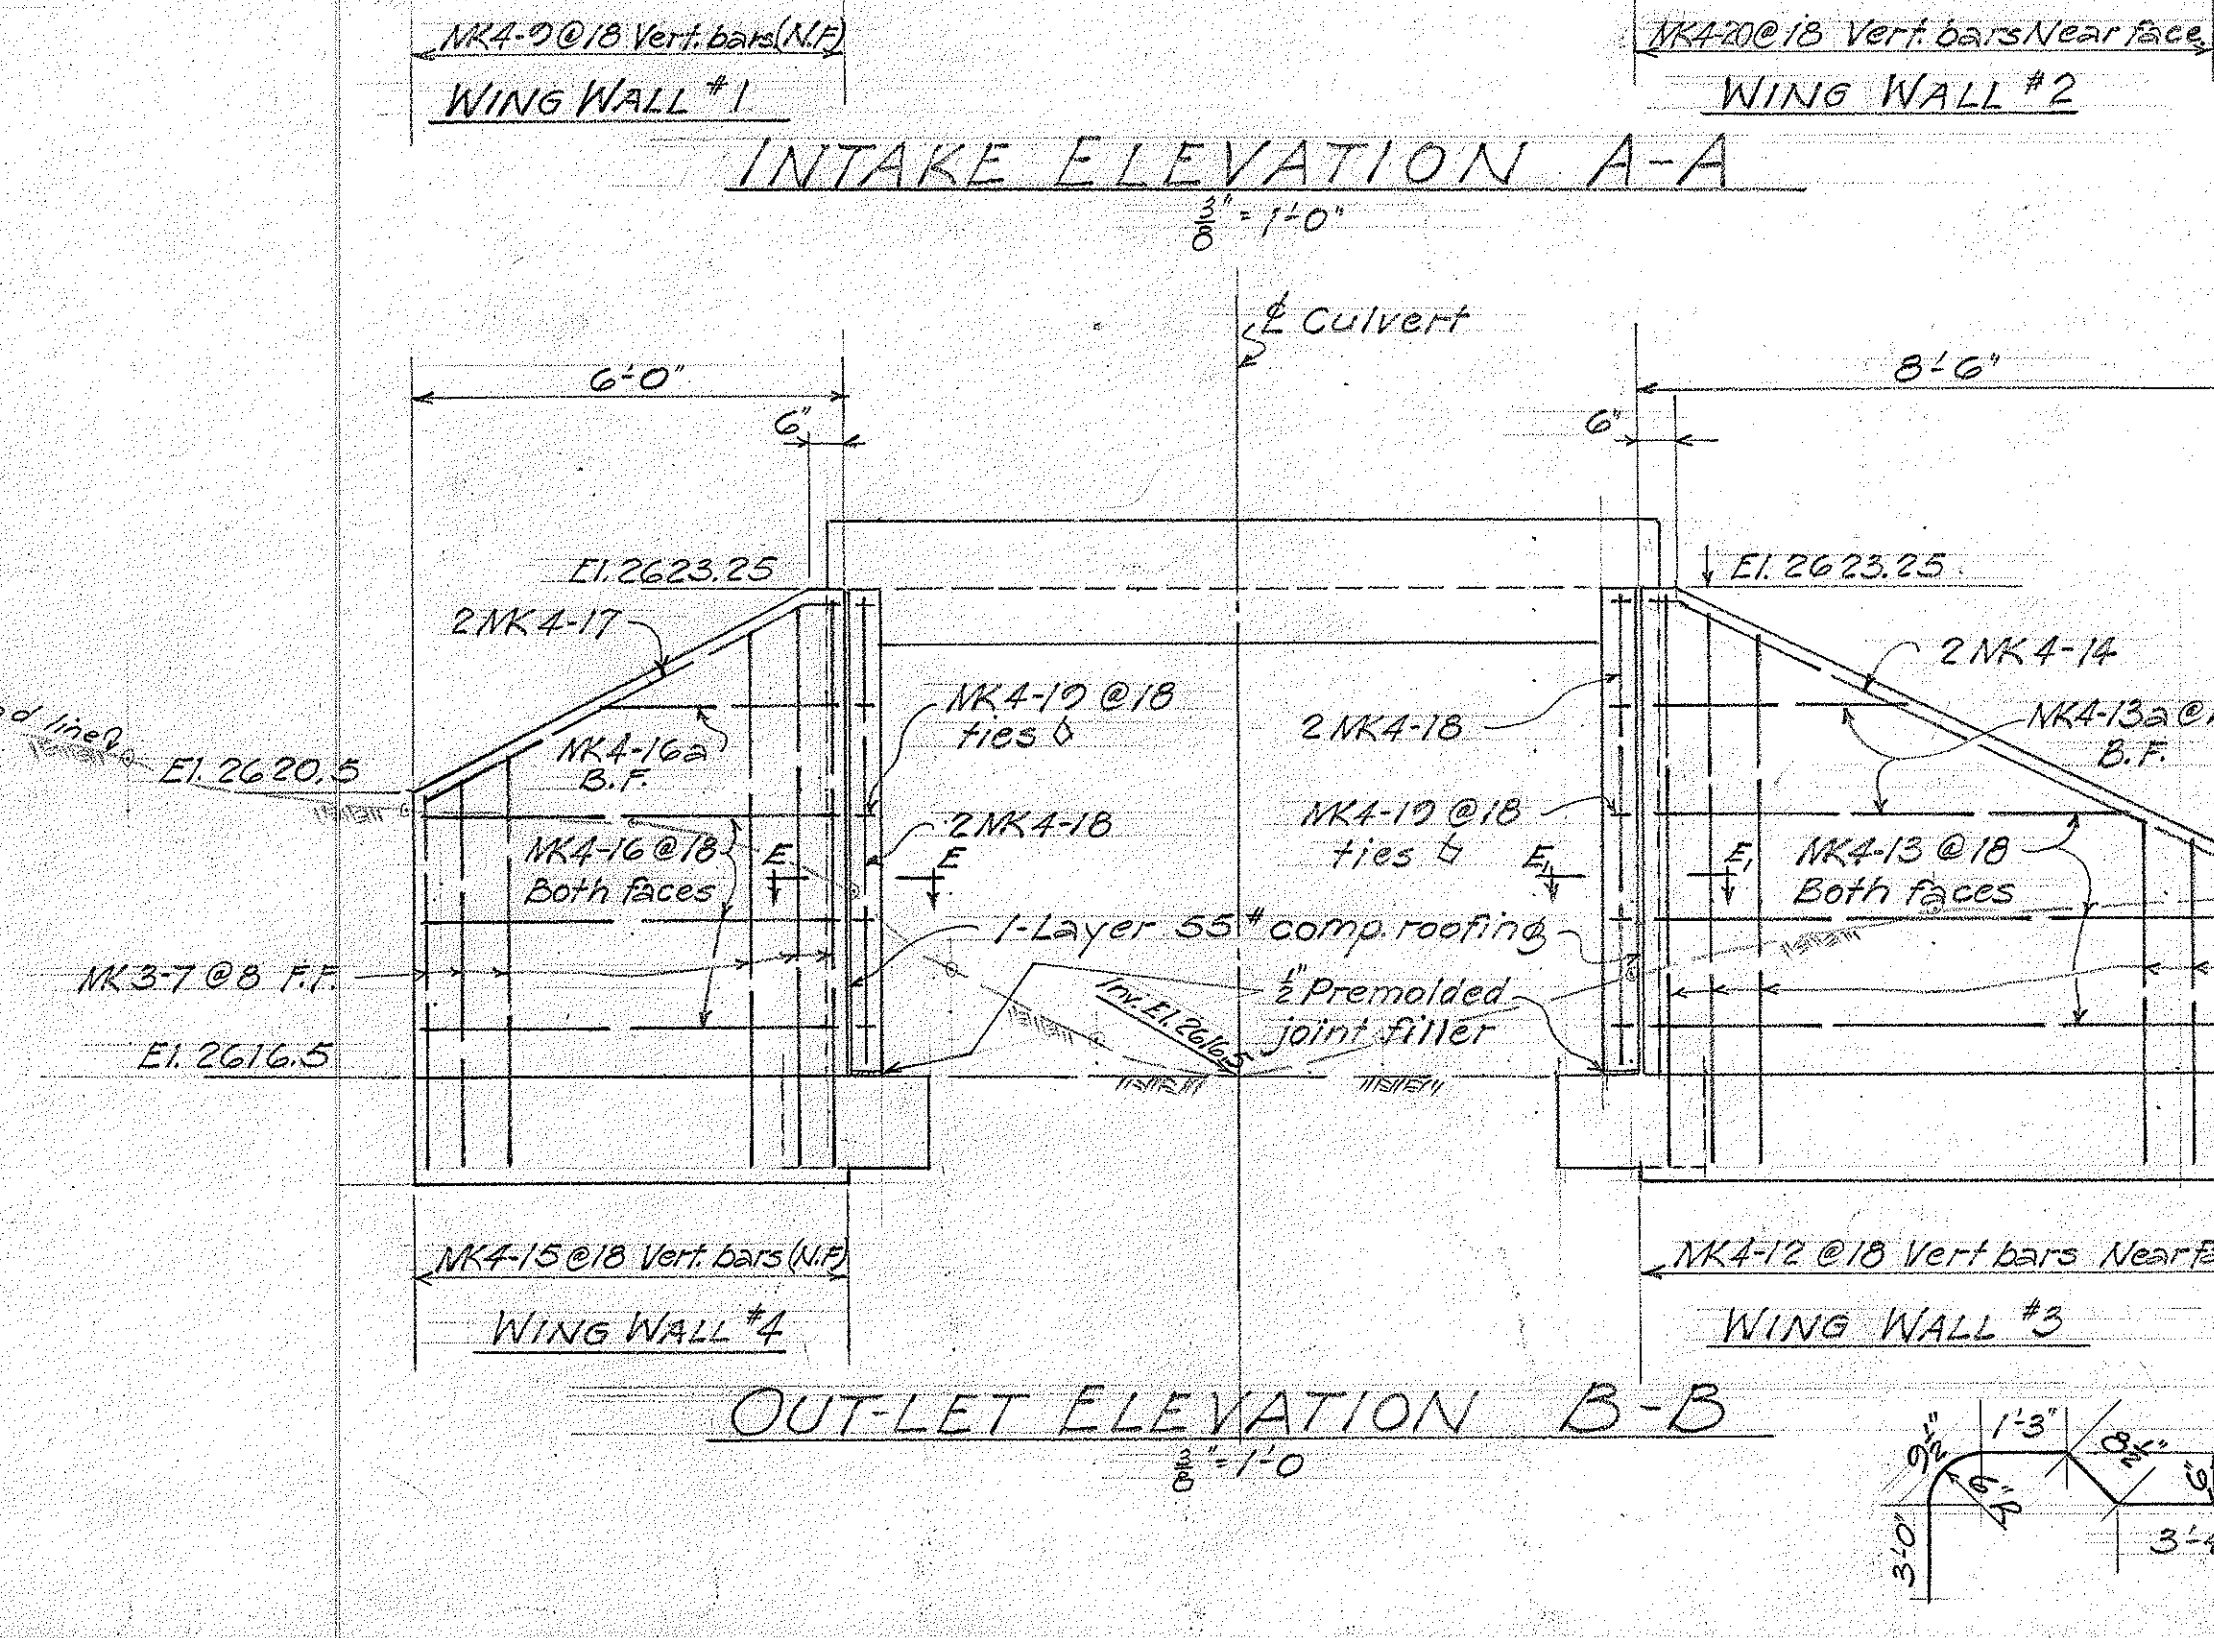
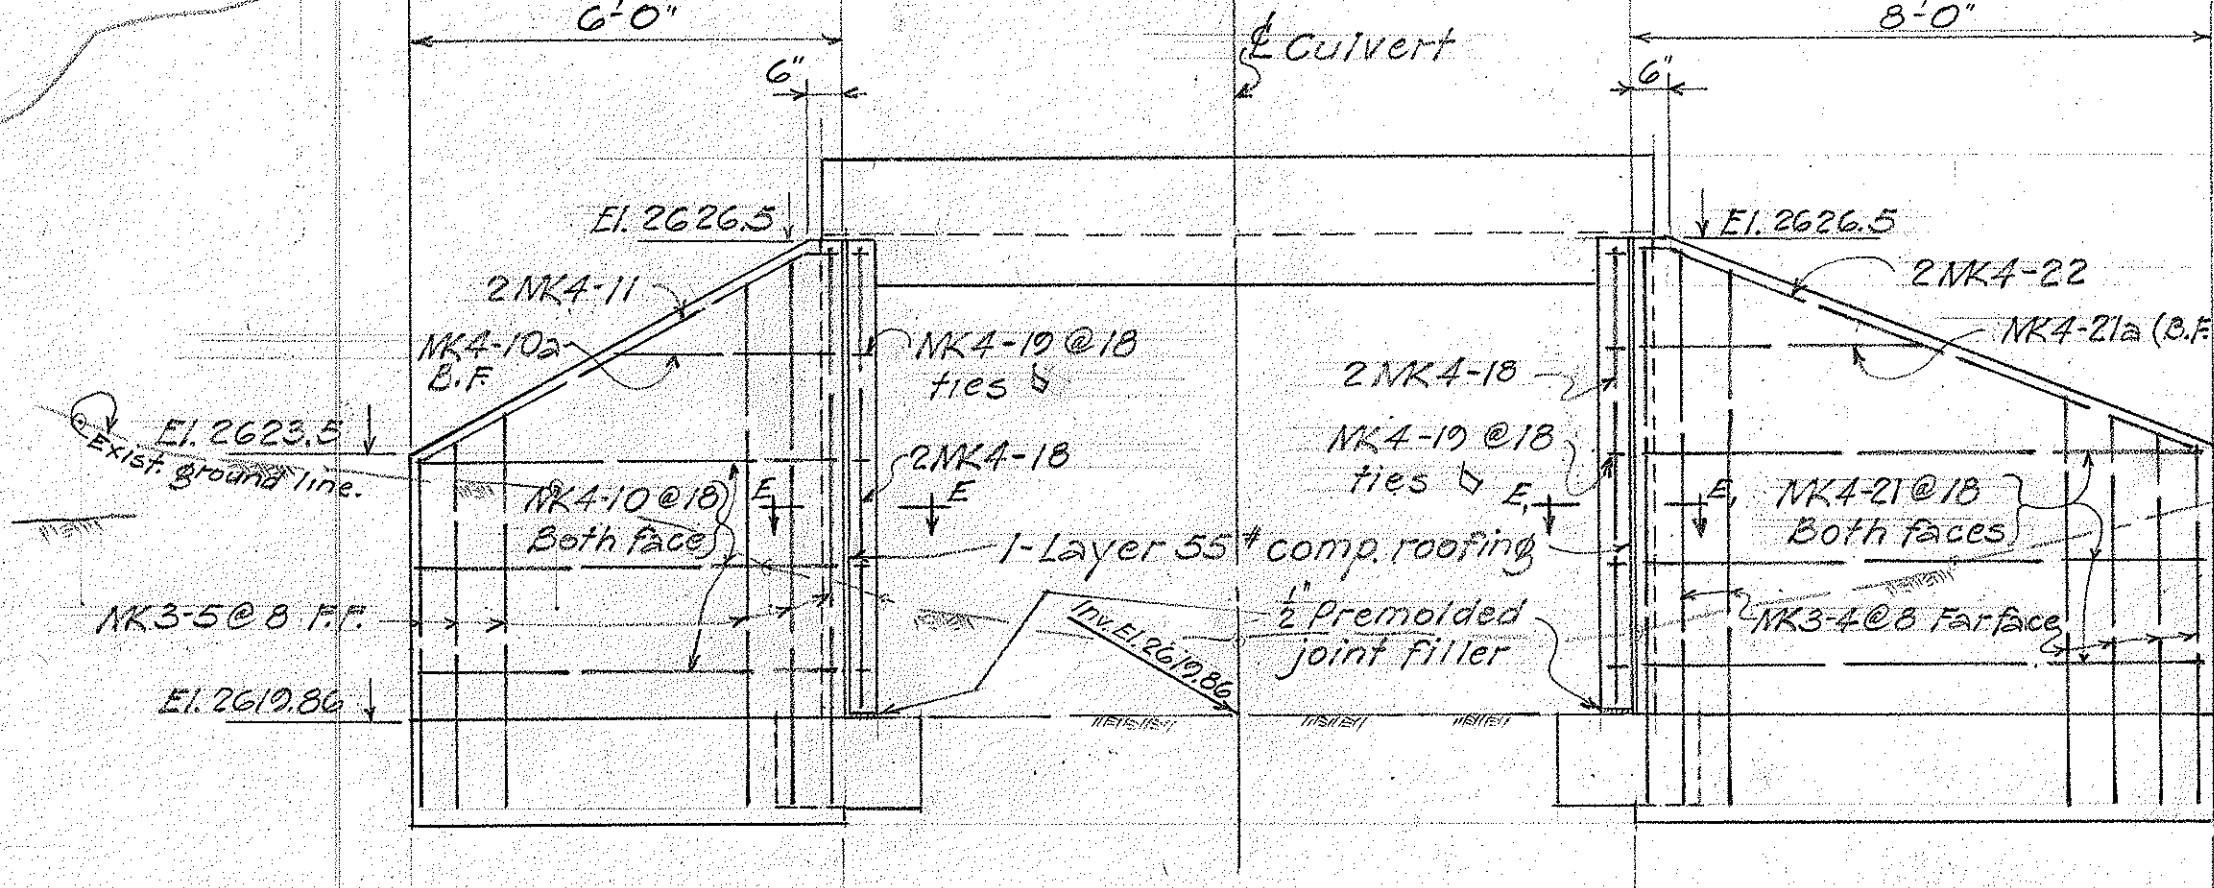
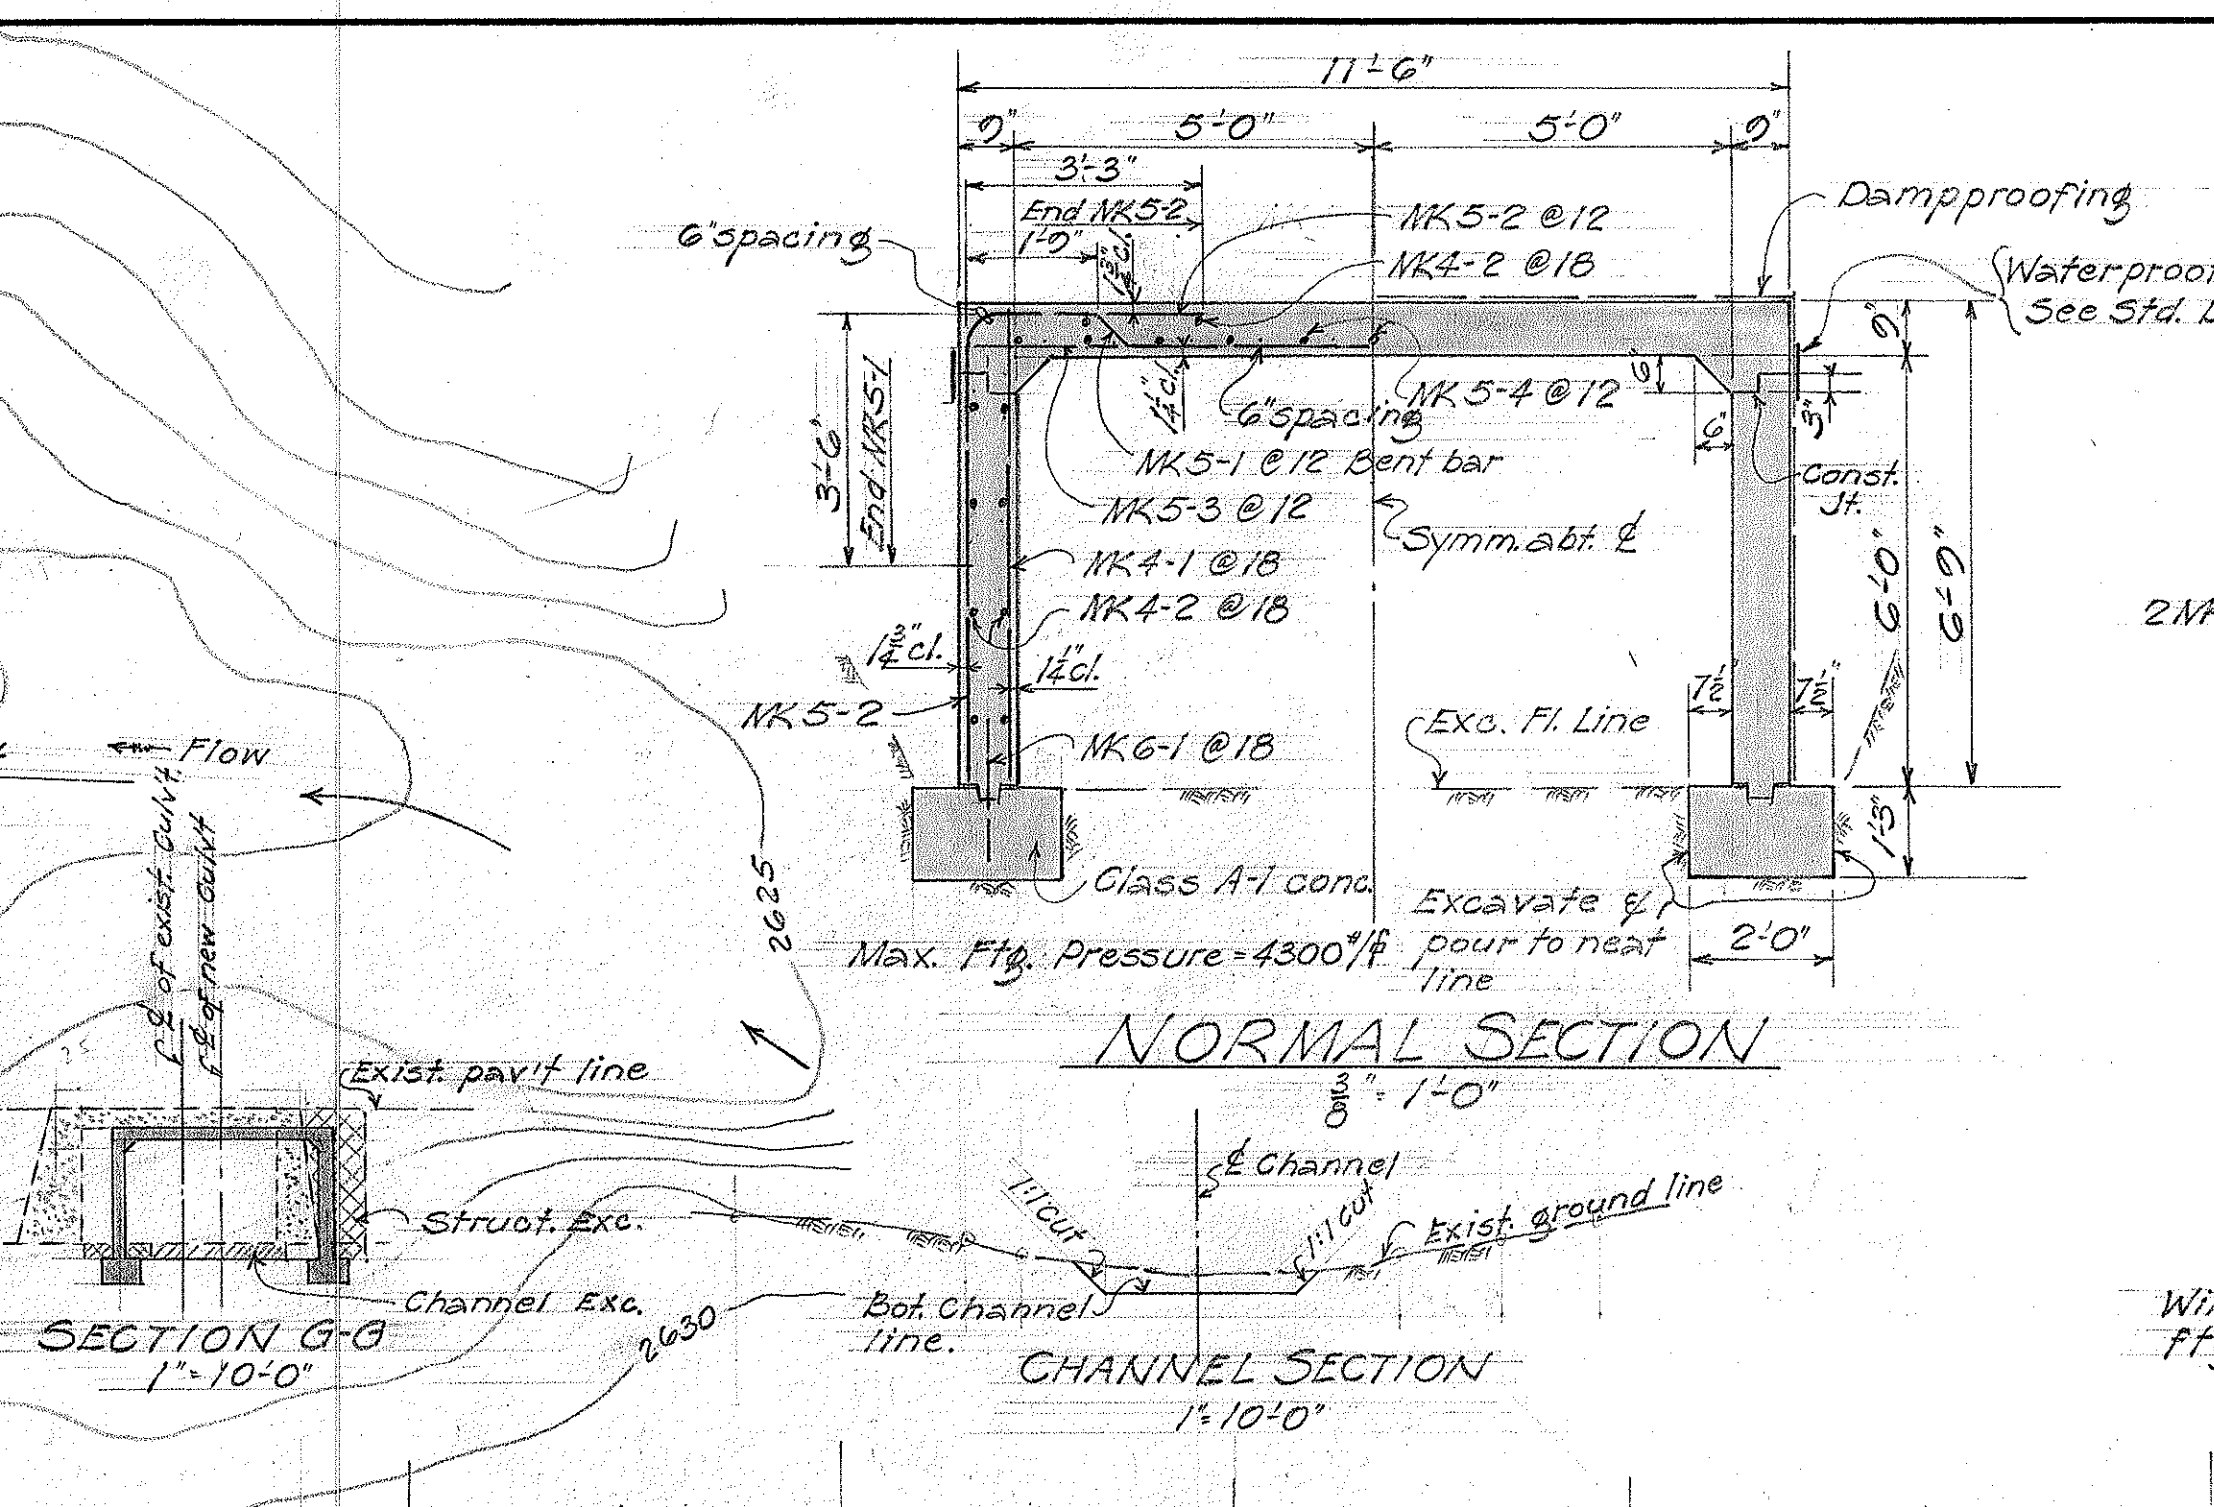
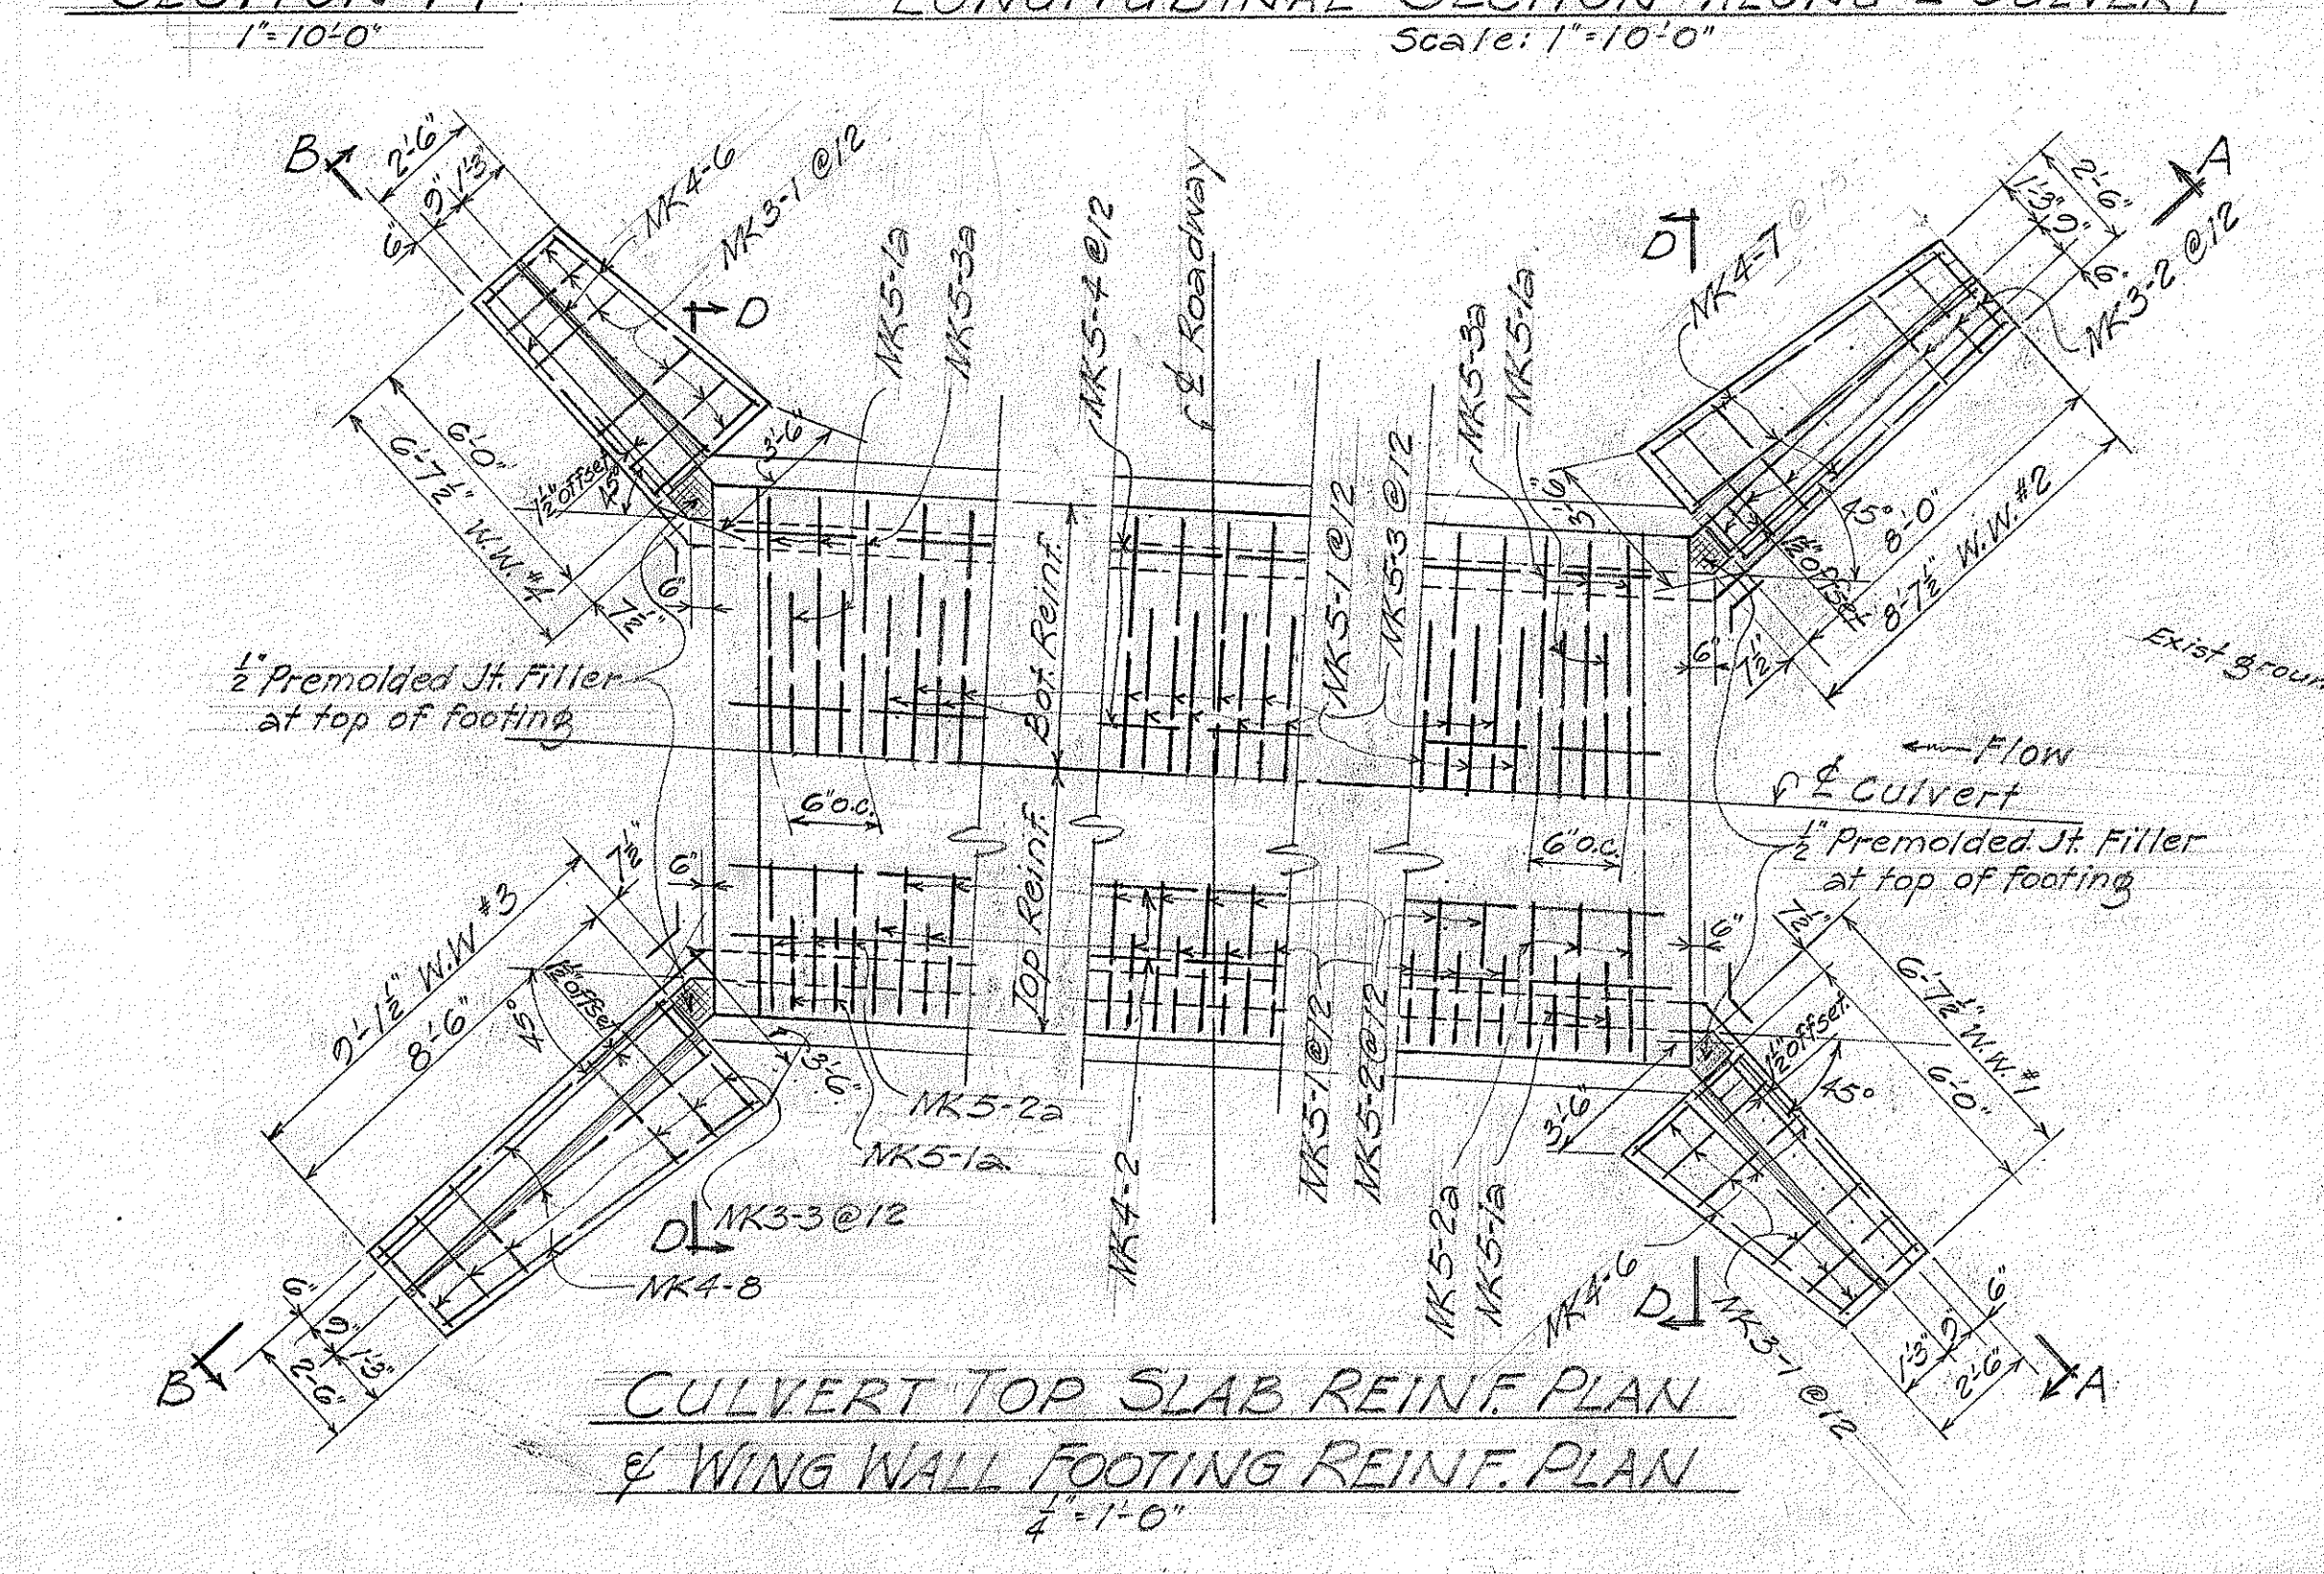
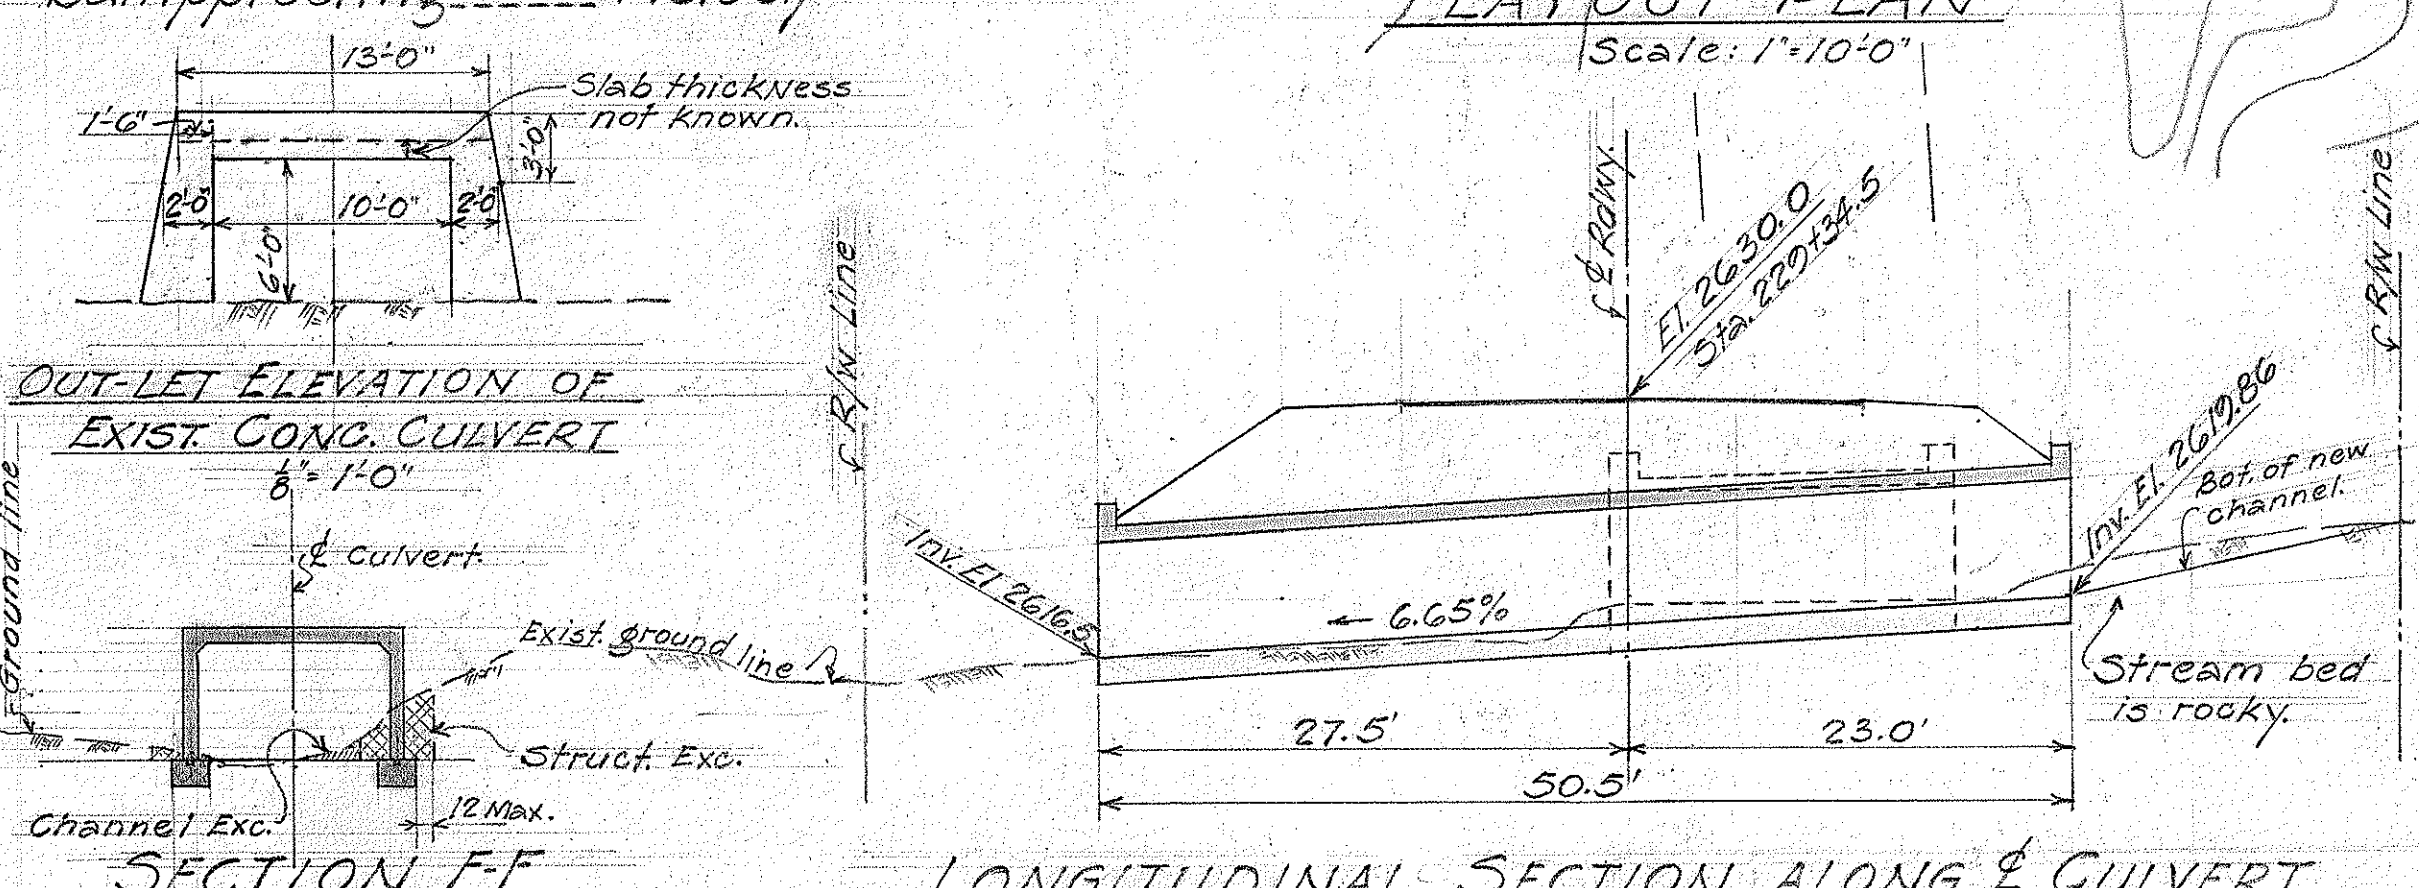


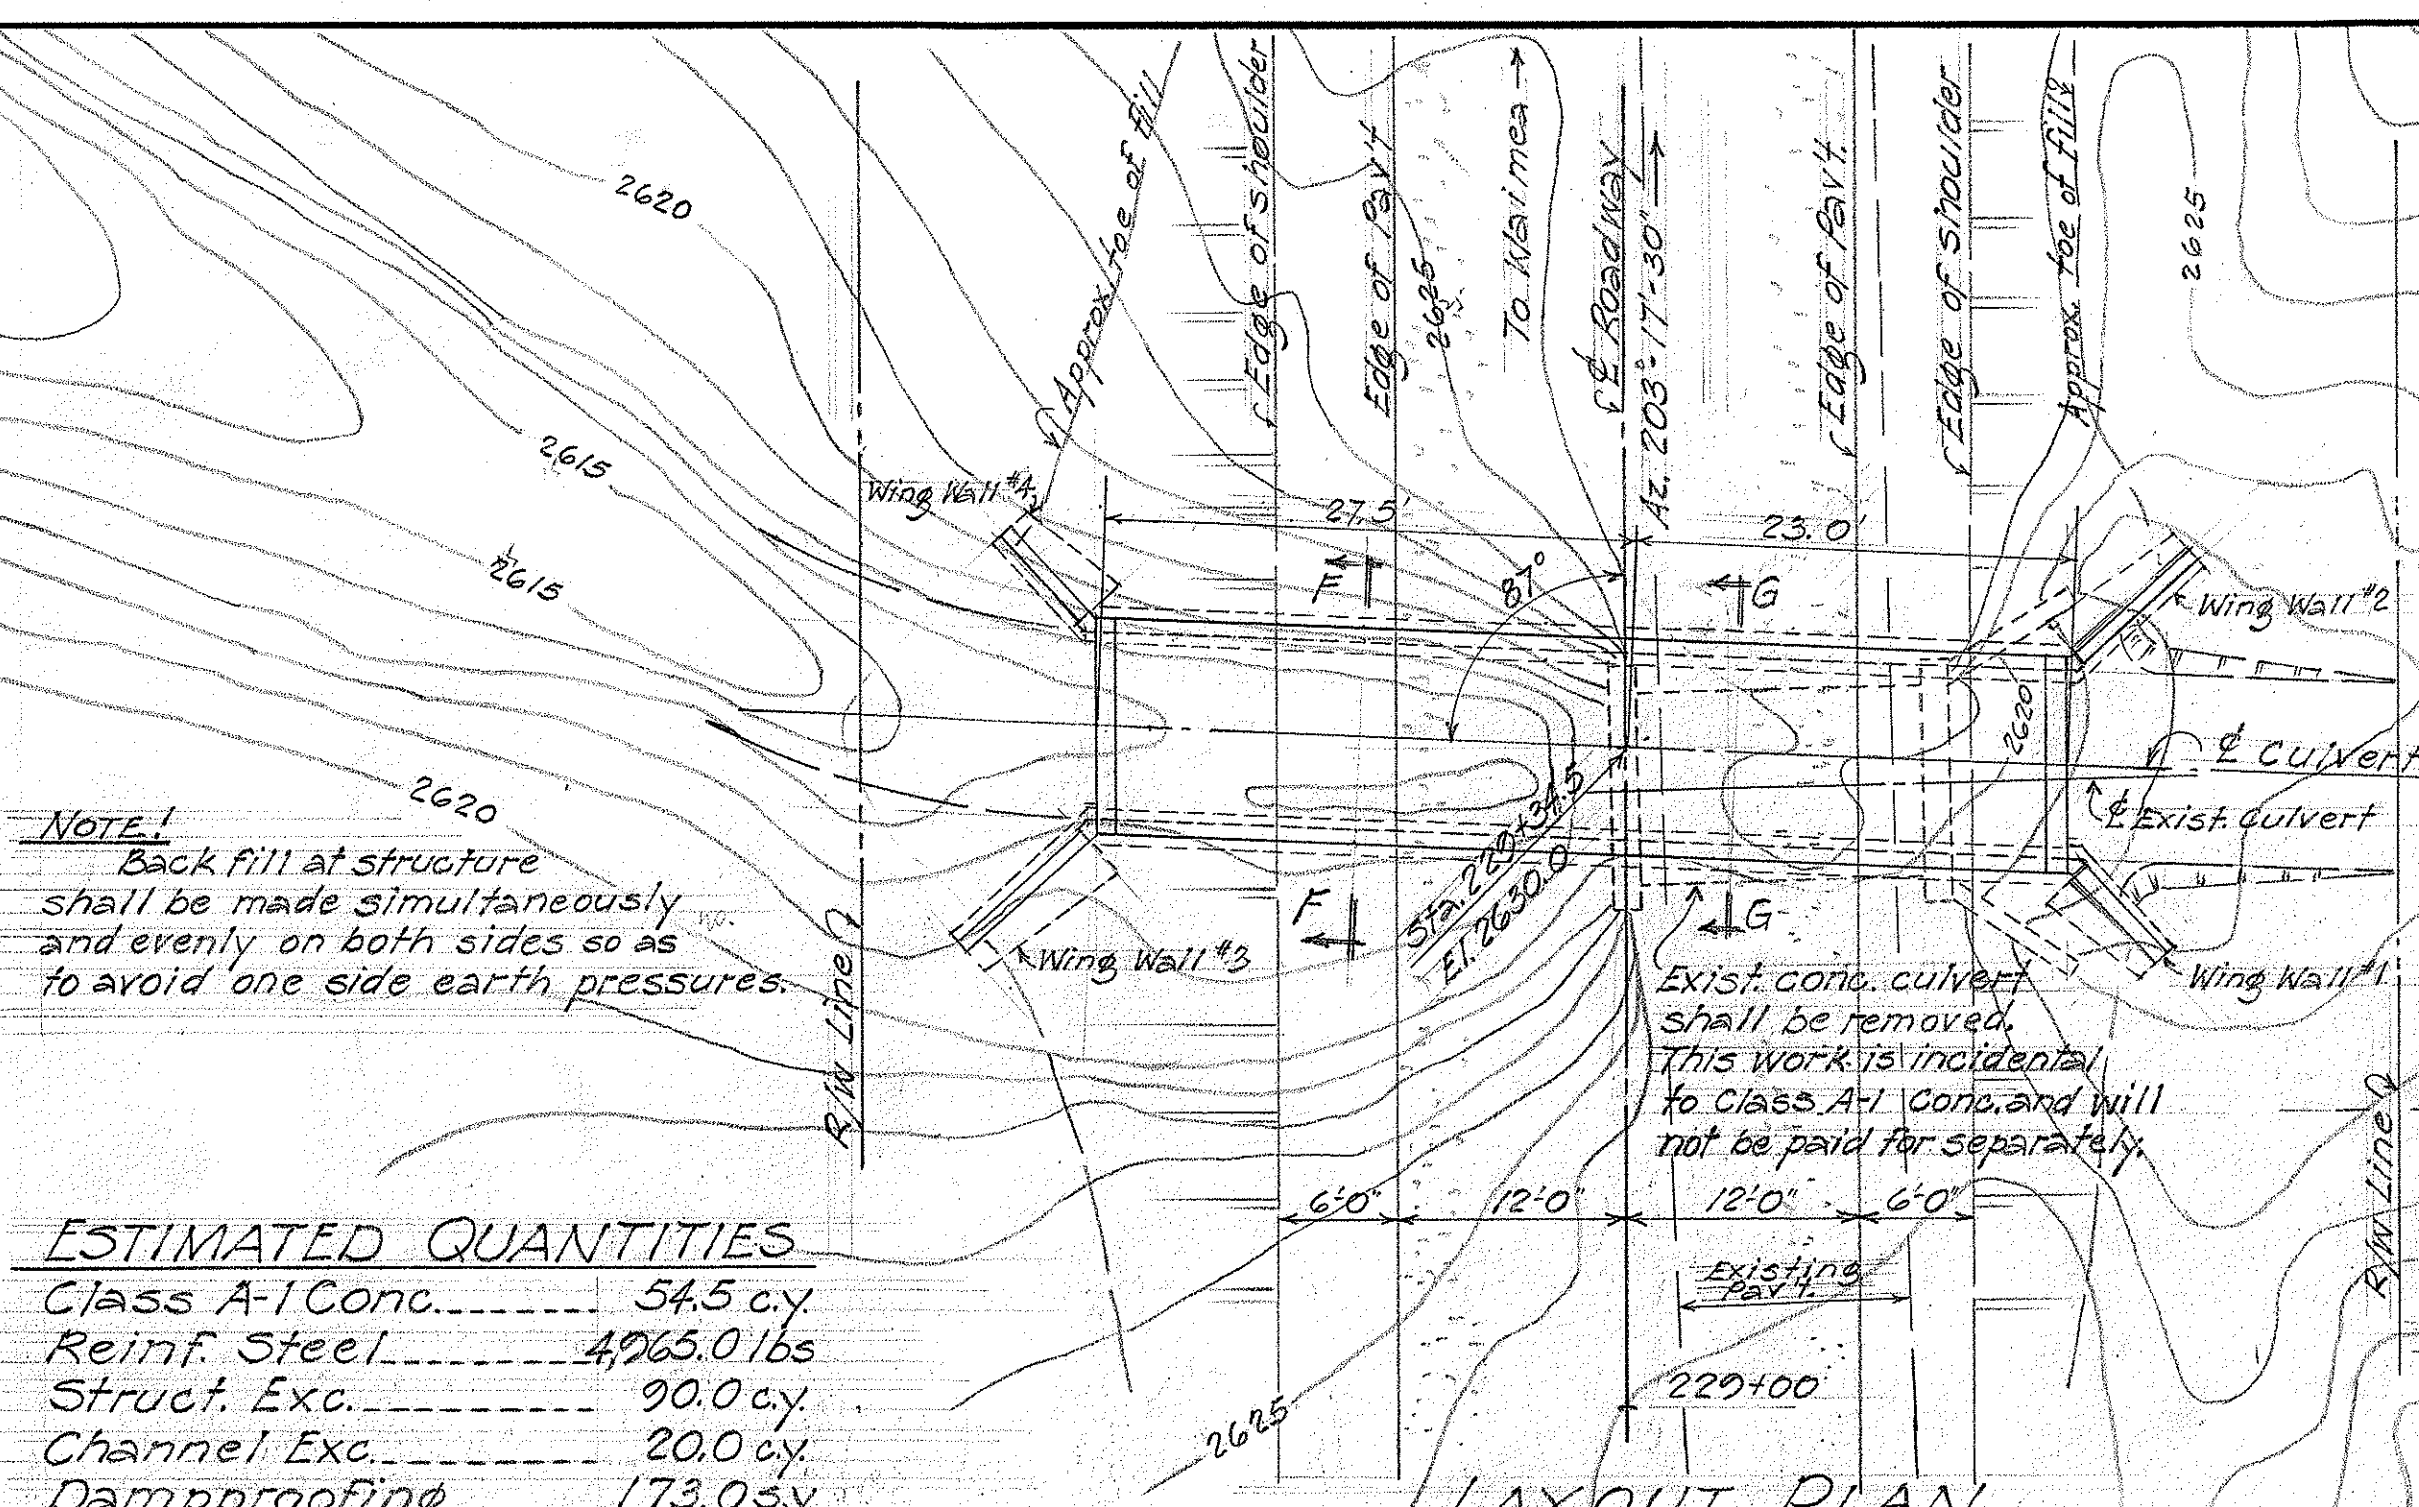

TERRITORIAL HIGHWAY DEPARTMENT
 TERRITORY OF HAWAII
10'-0" x 6'-0" CONG. FRAME CULVERT
 Sta. 229+34.5
 HAWAII BELT ROAD F10(6)
 April 1953
 SHEET No. 1 OF 1 SHEETS

SURVEY PLOTTED BY: DATE: 4-12-53
 DRAWN BY: 4-12-53
 CHECKED BY: 4-12-53
 NOTE BOOK NO. 1