

INDEX TO DRAWINGS	
SHEET	DESCRIPTION
1	TITLE SHEET
2	TYPICAL SECTION
3-4	PLAN & PROFILE
5-7	STANDARD DETAILS
8	DETAILS OF CONC. FRAME CULVERT
9-12	CROSS SECTIONS

TERRITORY OF HAWAII

TERRITORIAL HIGHWAY DEPARTMENT

HONOLULU T.H.

PLANS OF

HAWAII BELT ROAD

FEDERAL AID PROJECT NO. F 10 (6)



DISTRICT OF SOUTH KOHALA

ISLAND OF HAWAII

CONVENTIONAL SIGNS USED

Centerline	----- 150
Boundary Lines	----- or -----
Fences (Noted)	----- or -----
Existing Roadway	=====
Box Culvert	-----  -----
Circular Culvert	-----  -----
Tree (Large)	-----  or  -----
Telephone Pole	----- o TP -----
Centerline Monument	----- @ -----

SCALES	
PLAN	----- 1 INCH = 100 FT.
PROFILE	HOR. 1 INCH = 100 FT.
	VER. 1 INCH = 10 FT.
CROSS SECTION	HOR. 1 INCH = 10 FT.
	VER. 1 INCH = 10 FT.

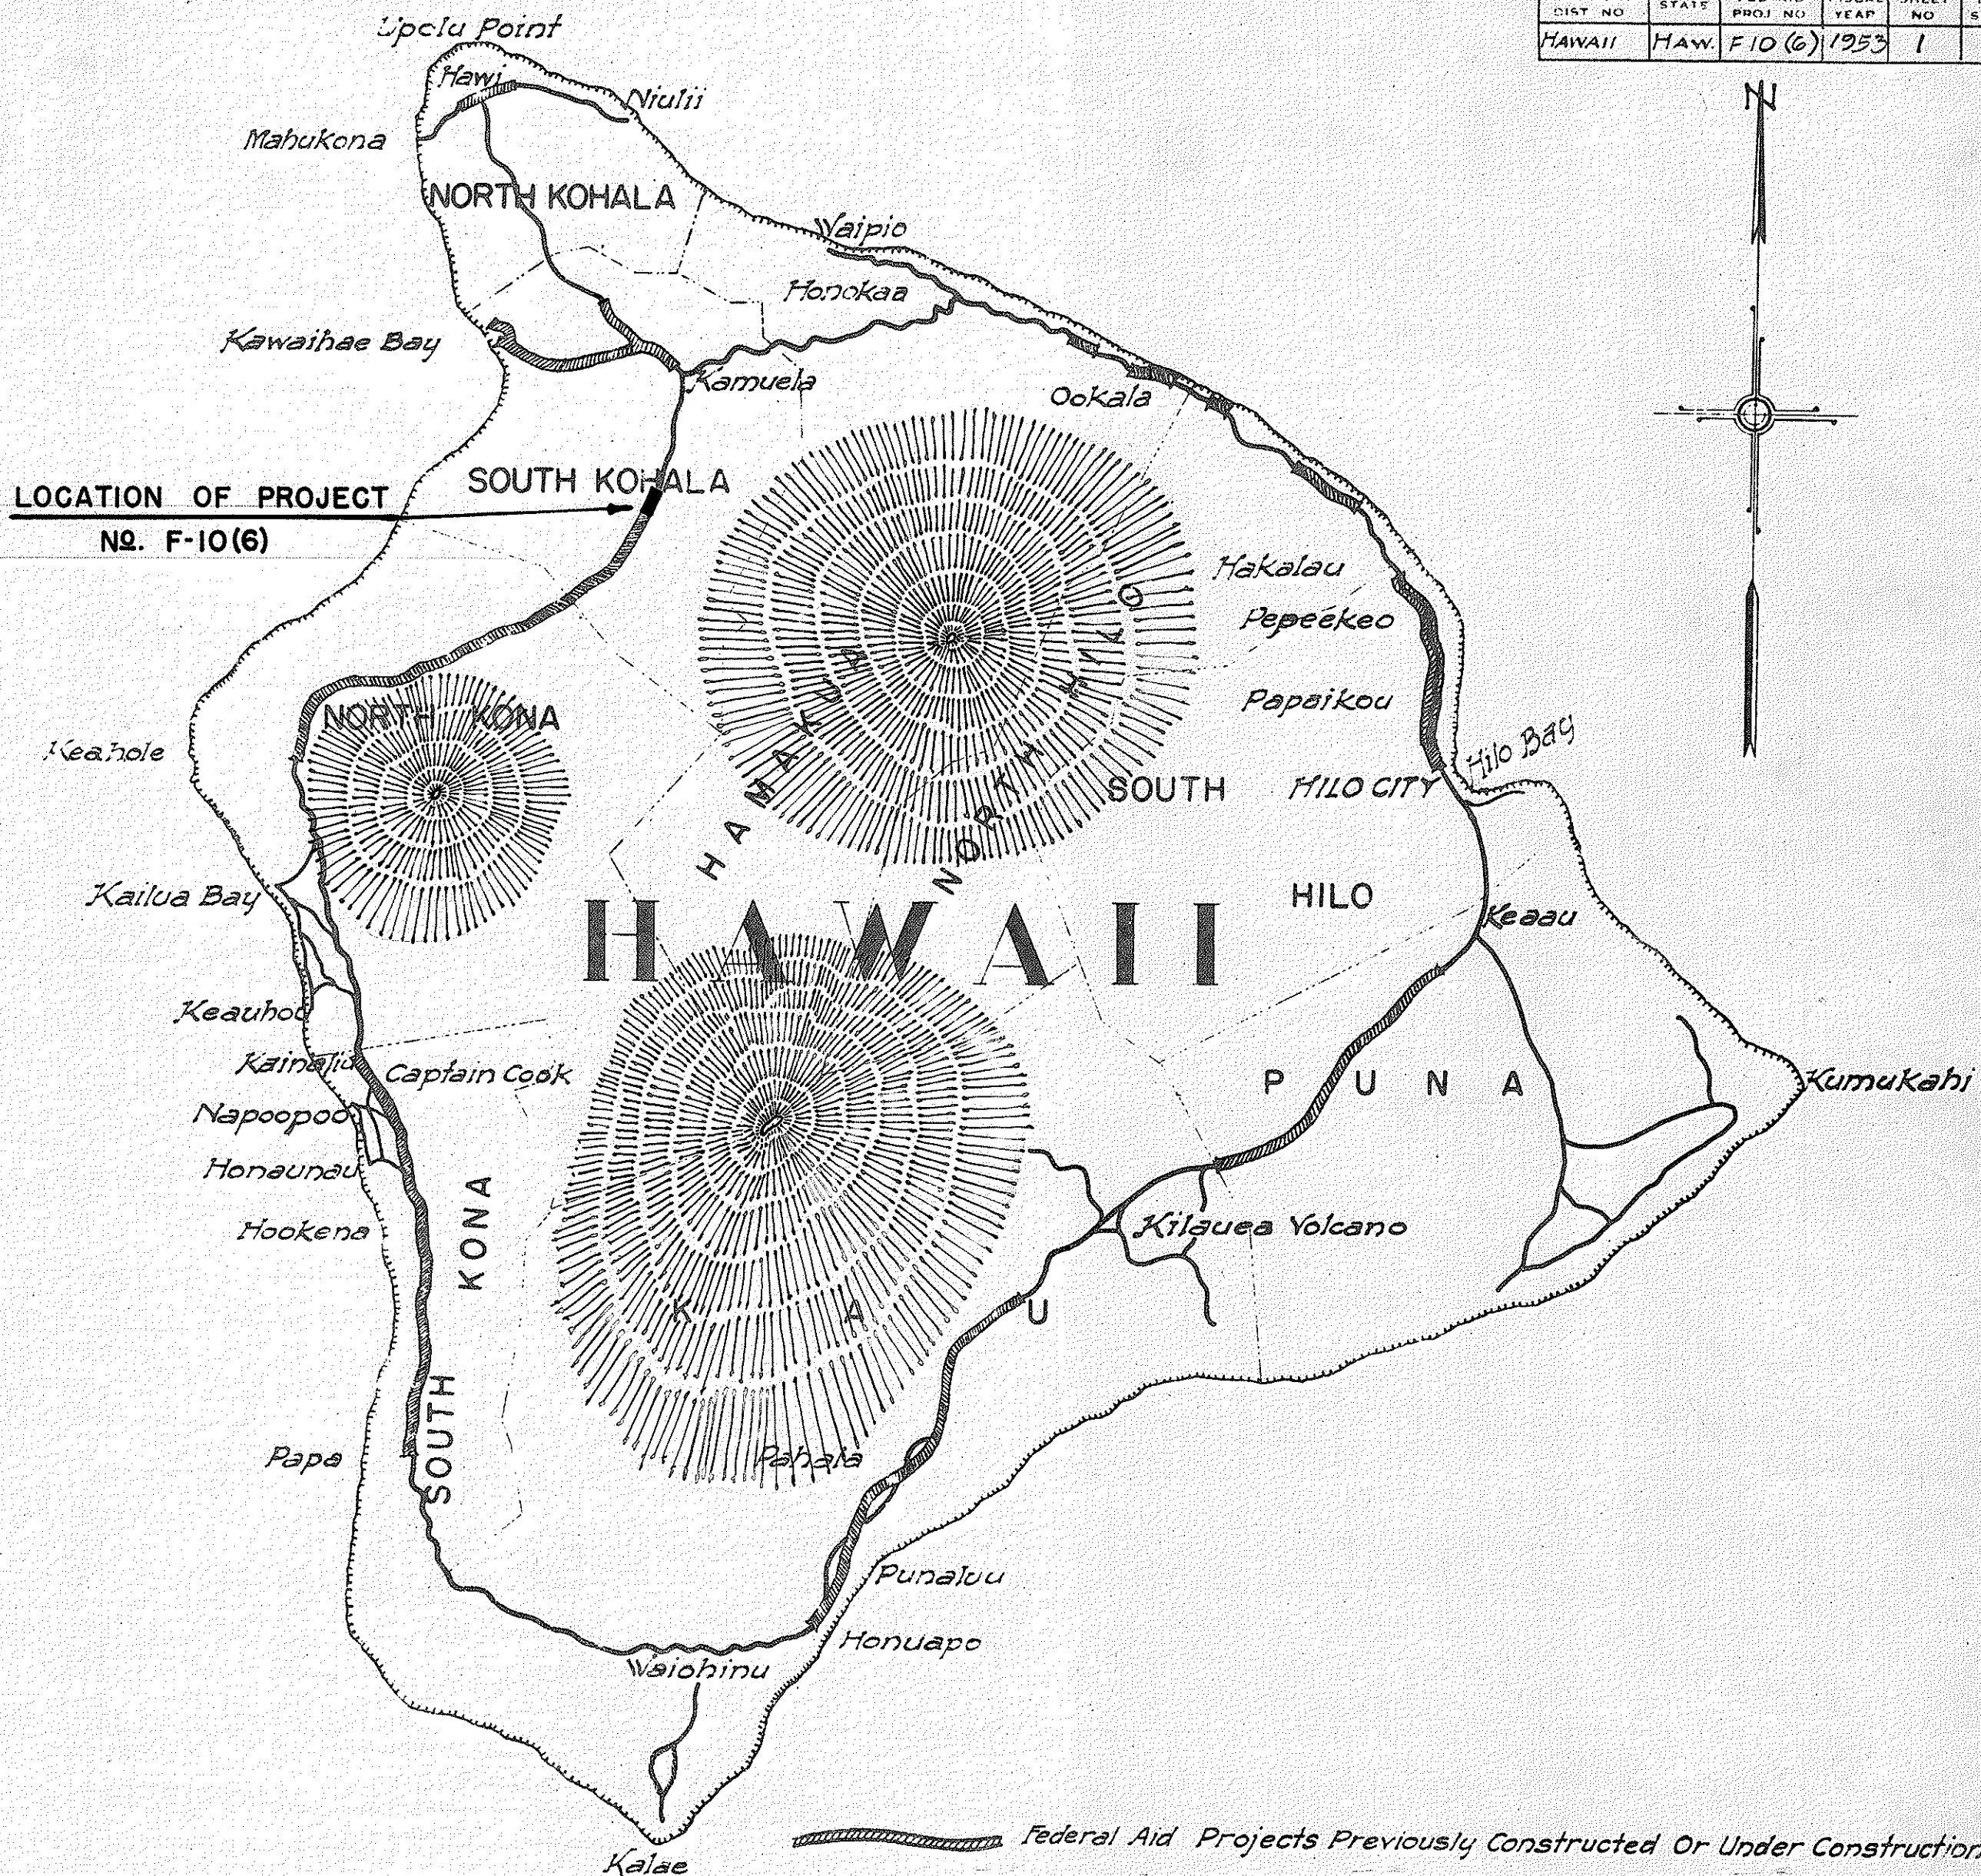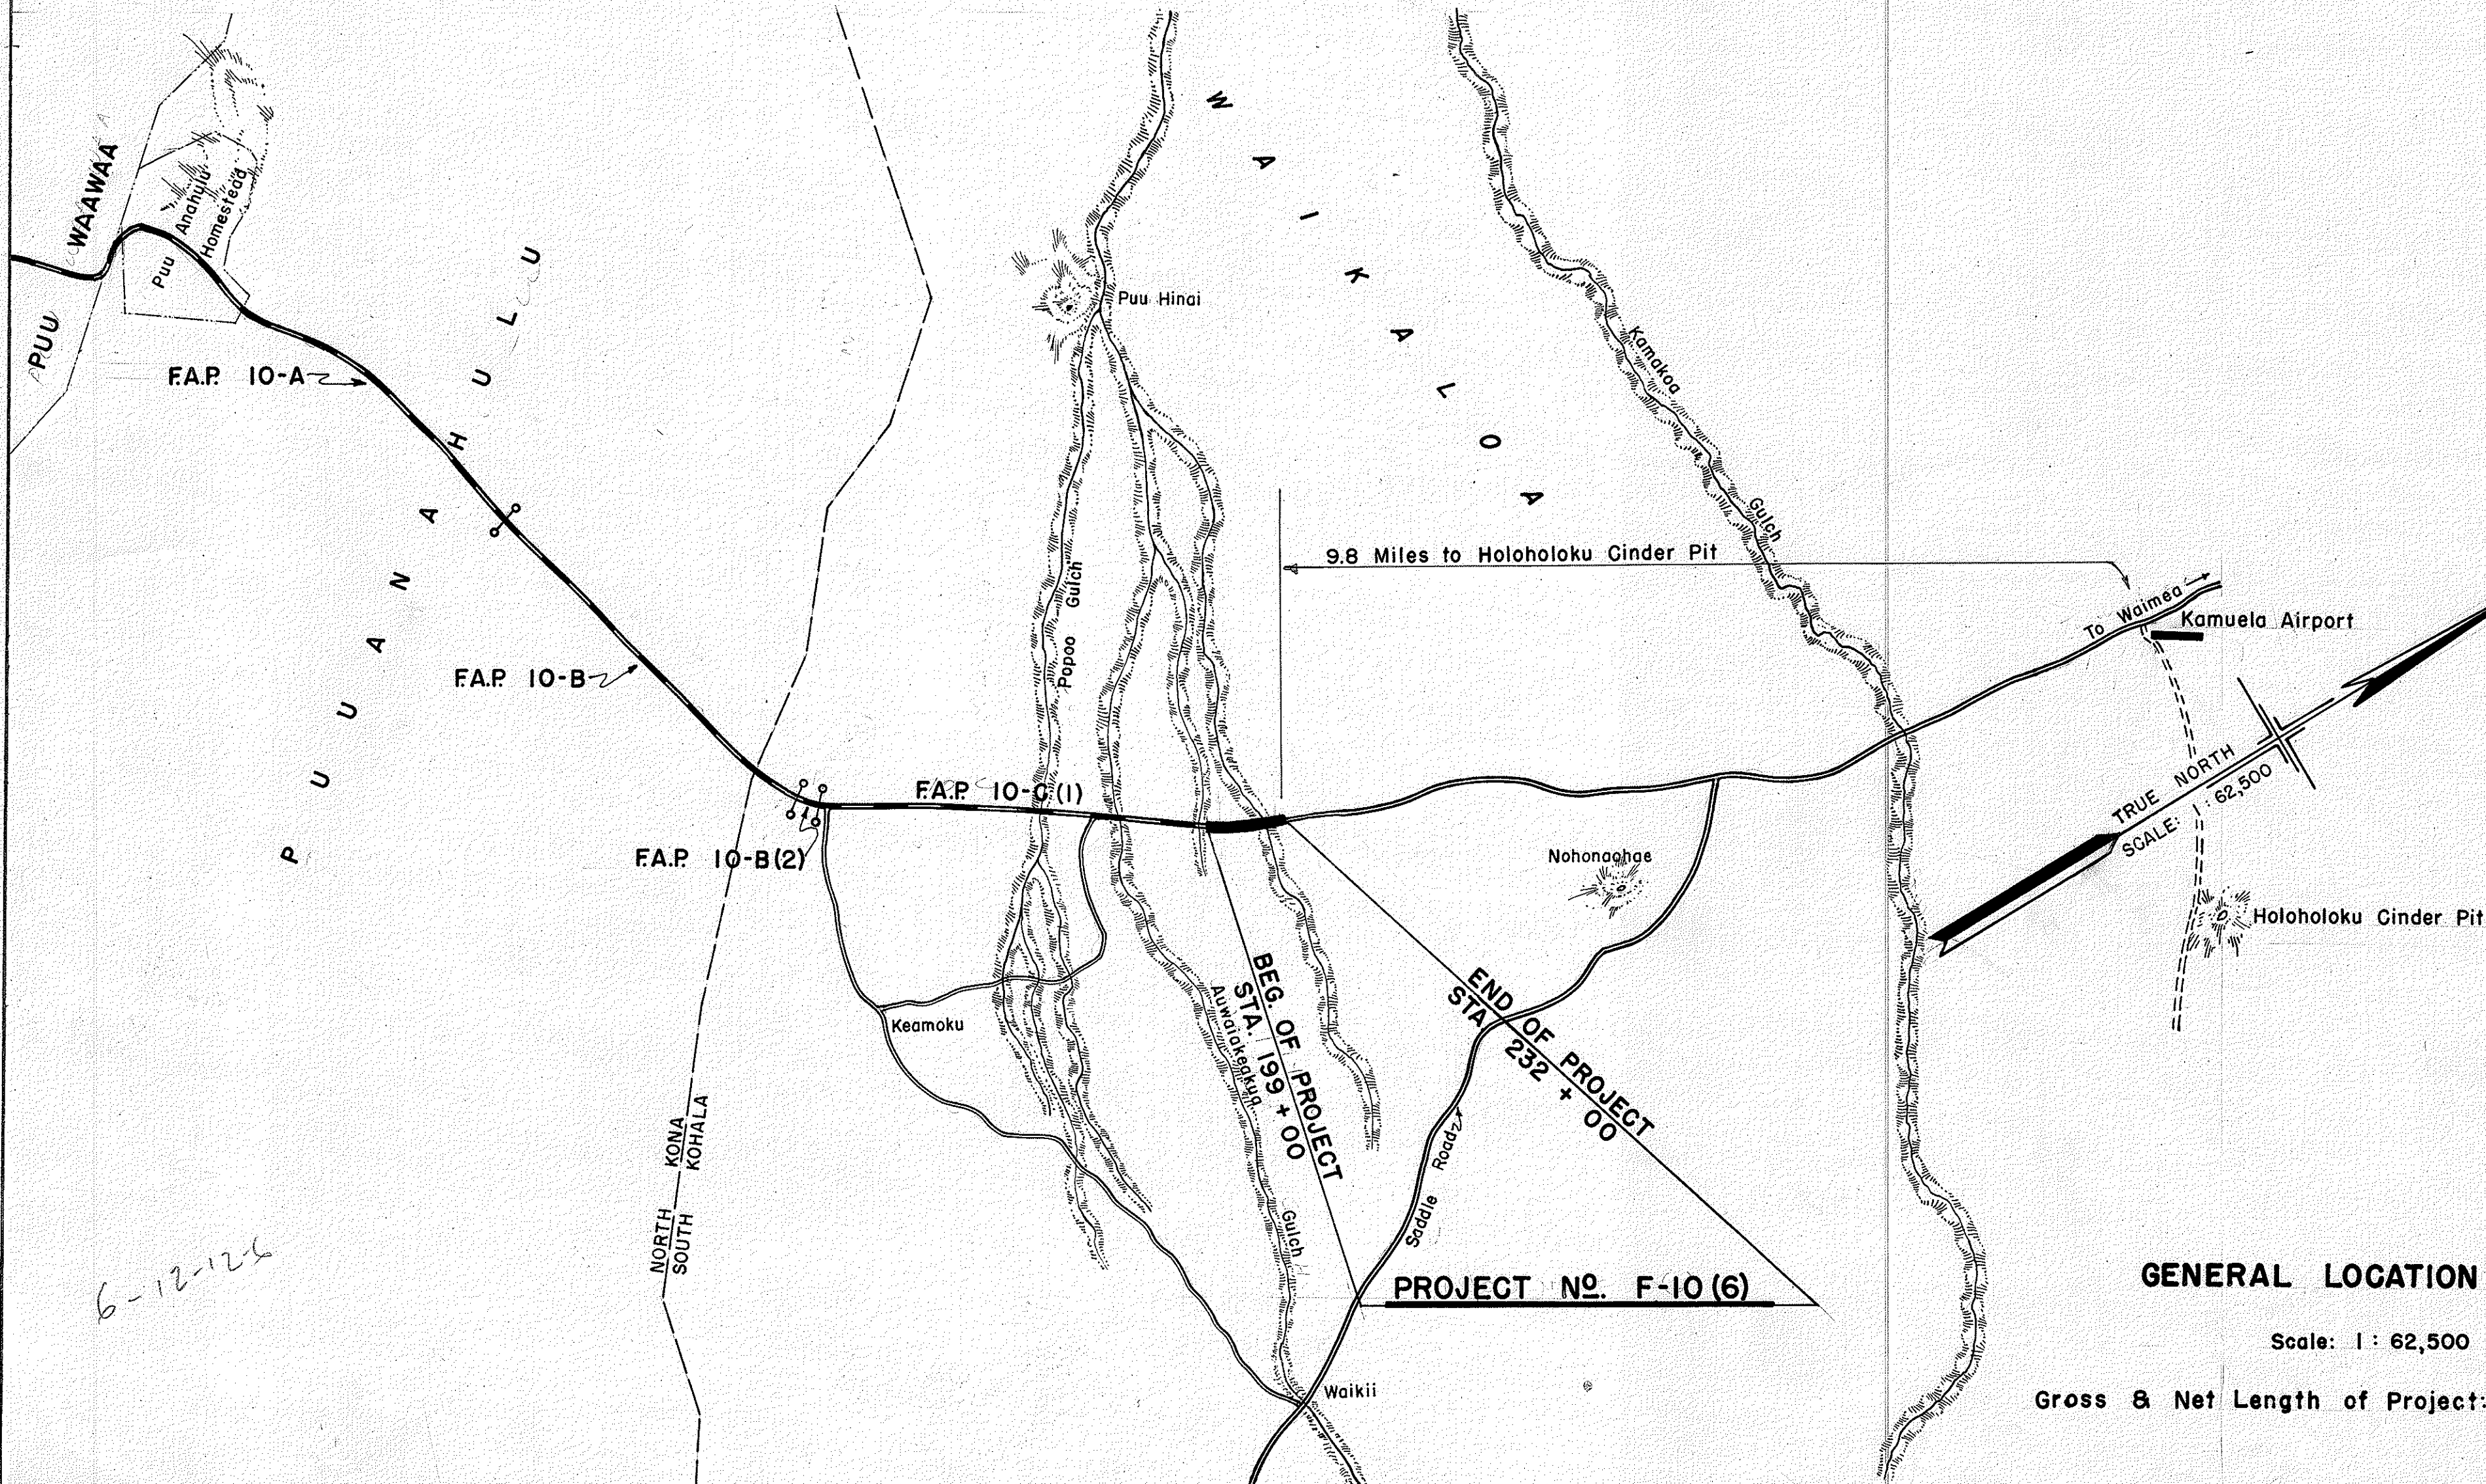


NOTE:

ALL CHANGES MADE DURING CONSTRUCTION

HAVE BEEN NOTED IN RED ON THESE TRACINGS

AND CHECKED BY:

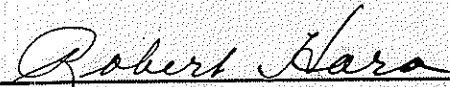

RESIDENT ENGINEER

4/2/54

DATE

DEPARTMENT OF COMMERCE

BUREAU OF PUBLIC ROADS

APPROVED:



DISTRICT ENGINEER

DATE


APPROVED:

DATE 4/24/53



TERRITORIAL HIGHWAY ENGINEER

FED. ROAD DIST. NO.	STATE	FED. AID PROJ. NO.	FISCAL YEAR	SHEET NO.	TOTAL SHEETS
HAWAII	HAW.	F 10 (6)	1953	1	12

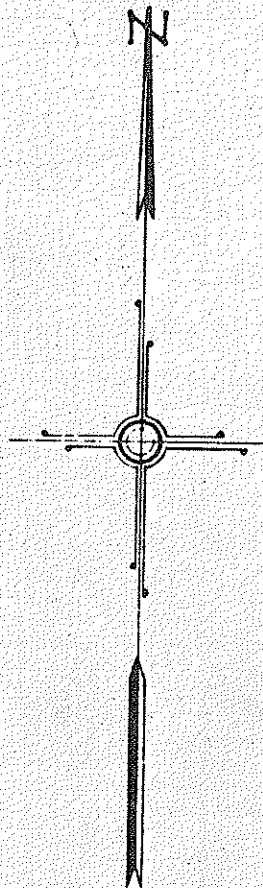

GENERAL LOCATION PLAN

Scale: 1 : 62,500

Gross & Net Length of Project: 0.625 Miles