



PLAN	SURVEYED	DATE
	BY	
	PLOTTED	
	NOTE BOOK	
	RT. OF WAY CHECKED	
	NO.	

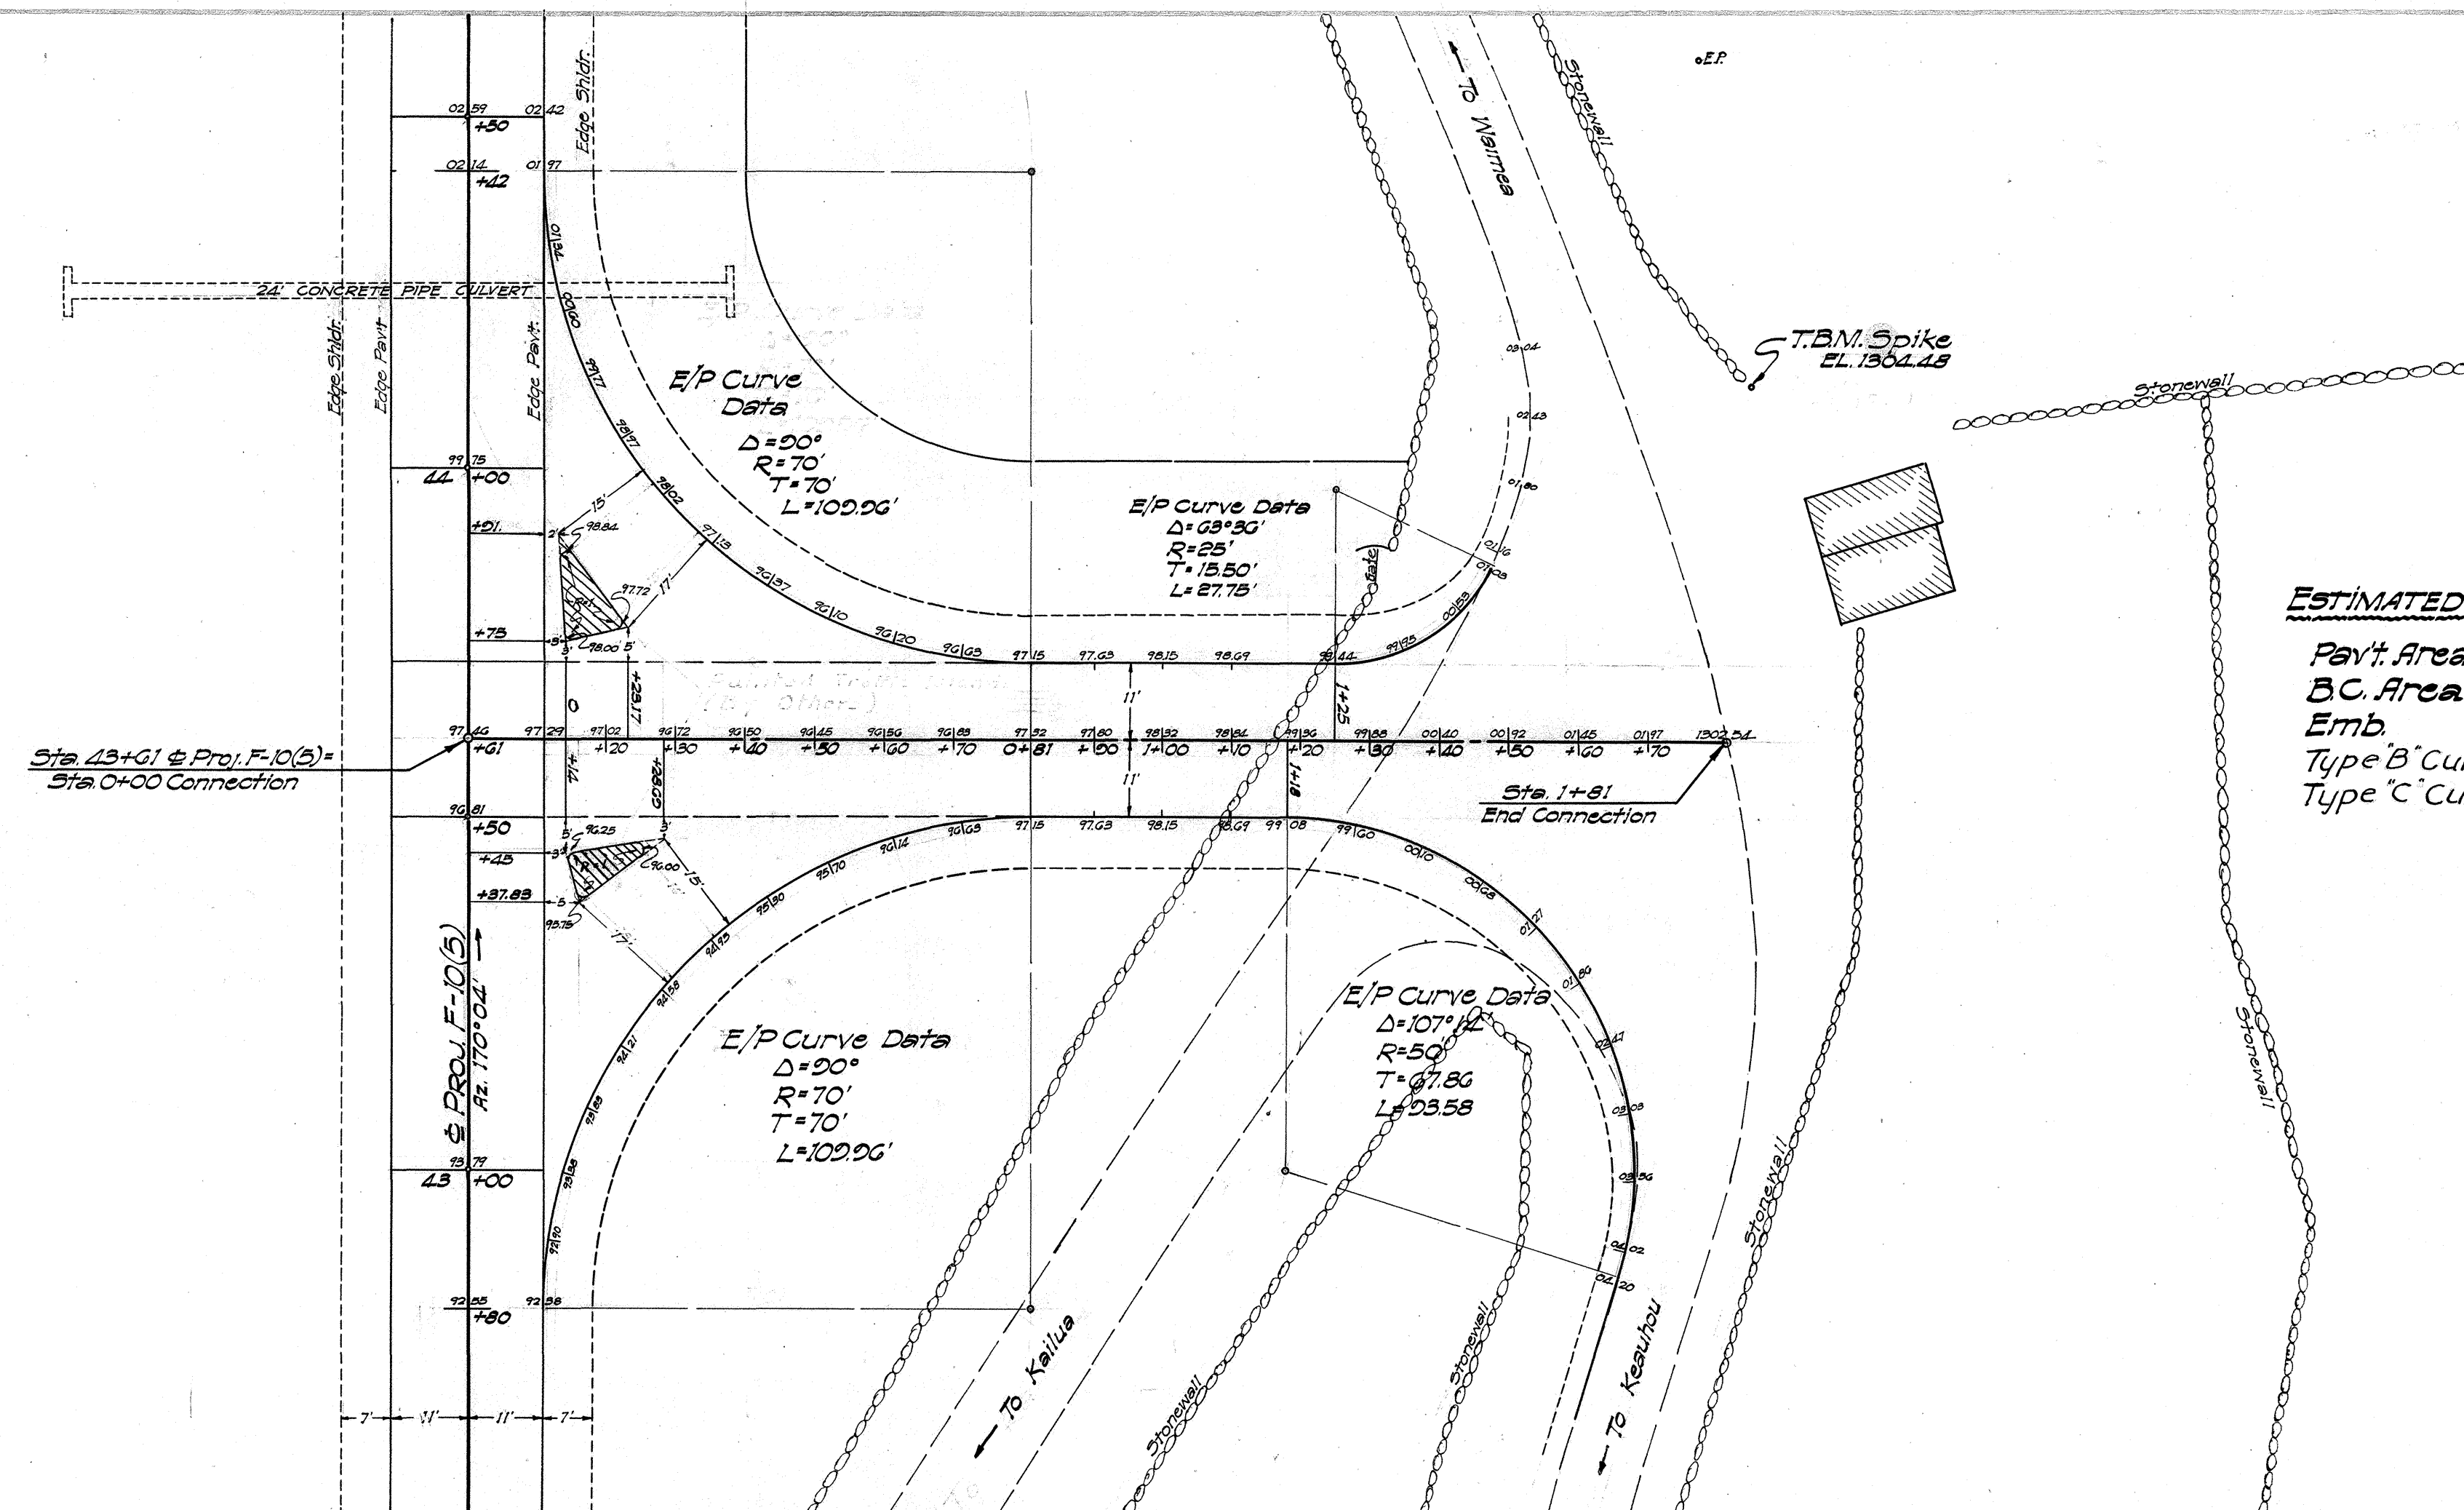

ESTIMATED QUANTITIES
 Pavt. Area ~ 930 sq.
 B.C. Area ~ 265 sq.
 Emb. ~ 2000 cu.
 Type B Curb ~ 57 lin ft.
 Type C Curb ~ 15 lin ft.

PROFILE	SCAFFED	DATE
	BY	
	GRADES CHECKED	
	NOTE BOOK	
	B. ME. NOTED	
	STRUCTURE NOTATION CH-KD	
	NO.	

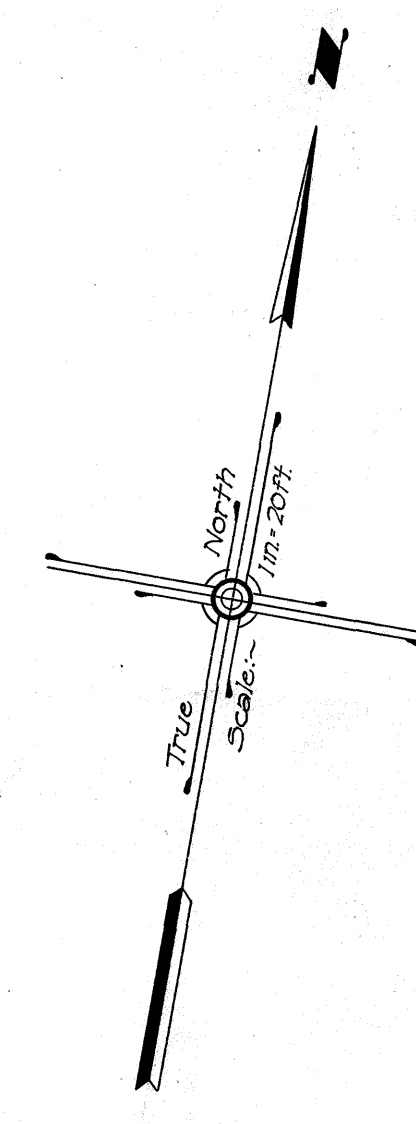