

| INDEX TO DRAWINGS |                      |
|-------------------|----------------------|
| SHEET             | DESCRIPTION          |
| 1                 | TITLE SHEET          |
| 2                 | TYPICAL SECTION      |
| 3-15              | PLAN & PROFILE       |
| 16                | INTERSECTION DETAILS |
| 17-21             | STANDARD DETAILS     |
| 22-54             | CROSS SECTIONS       |
|                   |                      |
|                   |                      |
|                   |                      |

TERRITORY OF HAWAII

TERRITORIAL HIGHWAY DEPARTMENT

HONOLULU T.H.

PLANS OF

HAWAII BELT ROAD

PALANI JUNCTION - HUEHUE SECTION

FEDERAL AID PROJECT NO. F 10 (5)



DISTRICT OF NORTH KONA

ISLAND OF HAWAII

CONVENTIONAL SIGNS USED

|                     |      |
|---------------------|------|
| Centerline          | 150  |
| Boundary Lines      | or   |
| Fences (Noted)      | or   |
| Existing Roadway    |      |
| Box Culvert         |      |
| Circular Culvert    |      |
| Bridges             |      |
| Tree (Large)        | or   |
| Telephone Pole      | o TP |
| Centerline Monument | o    |

| SCALES        |                       |
|---------------|-----------------------|
| PLAN          | 1 INCH = 100 FT.      |
| PROFILE       | HOR. 1 INCH = 100 FT. |
|               | VER. 1 INCH = 10 FT.  |
| CROSS SECTION | HOR. 1 INCH = 10 FT.  |
|               | VER. 1 INCH = 10 FT.  |

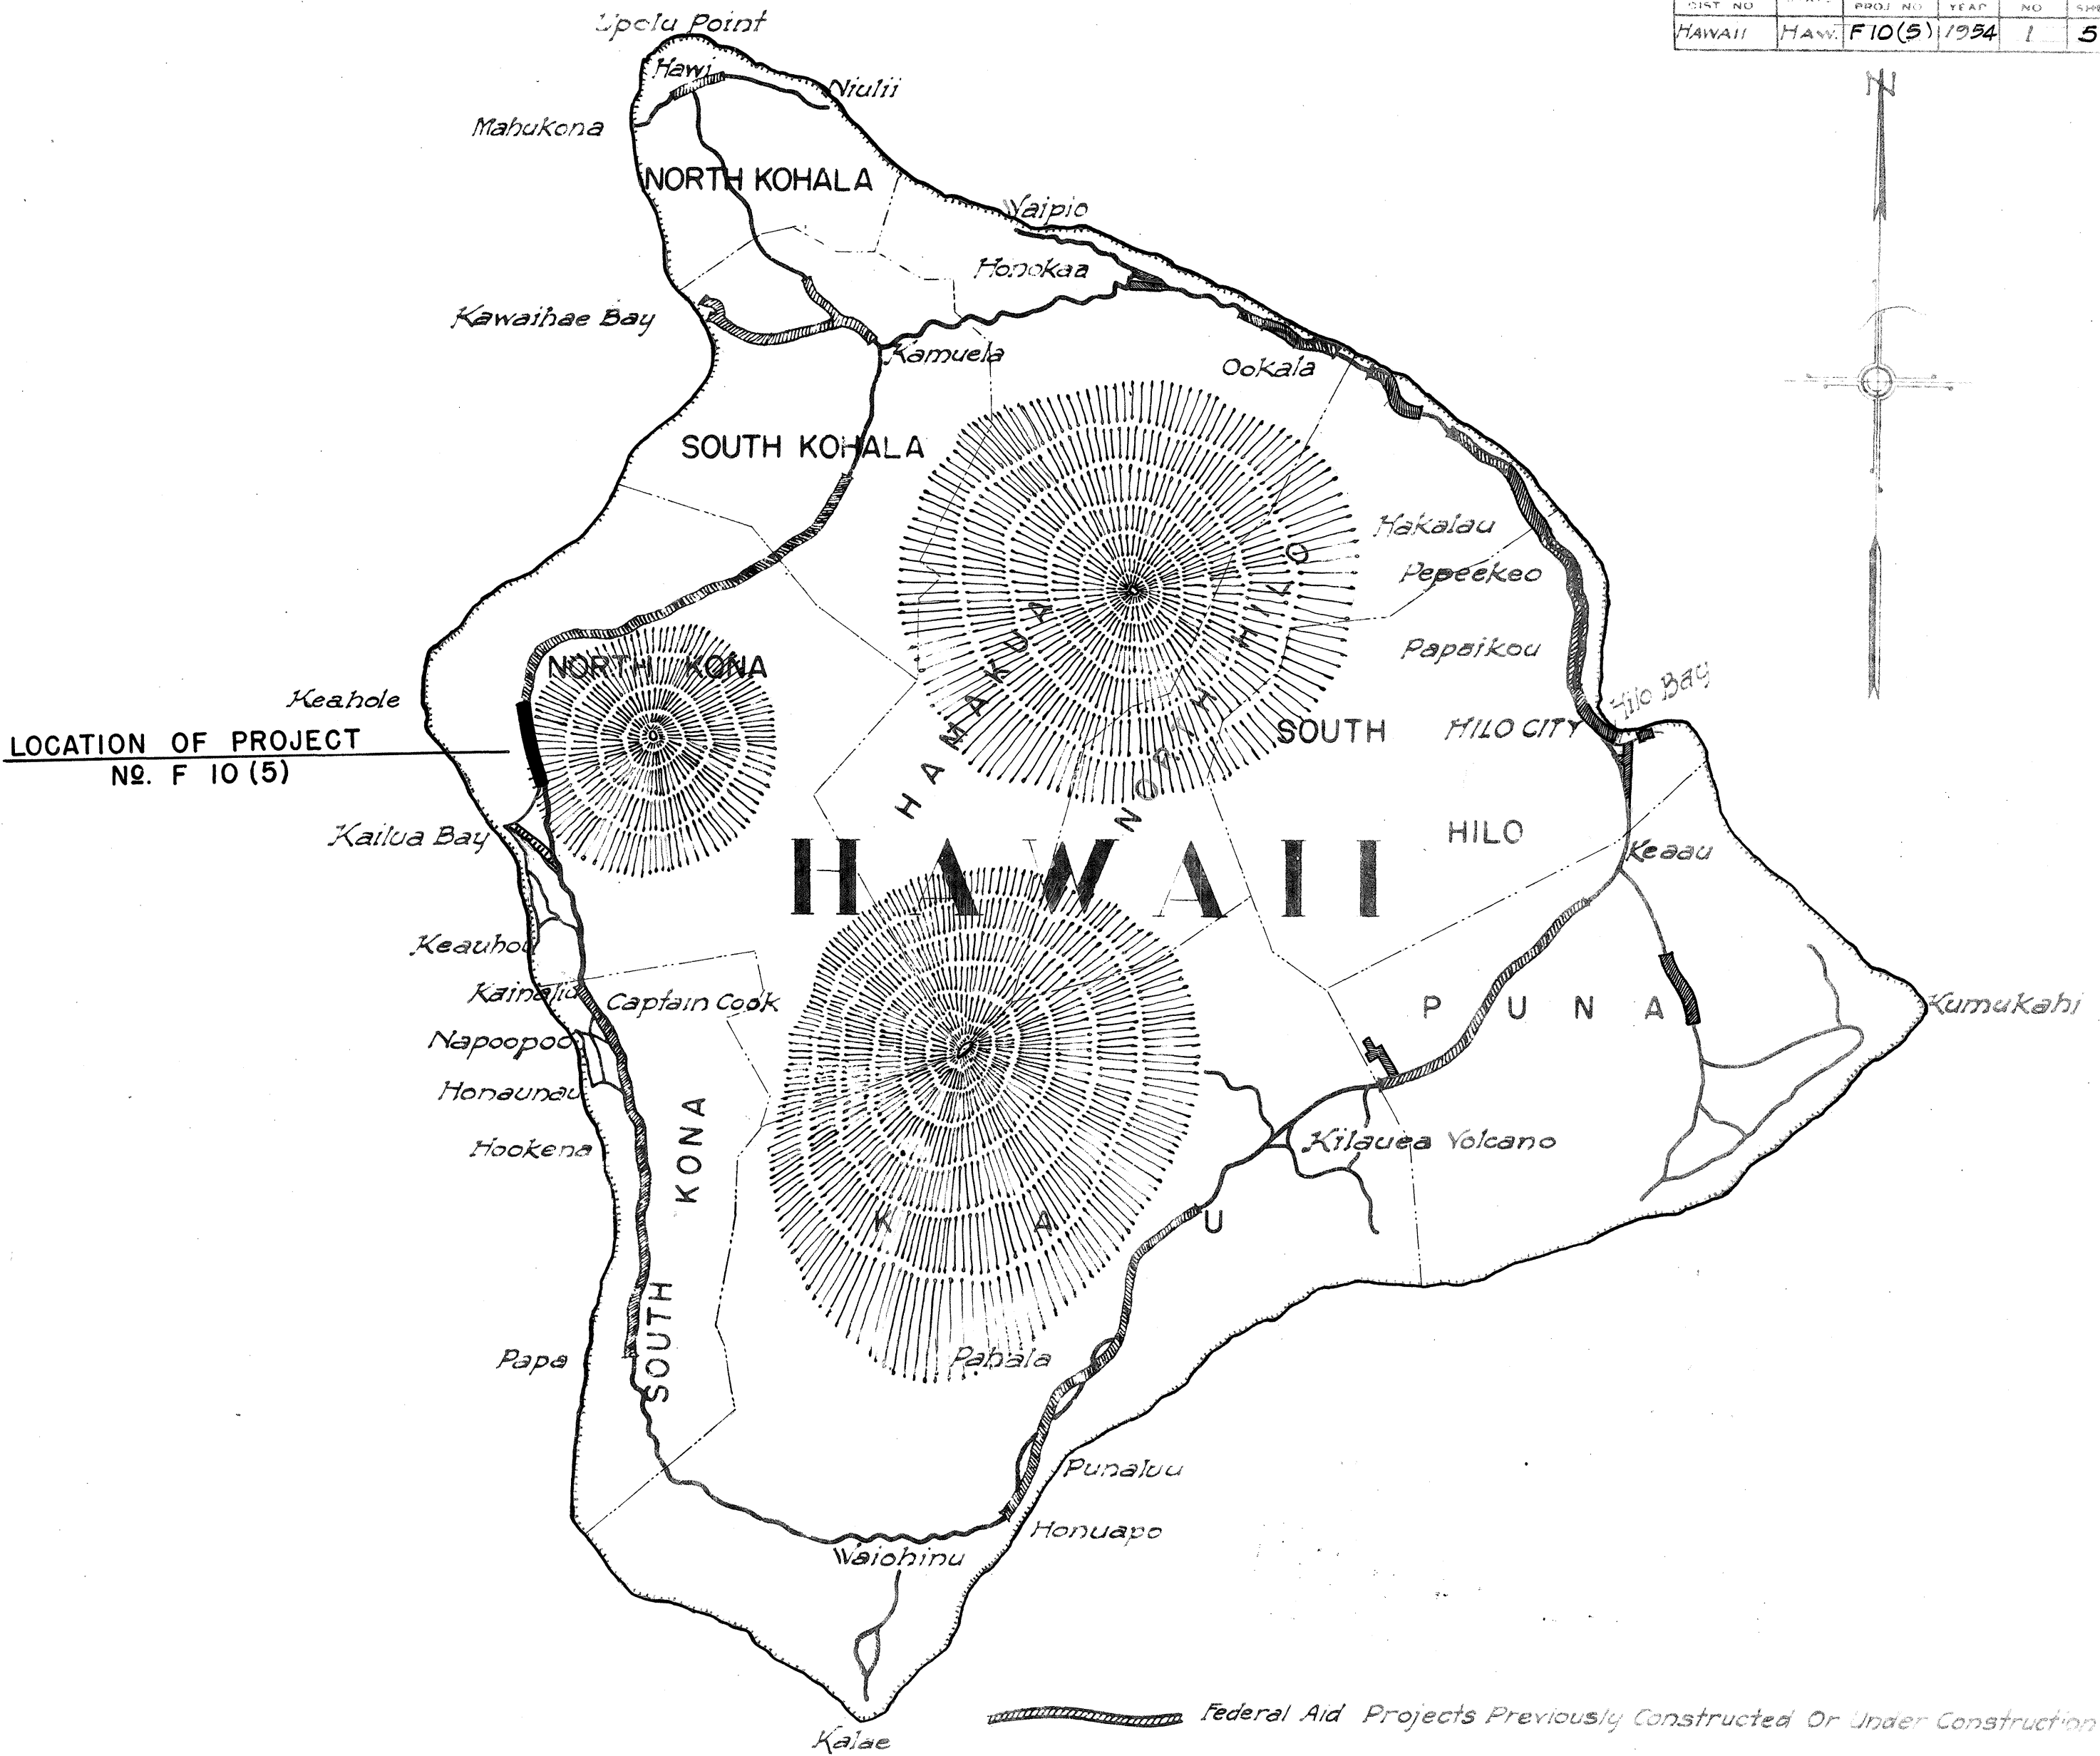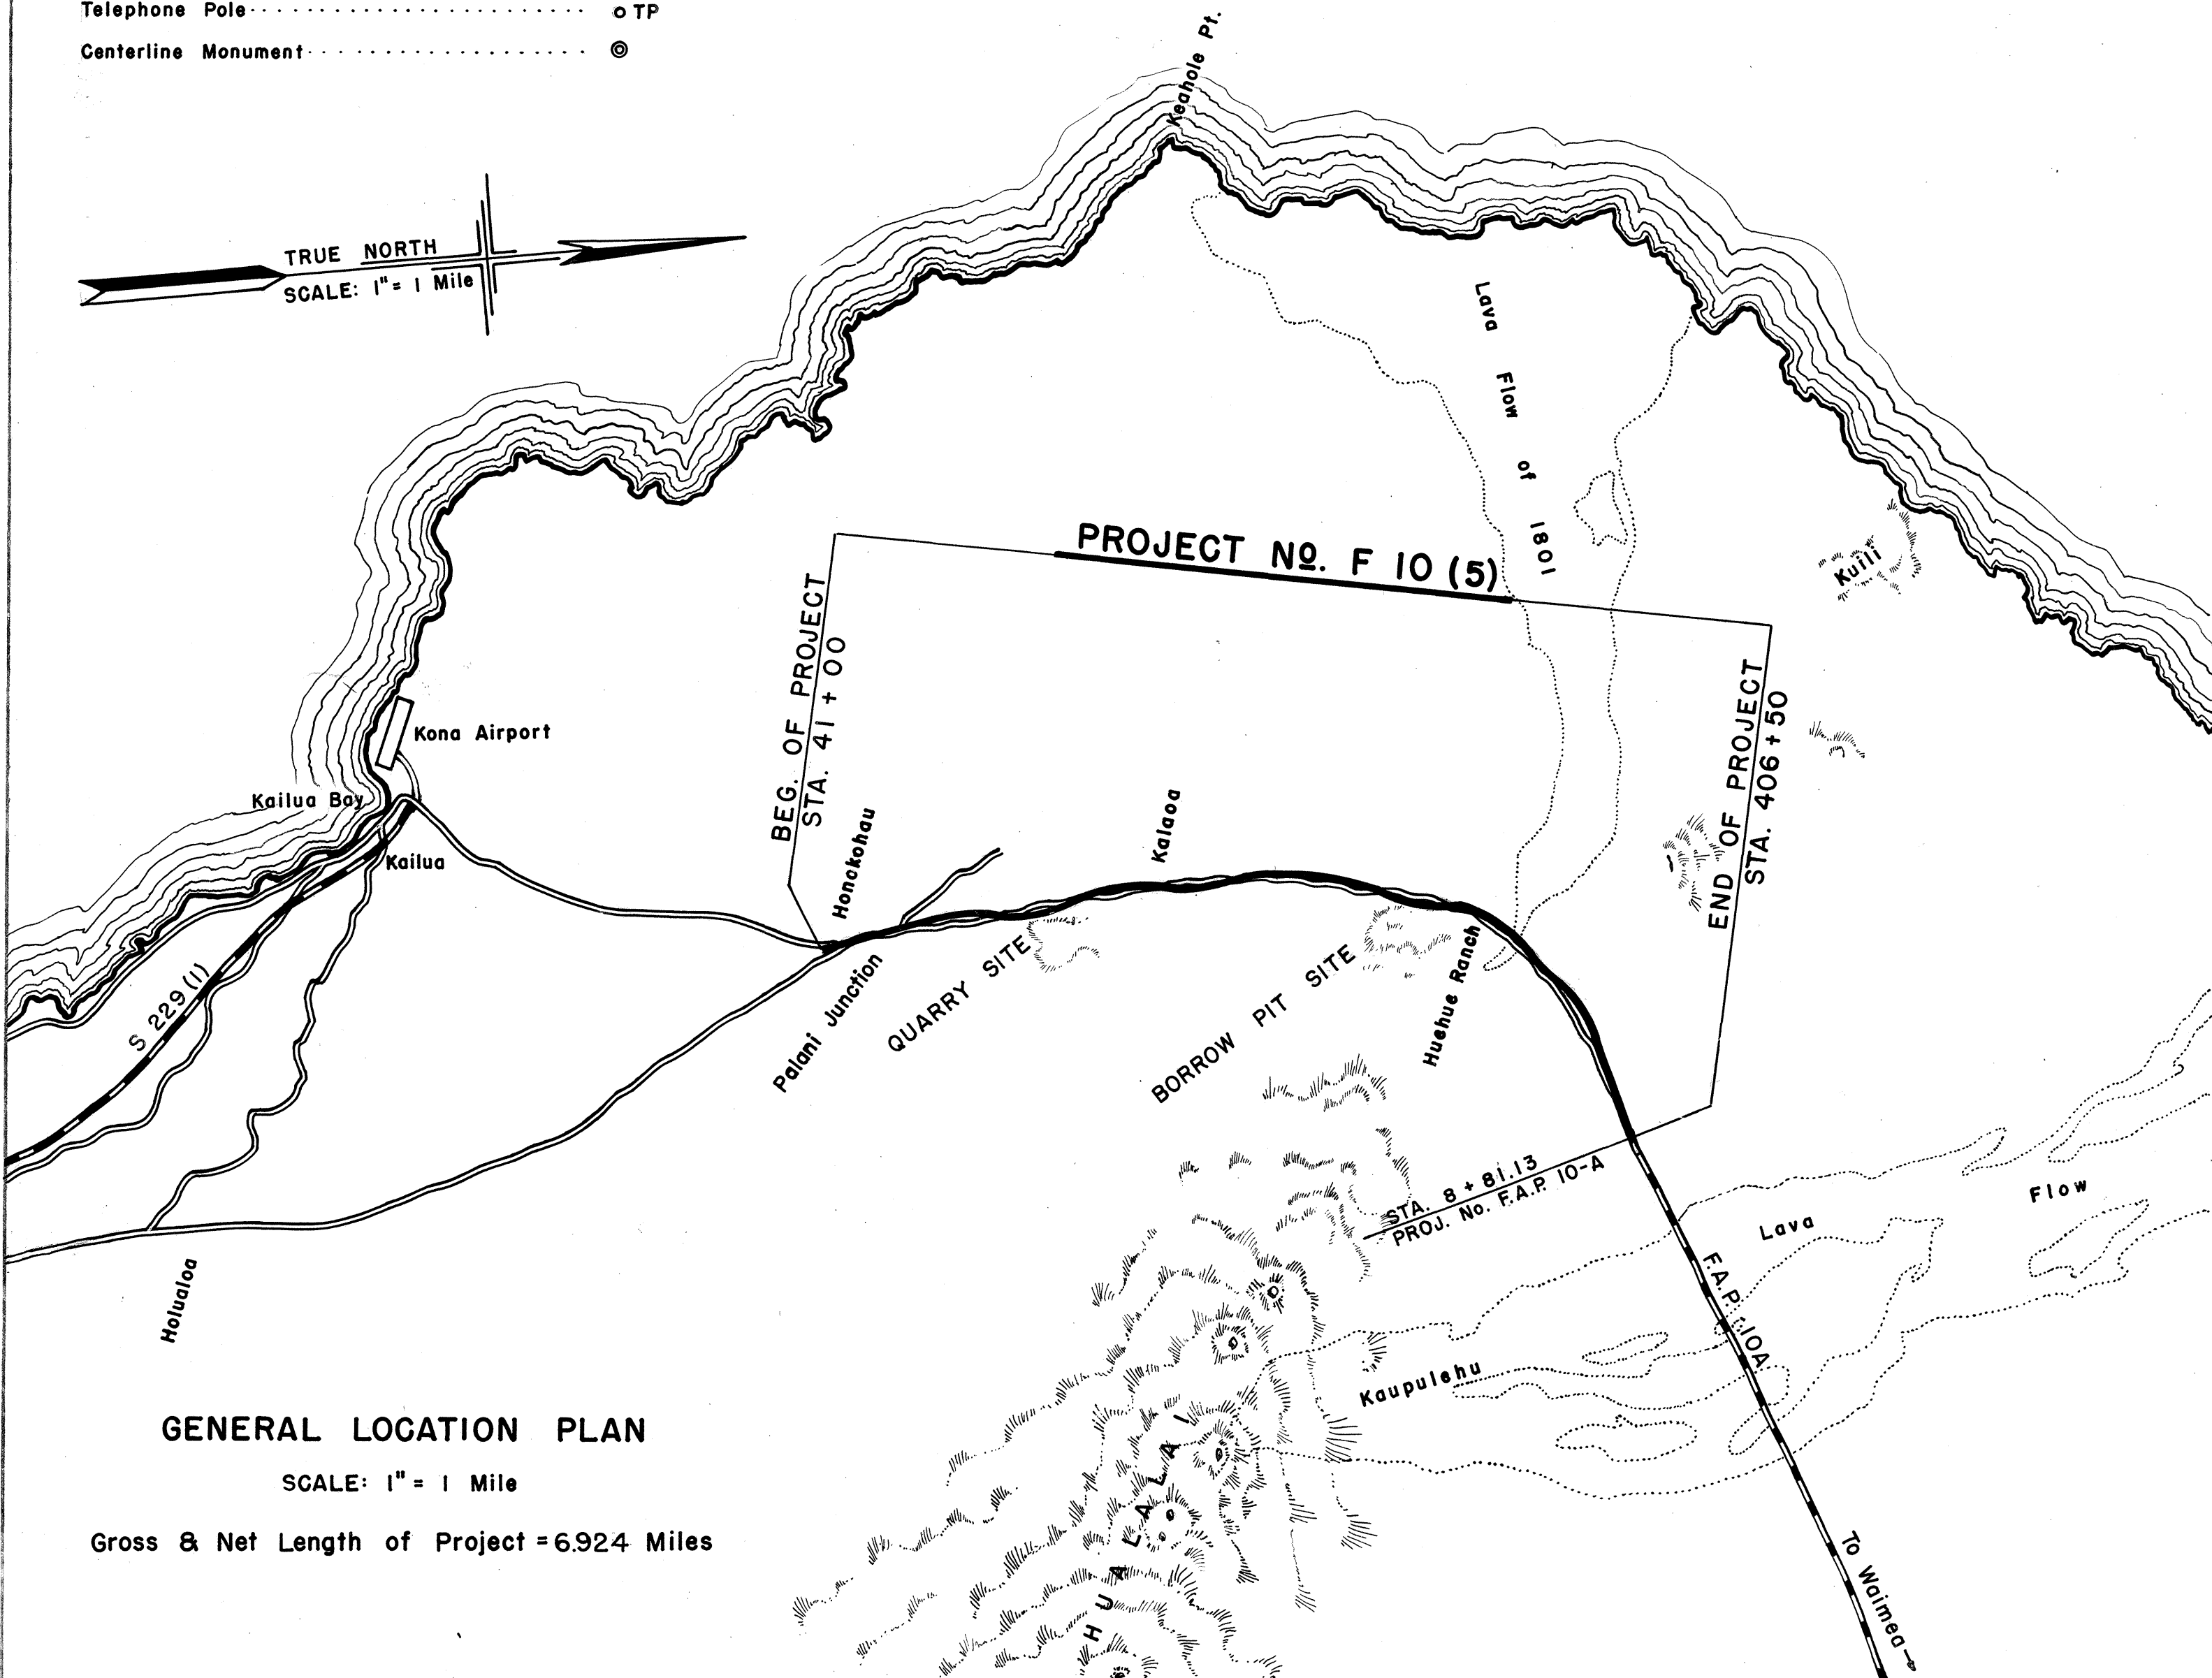

NOTE:

ALL CHANGES MADE DURING CONSTRUCTION  
HAVE BEEN NOTED IN RED ON THESE  
TRACINGS AND CHECKED BY:

Moses Serrao  
PROJECT ENGINEER

August 31, 1956  
DATE

APPROVED: DATE 6/22/54

R. E. Rutter  
TERRITORIAL HIGHWAY ENGINEER

DEPARTMENT OF COMMERCE  
BUREAU OF PUBLIC ROADS

APPROVED:

DISTRICT ENGINEER DATE