

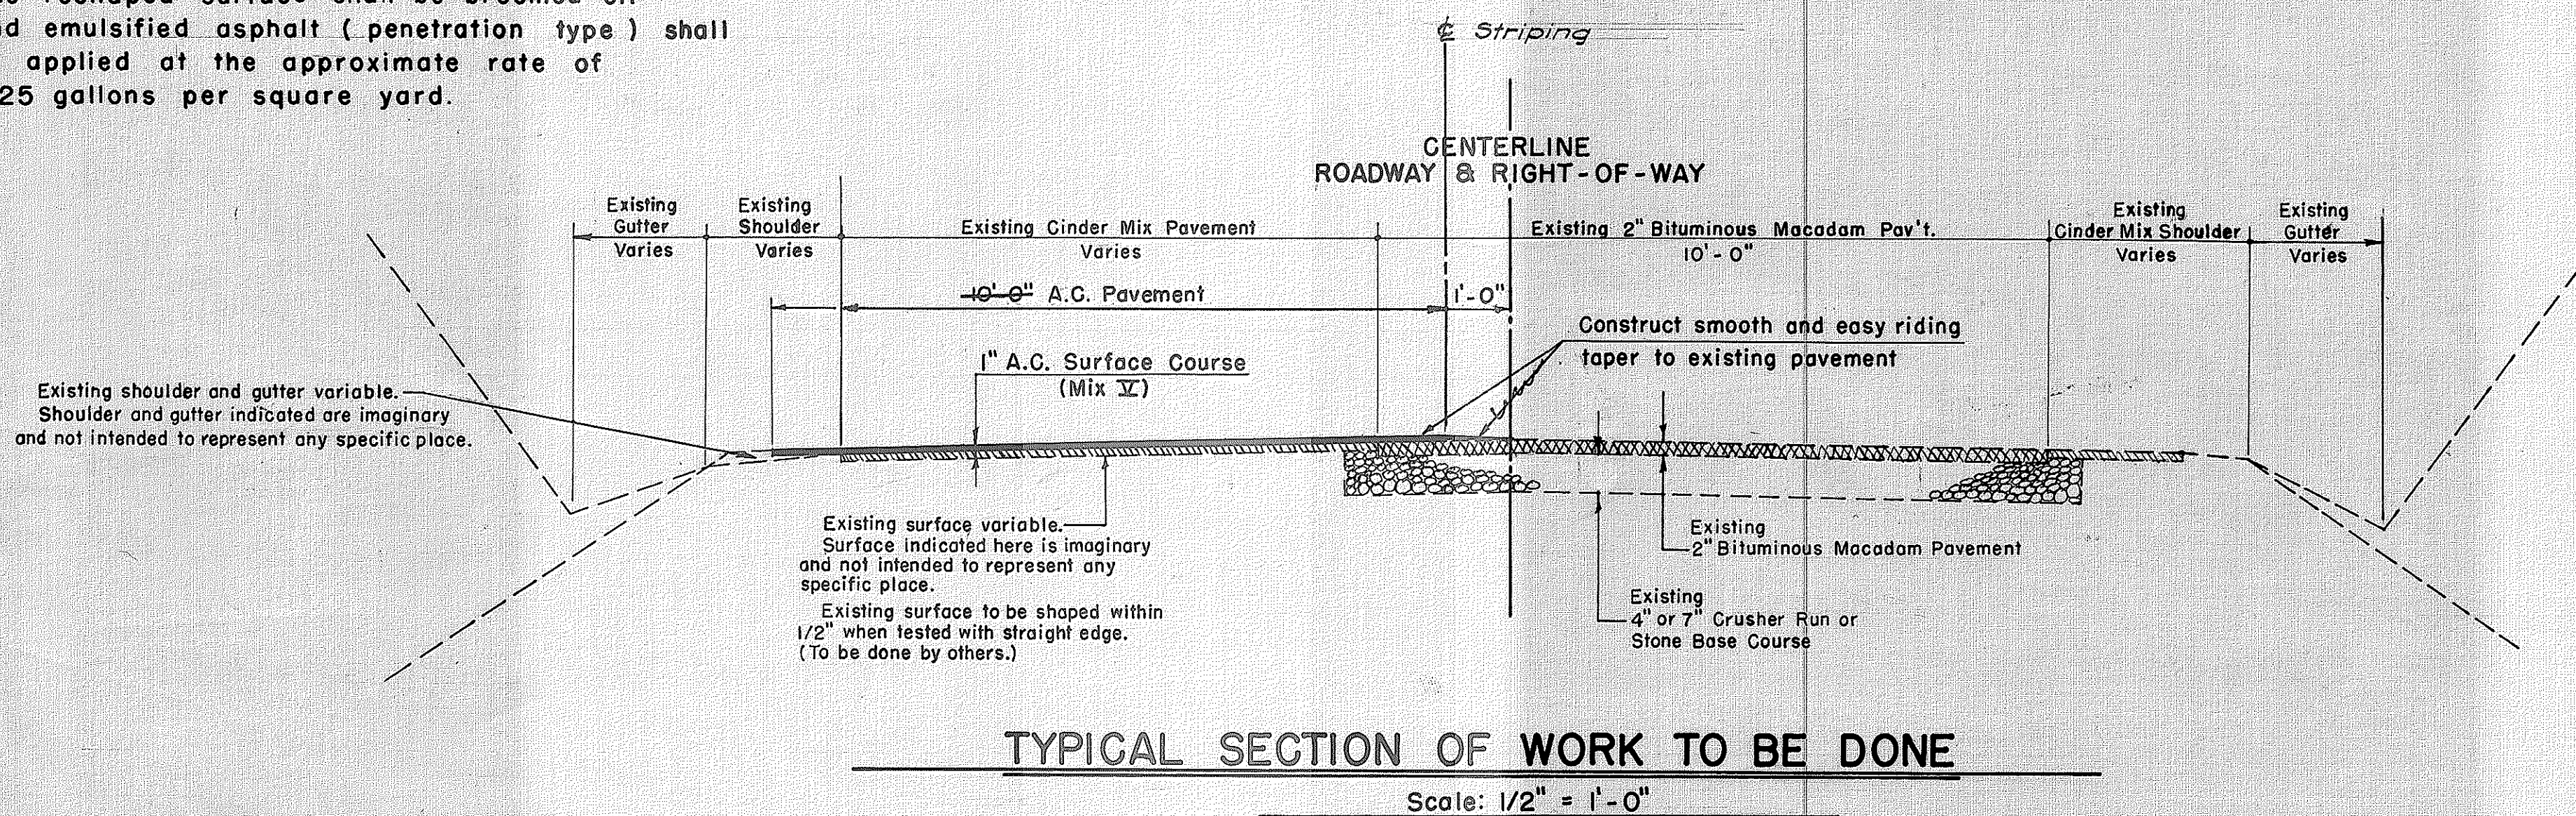


INDEX TO DRAWINGS	
SHEET	DESCRIPTION
1	TITLE SHEET

- NOTE:
- Existing cinder mix pavement and shoulders shall be reshaped and graded by others prior to awarding of the contract.
 - The reshaped surface shall be broomed off and emulsified asphalt (penetration type) shall be applied at the approximate rate of 0.25 gallons per square yard.

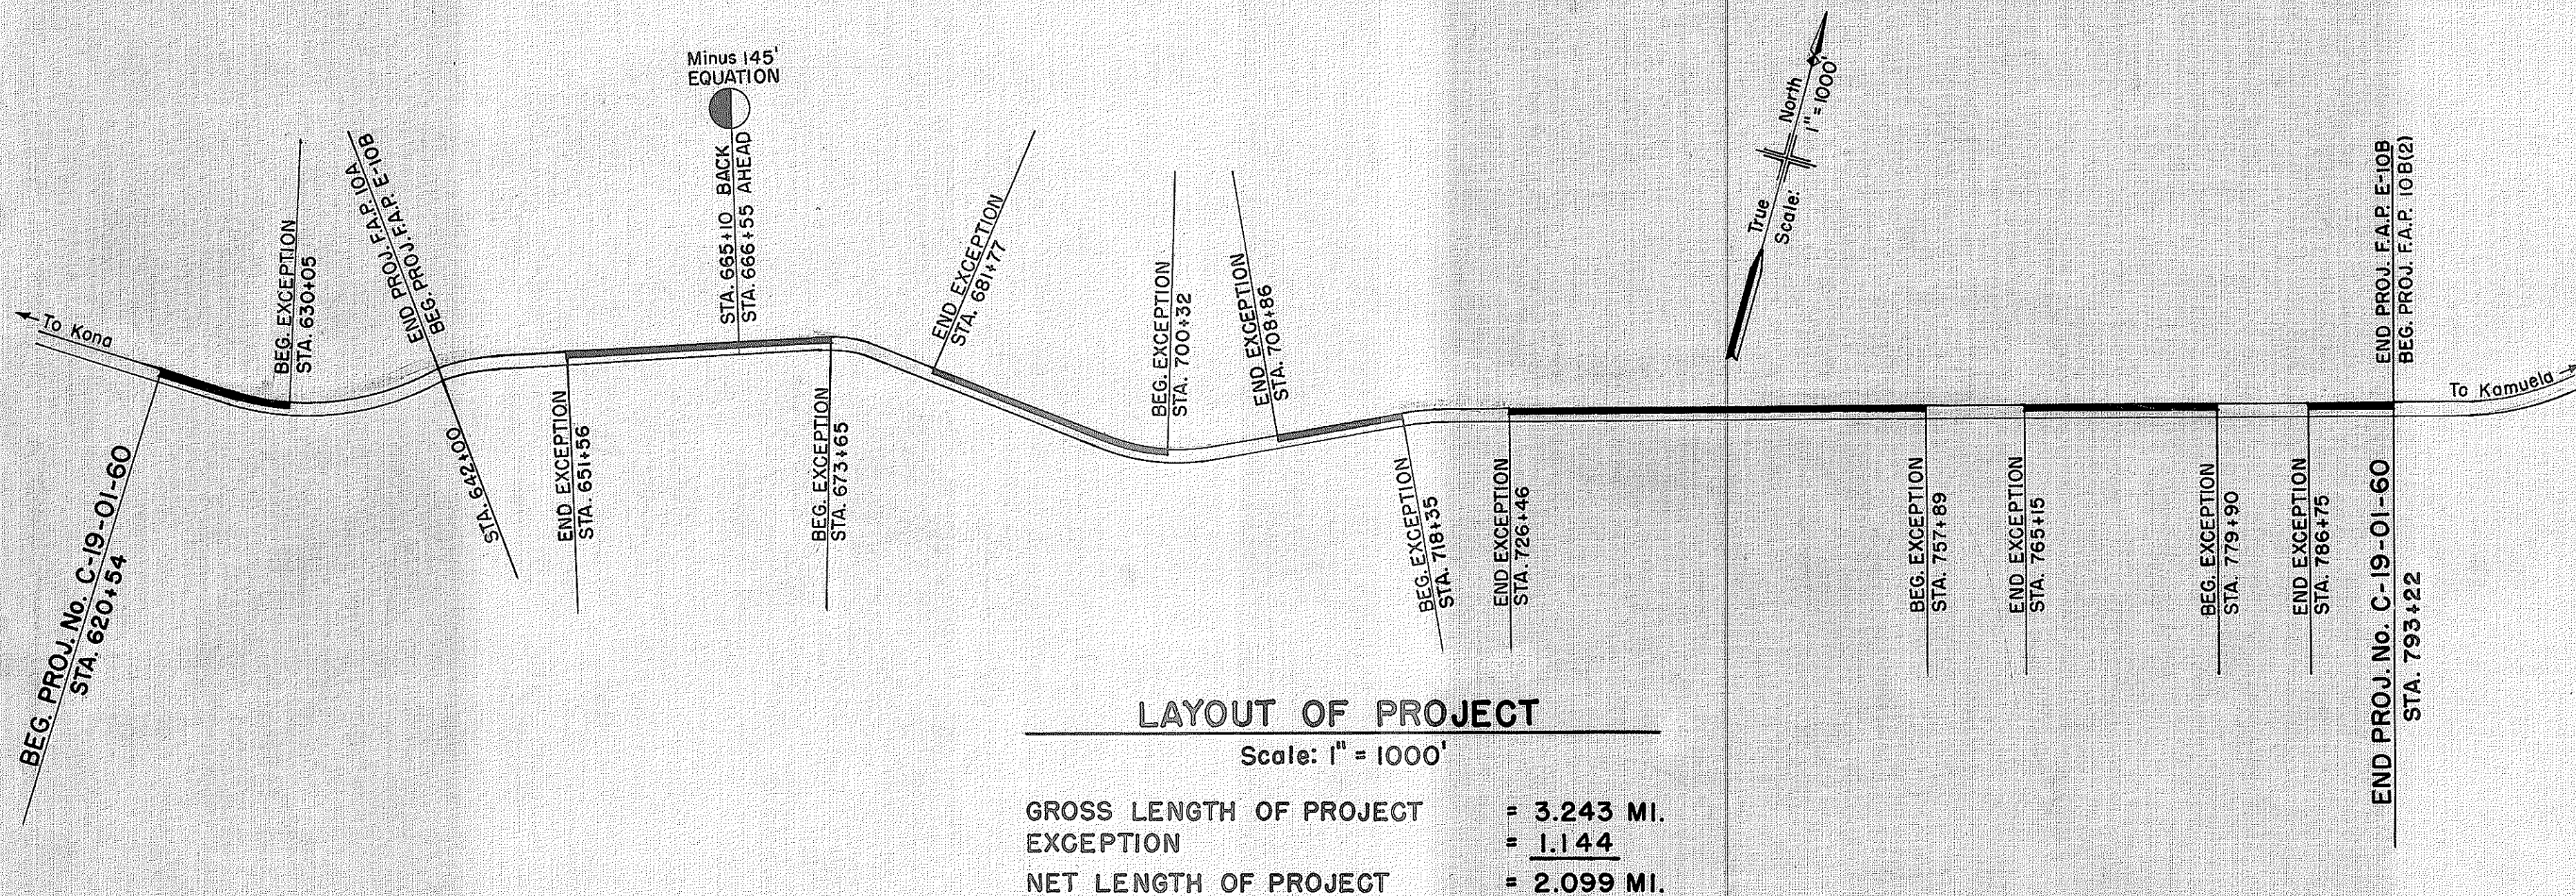


GENERAL LOCATION
PROJ. C-19-01-60

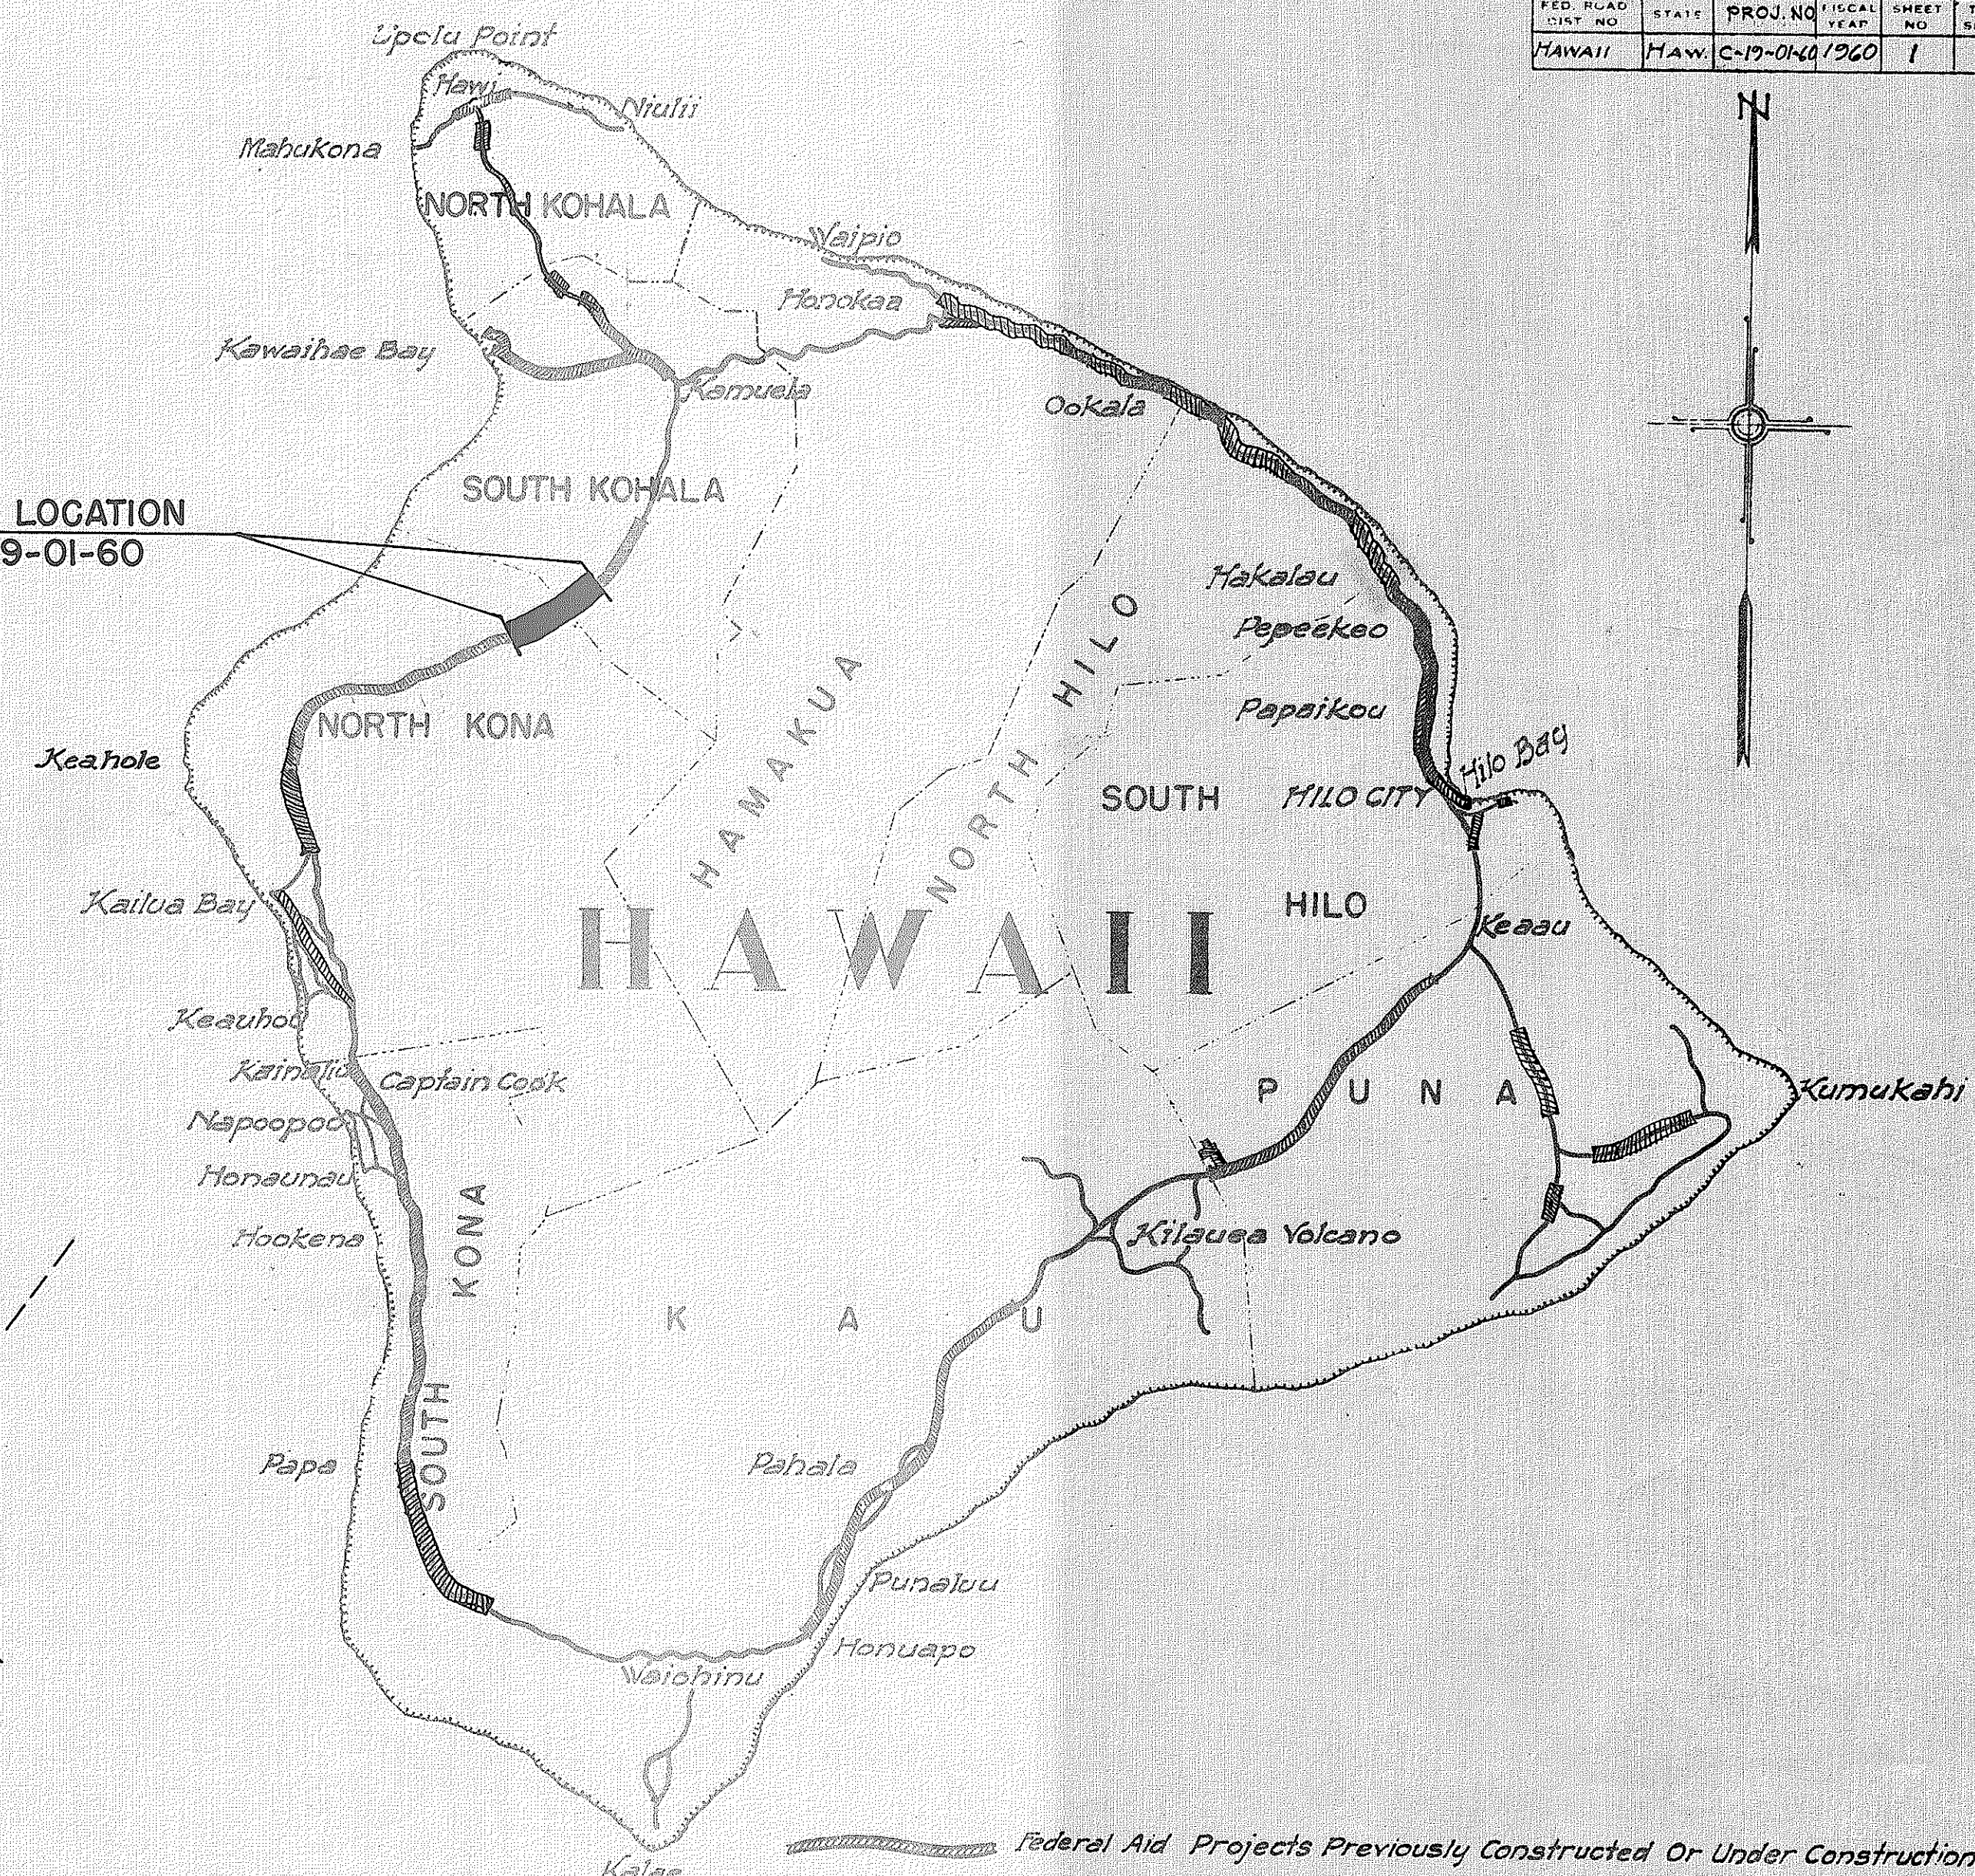

NOTE:
ALL CHANGES MADE DURING CONSTRUCTION HAVE BEEN NOTED IN RED ON THESE TRACINGS AND CHECKED BY:

DISTRICT ENGINEER

DATE

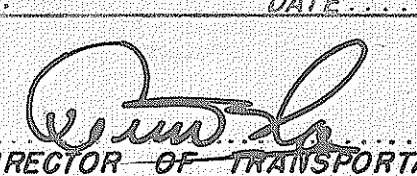APPROVED:  DATE: _____
DIRECTOR OF TRANSPORTATION