
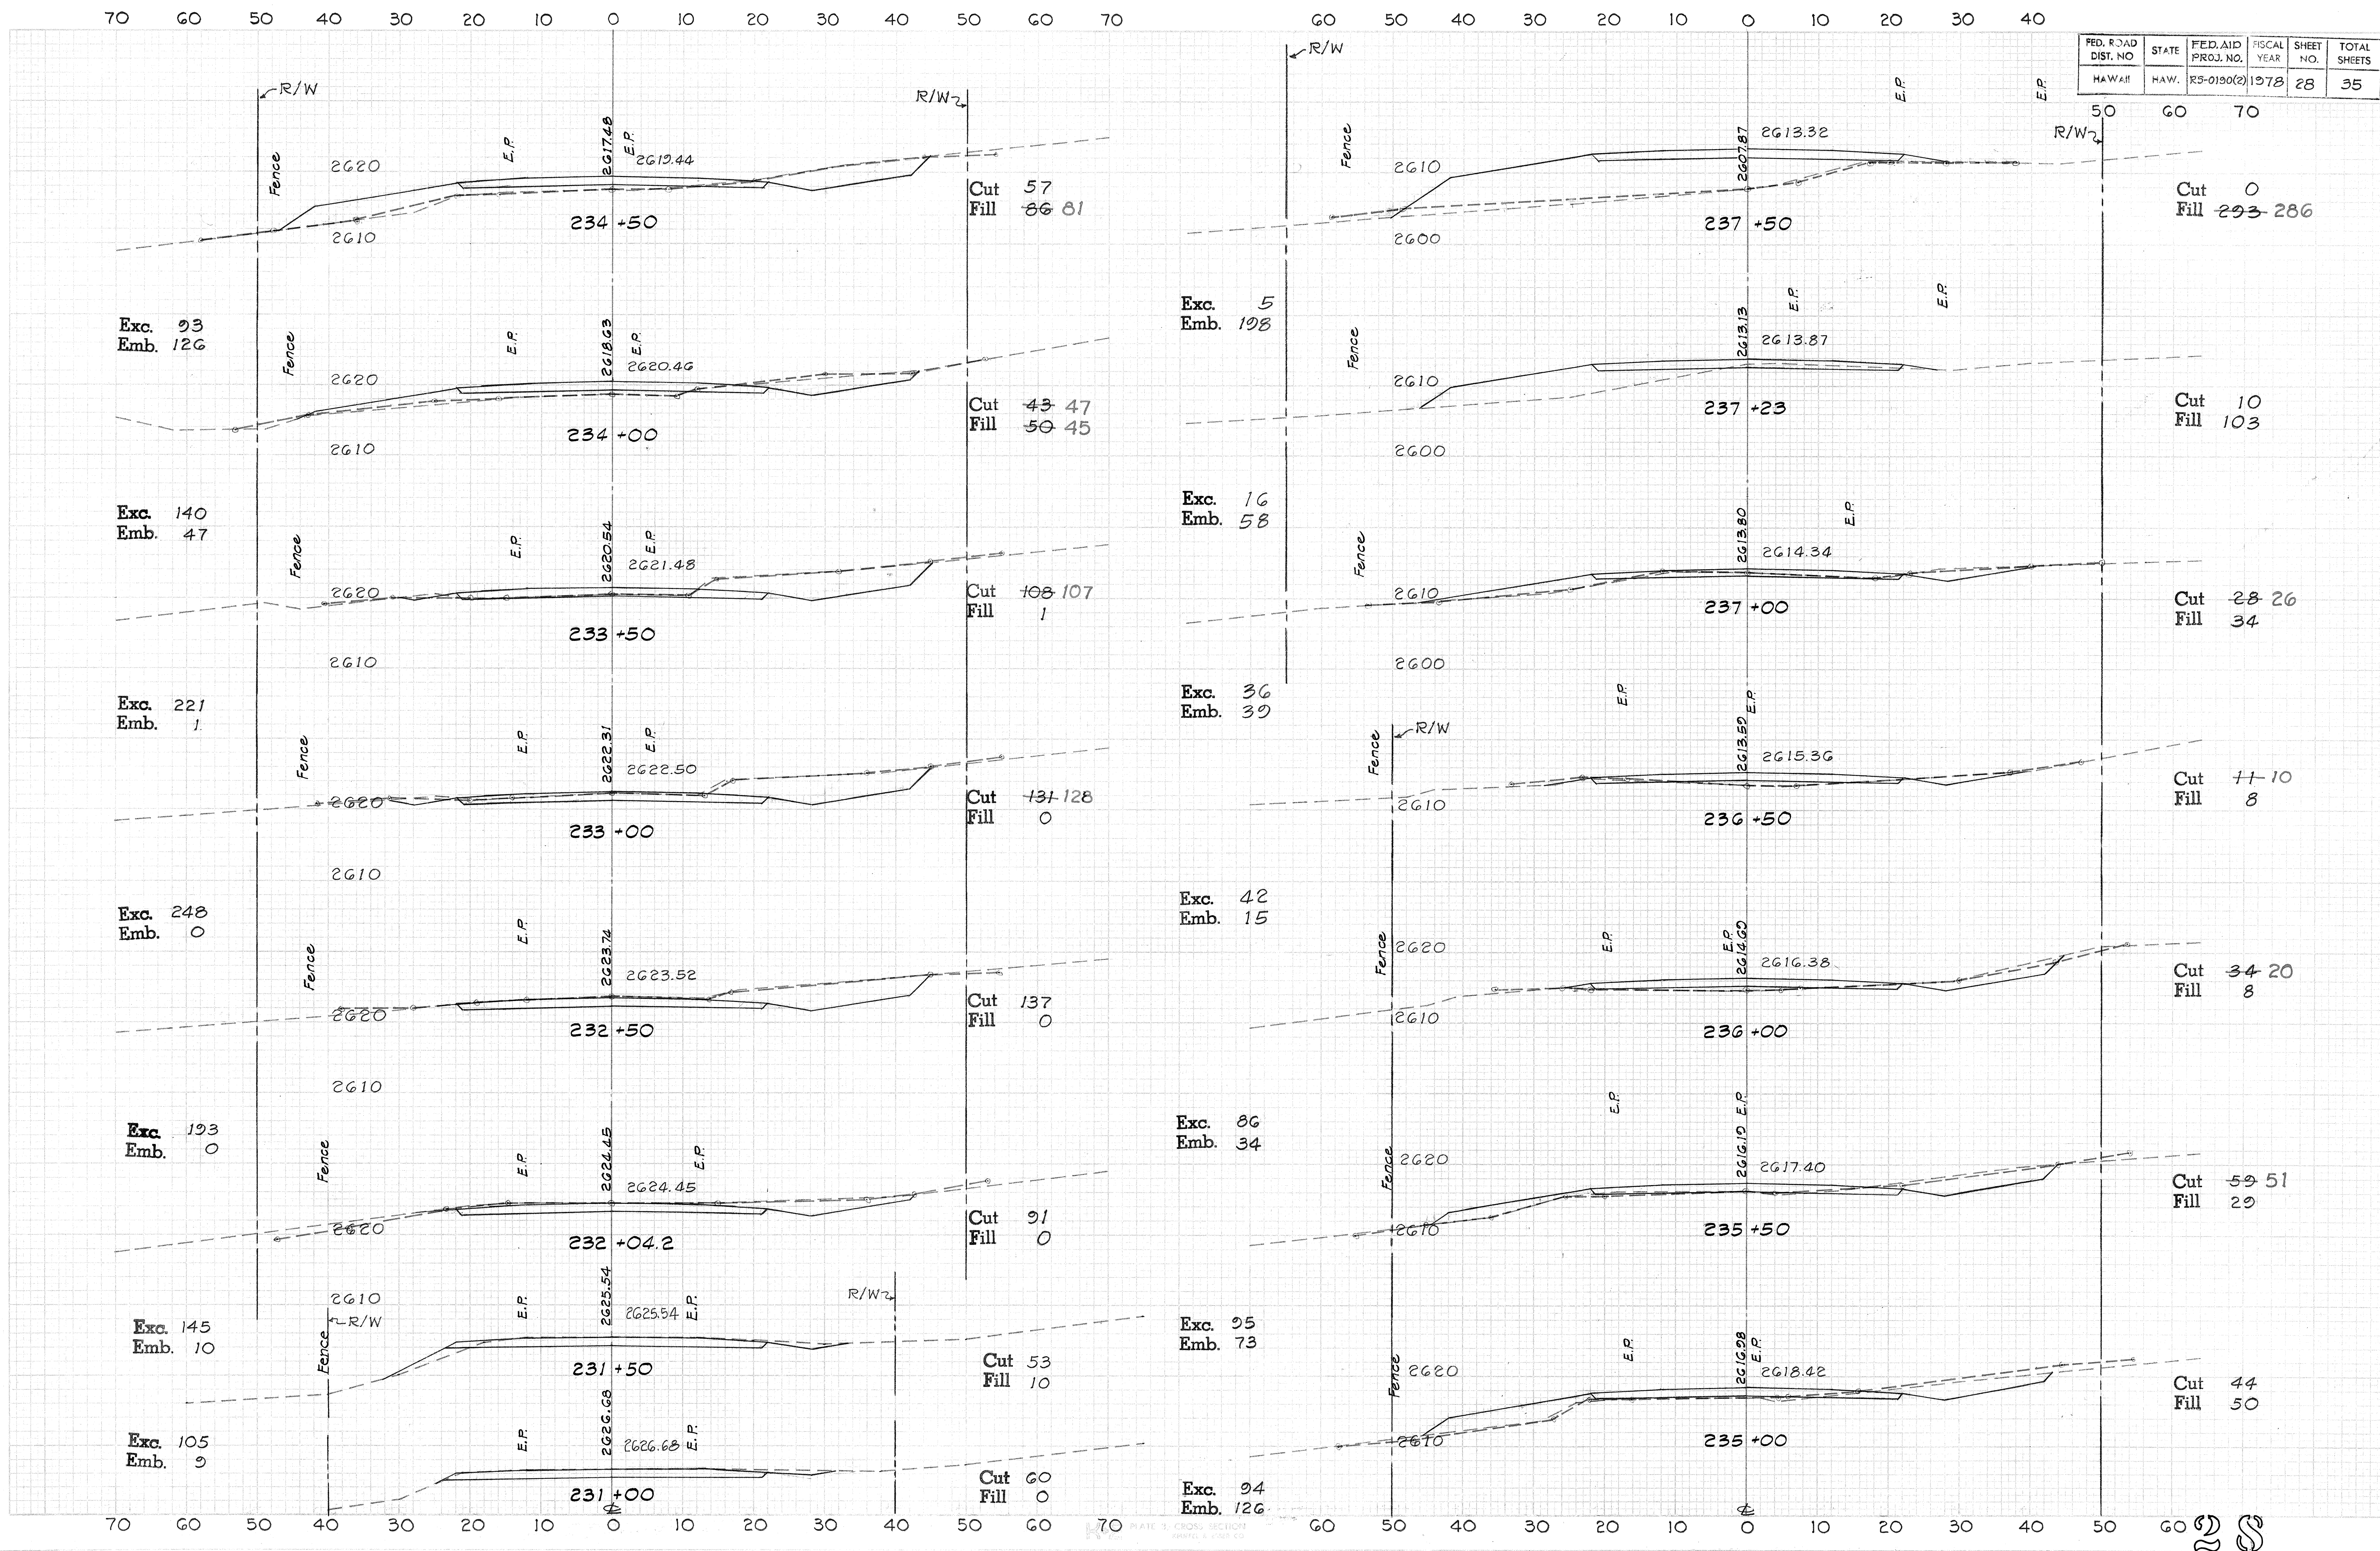



FED. ROAD DIST. NO	STATE	FED. AID PROJ. NO.	FISCAL YEAR	SHEET NO.	TOTAL SHEETS
HAWAII	HAW.	R5-0190(2)	1978	28	35

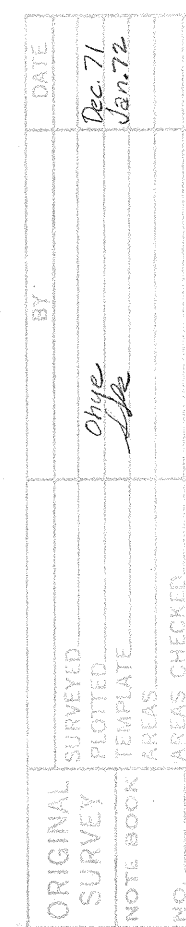

FINAL SURVEY	DATE	
	BY	
	SURVEYED	
	PLOTTED	
	NOTE BOOK	TEMP. PLATE
	NO.	AREAS CHECKED

ORIGINAL SURVEY	DATE	Dec 71
	BY	dyke
	SURVEYED	
	PLOTTED	
	NOTE BOOK	TEMP. PLATE
	NO.	AREAS CHECKED


FED. ROAD DIST. NO.	STATE	FED. AID PROJ. NO.	FISCAL YEAR	SHEET NO.	TOTAL SHEETS
HAWAII	HAW.	RS-0190(2)	1978	29	35

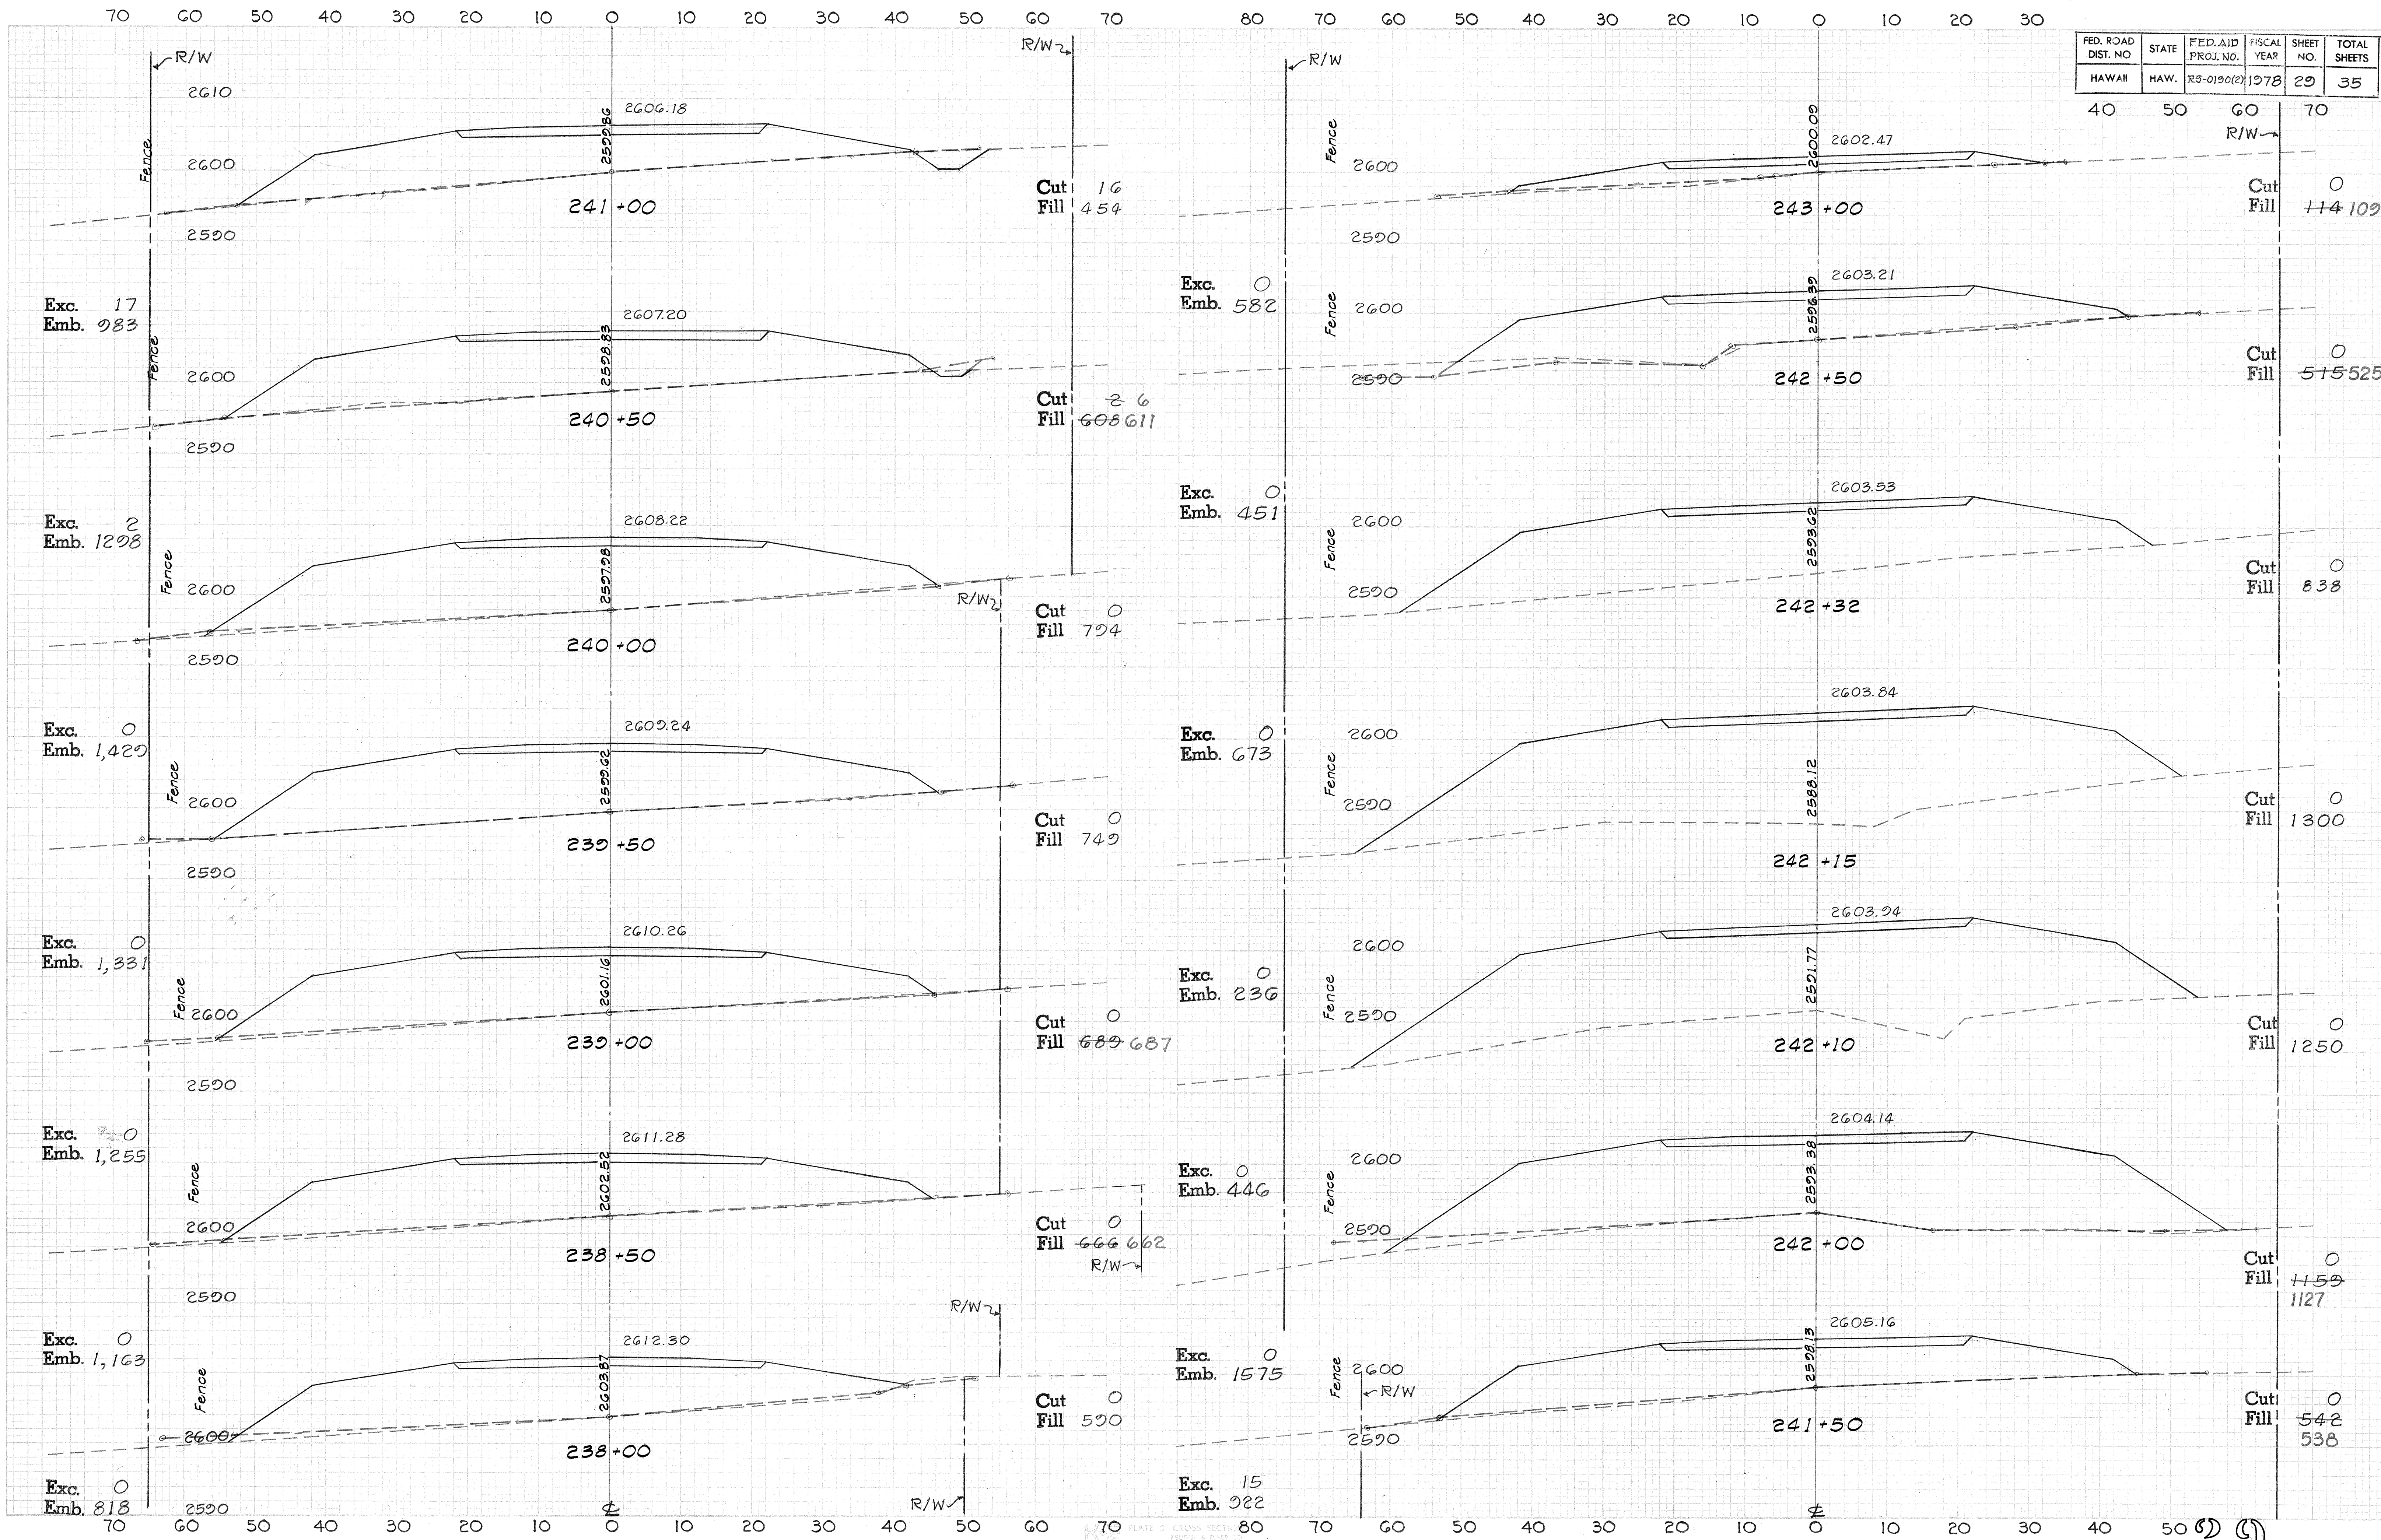

FED. ROAD DIST. NO.	STATE	FED. AID PROJ. NO.	FISCAL YEAR	SHEET NO.	TOTAL SHEETS
HAWAII	HAW.	RS-0190(2)	1978	30	35

DATE	BY
DATE	BY
DATE	BY



DATE	BY
Dec 71	
DATE	BY
Jan 72	
DATE	BY

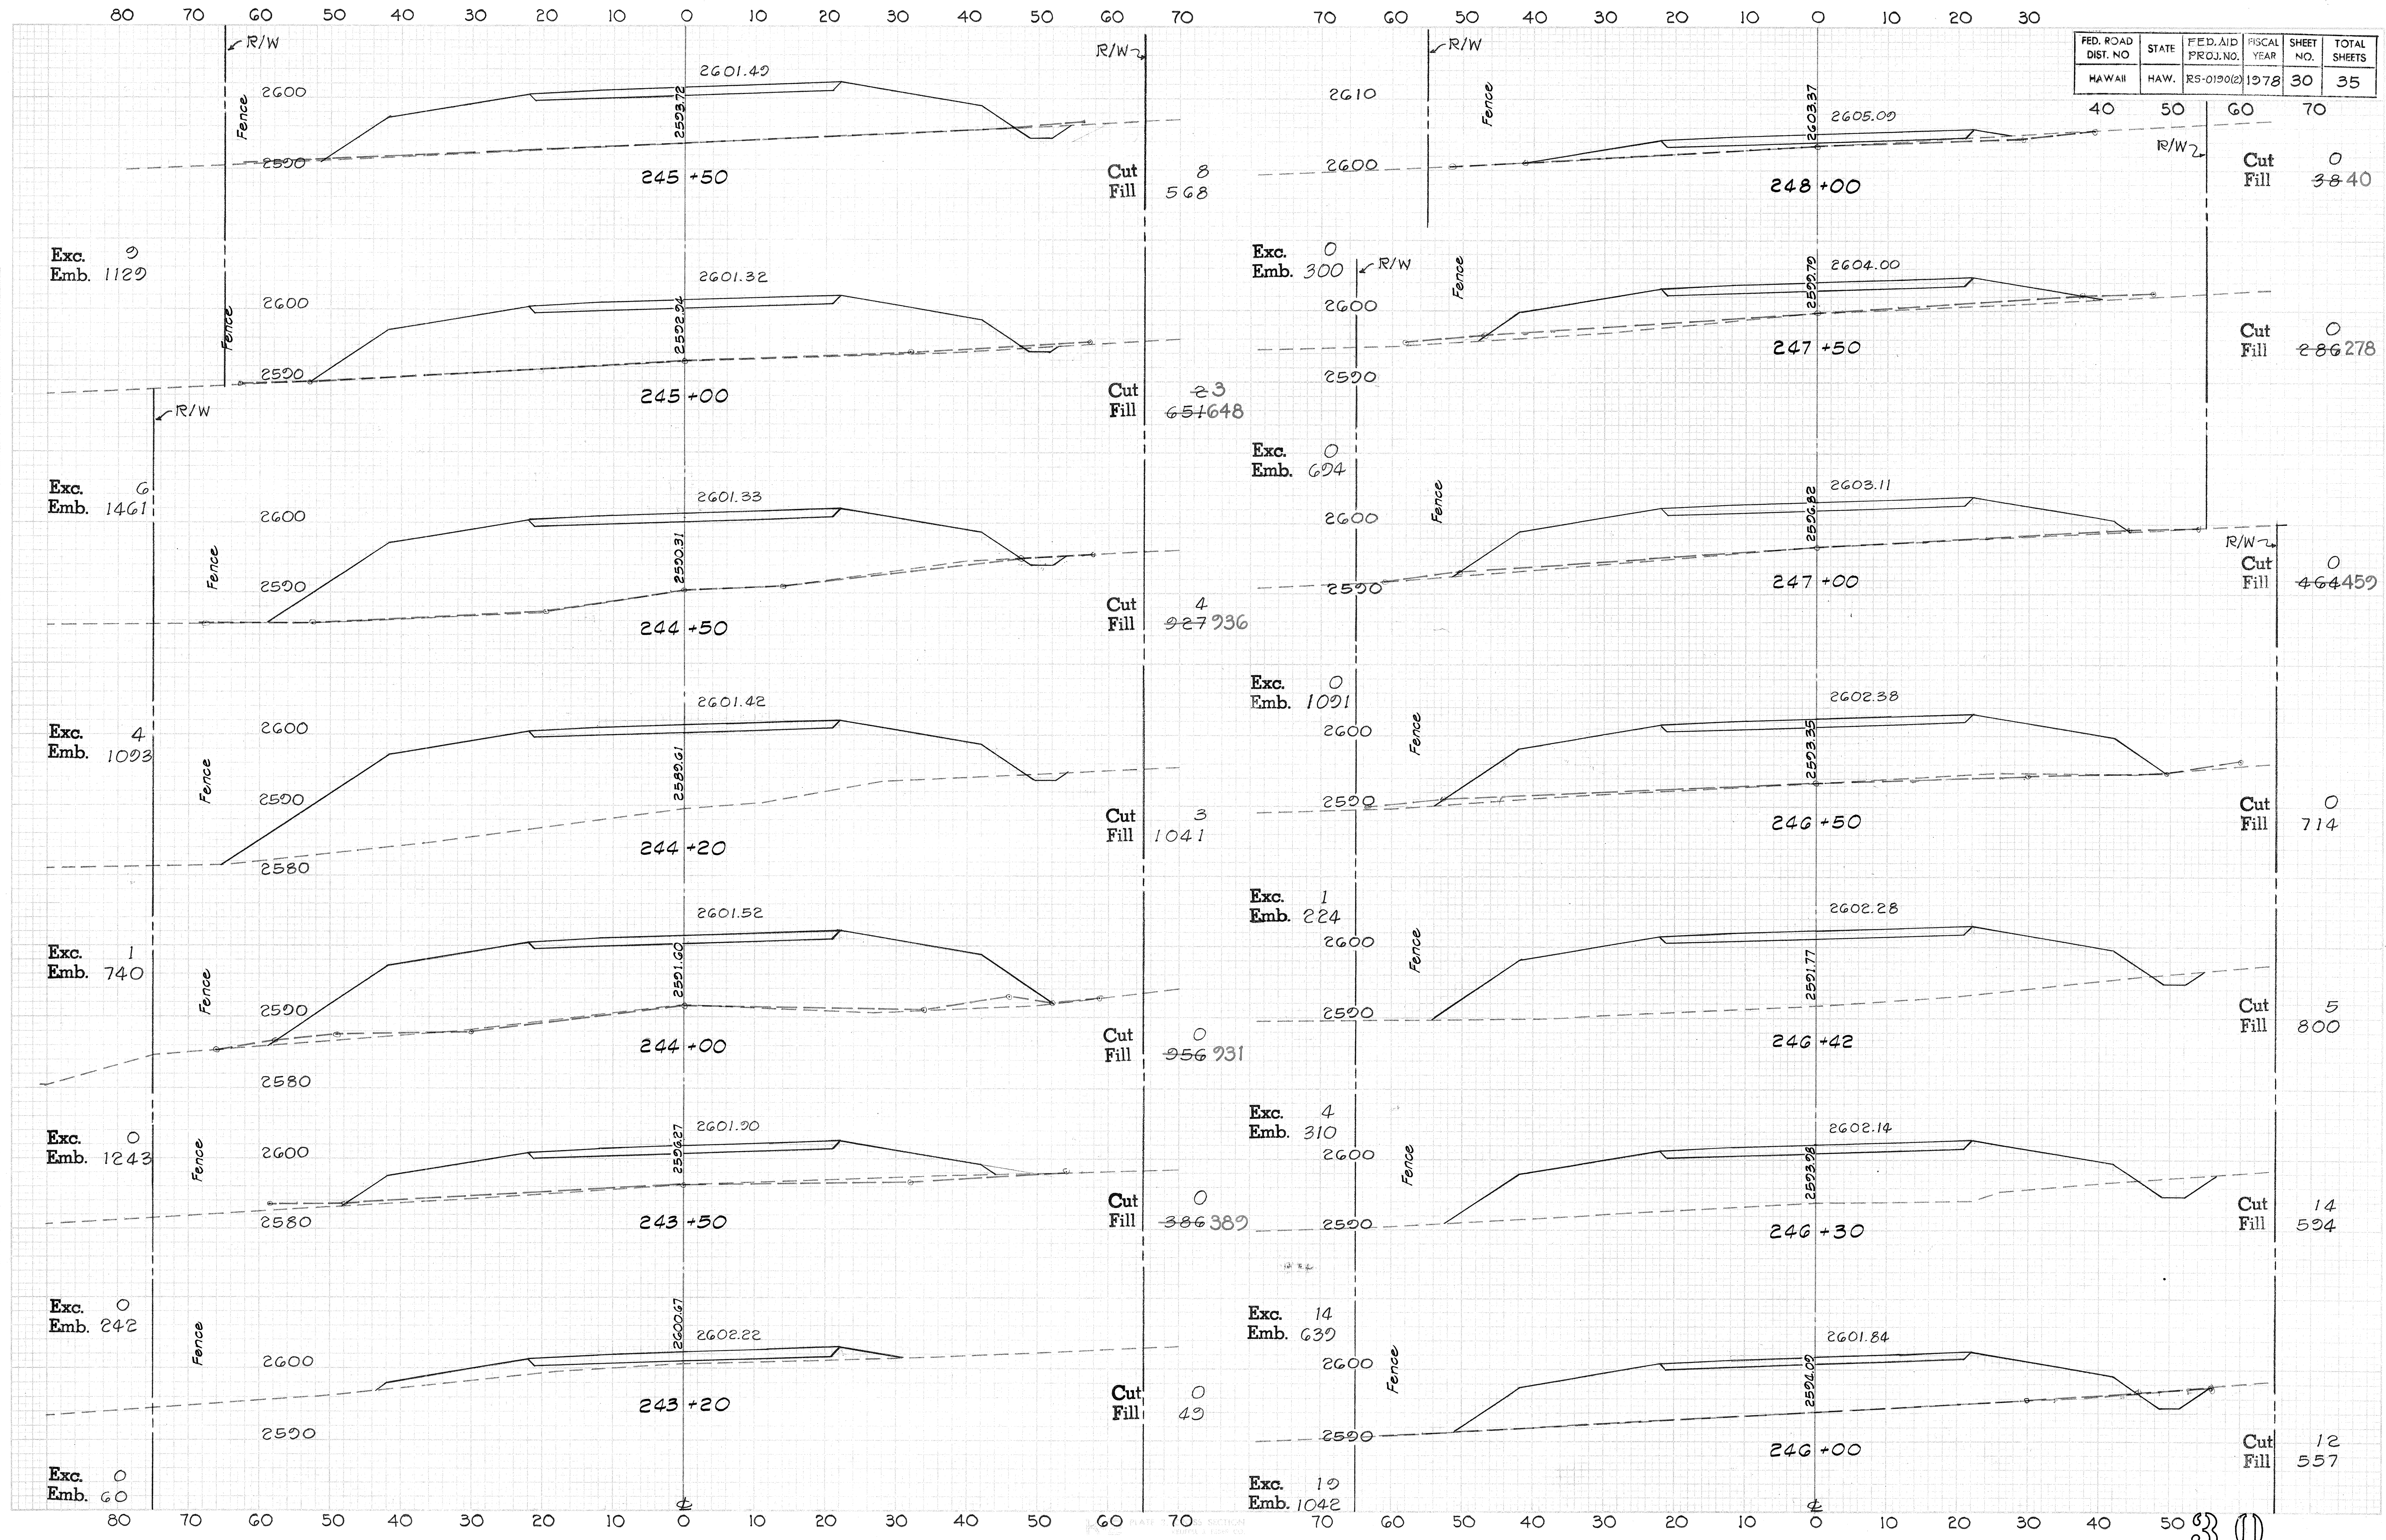

FED. ROAD DIST. NO.	STATE	FED. AID PROJ. NO.	FISCAL YEAR	SHEET NO.	TOTAL SHEETS
HAWAII	HAW.	RS-0180(2)	1978	31	35

FINAL SURVEY PLATTED
NOTE BOOK
NO.



ORIGINAL SURVEY PLATTED
NOTE BOOK
NO.

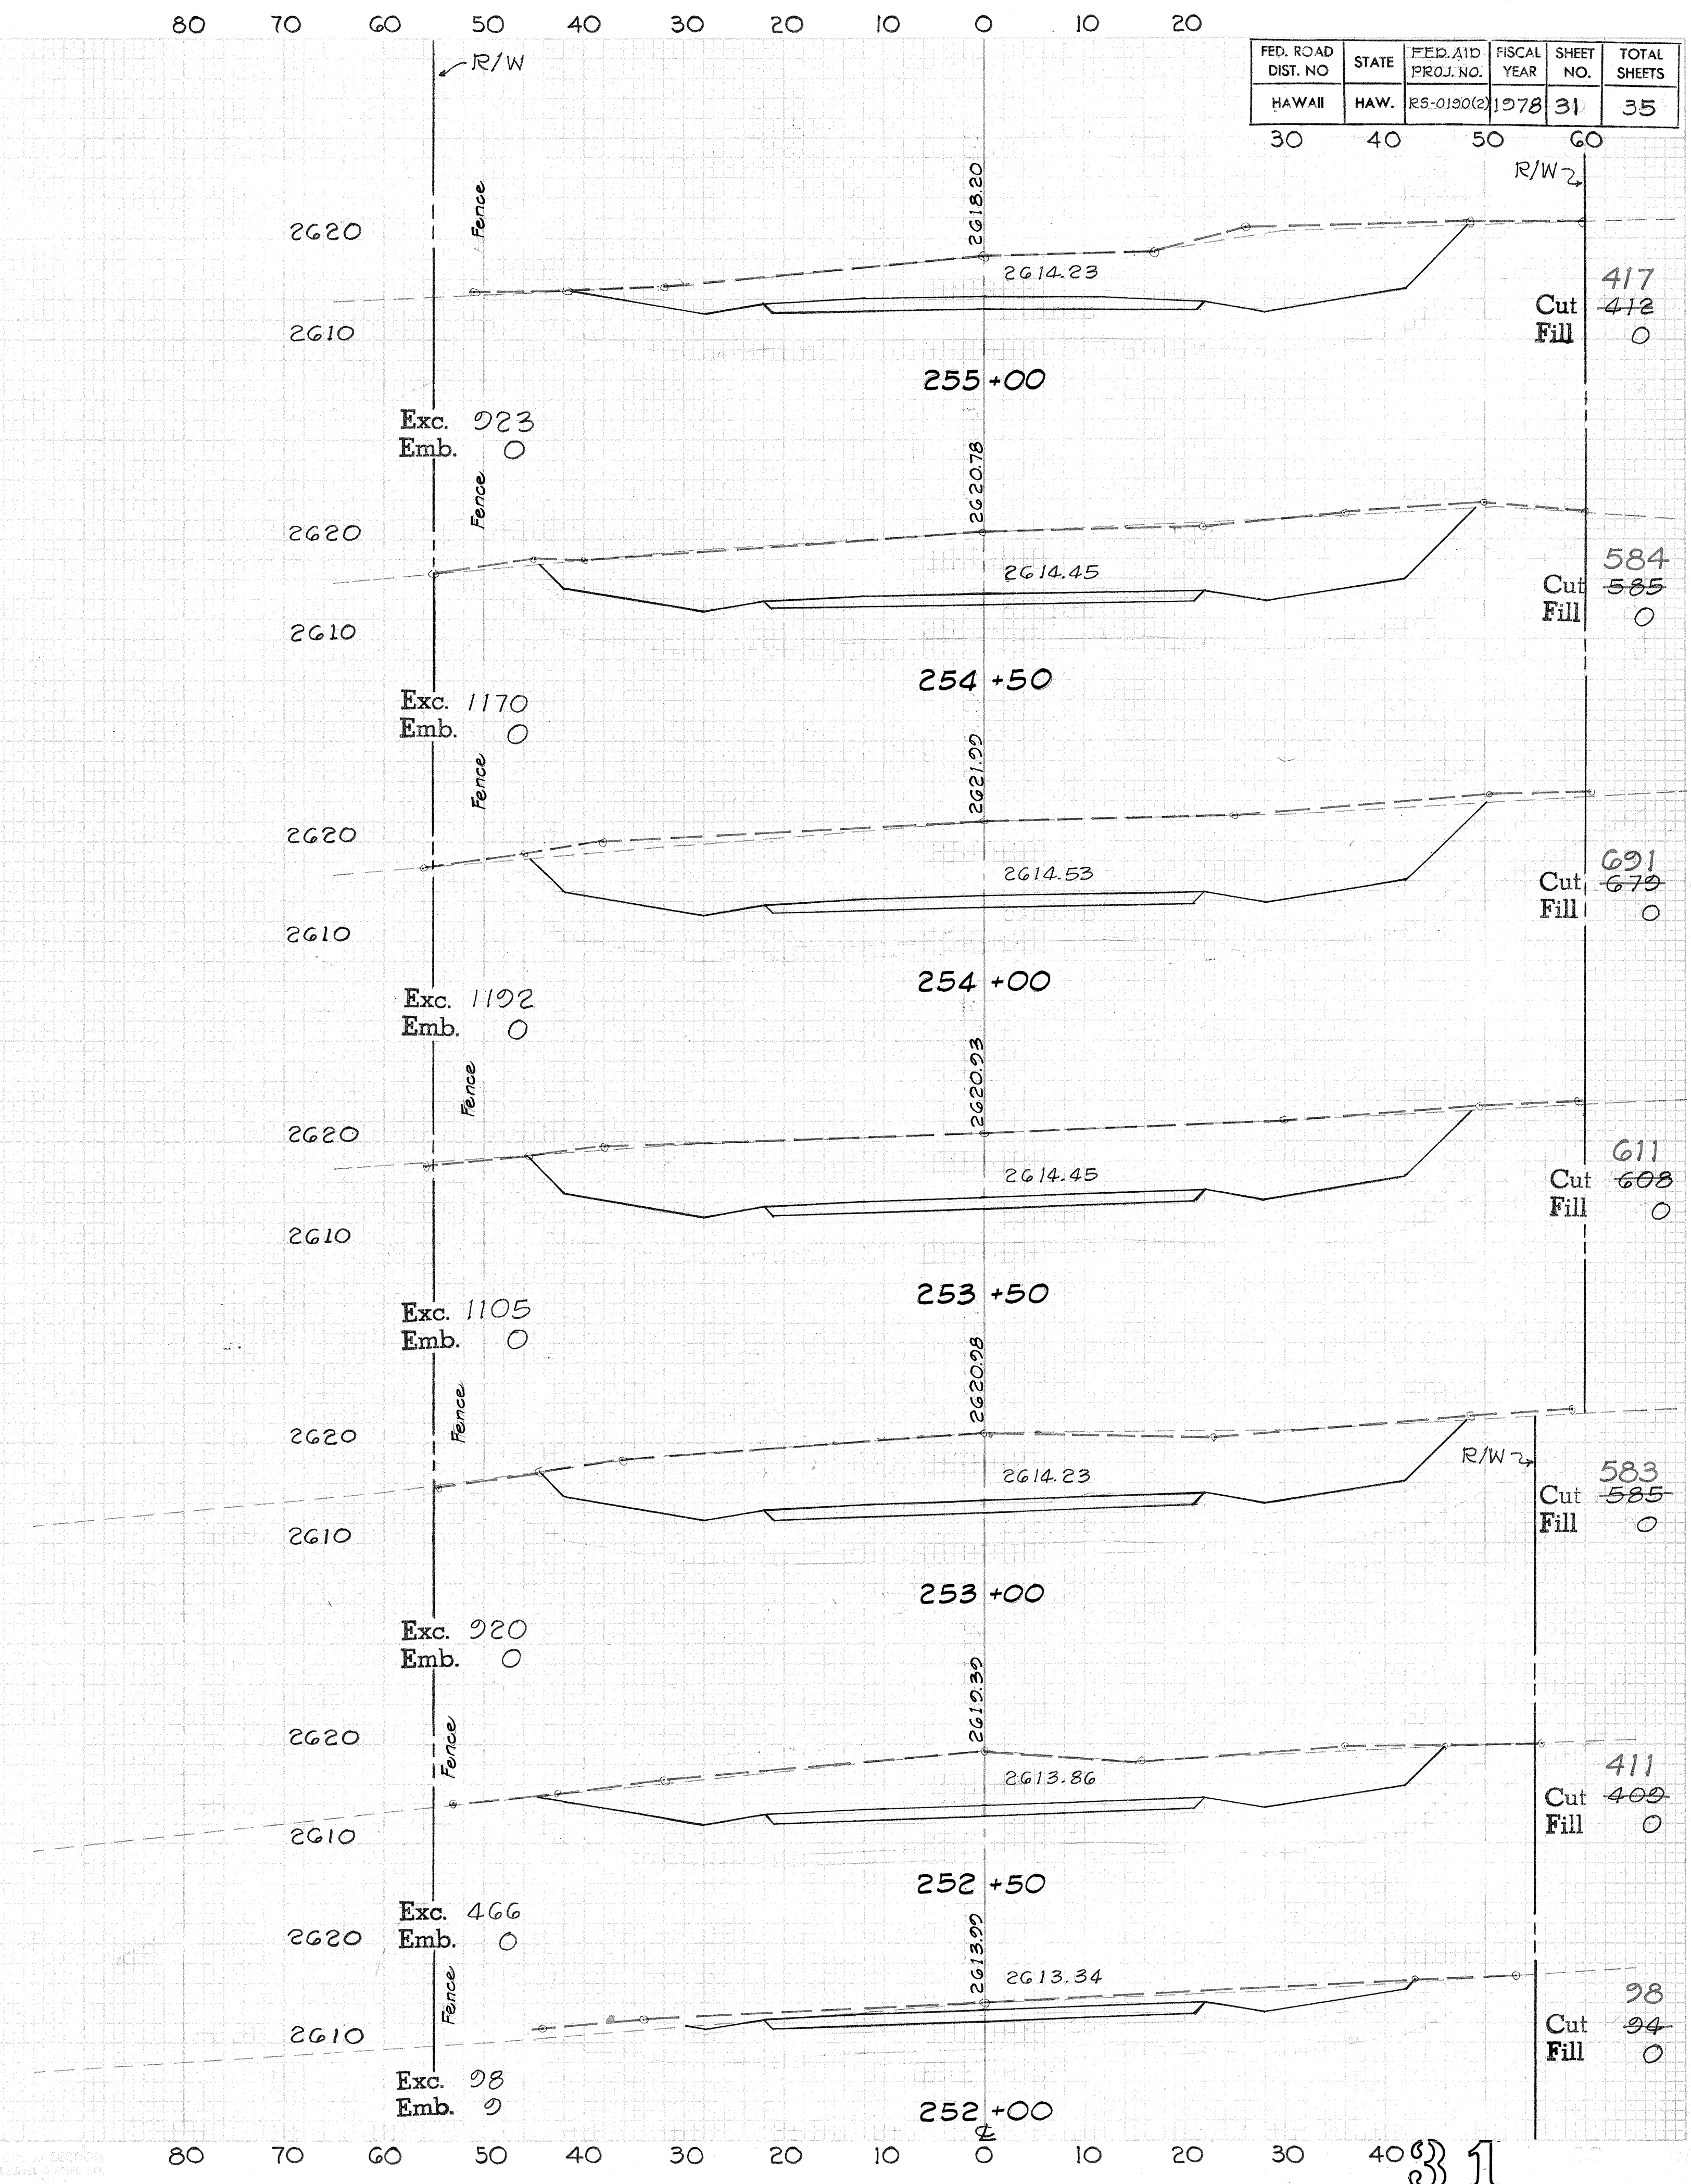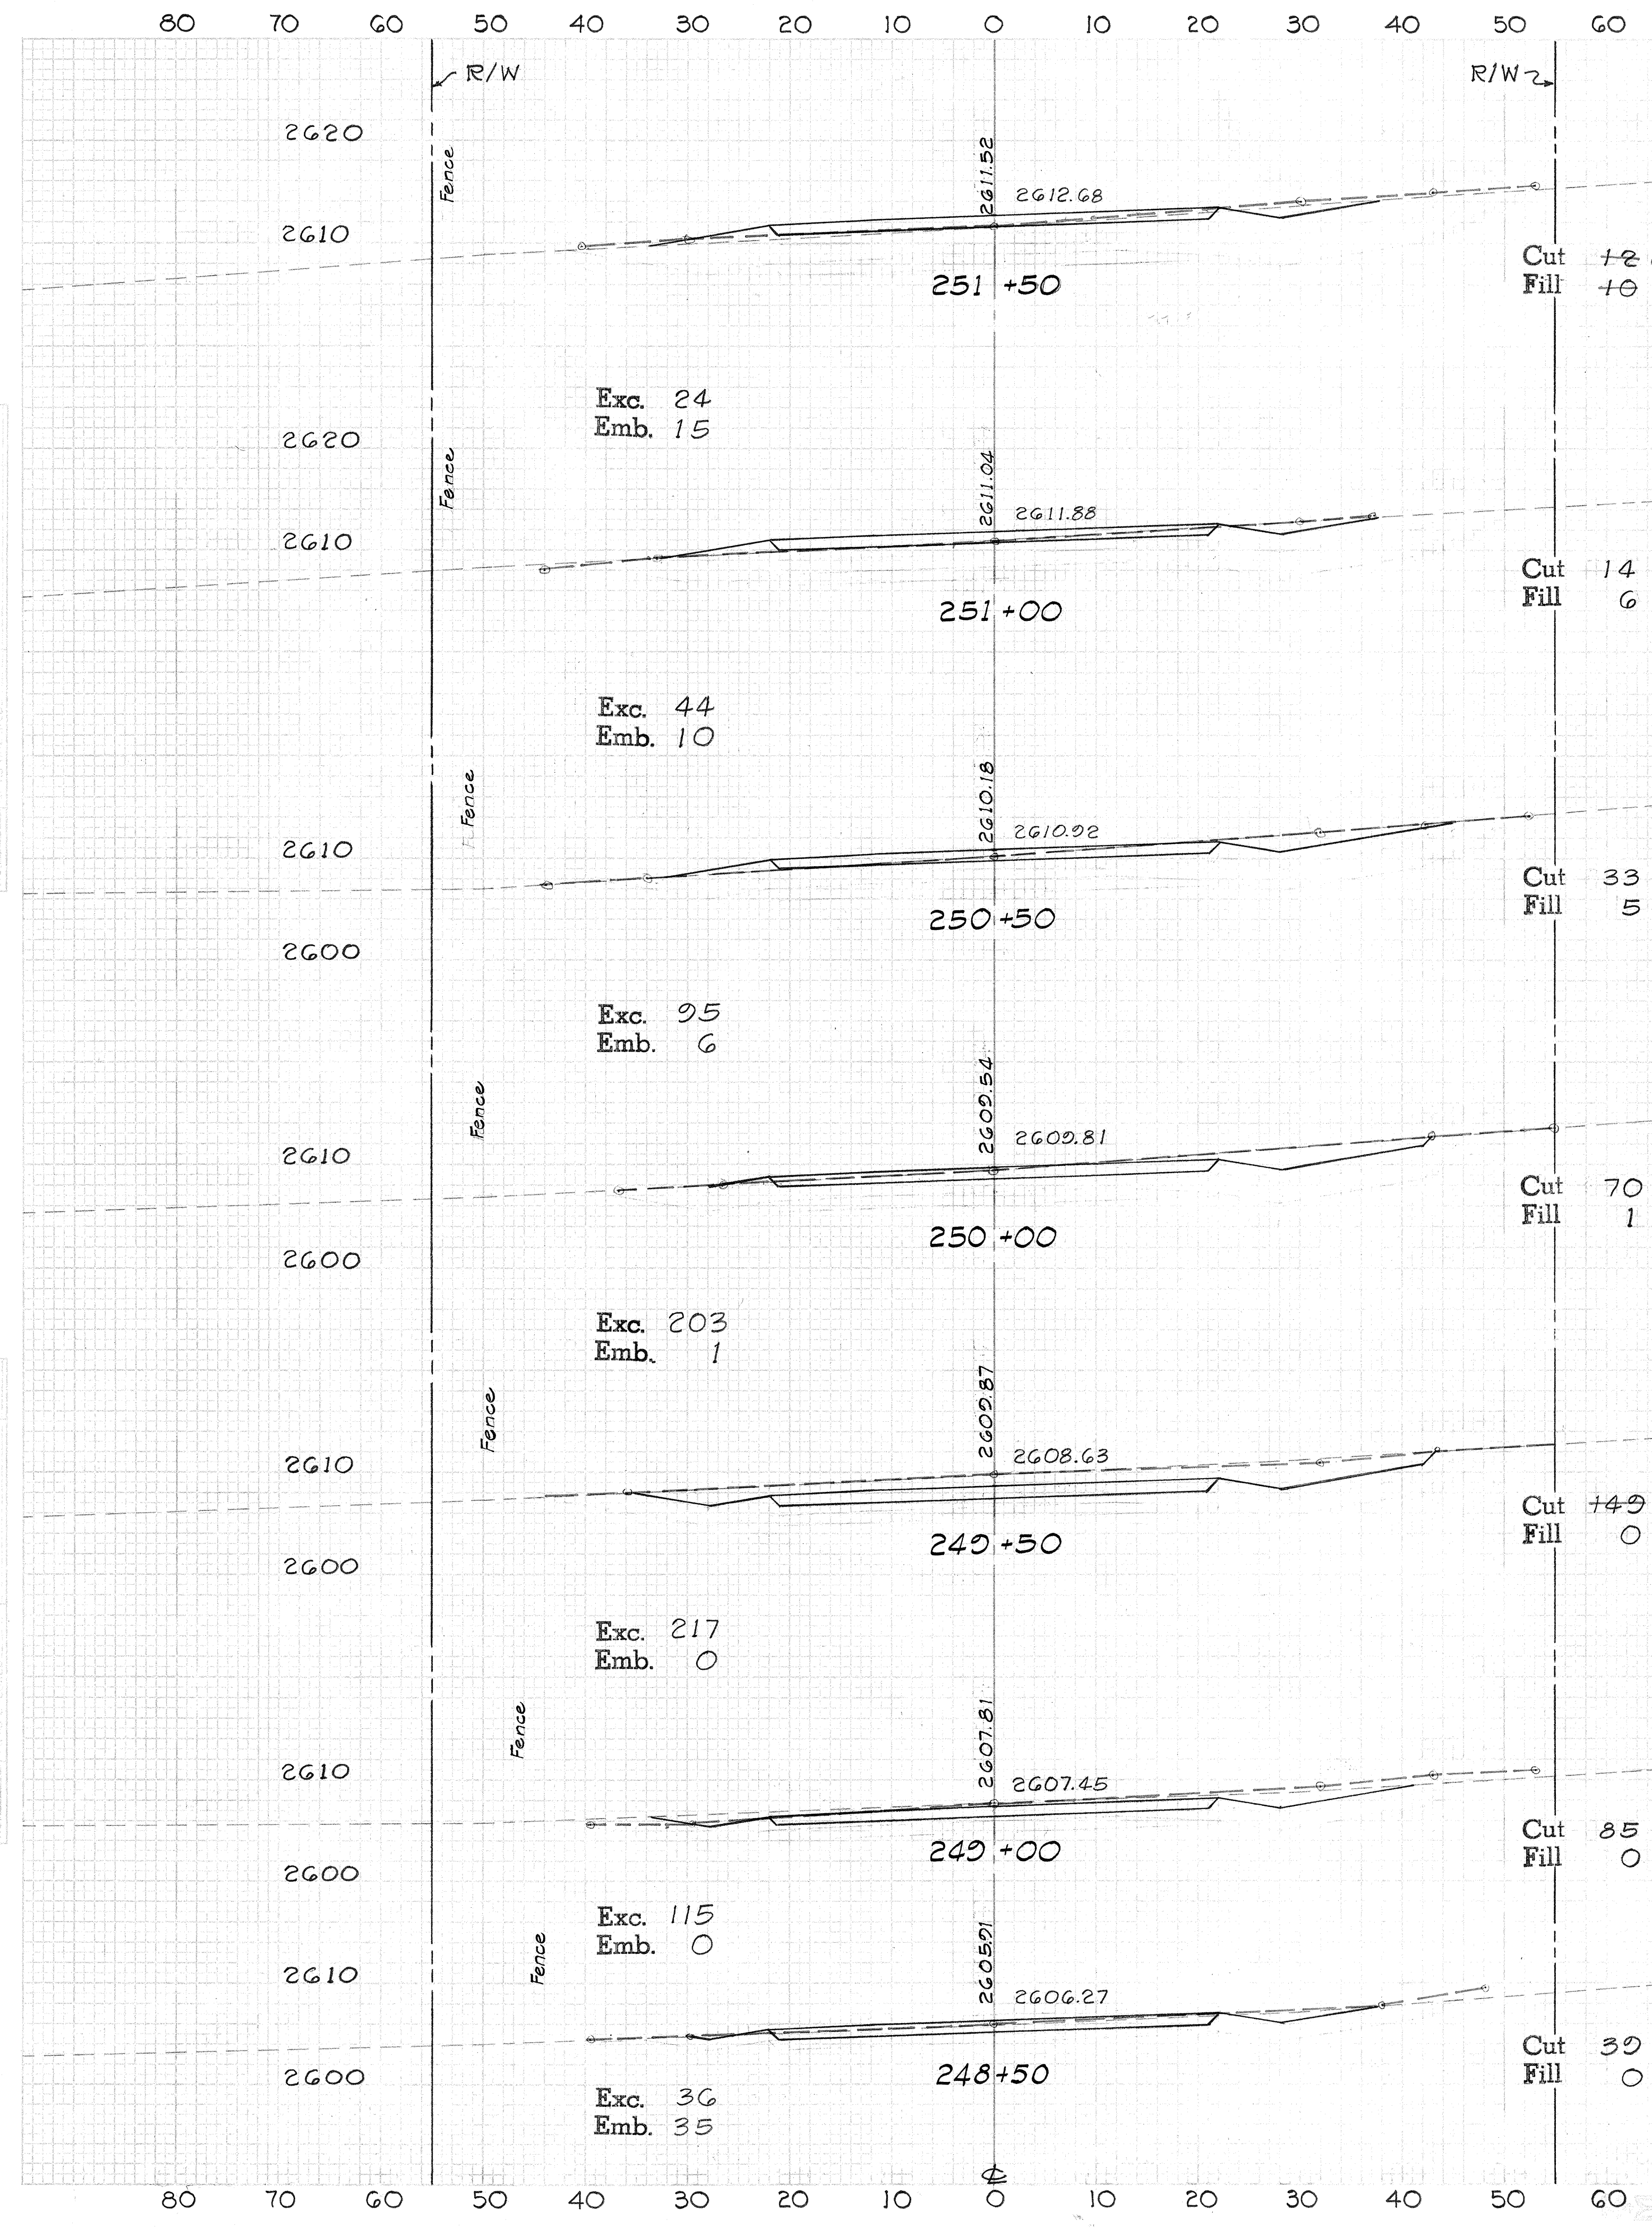

FINAL SURVEYED BY DATE
 SURVEY PLOTTED
 NOTE BOOK AREAS
 NO. AREAS CHECKED



ORIGINAL SURVEYED BY DATE
 SURVEY PLOTTED
 NOTE BOOK AREAS
 NO. AREAS CHECKED

FED. ROAD DIST. NO.	STATE	FED. AID PROJ. NO.	FISCAL YEAR	SHEET NO.	TOTAL SHEETS
HAWAII	HAW.	RS-0190(2)	1978	32	35

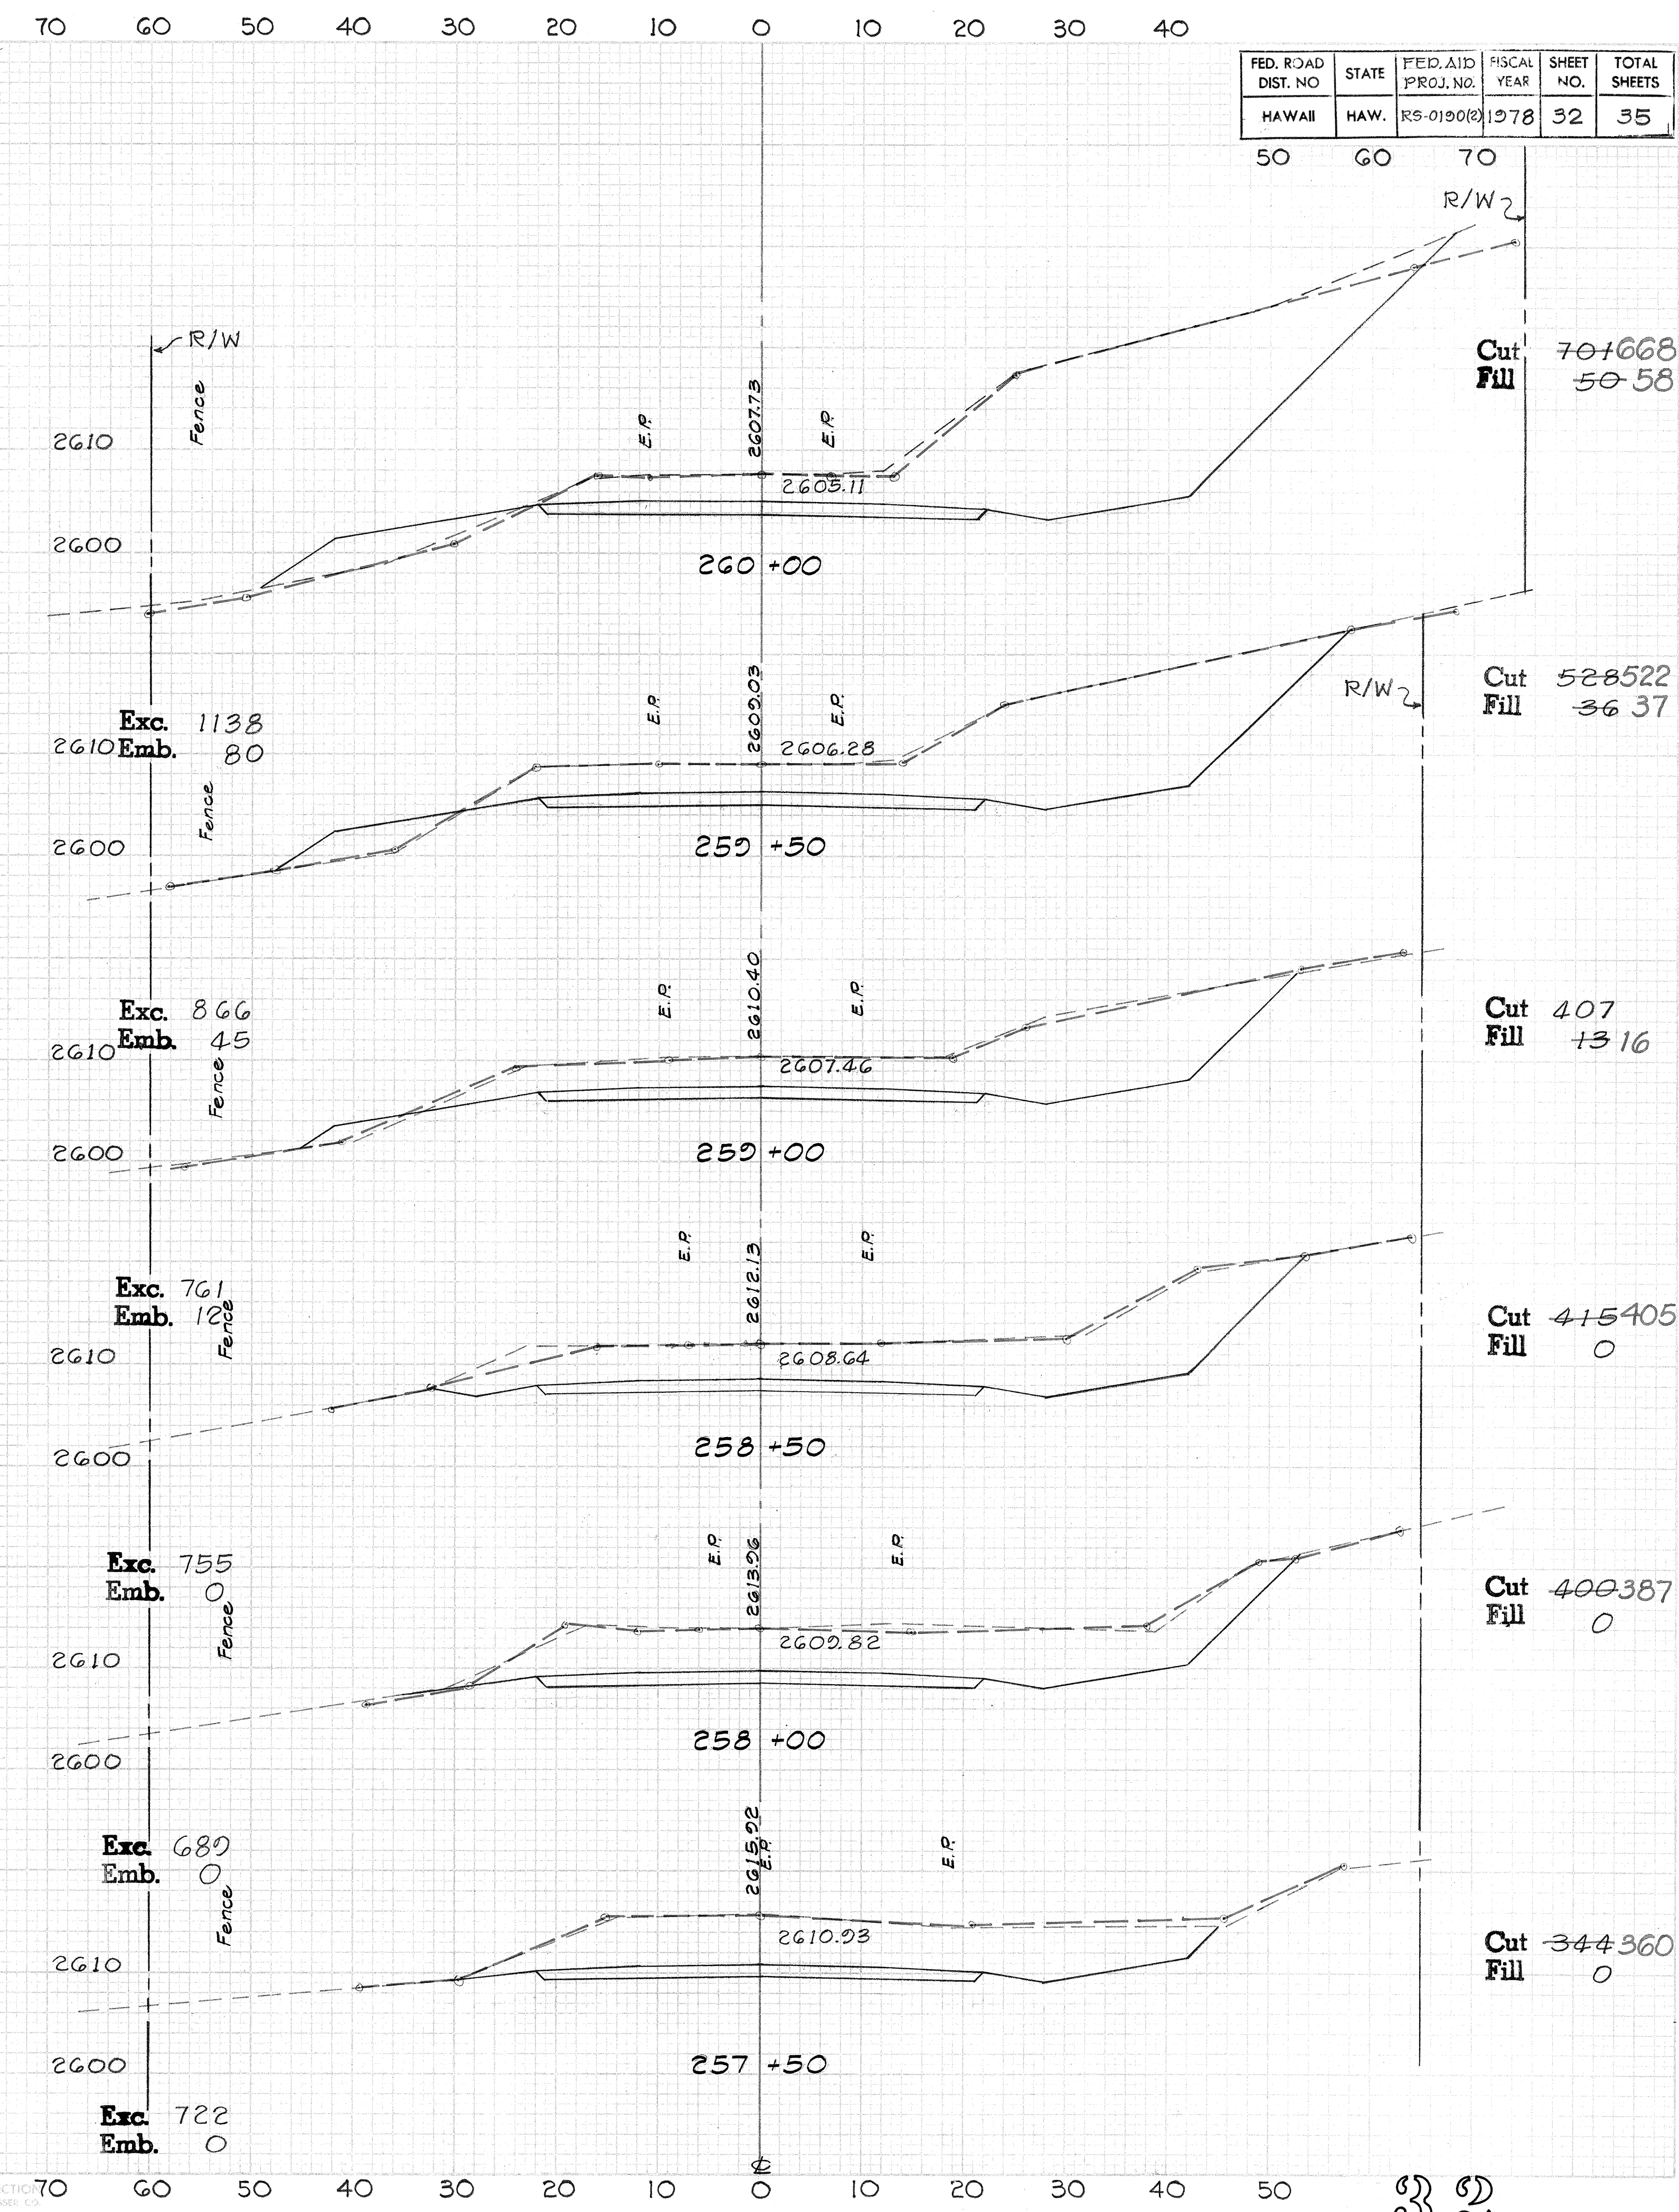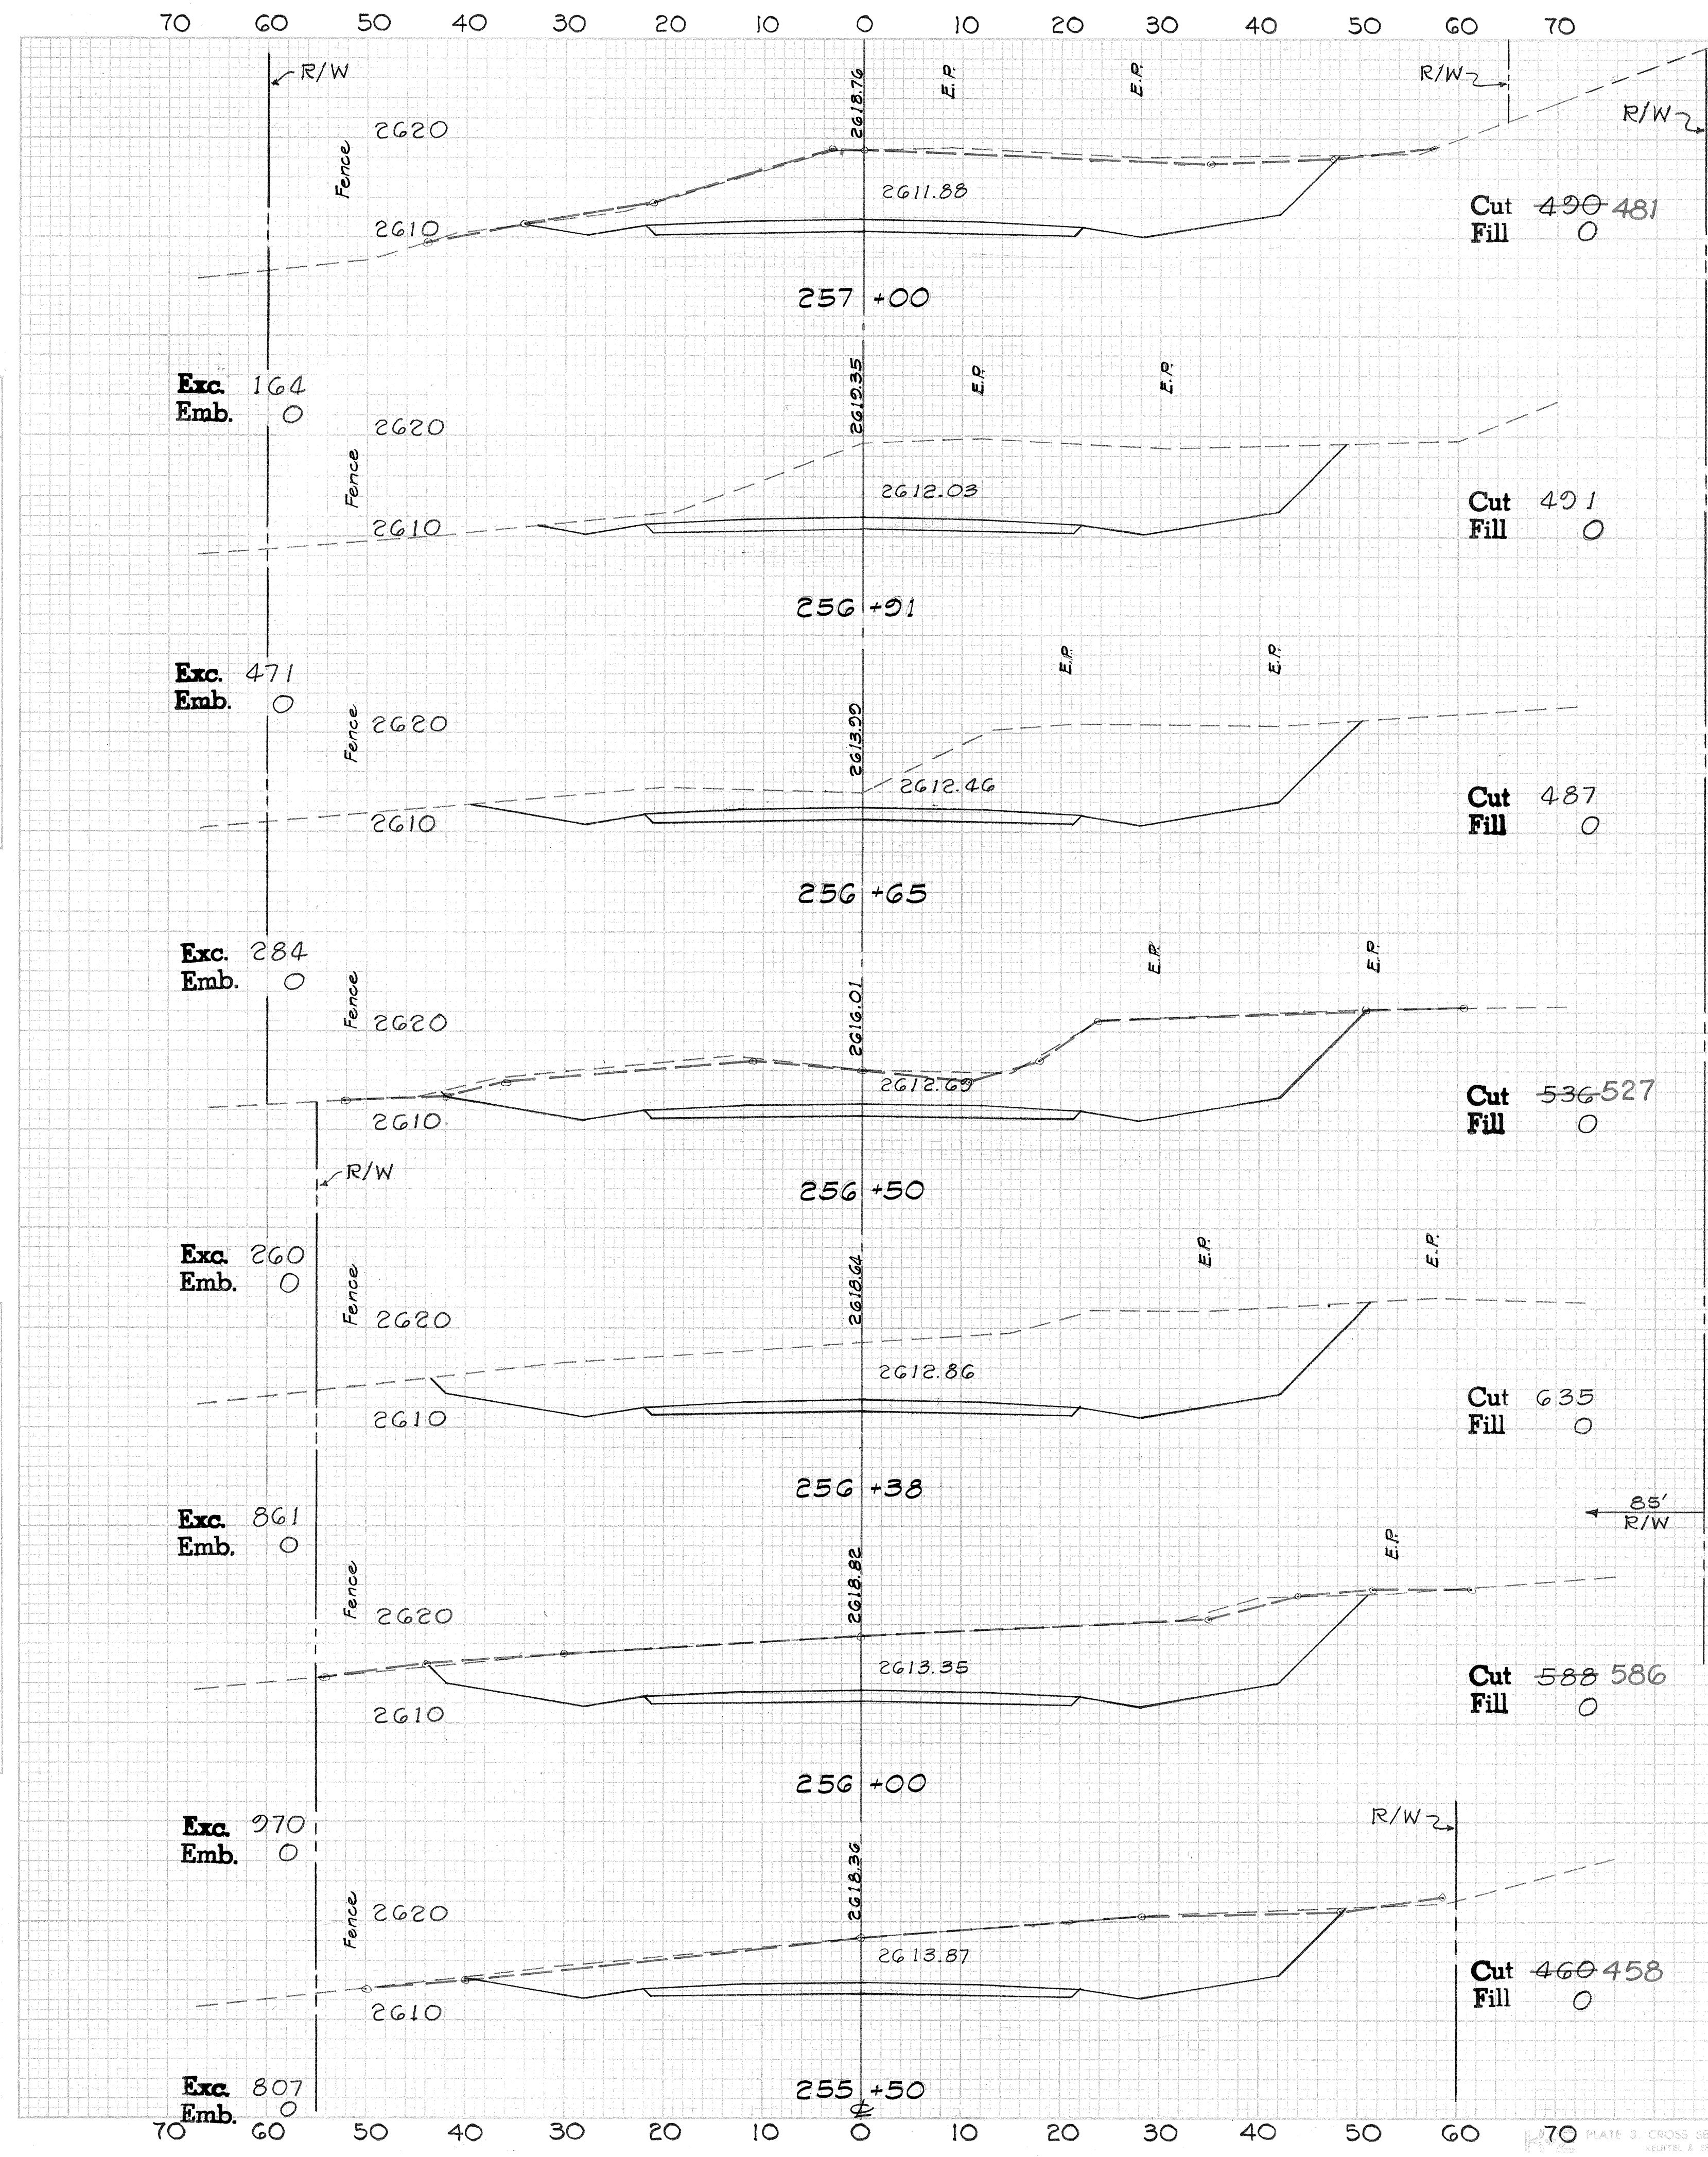

DATE	
BY	
REVIEWED	
SURVEY	
PLOTTED	
NOTE BOOK	
AREAS	
CHECKED	

DATE	3/10/72
BY	HA
REVIEWED	
SURVEY	
PLOTTED	
NOTE BOOK	
AREAS	
CHECKED	

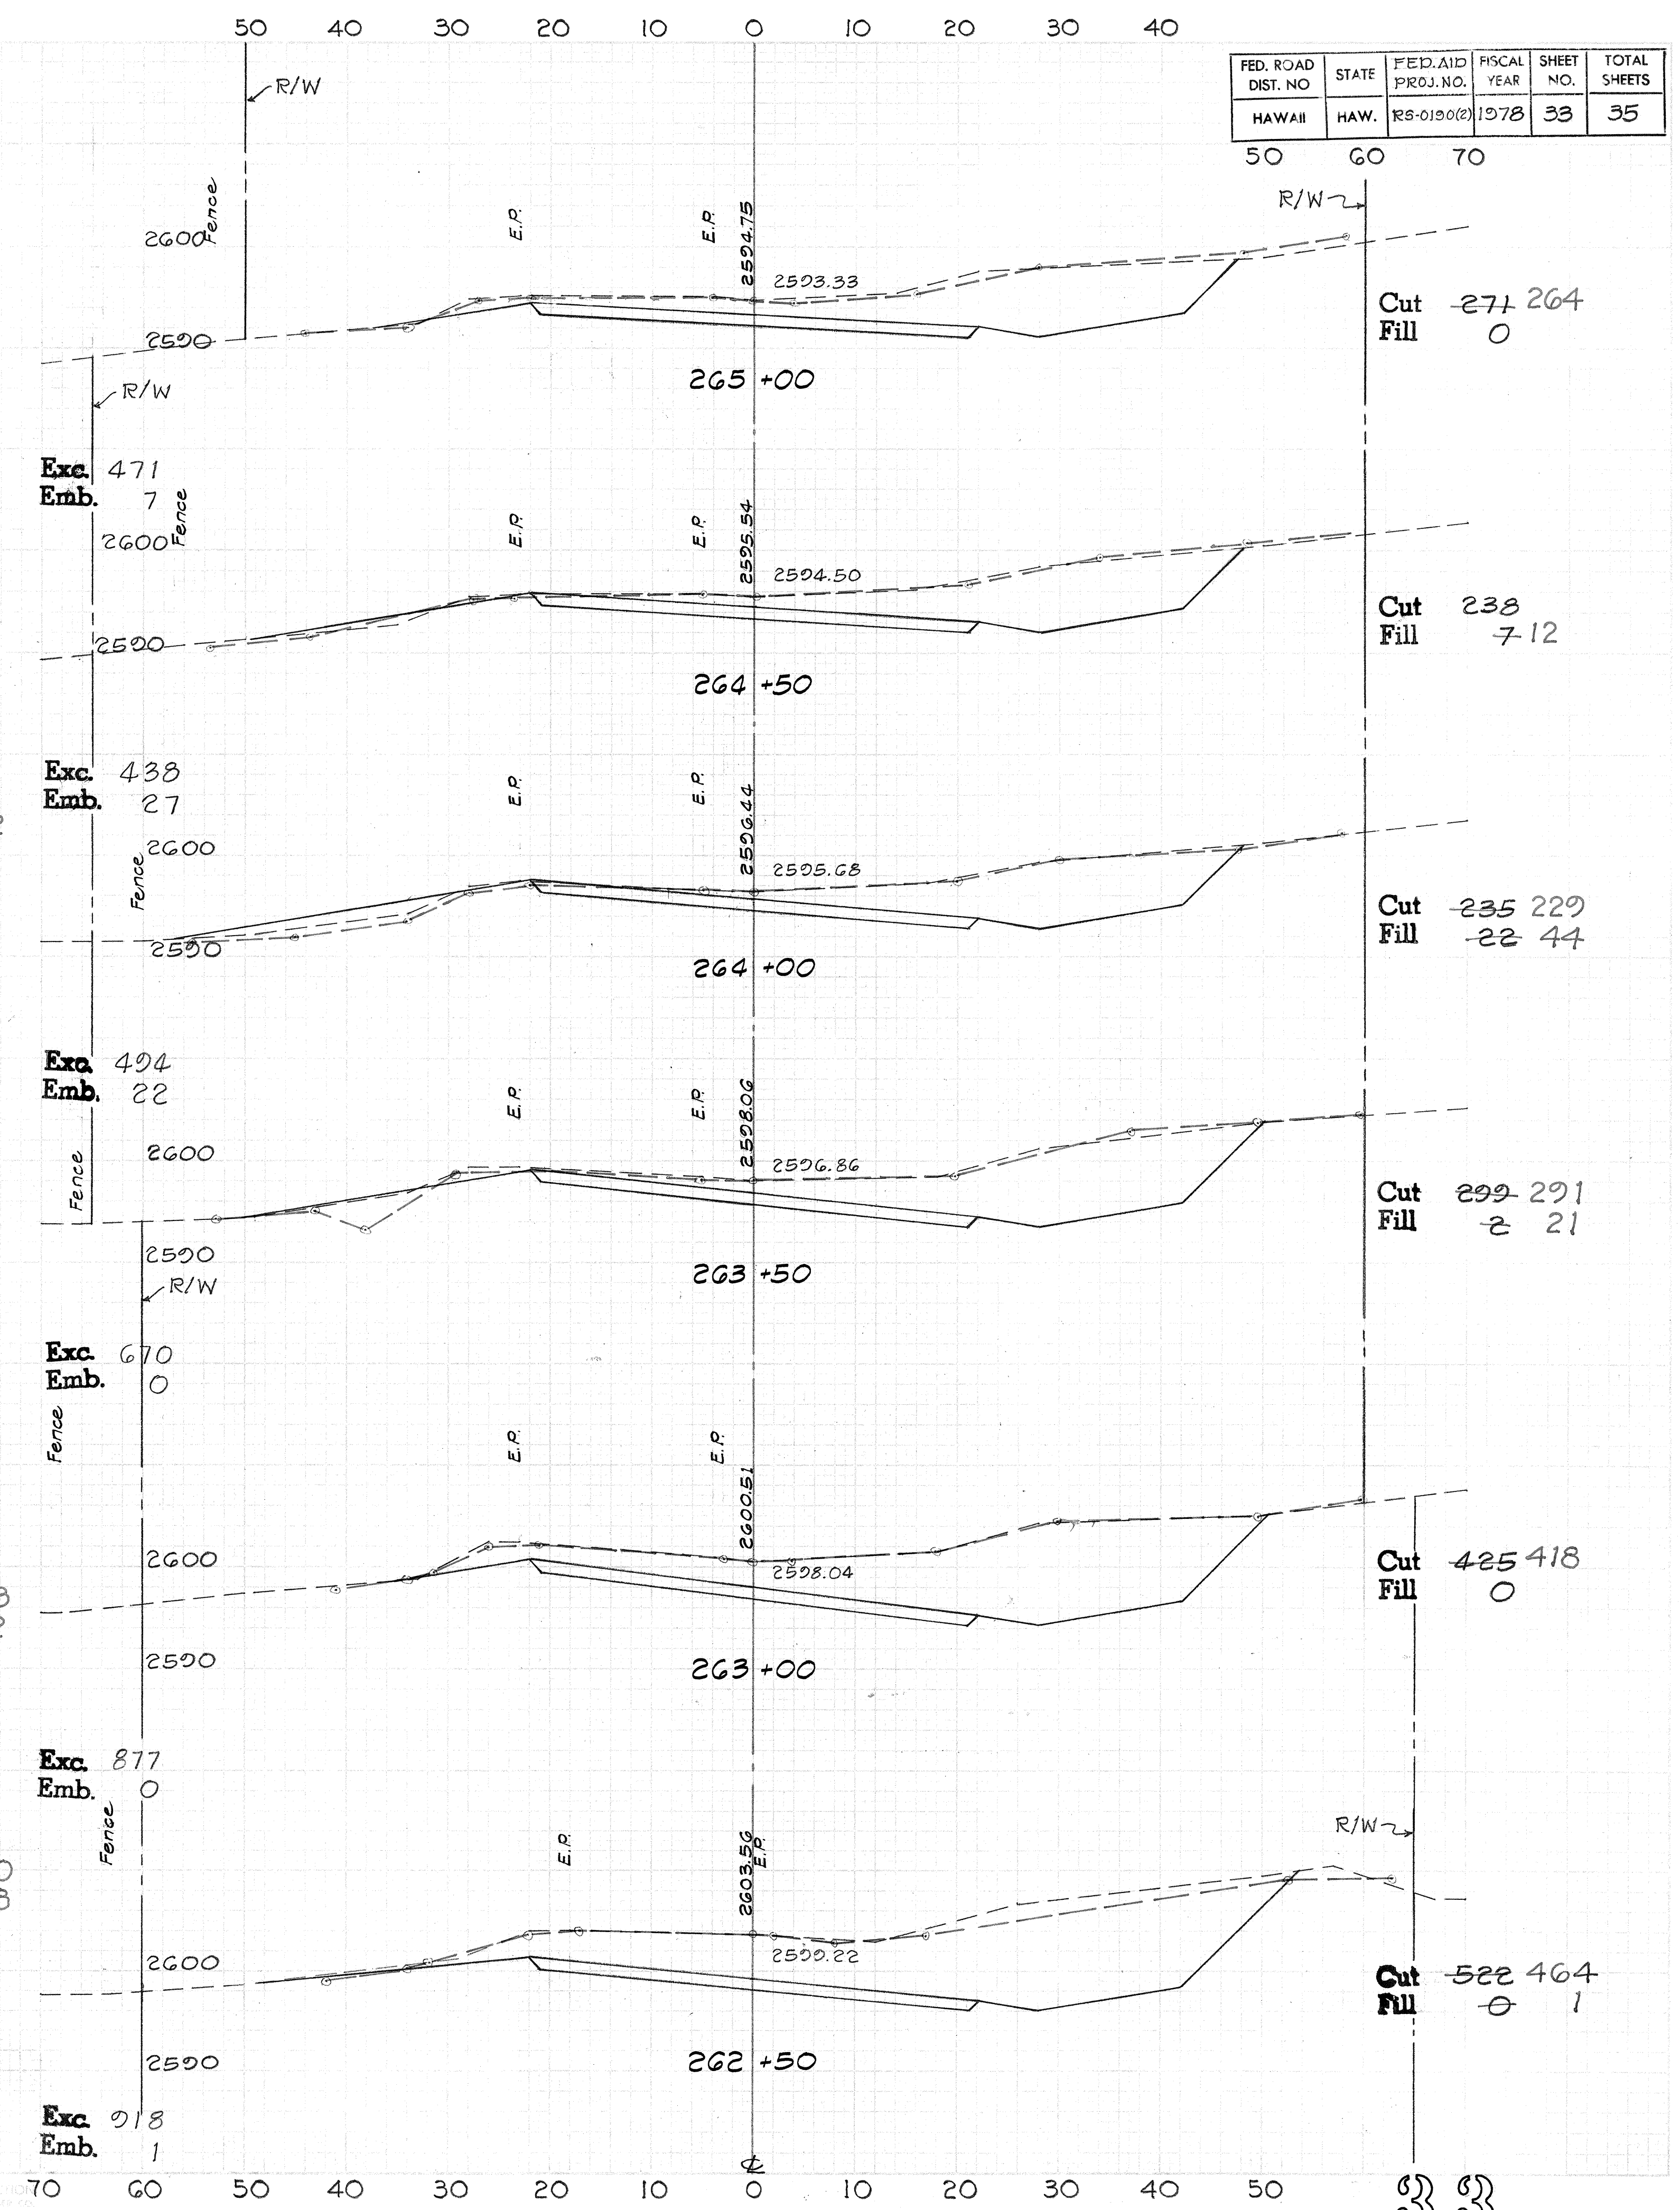
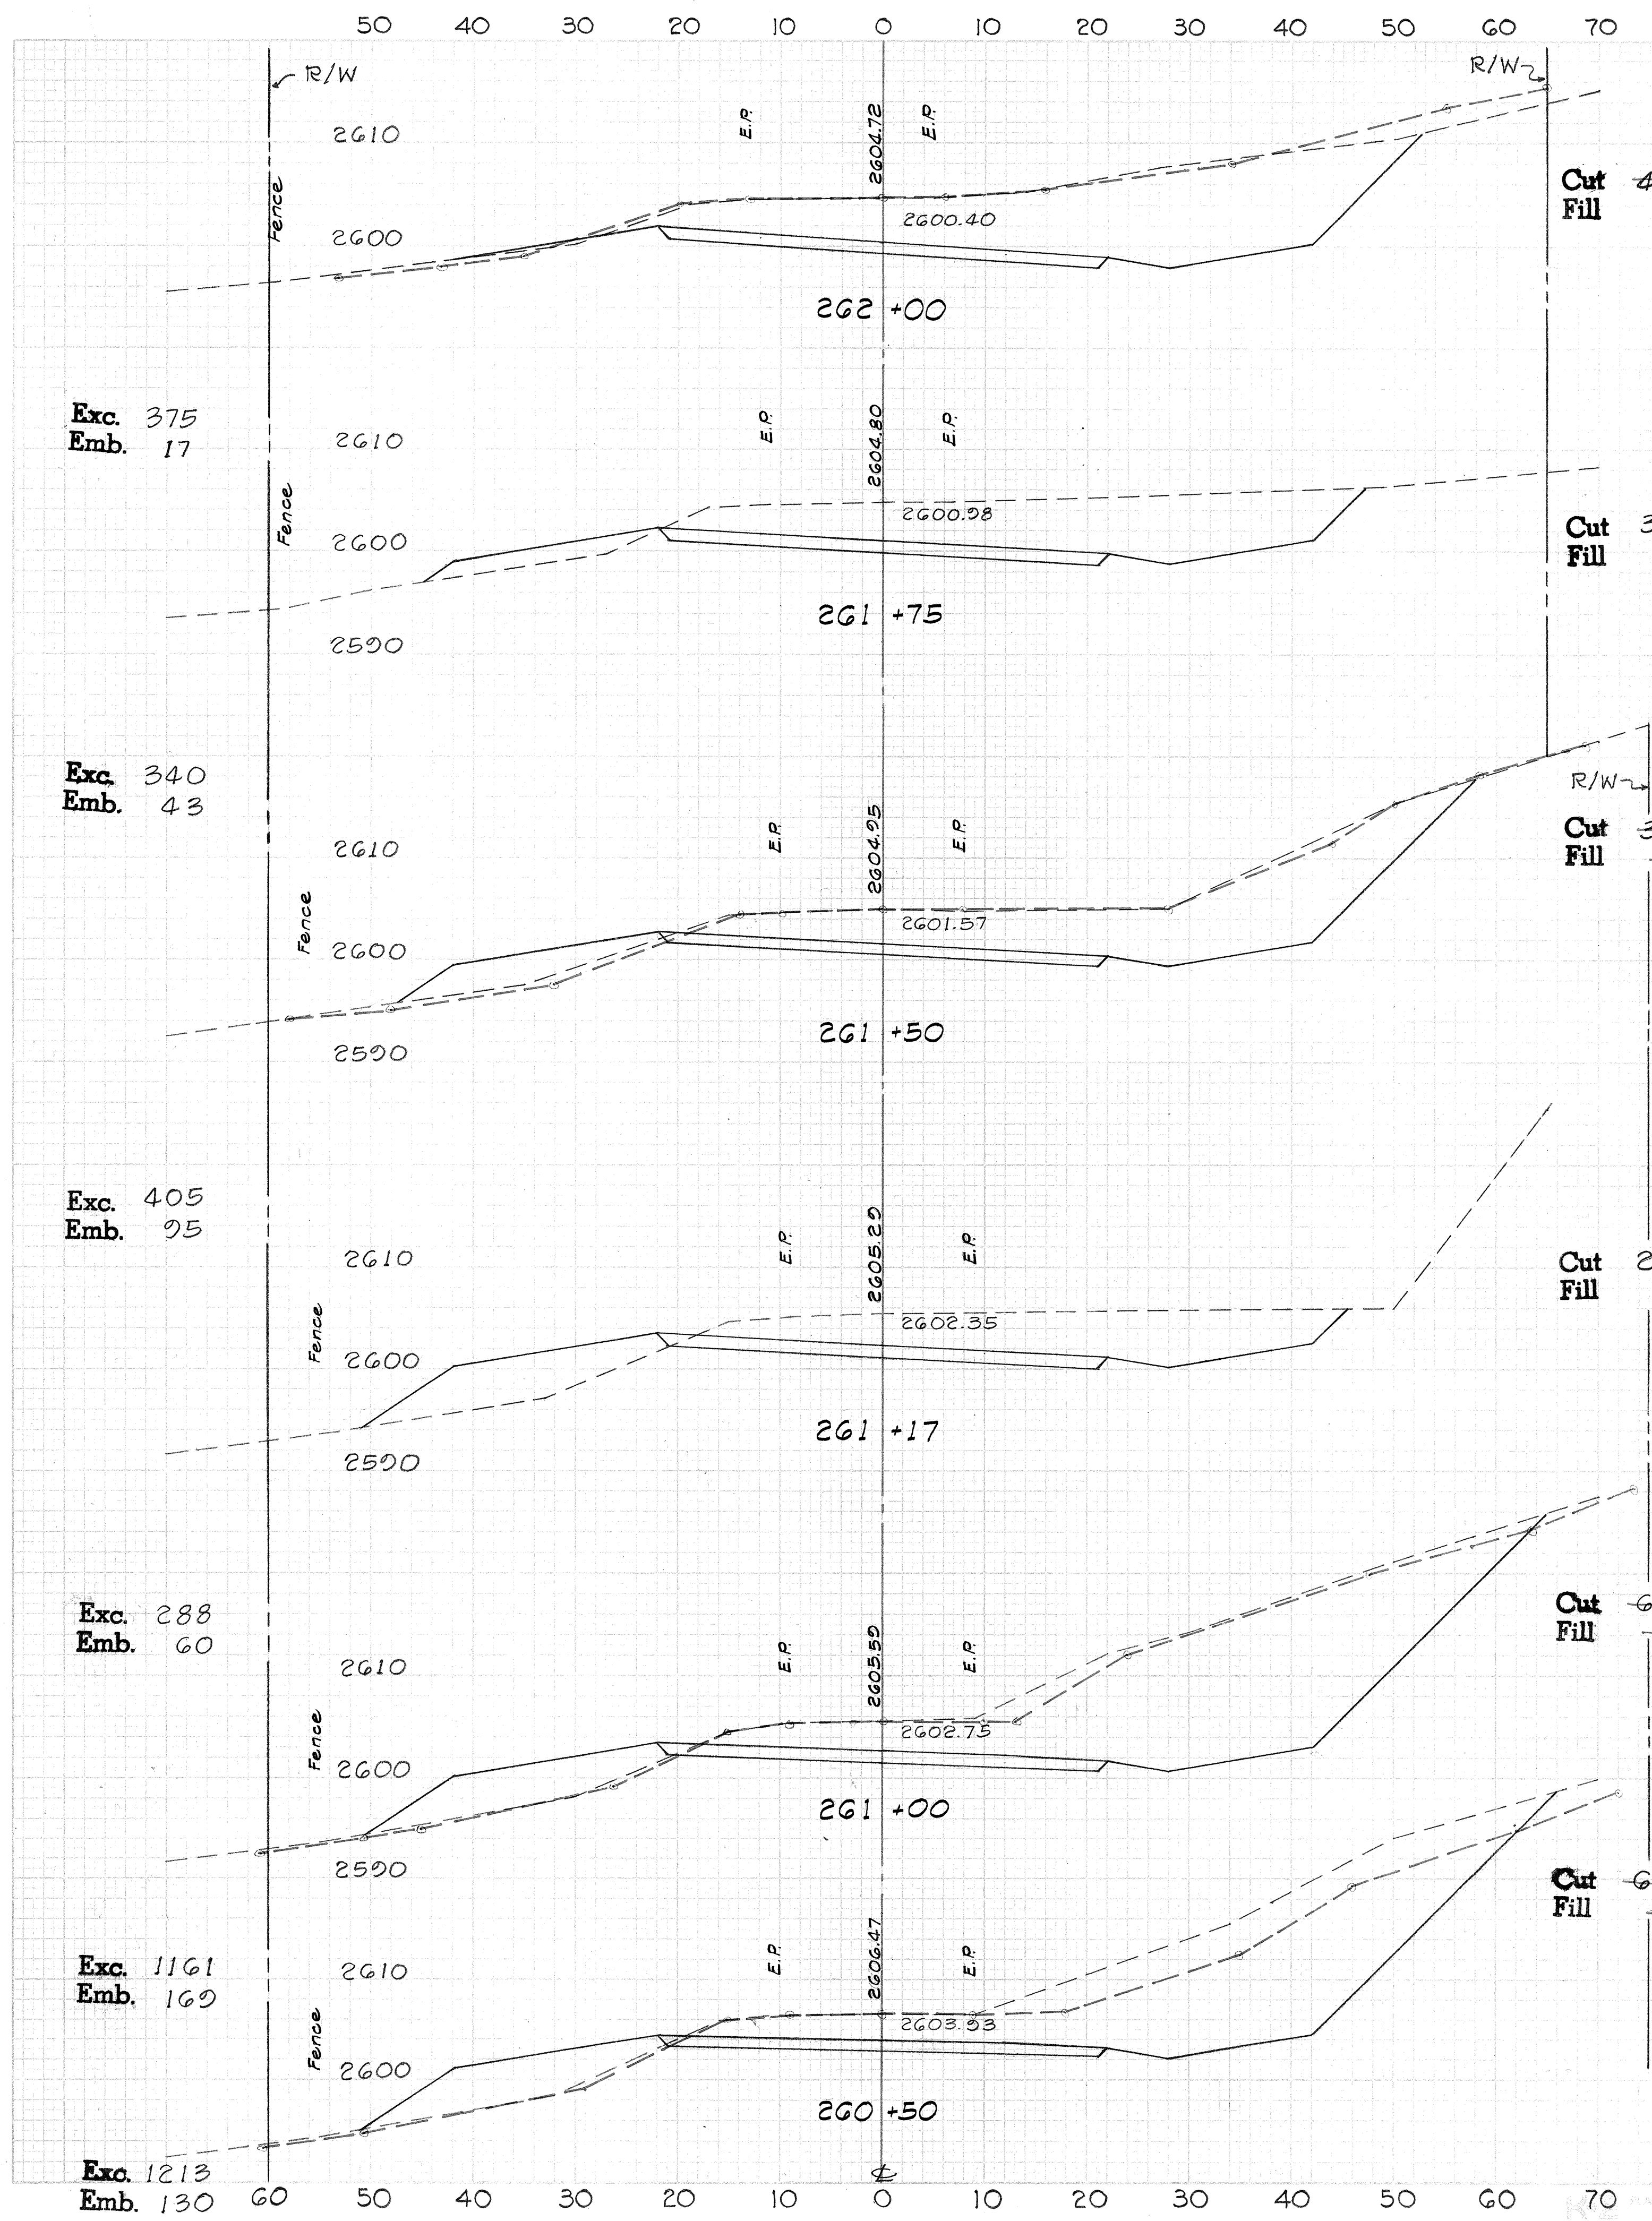


FED. ROAD DIST. NO.	STATE	FED. AID PROJ. NO.	FISCAL YEAR	SHEET NO.	TOTAL SHEETS
HAWAII	HAW.	RS-0190(2)	1978	33	35

FINAL SURVEY	DATE
BY	
SURVEYED	
NOTE BOOK	
AREAS CHECKED	

ORIGINAL SURVEY	DATE
BY	
SURVEYED	
NOTE BOOK	
AREAS CHECKED	

FED. ROAD DIST. NO.	STATE	FED. AID PROJ. NO.	FISCAL YEAR	SHEET NO.	TOTAL SHEETS
HAWAII	HAW.	RS-0190(2)	1978	34	35

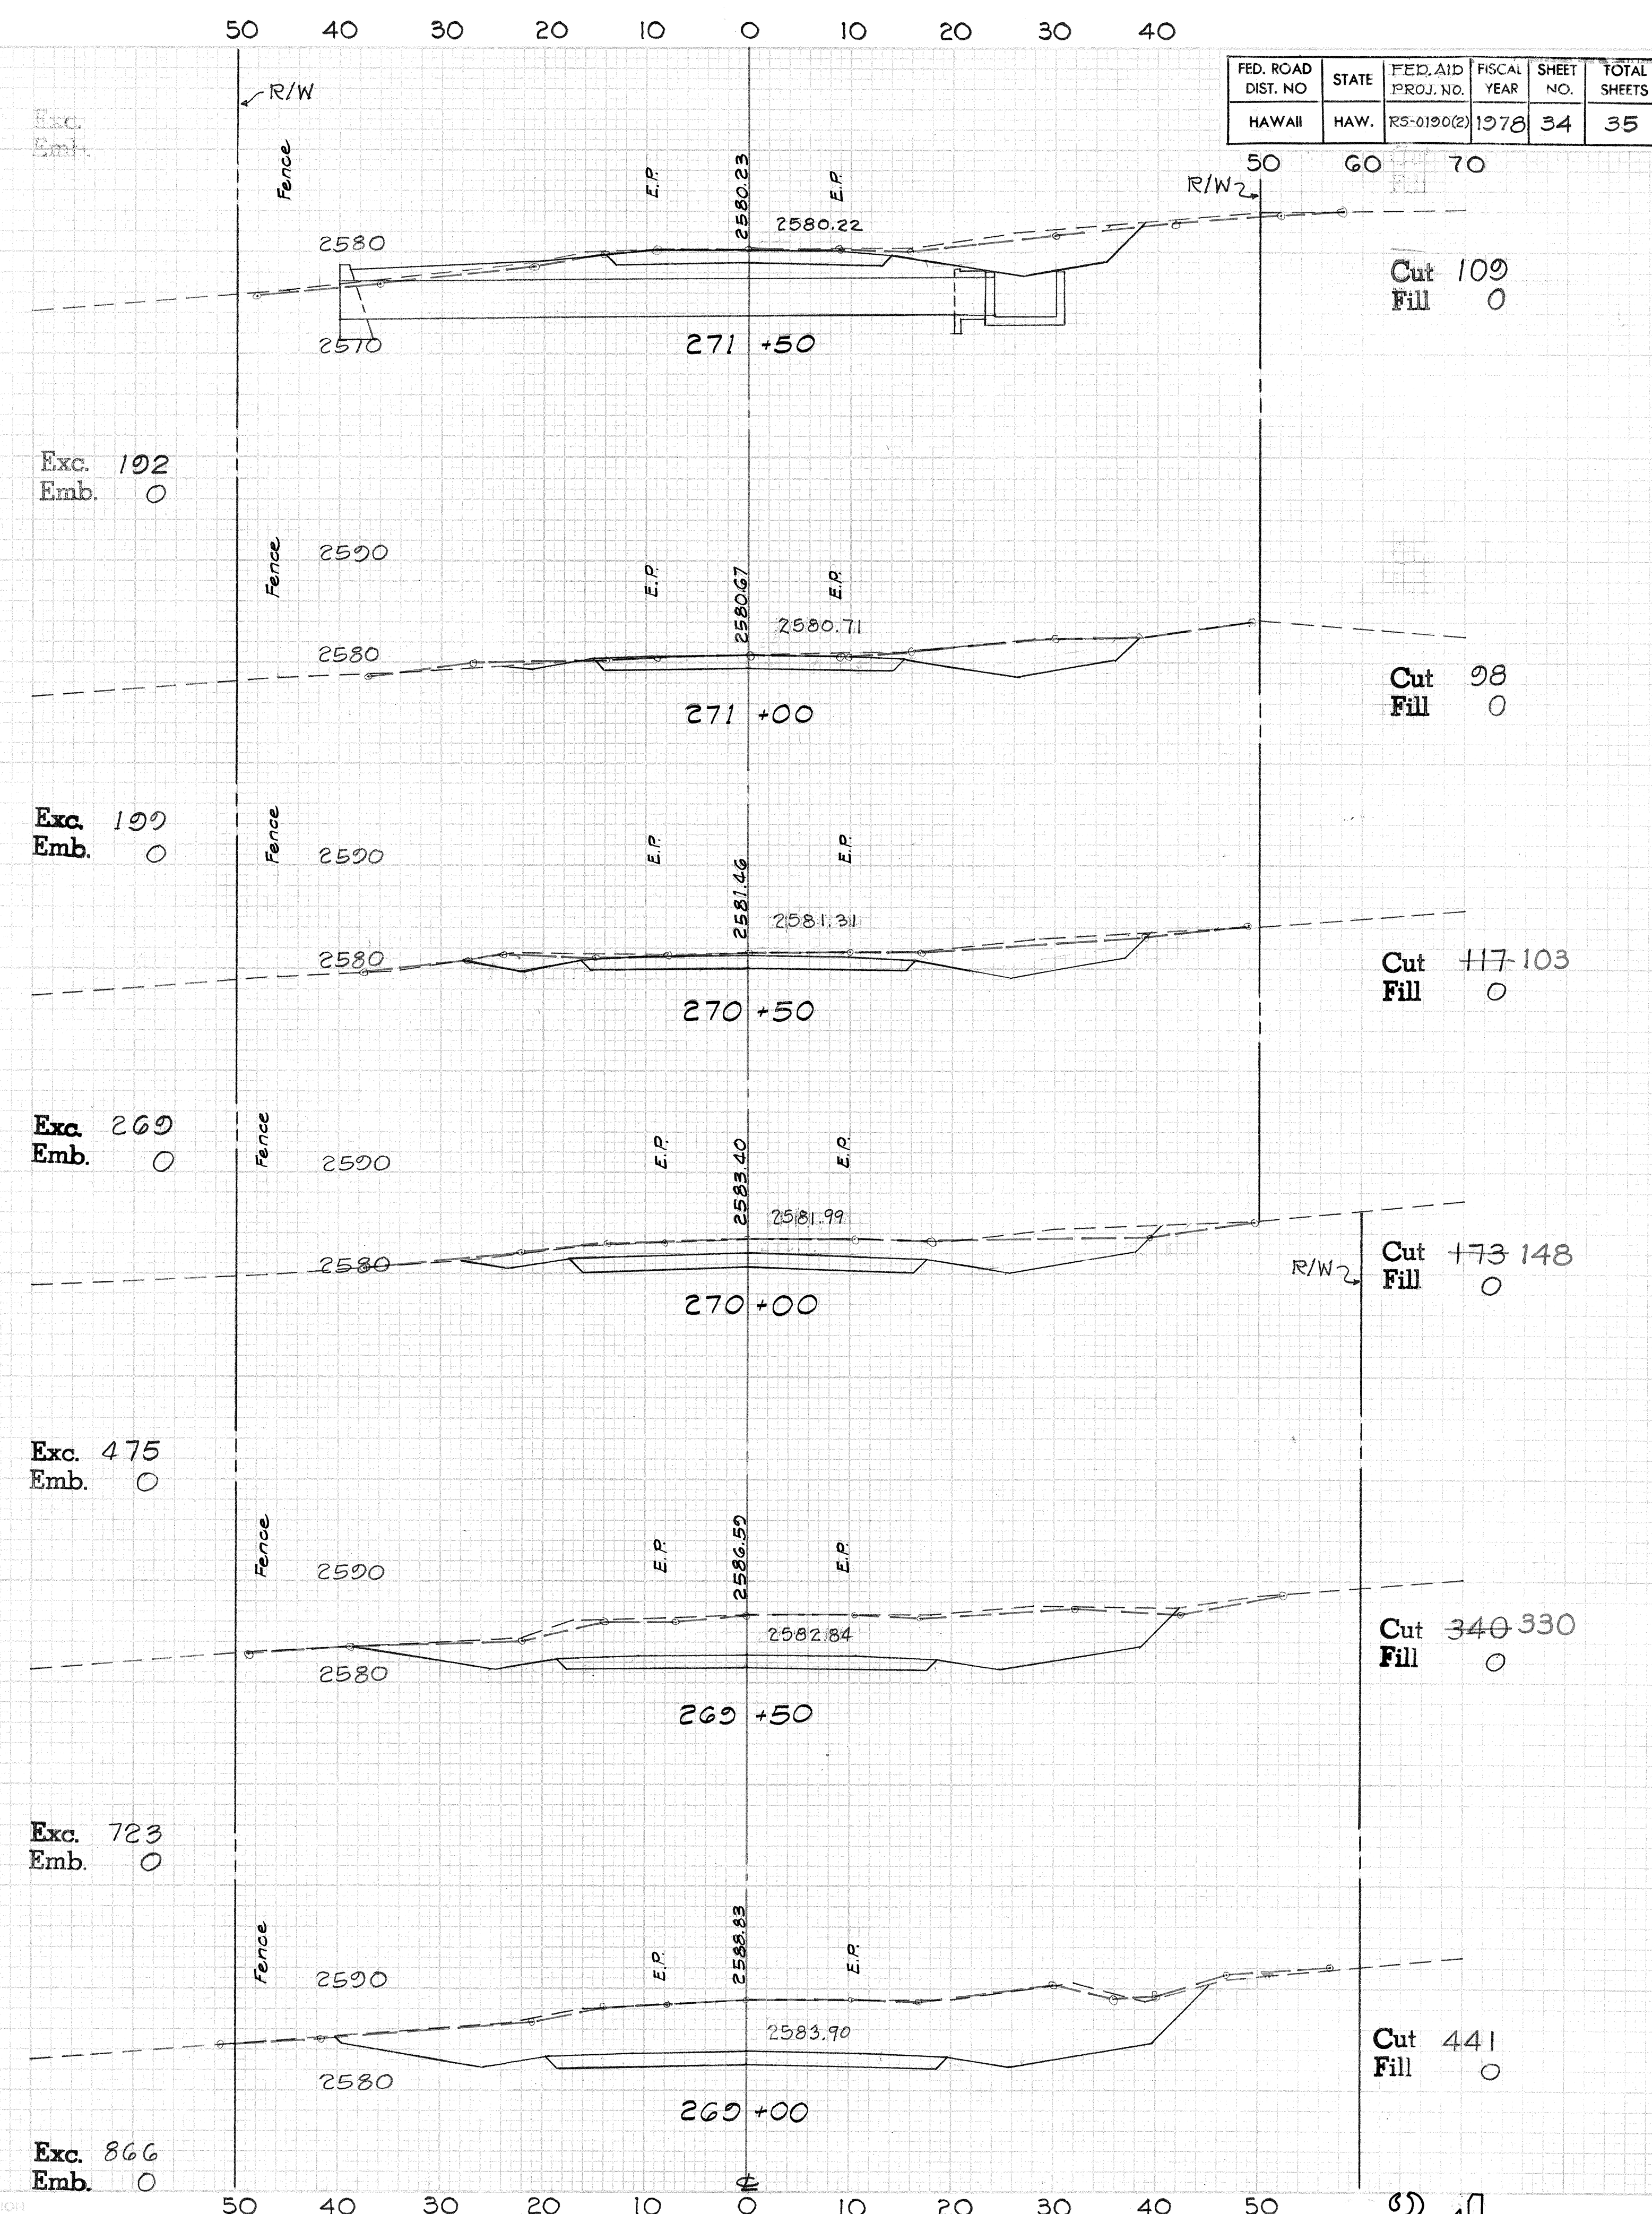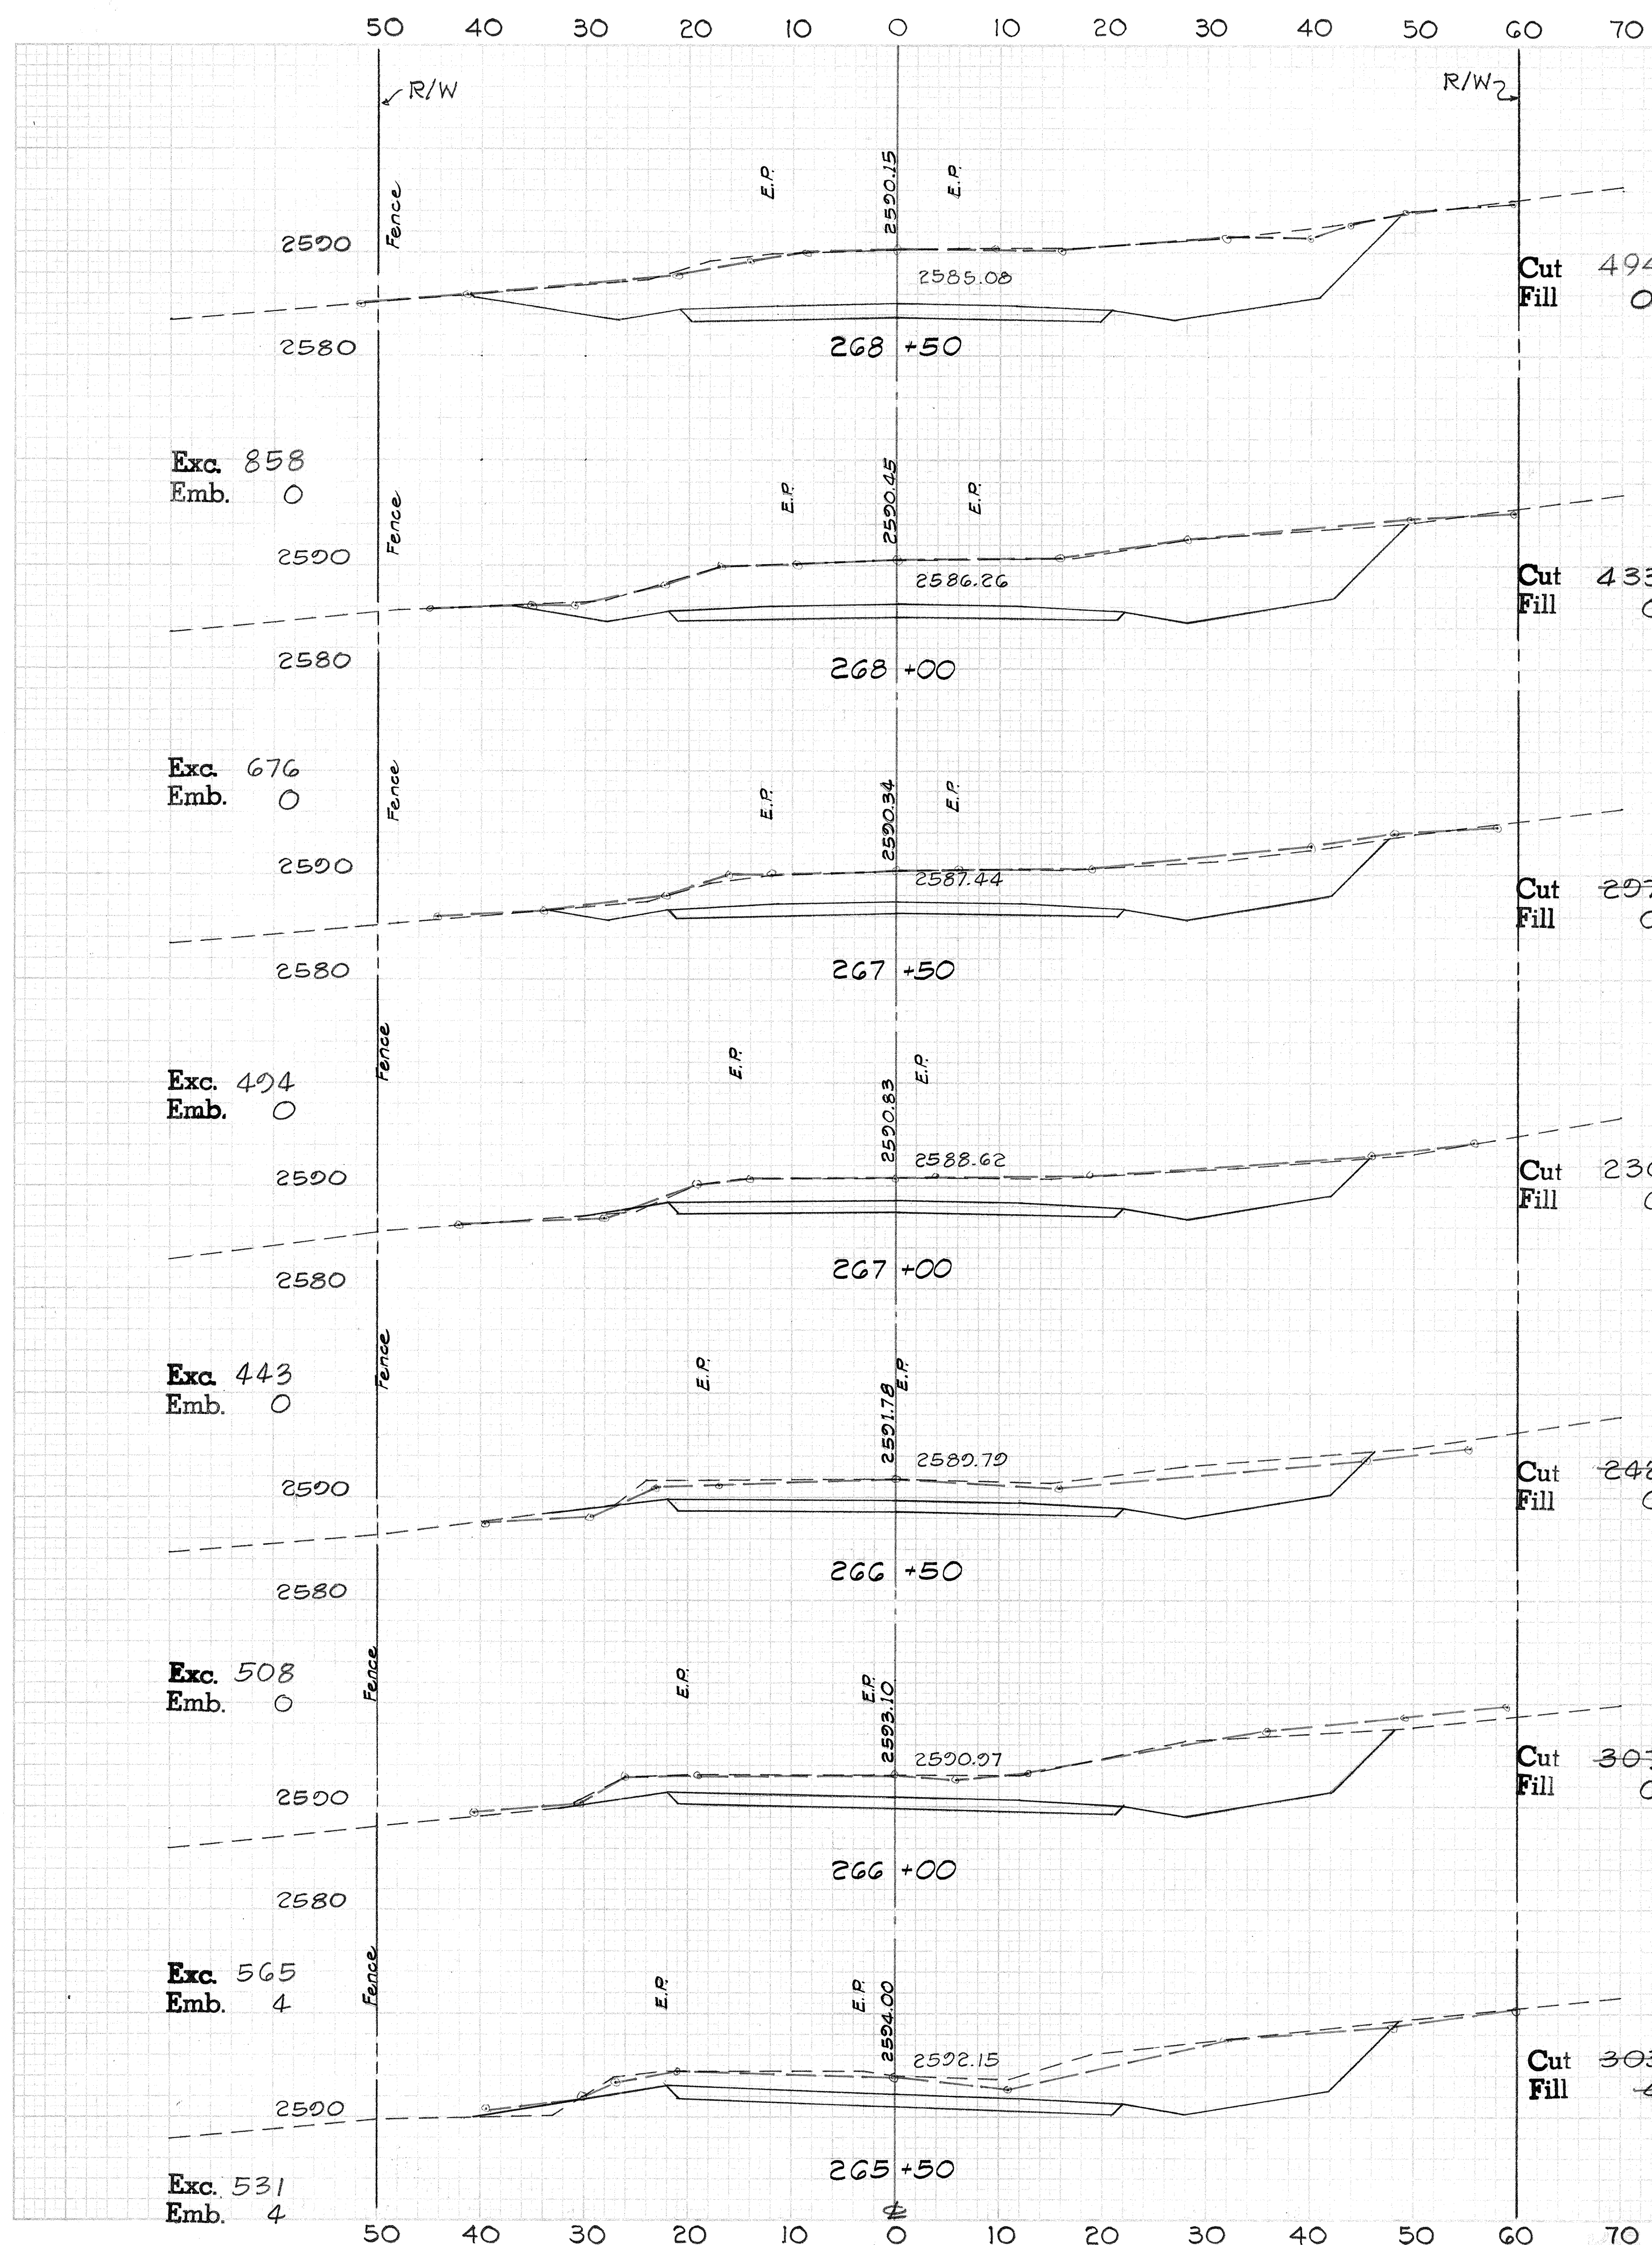

FED. ROAD DIST. NO.	STATE	FED. AID PROJ. NO.	FISCAL YEAR	SHEET NO.	TOTAL SHEETS
HAWAII	HAW.	RS-0190(2)	1978	35	35

FINAL SURVEY	BY	DATE
SURVEYED		
PLOTTED		
NOTE BOOK		
AREAS		
CHECKED		

ORIGINAL SURVEY	BY	DATE
SURVEYED		
PLOTTED		
NOTE BOOK		
AREAS		
CHECKED		

