

INDEX TO DRAWINGS	
SHEET NO.	DESCRIPTION
1	TITLE SHEET
2	TYPICAL SECTION
3 - 5	PLAN AND PROFILE
6	PAVEMENT STRIPING & TRAFFIC SIGNS
7 - 11	DRAINAGE
12 - 27	STANDARD DETAILS
28 - 35	CROSS SECTIONS

STATE OF HAWAII
DEPARTMENT OF TRANSPORTATION
LAND TRANSPORTATION FACILITIES DIVISION
AS BUILT
PLANS FOR

HAWAII BELT ROAD
ROUTE 190D
KEAMUKU TOWARDS WAIMEA
FEDERAL AID PROJECT NO. RS-0190(2)
DISTRICT OF SOUTH KOHALA
ISLAND OF HAWAII


SCALES

PLAN.....
1 INCH = 50 FT.

PROFILE.....
HOR. 1 INCH = 50 FT.
VER. 1 INCH = 10 FT.

CROSS SECTION.....
HOR. 1 INCH = 10 FT.
VER. 1 INCH = 10 FT.

GENERAL LOCATION
OF PROJECT

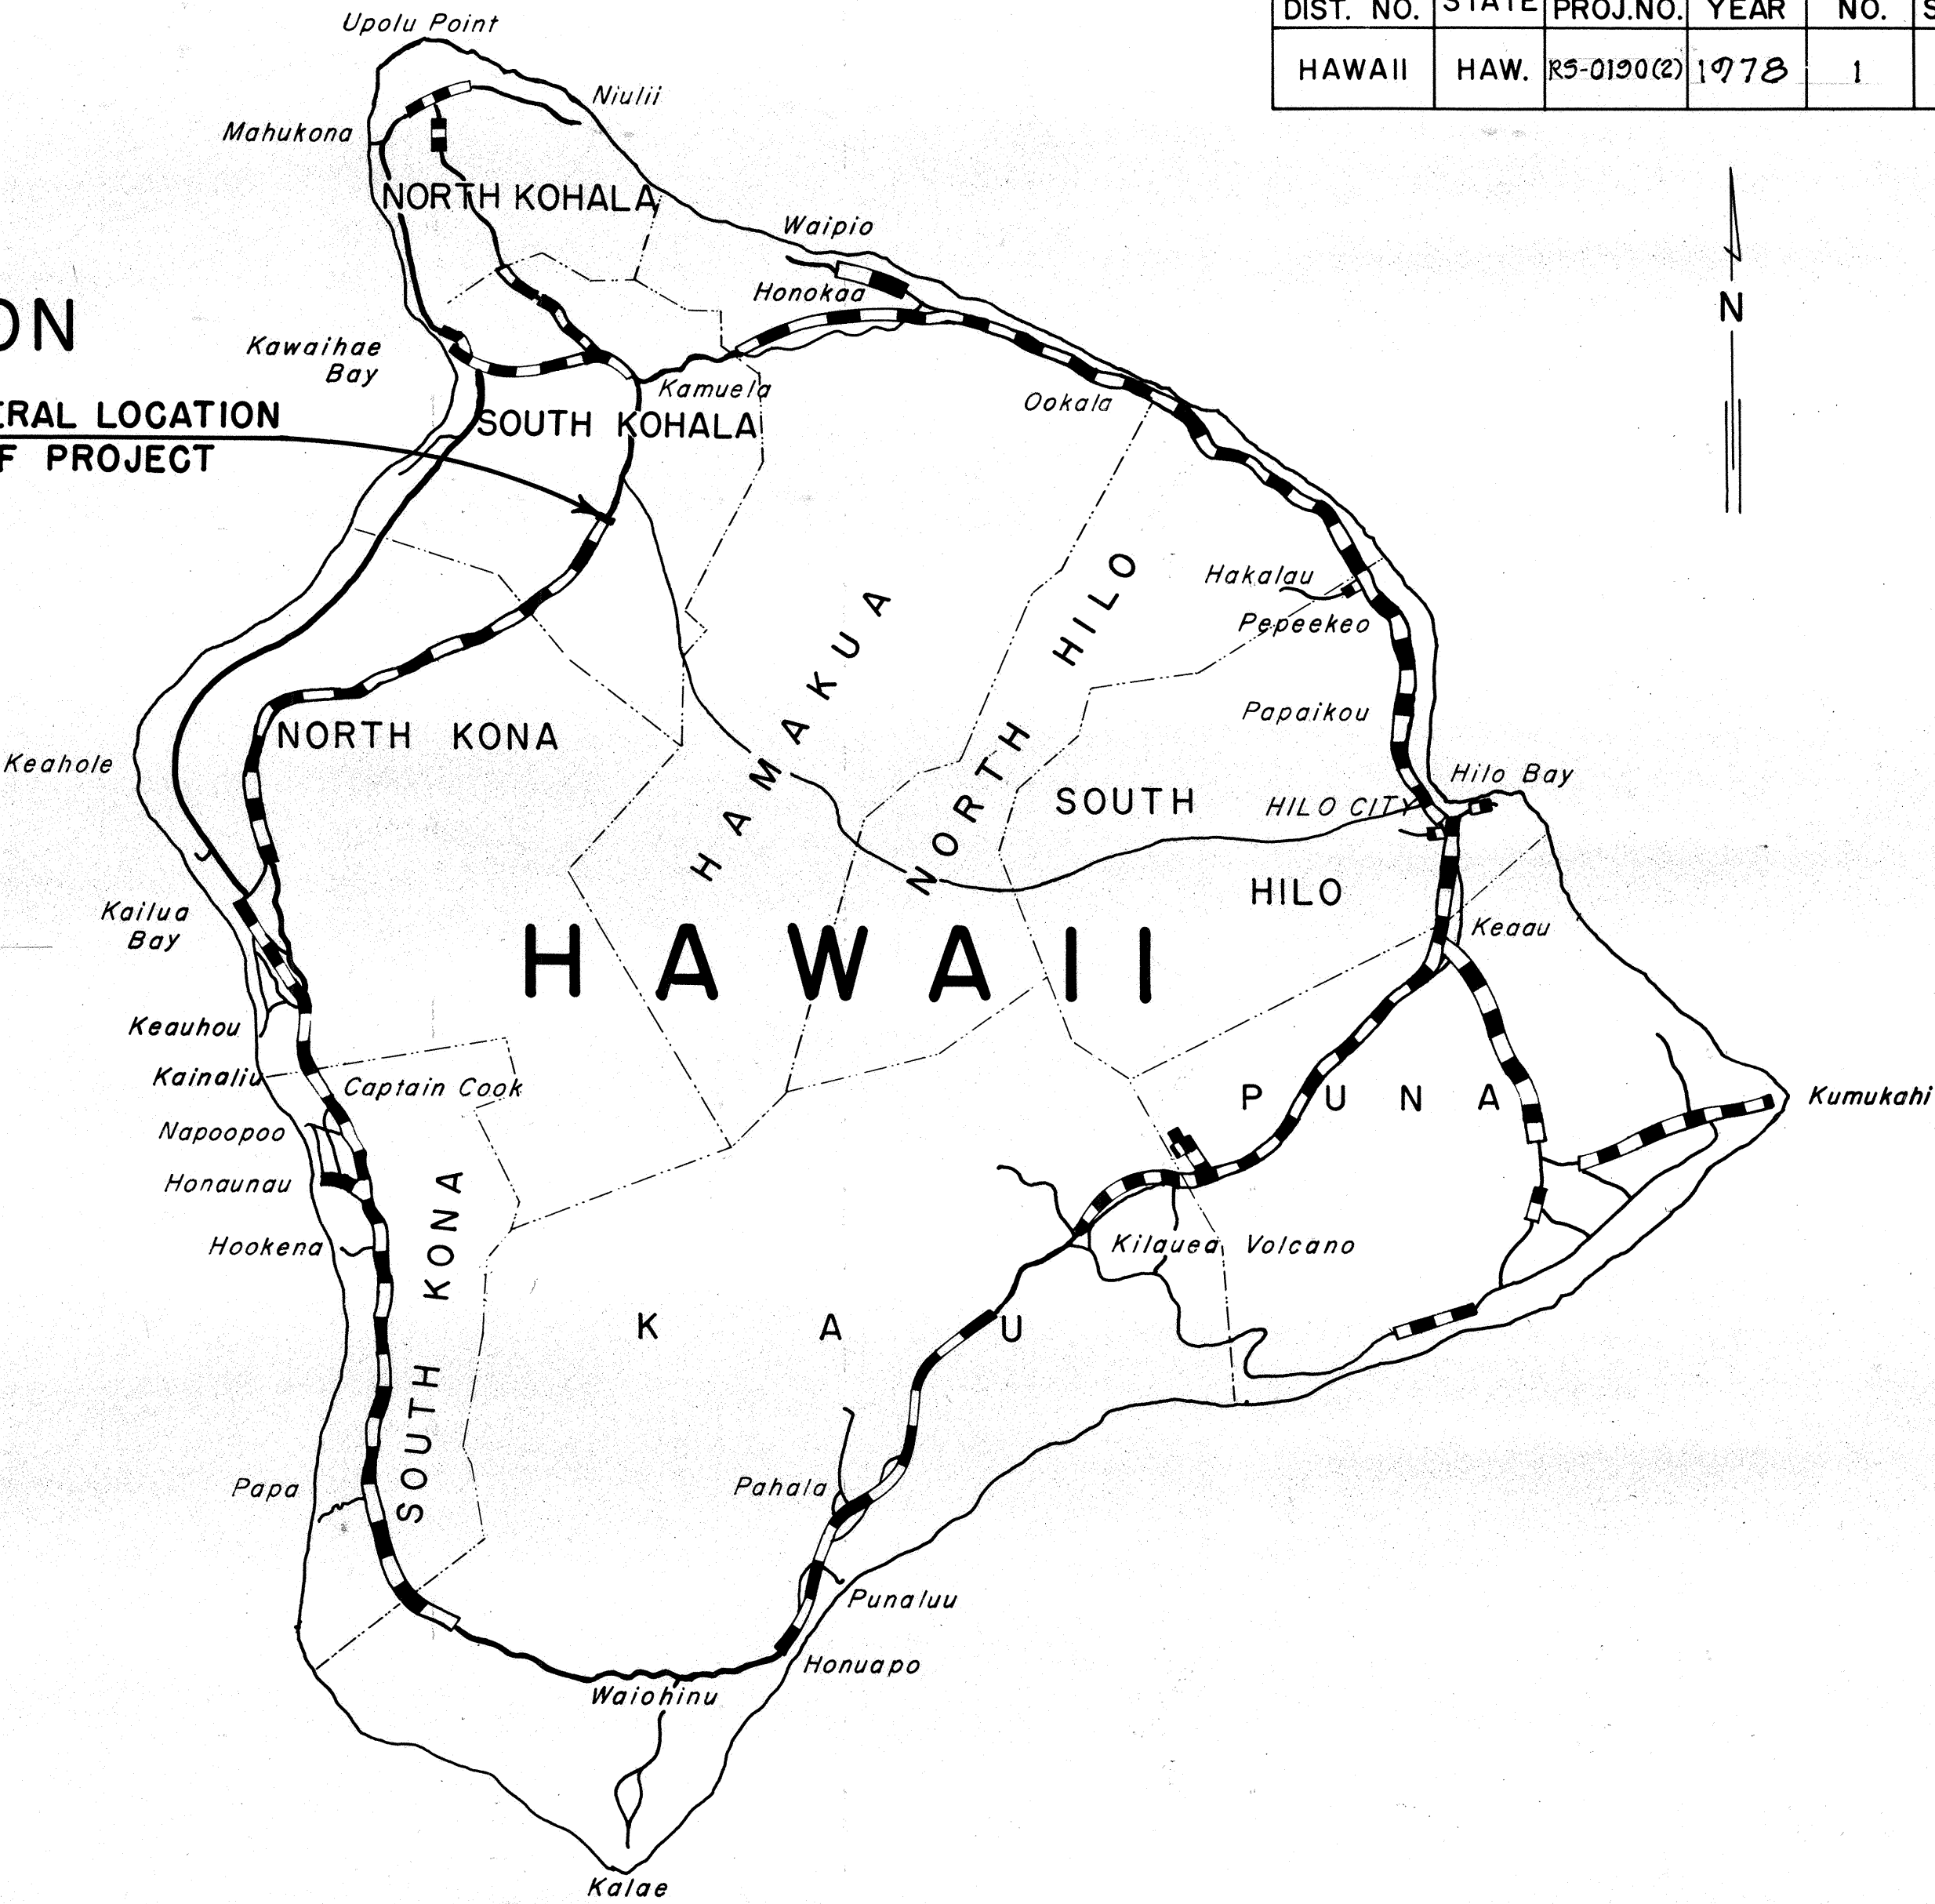

Federal Aid Projects Previously Constructed Or Under Construction

DESIGN CLASSIFICATION

ADT (1976) 1,050
DESIGN ADT (1996) 2,250
DHV 225
D 55/45
T 10%
K 10%

NOTE:
ALL CHANGES MADE DURING CONSTRUCTION HAVE BEEN INCORPORATED ON THESE PLANS IN RED EXCEPT CHANGES IN THE ORIGINAL THEORETICAL QUANTITIES.

Bruce C. Brocena


PROJECT ENGINEER

January 17, 1979

DATE

LENGTH OF PROJECT = 0.757 Mi.

DEPARTMENT OF TRANSPORTATION STATE OF HAWAII	
APPROVED:	
<i>R. Higashionna</i>	2/18/79
DIRECTOR OF TRANSPORTATION	DATE

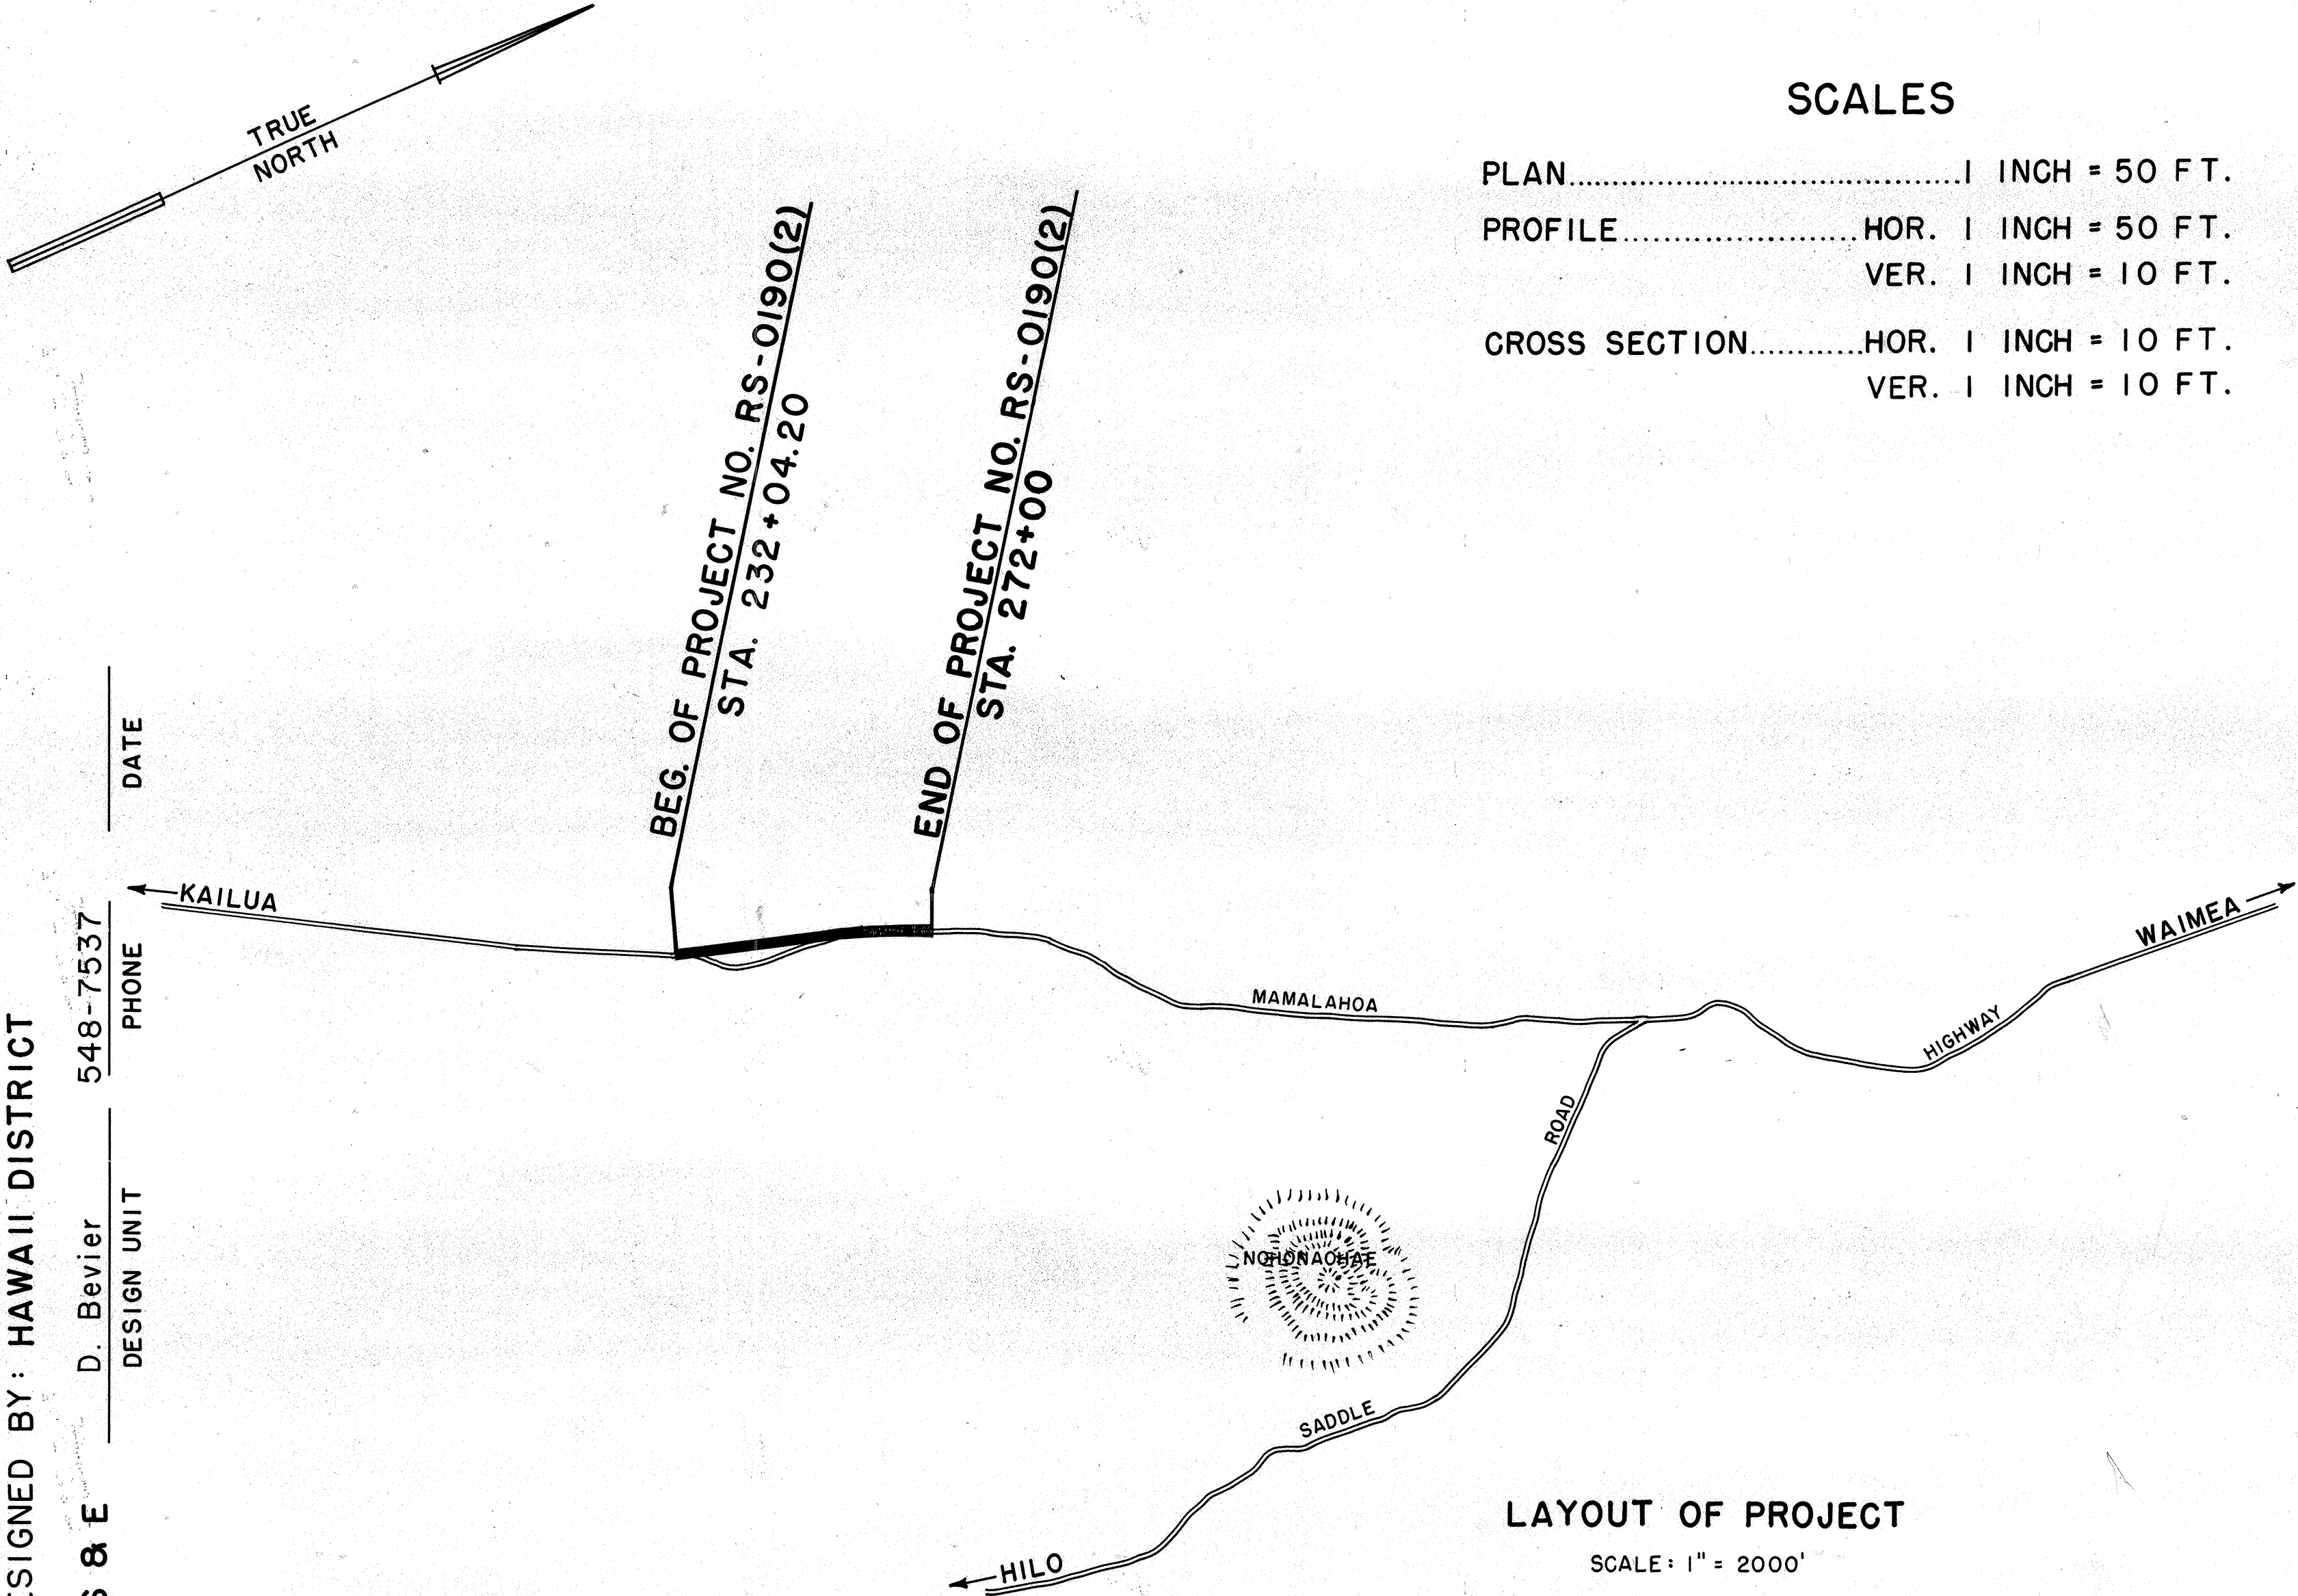

DESIGNED BY: HAWAII DISTRICT
PS & E
D. Bevier
DESIGN UNIT
PHONE 548-7537
DATE