
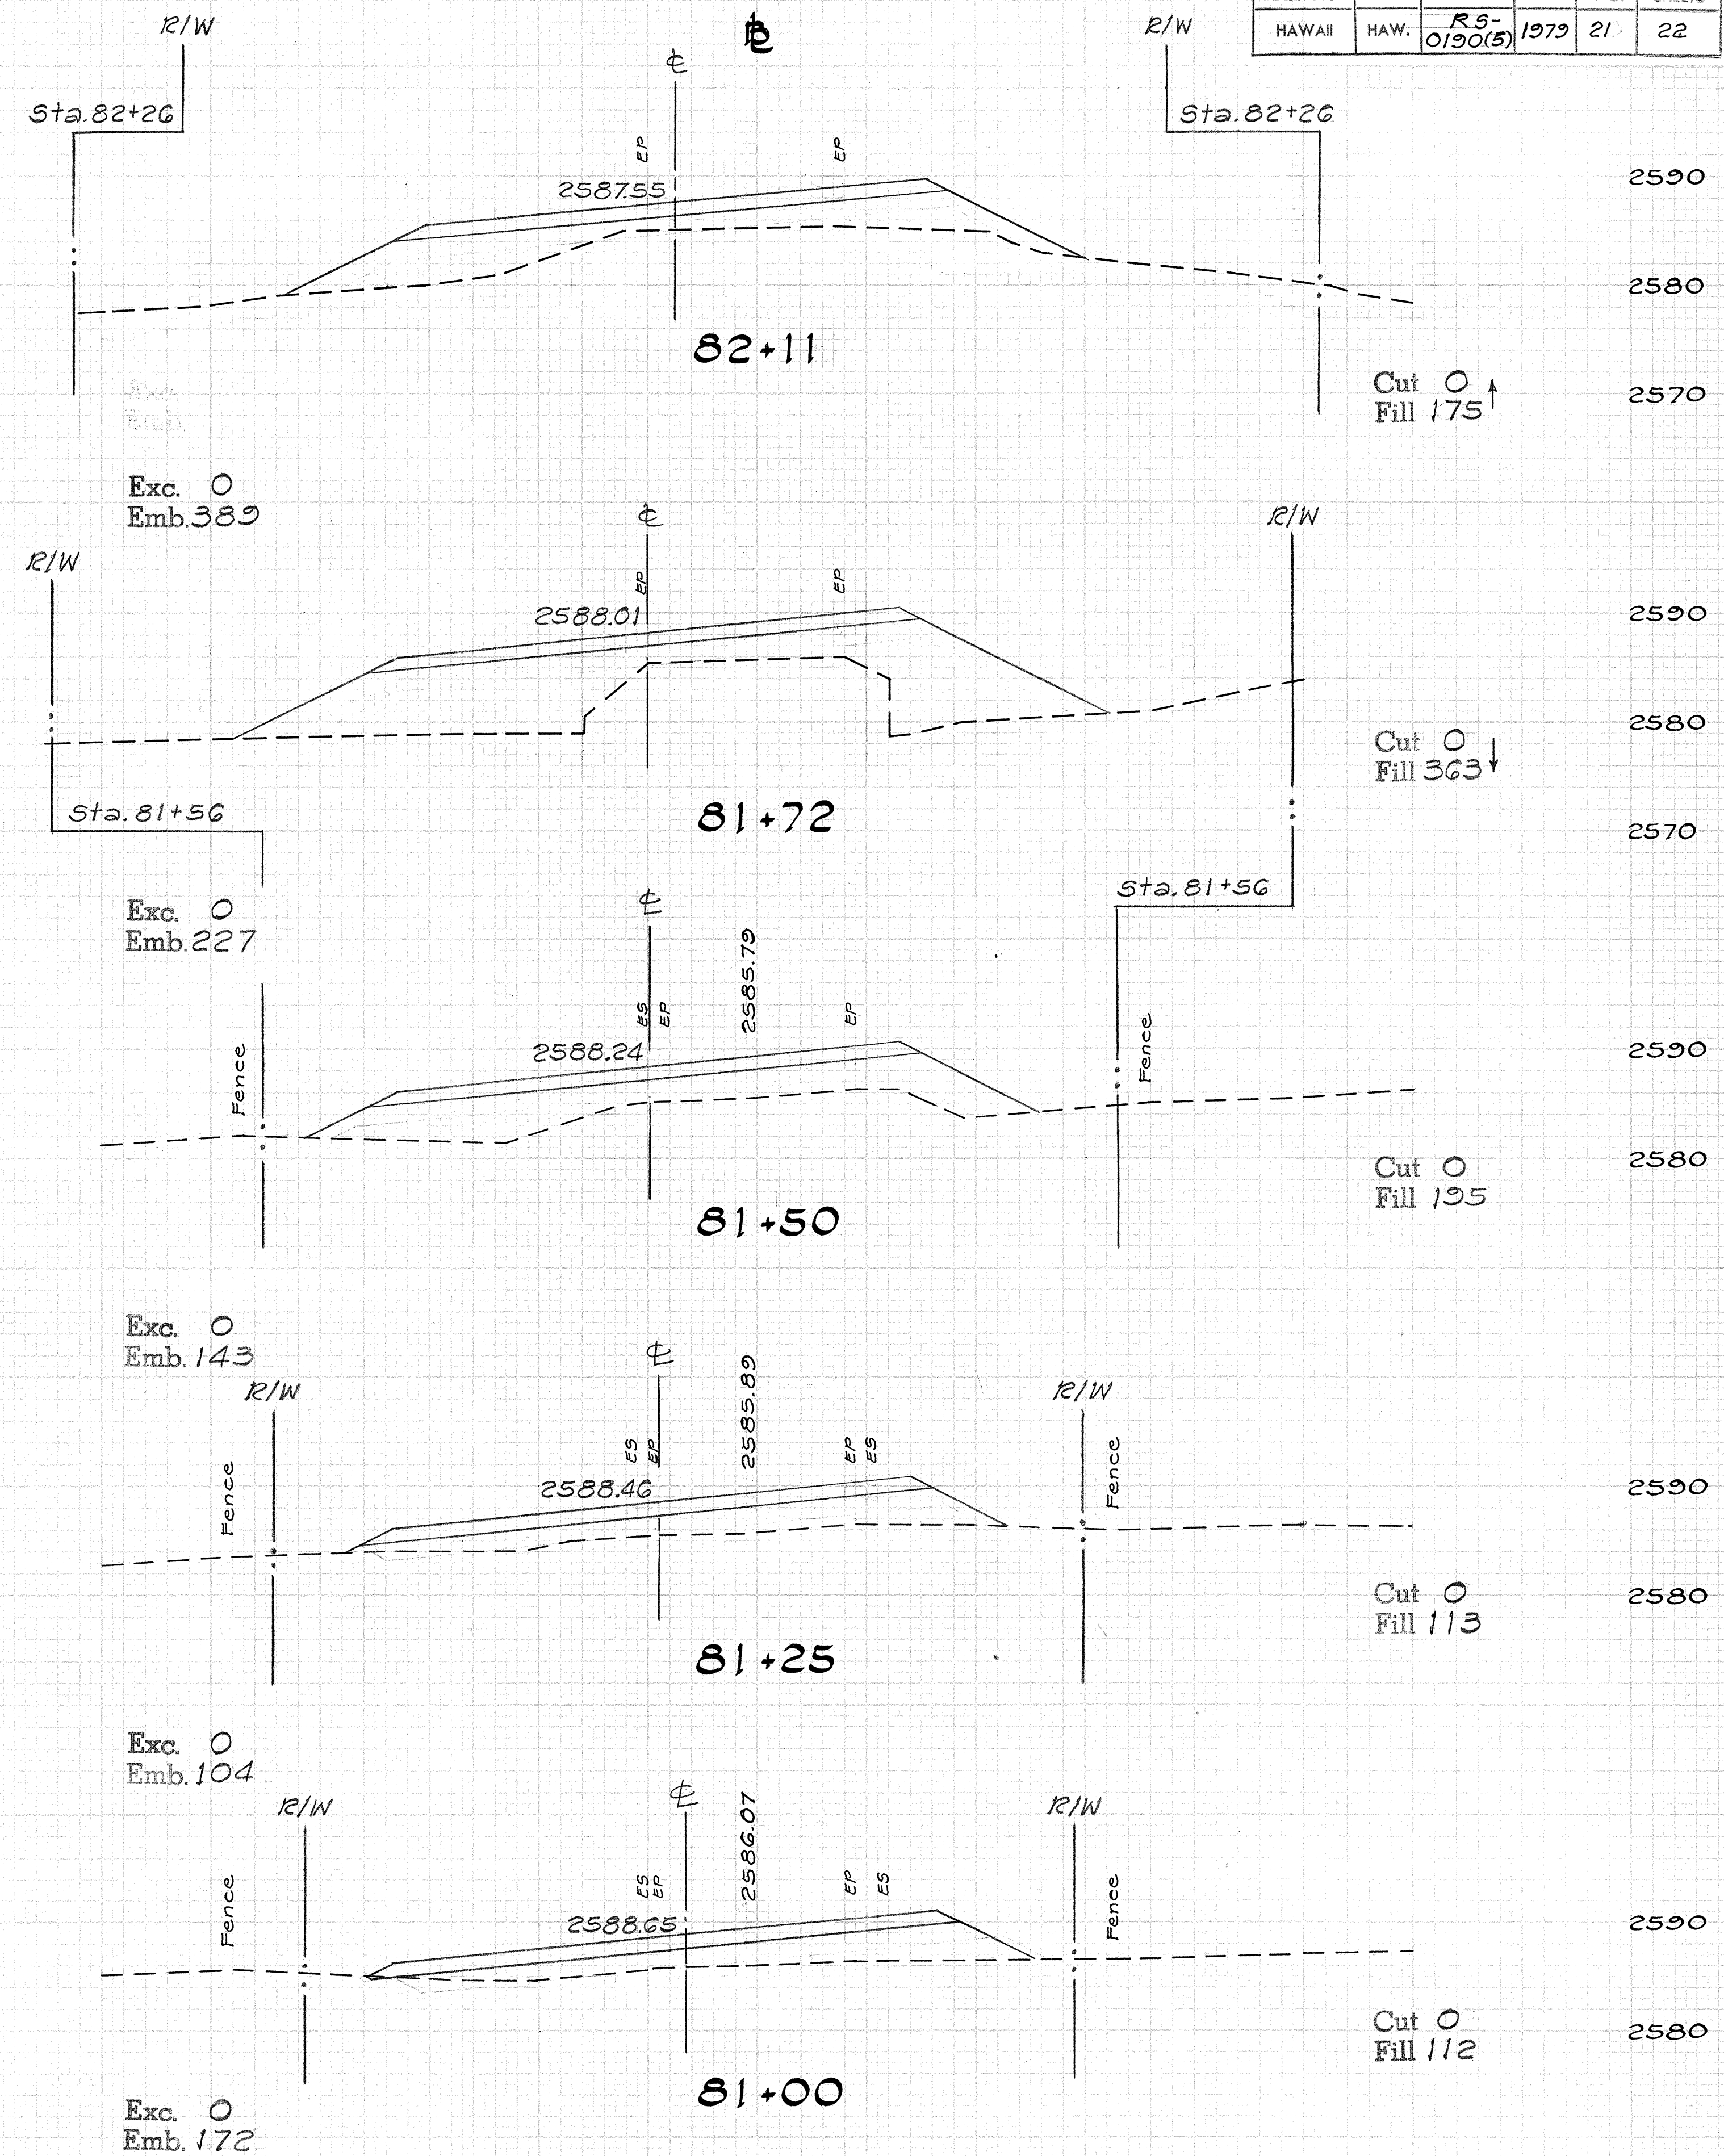


FED. ROAD DIST. NO.	STATE	PROJ. NO.	FISCAL YEAR	SHEET NO.	TOTAL SHEETS
HAWAII	HAW.	RS-0190(5)	1979	21	22

DATE	BY	FINAL SURVEY	PLOTTED	NOTE BOOK	AREA CHECKED

DATE	BY	ORIGINAL SURVEY	PLOTTED	NOTE BOOK	AREA CHECKED

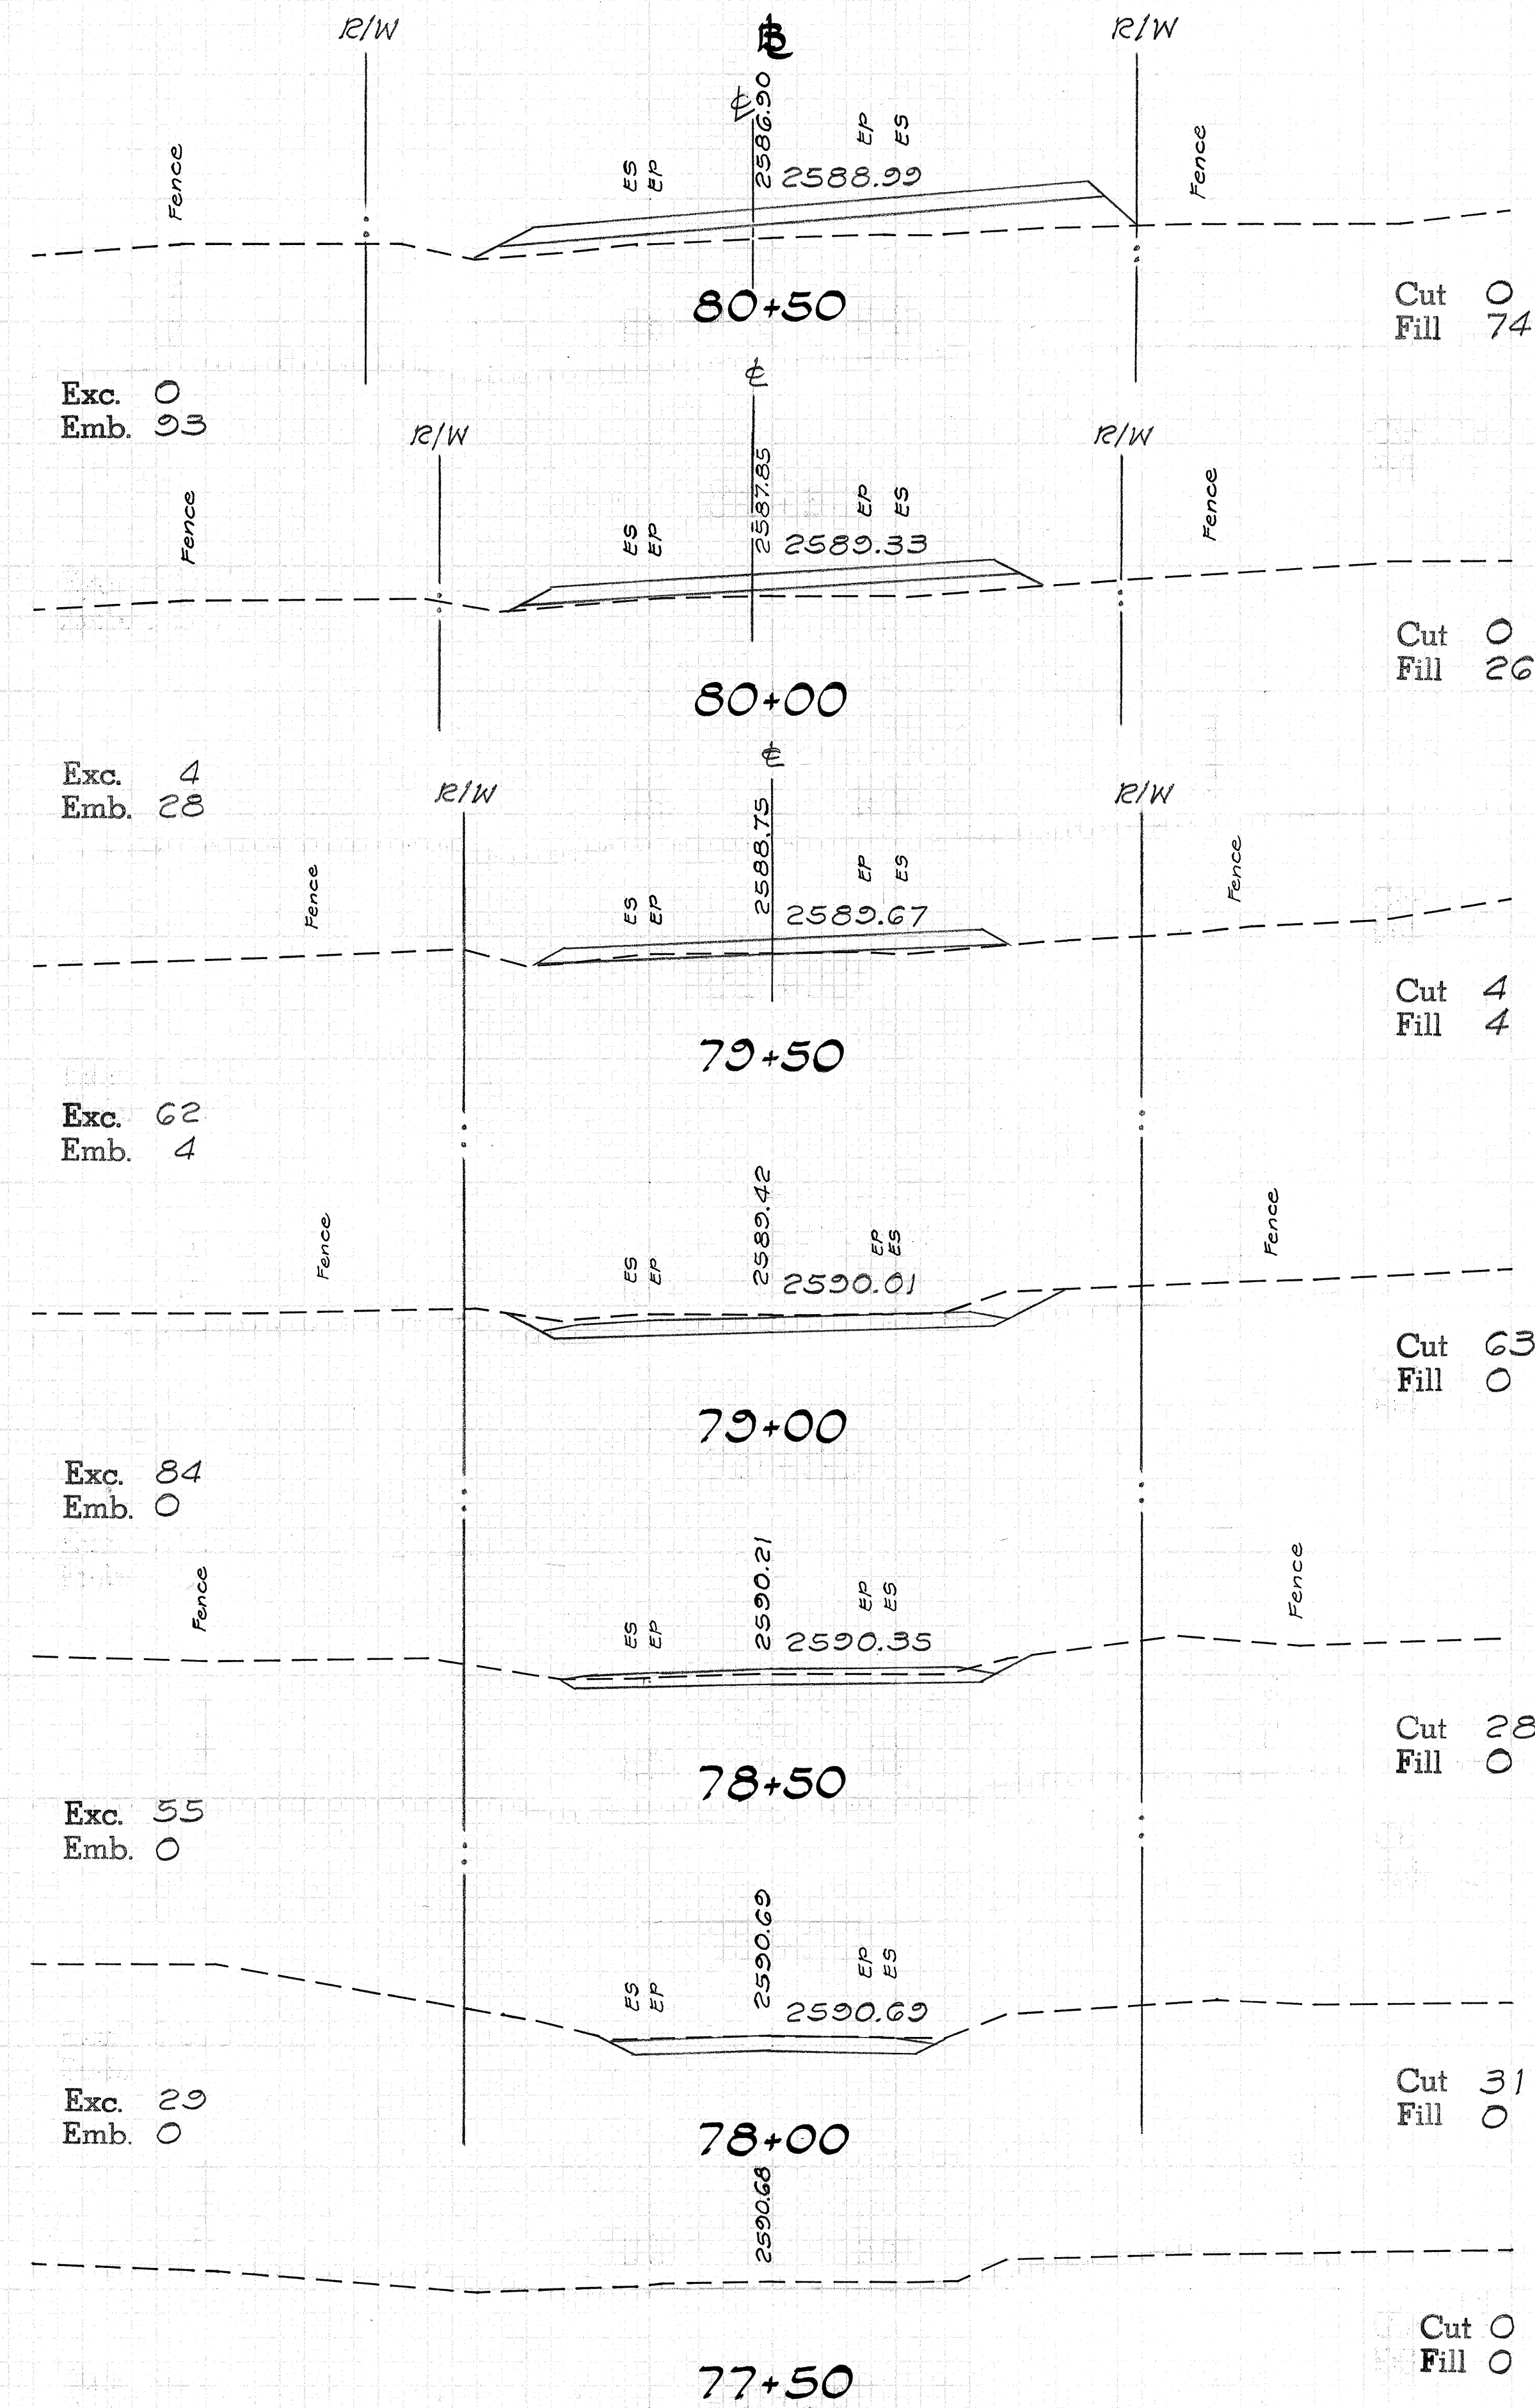

FED. ROAD DIST. NO.	STATE	PROJ. NO.	FISCAL YEAR	SHEET NO.	TOTAL SHEETS
HAWAII	HAW.	RS-0190(5)	1979	22	22

FINAL SURVEY	SURVEY	DATE
NOTE BOOK	PLATT	
NO.	AREAS CHECKED	

ORIGINAL SURVEY	SURVEY	DATE
NOTE BOOK	PLATT	
NO.	AREAS CHECKED	

