


INDEX TO DRAWINGS	
SHEET NO.	DESCRIPTION
1	TITLE SHEET
2	TYPICAL SECTION, S. E. DIAGRAM & MISCELLANEOUS DETAILS
3 - 4	PLAN & PROFILE
5 - 6	DRAINAGE PLAN & DETAILS
7 - 8	TYPICAL DETAILS
9 - 20	STANDARD DETAILS
21 - 22	CROSS - SECTIONS

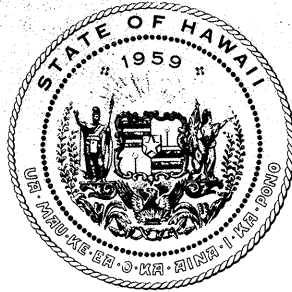


STATE OF HAWAII
DEPARTMENT OF TRANSPORTATION
HIGHWAYS DIVISION


"AS - BUILT" PLANS FOR
**HAWAII BELT ROAD
WIDENING AND REALIGNMENT
OF KAMAKOA II BRIDGE**
FEDERAL AID PROJECT NO. RS-0190(5)
DISTRICT OF SOUTH KOHALA
ISLAND OF HAWAII

SCALES

PLAN	1 INCH = 20 FT.
PROFILE	HOR. 1 INCH = 20 FT. VER. 1 INCH = 2.5 FT.
CROSS SECTION	HOR. 1 INCH = 10 FT. VER. 1 INCH = 10 FT.

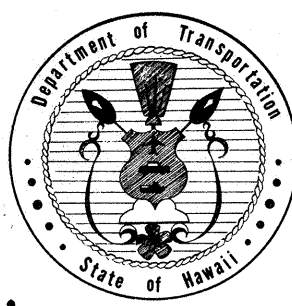

PROJECT LOCATION

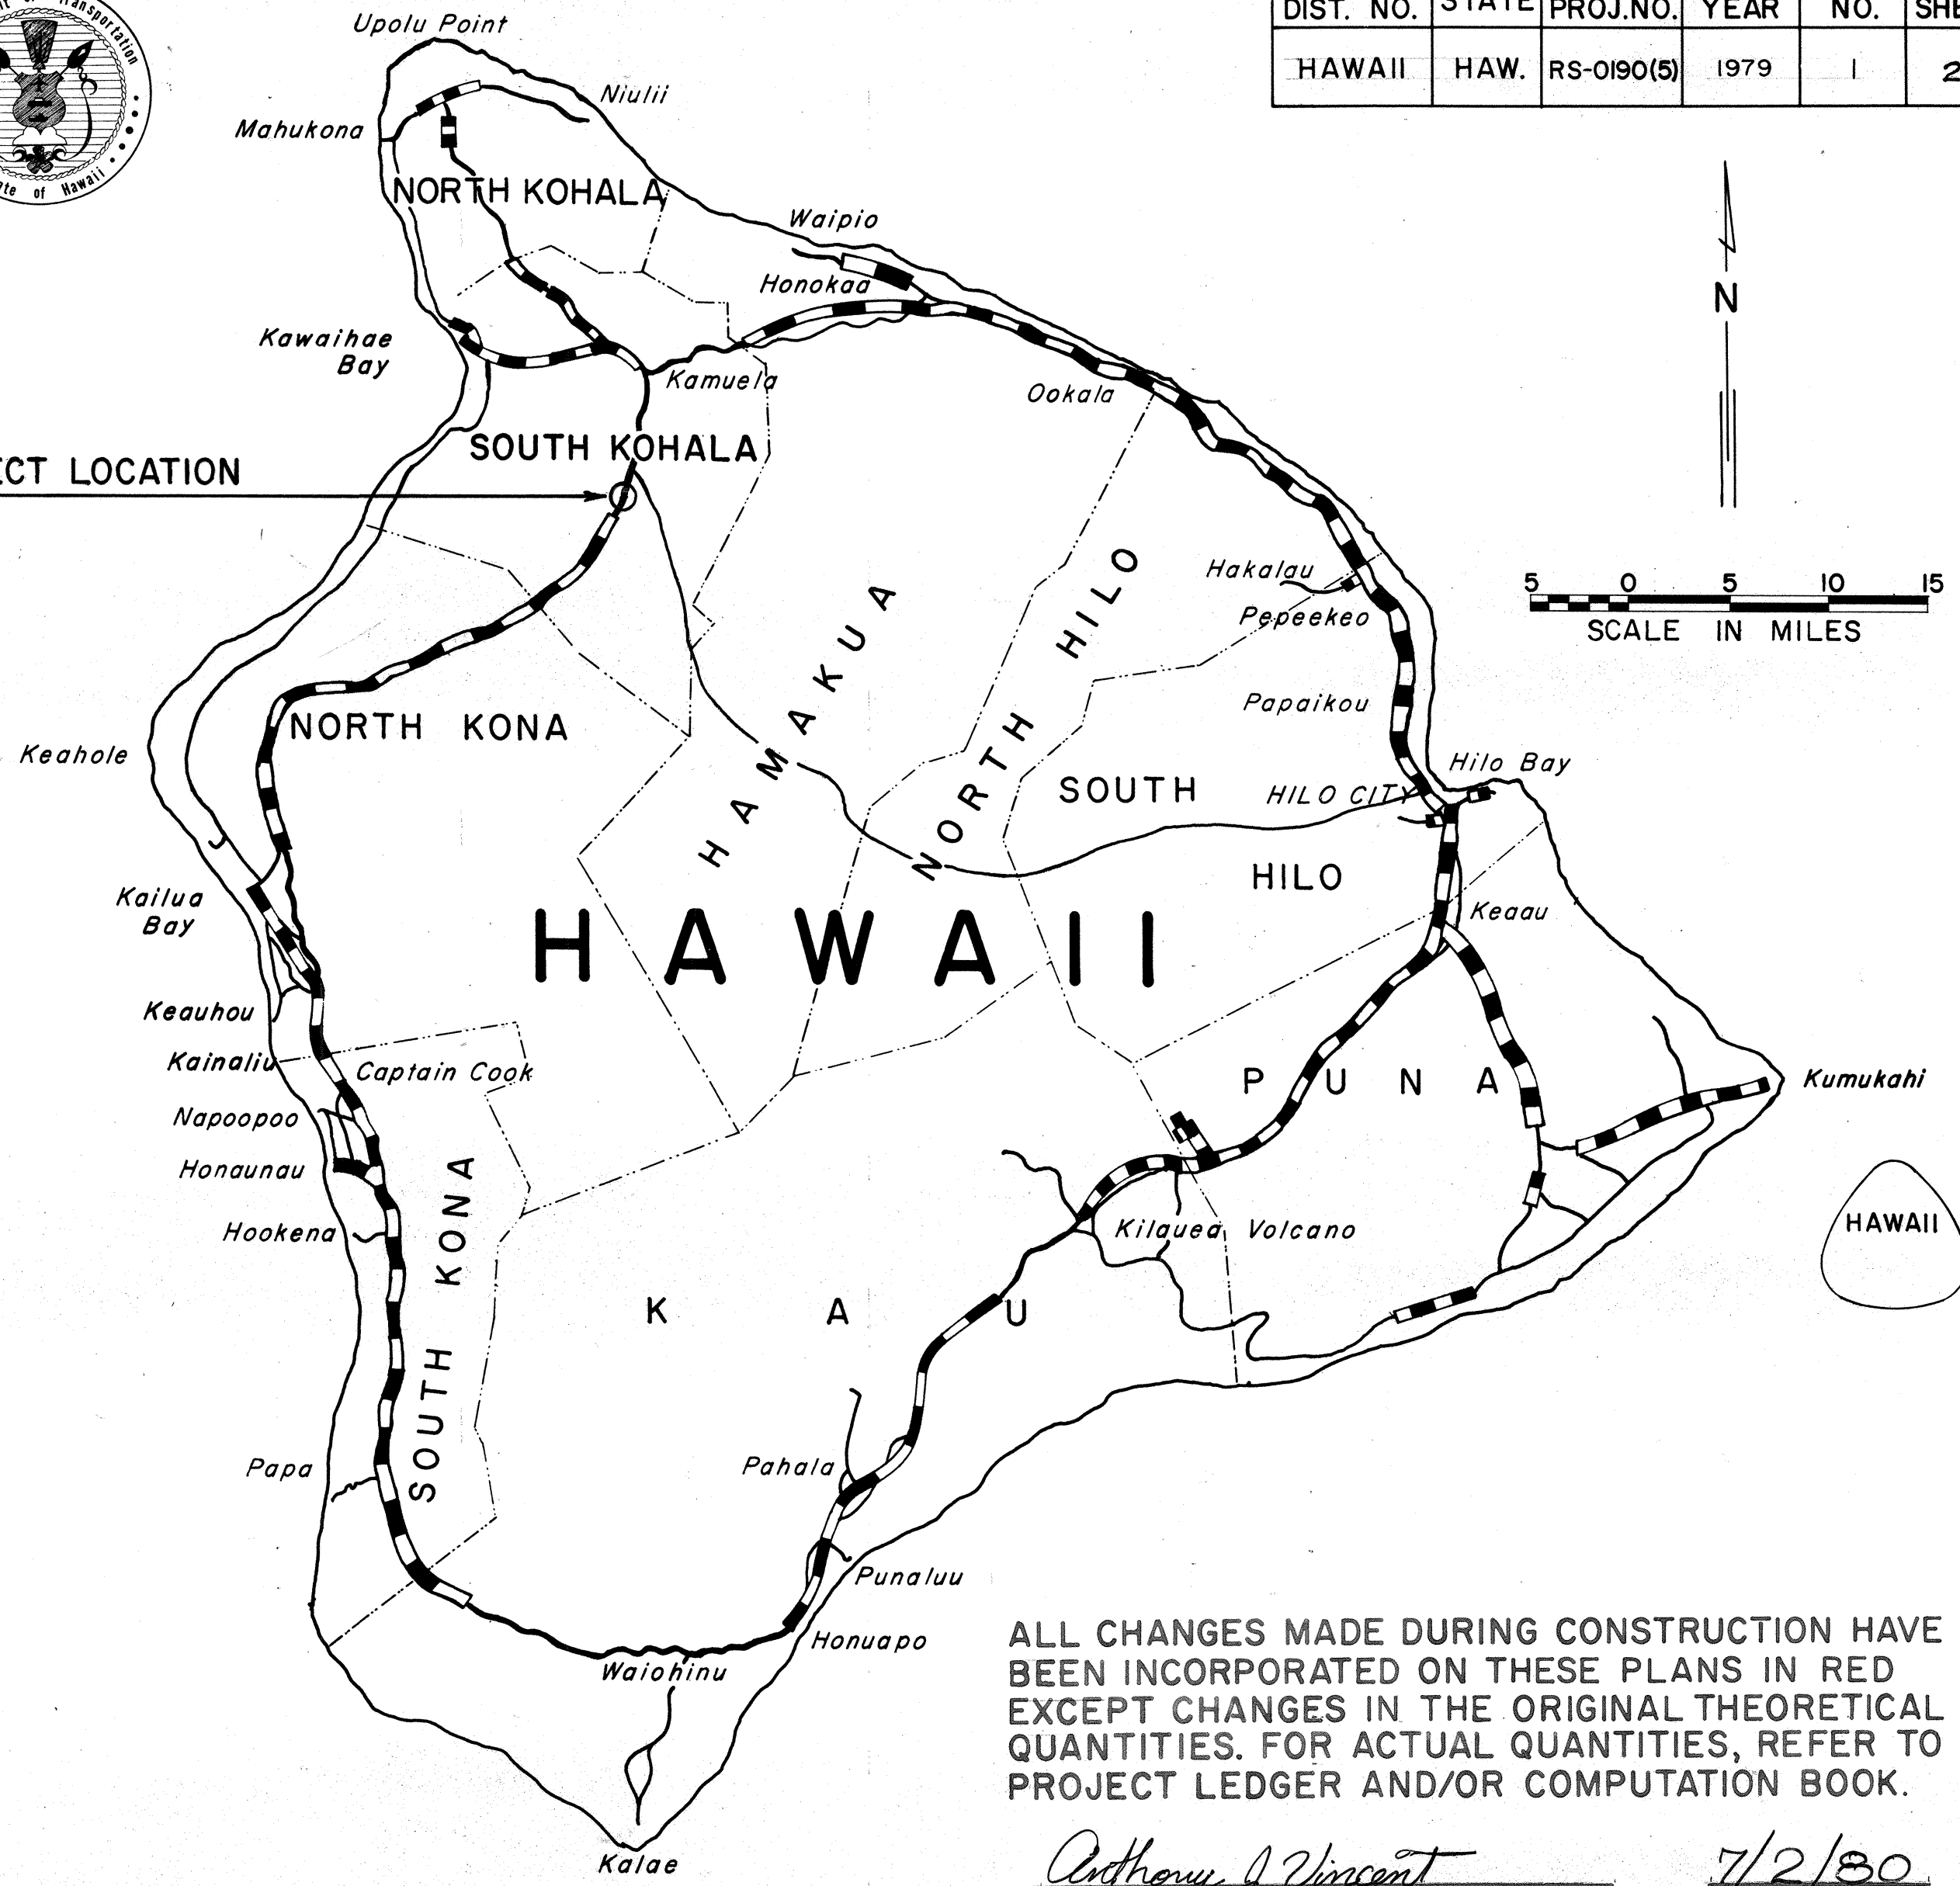

ALL CHANGES MADE DURING CONSTRUCTION HAVE BEEN INCORPORATED ON THESE PLANS IN RED EXCEPT CHANGES IN THE ORIGINAL THEORETICAL QUANTITIES. FOR ACTUAL QUANTITIES, REFER TO PROJECT LEDGER AND/OR COMPUTATION BOOK.

Anthony J. Vincent
RESIDENT ENGINEER
7/2/80
DATE

GENERAL LOCATION

Federal Aid Projects Previously Constructed Or Under Construction


DESIGN CLASSIFICATION

CURRENT ADT (1978)	1100
DESIGN ADT (1998)	5700
DHV	240
D	55/45
T	13%
T24	10%

CONTRACT NO. : 10874
CONTRACTOR : J. W. GLOVER, LTD.

DEPARTMENT OF TRANSPORTATION STATE OF HAWAII	
APPROVED: <i>James R. Carras</i> DIR. OF TRANSPORTATION	8/22/79 DATE

HAWAII DISTRICT
DESIGNED BY *Allen Nishimura* 549-7537 July, 1979
P. S. & E. BY PHONE DATE

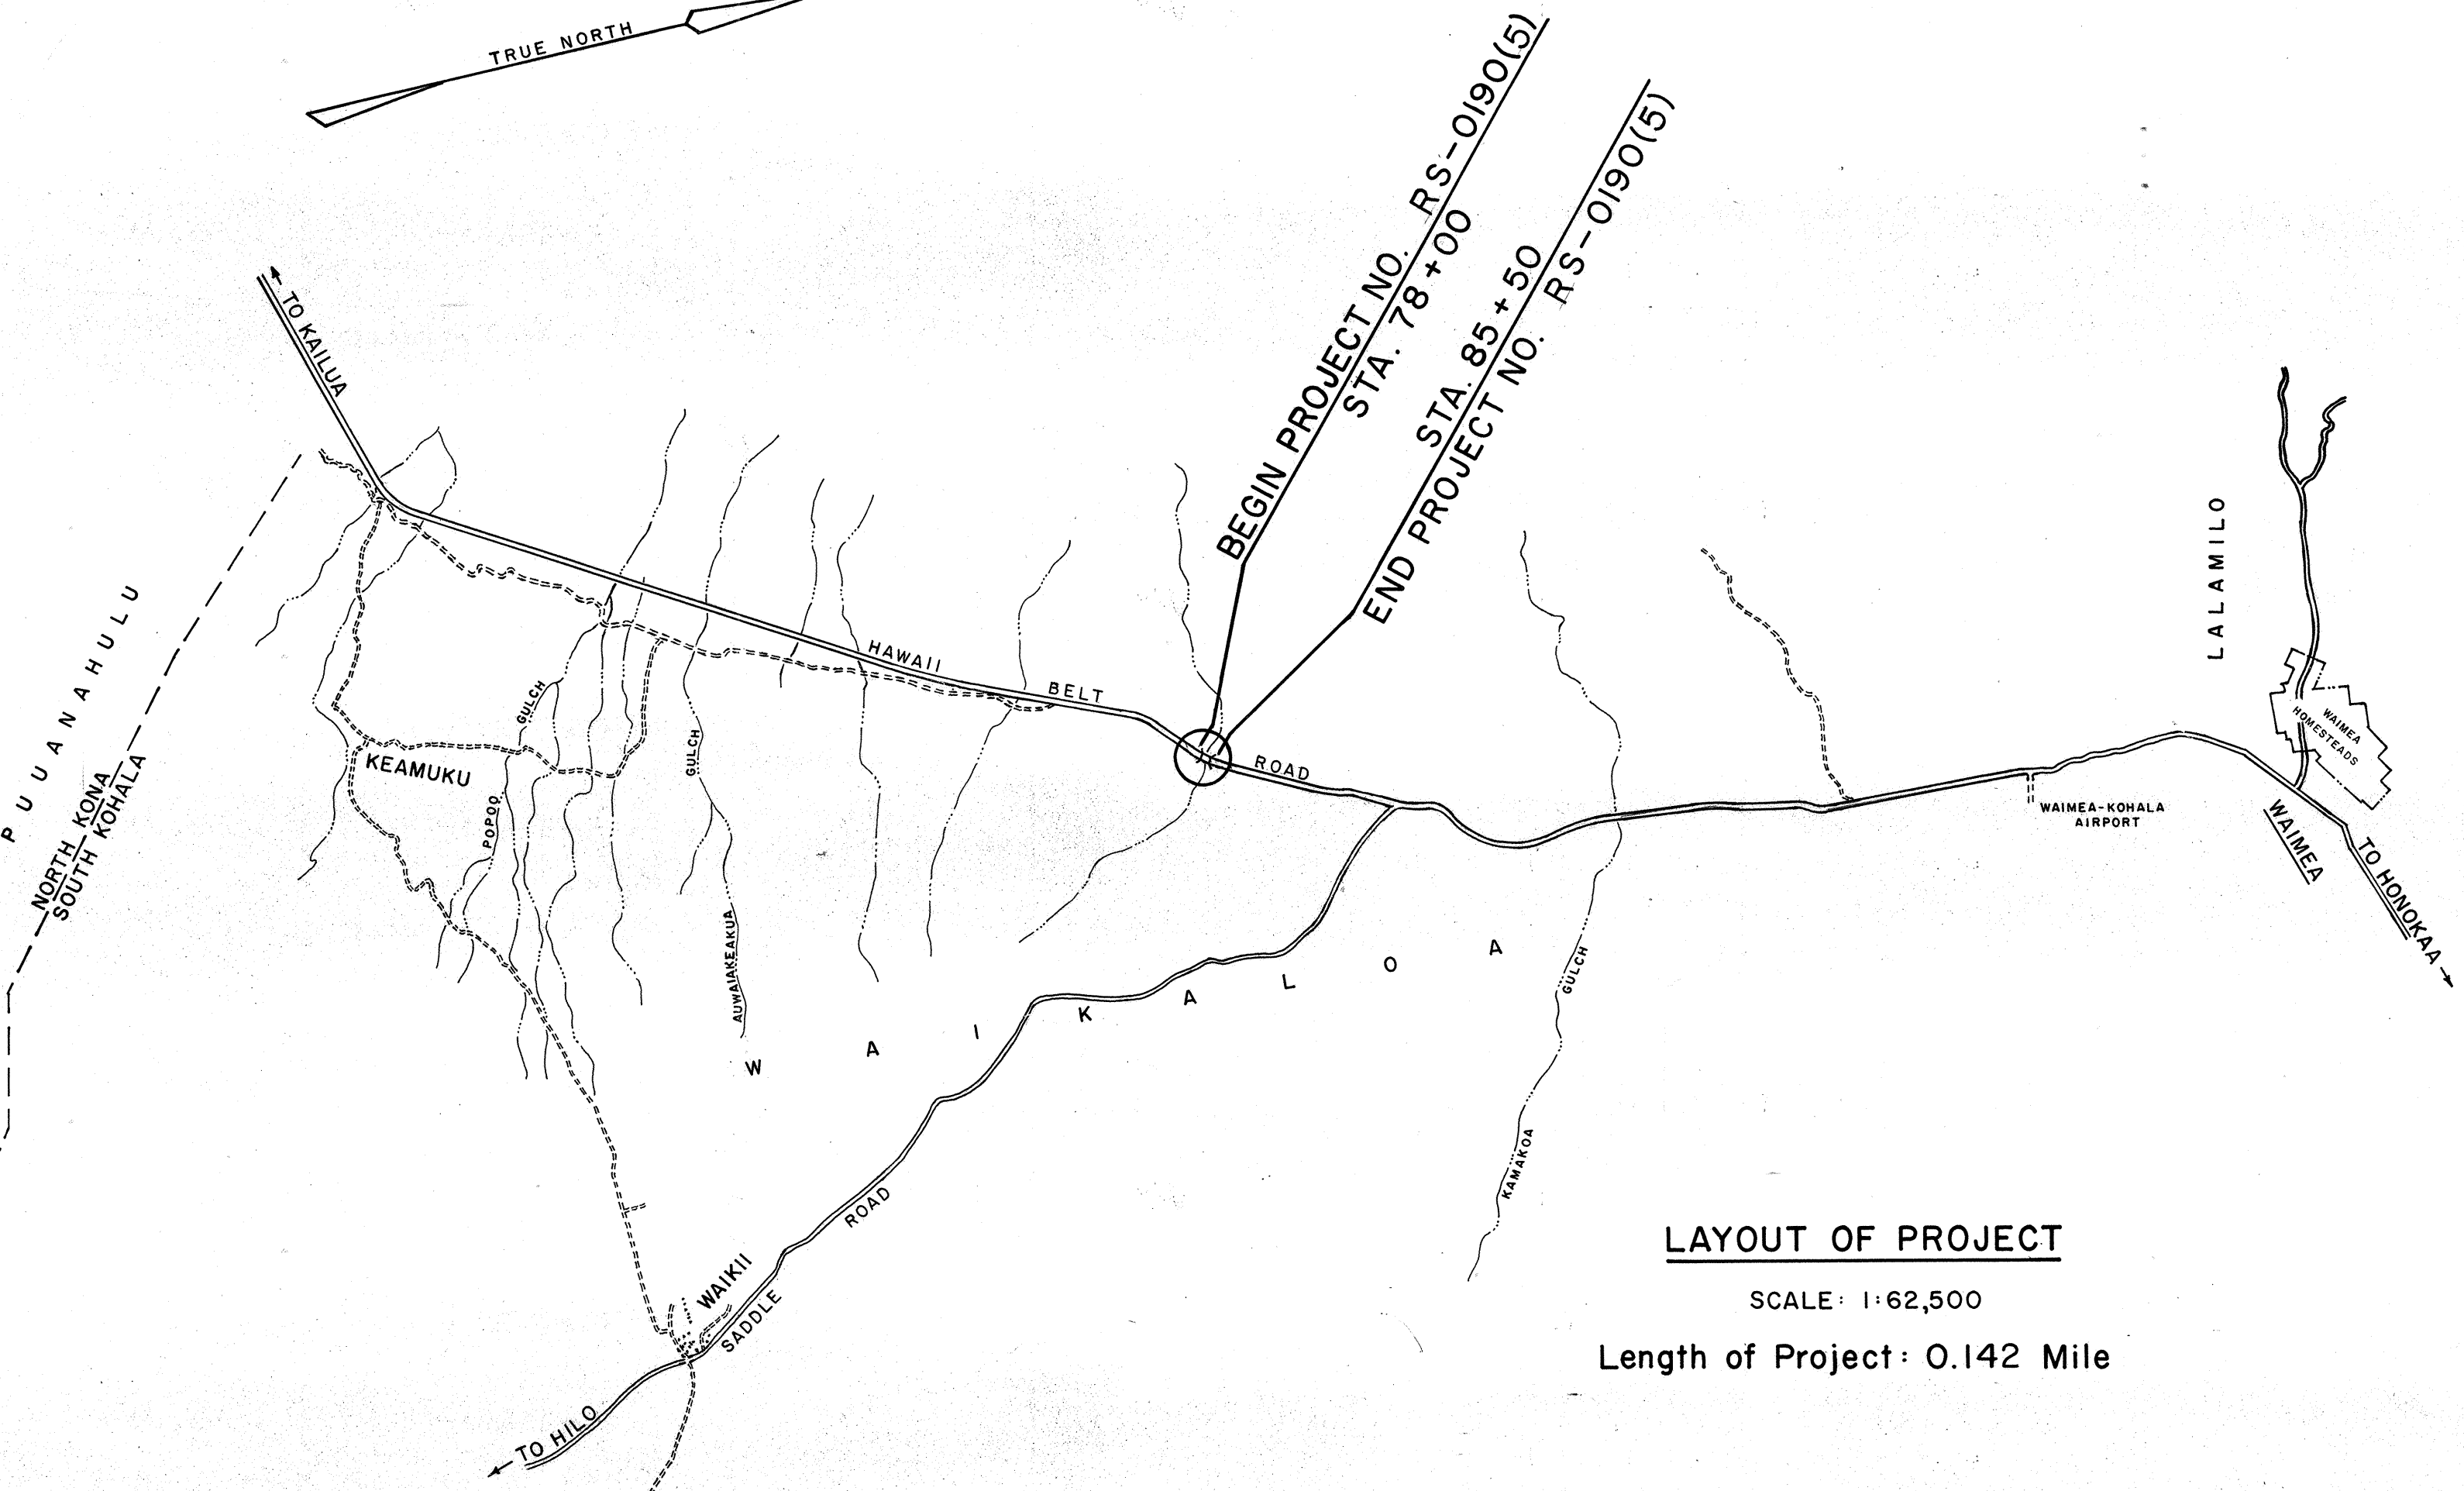

LAYOUT OF PROJECT

SCALE: 1"=62,500
Length of Project: 0.142 Mile