



FED. ROAD DIST. NO.	STATE	FED. AID PROJ. NO.	FISCAL YEAR	SHEET NO.	TOTAL SHEETS
HAWAII	HAW.	RS-0190(5)	1979	2	22

GENERAL NOTES:


- Guard Rail Posts over culverts shall be installed in mechanically or hand dug holes, backfilled and compacted.
- Existing metal guard rails and posts on approaches to Kamakoa II Bridge shall be removed.
- All signs, guardrails and markers, designated to be removed shall become the property of the Contractor and shall be removed from the project site. (Incidental to the various contract items.)

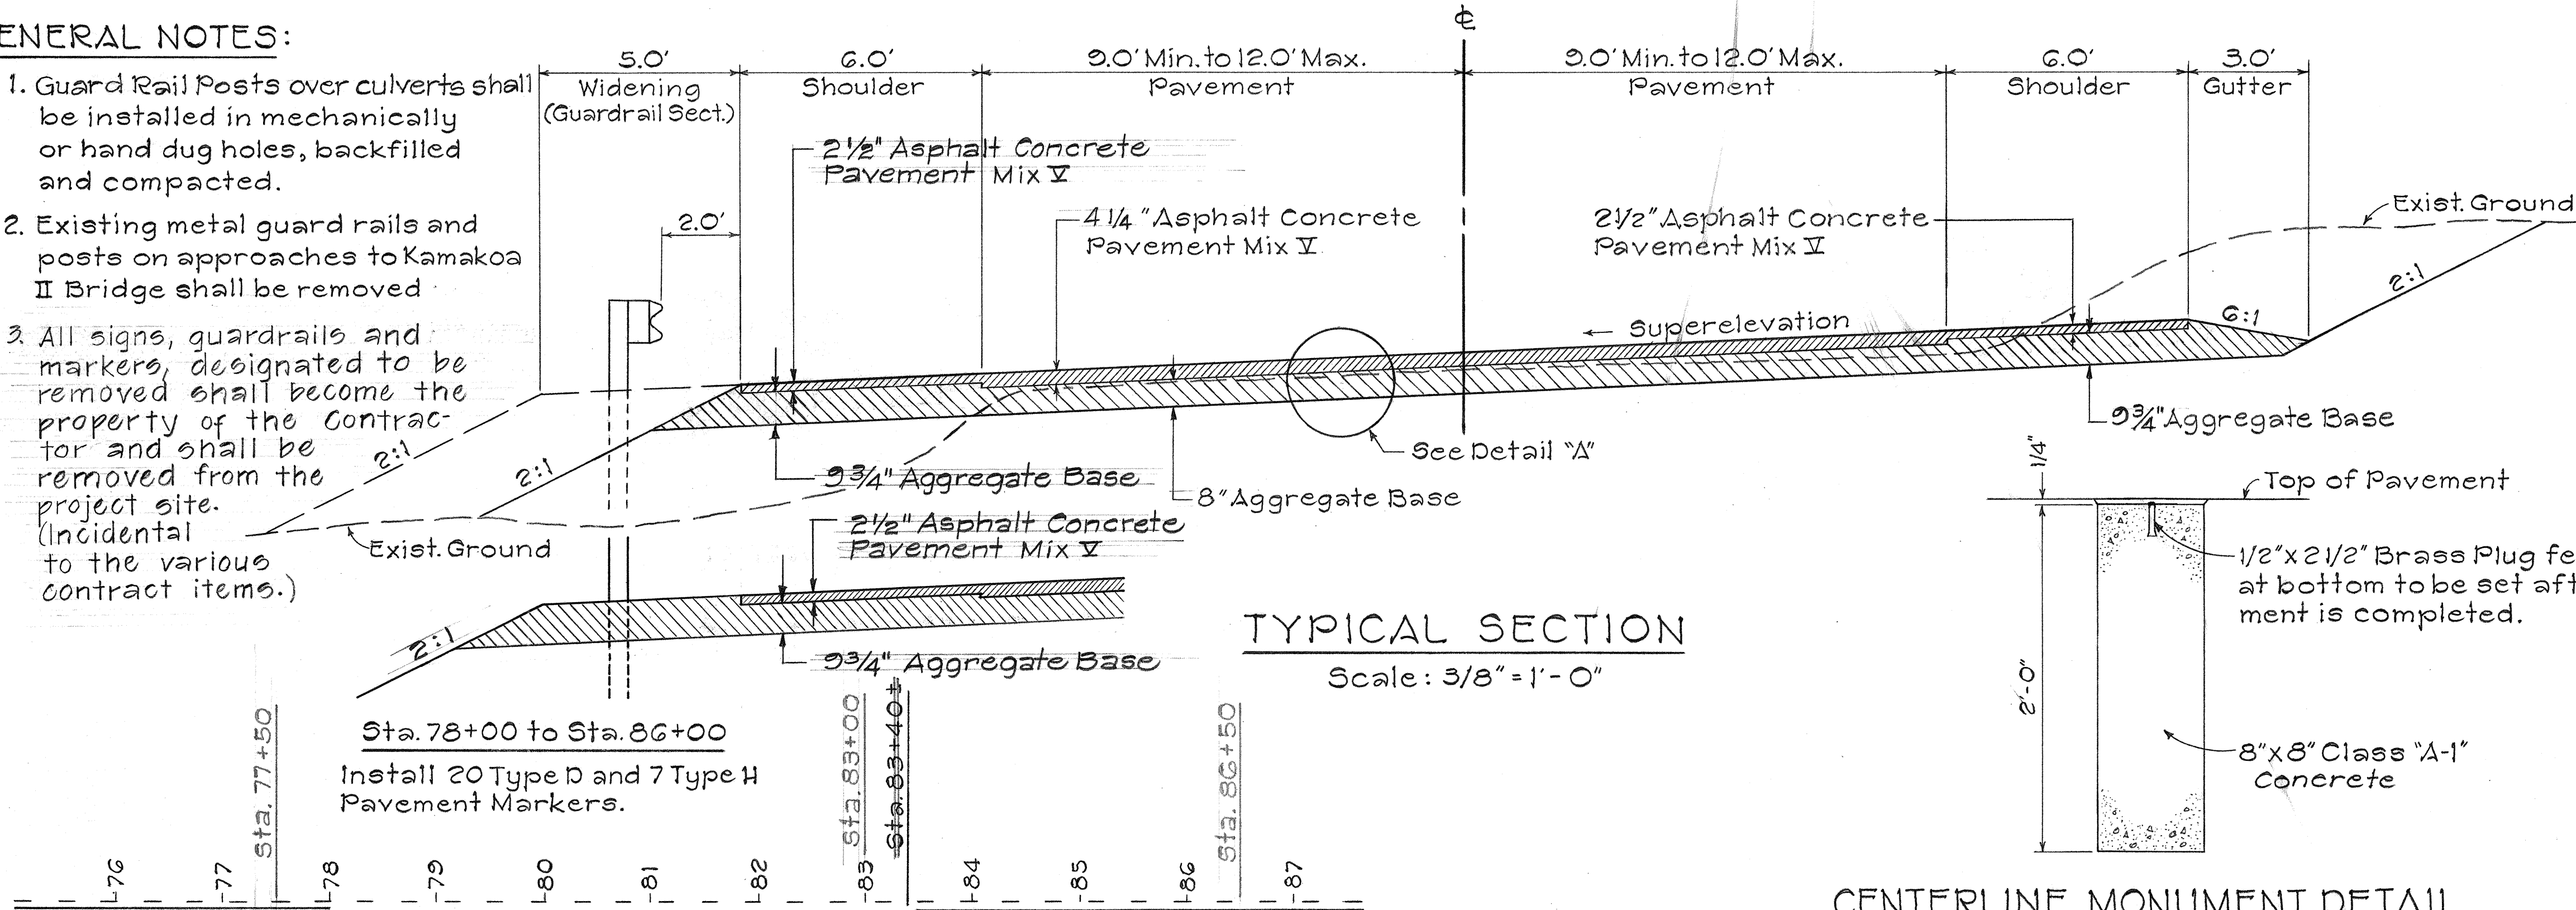


TYPICAL SECTION
Scale: 3/8" = 1'-0"

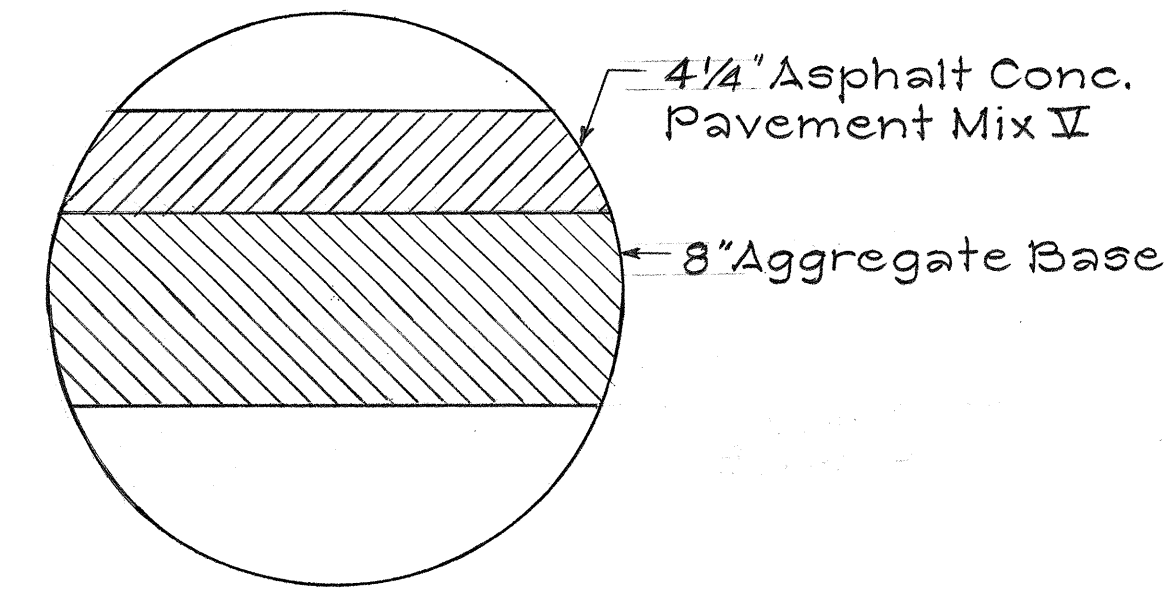

DETAIL "A"
Scale: 1 1/2" = 1'-0"

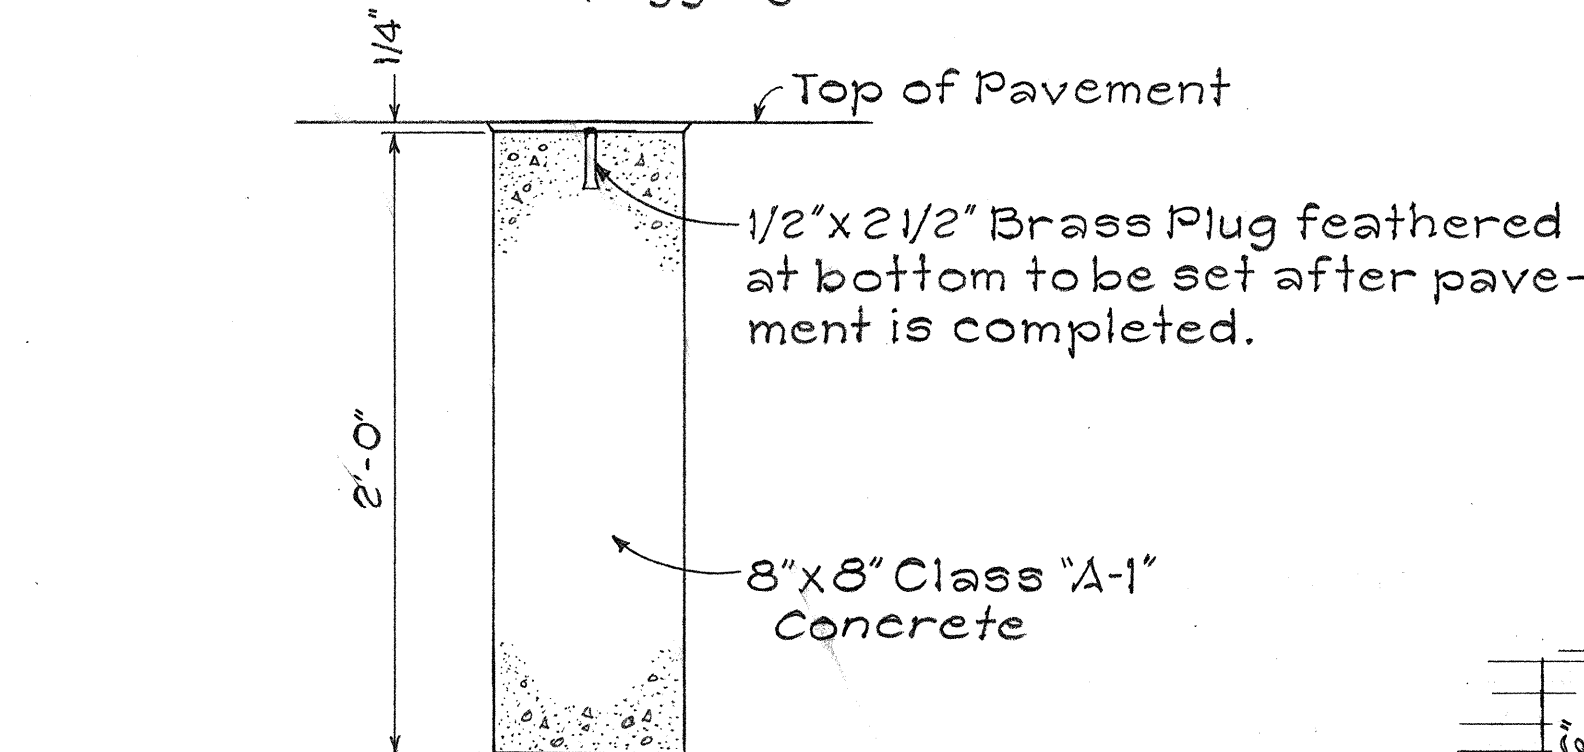


CENTERLINE MONUMENT DETAIL
Scale: 1 1/2" = 1'-0"

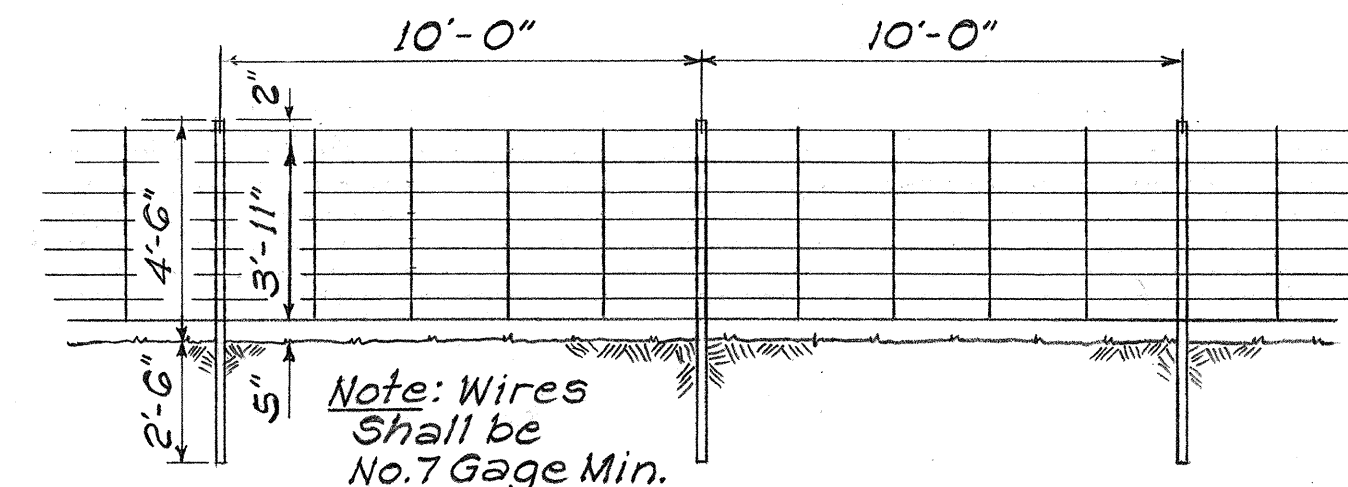

DETAIL OF WOVEN WIRE FENCE
Scale: 1/4" = 1'-0"

CENTERLINE MARKING SCHEMATIC
NOT TO SCALE

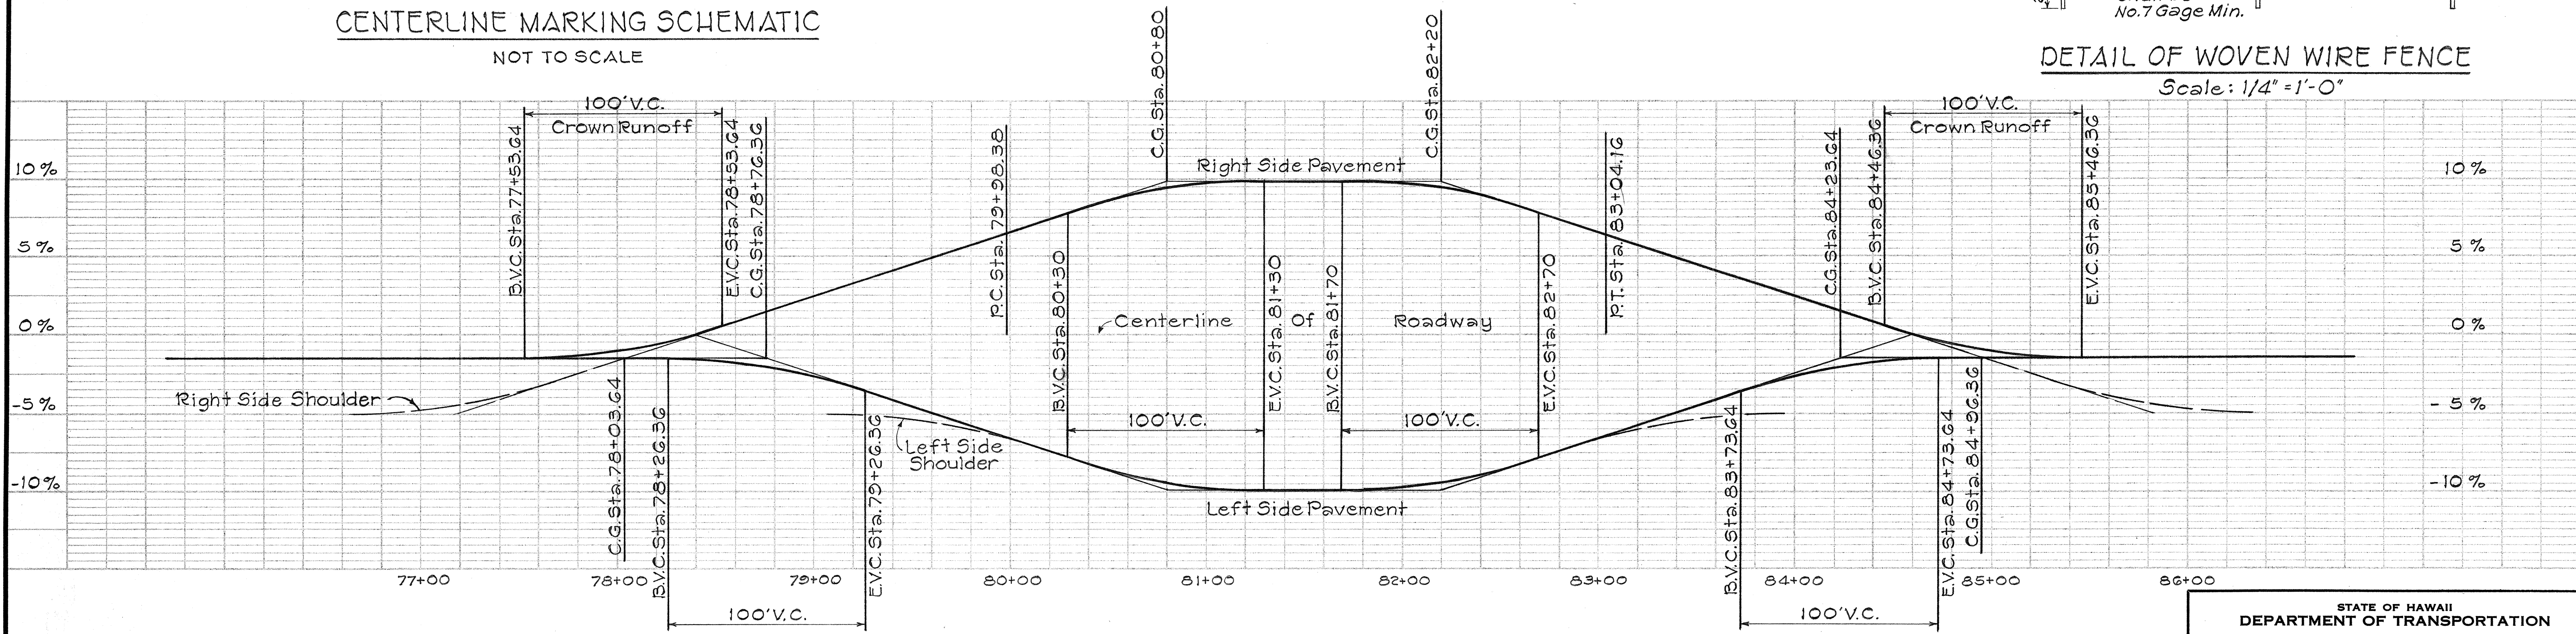

SUPERELEVATION DIAGRAM
(CROSS SLOPES IN PERCENT)

STATE OF HAWAII

DEPARTMENT OF TRANSPORTATION

HIGHWAYS DIVISION

TYPICAL SECTION

KAMAKOA II BRIDGE

F.A. PROJ. NO. RS-0190(5)

KEAMUKU SECTION

SOUTH KOHALA, HAWAII

Scale: As Noted

Date: July, 1979

SHEET No. 1 OF 1 SHEETS

SURVEY PLOTTED BY	DATE
DRAWN BY	
DESIGNED BY	
QUANTITIES BY	
CHECKED BY	
ORIGINAL PLAN	
NOTE BOOK	
No.	