



FED. ROAD DIST. NO.	STATE	PROJ. NO.	FISCAL YEAR	SHEET NO.	TOTAL SHEETS
HAWAII	HAW.	R5-0190(7)	1986	6	28

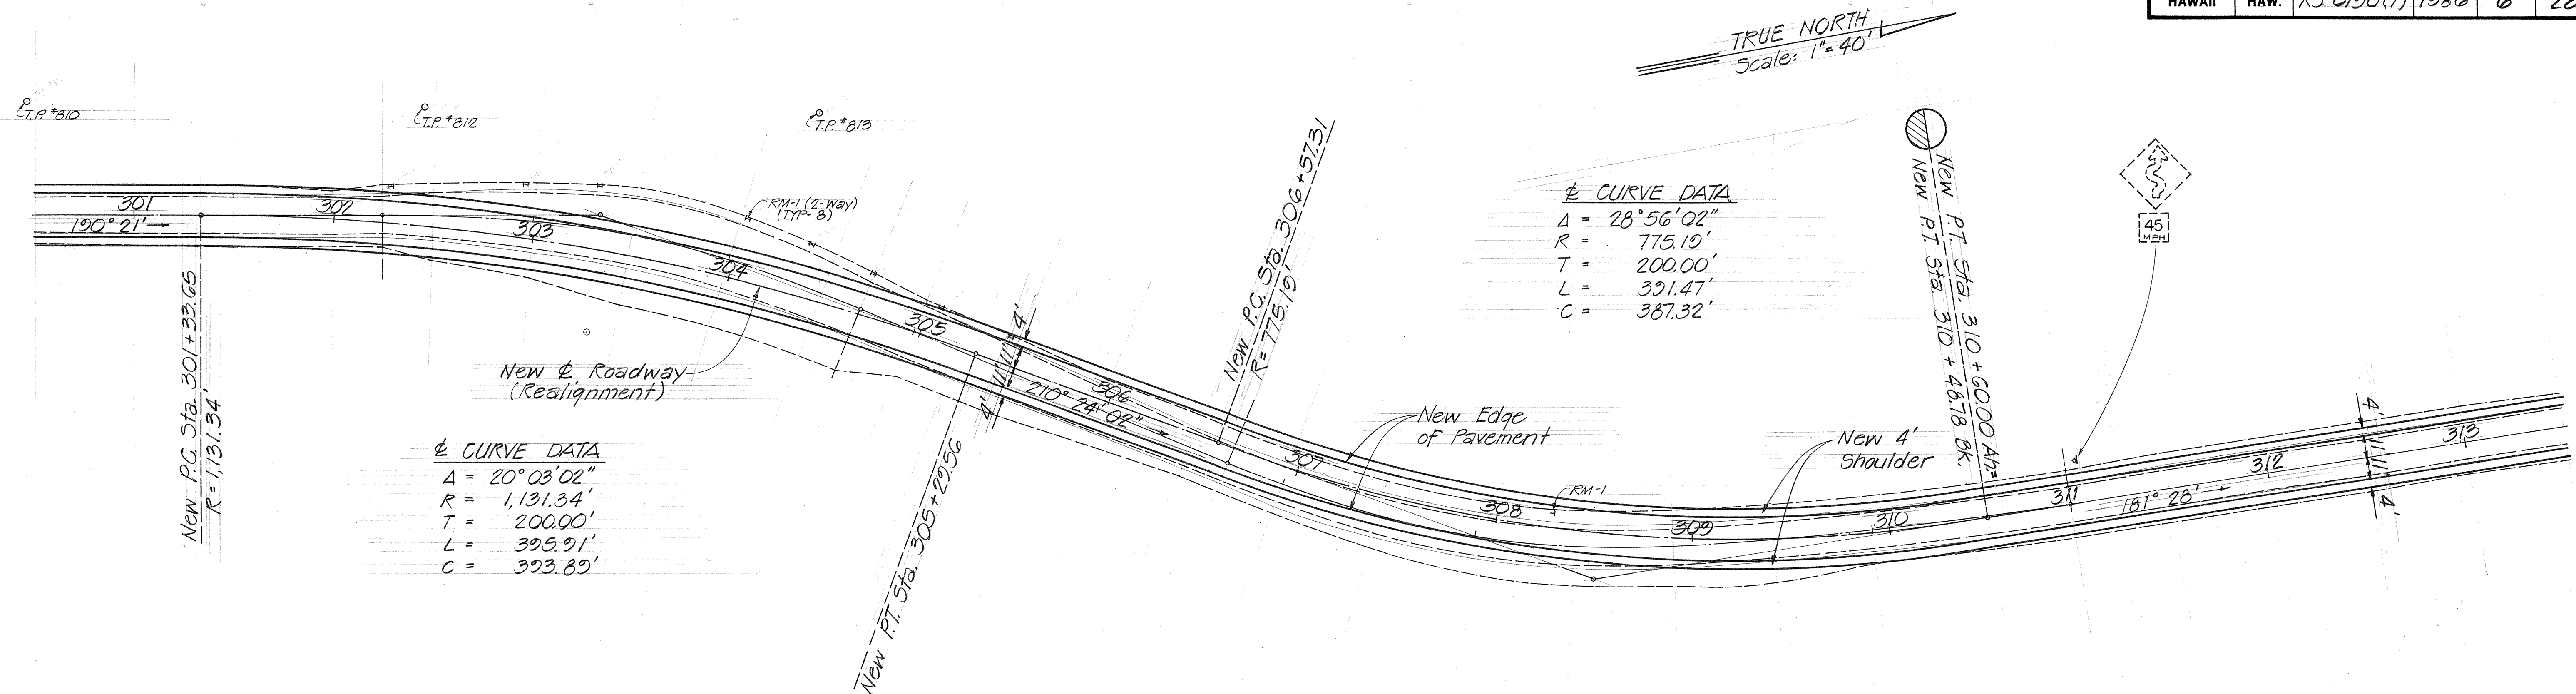

ROADWAY PLAN (REALIGNMENT)
Scale: 1" = 40'

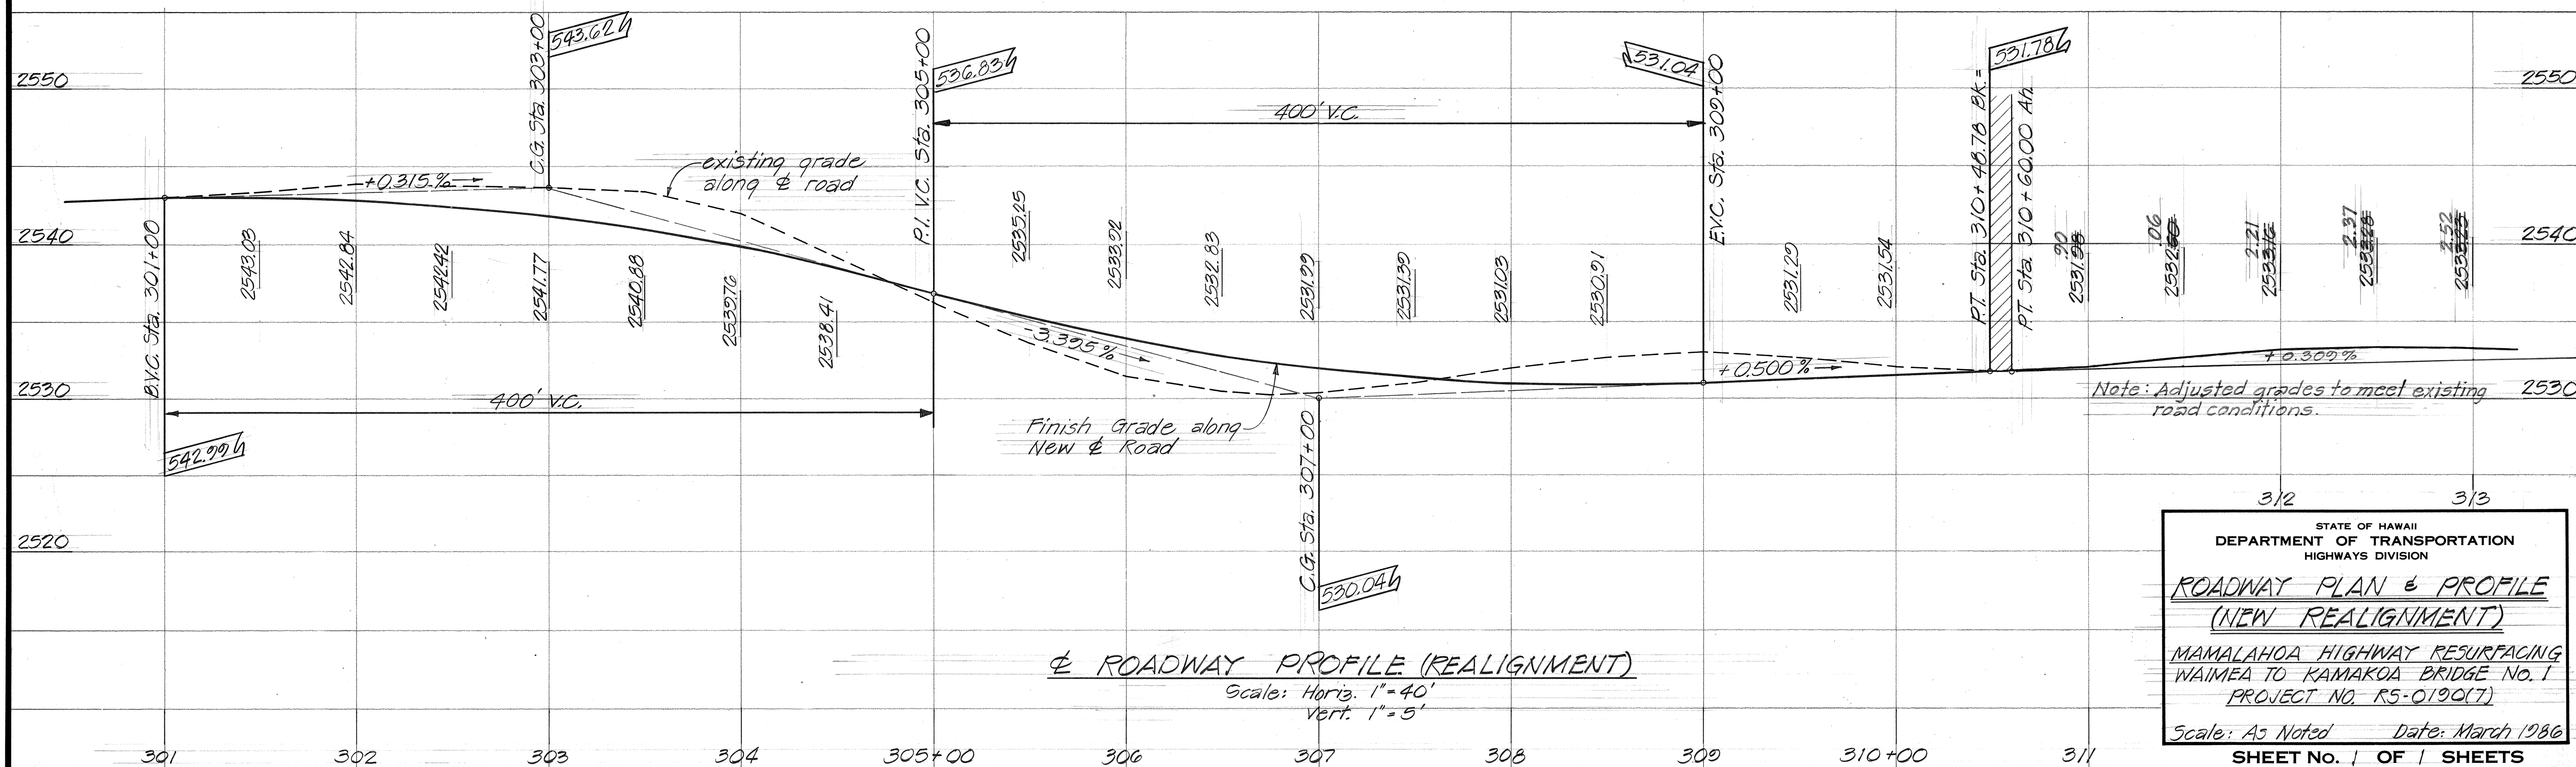

ROADWAY PROFILE (REALIGNMENT)
Scale: Horiz. 1" = 40'
Vert. 1" = 5'

STATE OF HAWAII
DEPARTMENT OF TRANSPORTATION
HIGHWAYS DIVISION

**ROADWAY PLAN & PROFILE
(NEW REALIGNMENT)**

MAMALAHOA HIGHWAY RESURFACING
WAIMEA TO KAMAKOHA BRIDGE No. 1
PROJECT NO. R5-0190(7)

Scale: As Noted Date: March 1986

SHEET No. 1 OF 1 SHEETS