


FED. ROAD DIST. NO.	STATE	PROJ. NO.	FISCAL YEAR	SHEET NO.	TOTAL SHEETS
HAWAII	HAW.	RS-0190(7)	1986	7	28

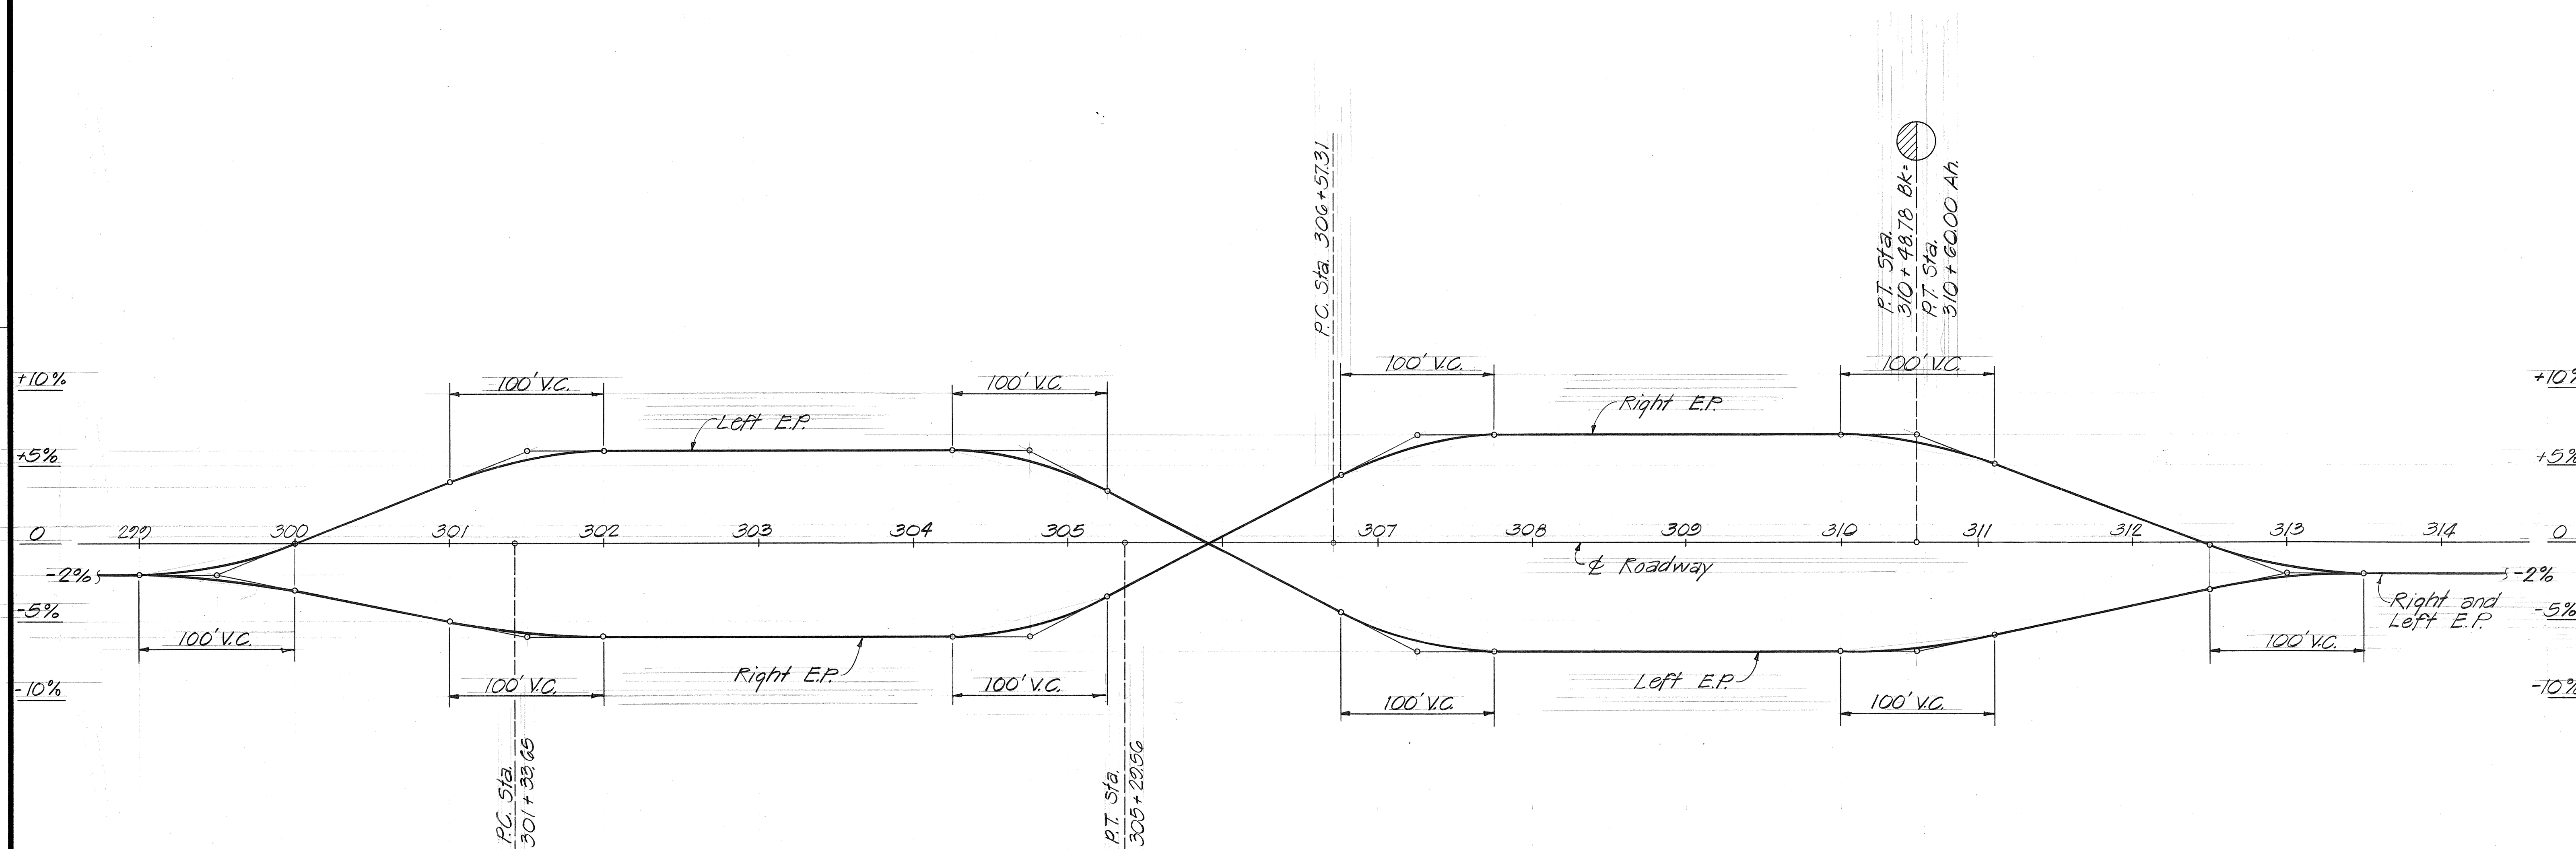

### SUPERELEVATION DIAGRAM

STA. 299+00 TO STA. 314+00

Scale: Horiz. 1" = 50'

Vert. 1" = 5%

STATE OF HAWAII  
DEPARTMENT OF TRANSPORTATION  
HIGHWAYS DIVISION

### SUPERELEVATION DIAGRAM (STA. 299+00 TO STA. 314+00)

MAMALAHOA HIGHWAY RESURFACING  
WAIMEA TO KAMAKOHA BRIDGE No. 1  
PROJECT NO. RS-0190(7)

Scale: As Noted Date: March 1986

SHEET No. 1 OF 1 SHEETS

SURVEY PLOTTED BY	DATE
DRAWN BY	
DESIGNED BY	
CHECKED BY	
ORIGINAL PLAN	
NOTE BOOK	
NO.	