

INDEX TO DRAWINGS	
SHEET NO.	DESCRIPTION
1	TITLE SHEET
2	TYPICAL SECTIONS AND DETAILS
3 - 5	GENERAL LAYOUT PLAN & RECONSTRUCTION LOCATIONS
6	ROADWAY PLAN & PROFILE (NEW REALIGNMENT)
7	SUPERELEVATION DIAGRAM (STA. 299+00 TO STA. 314+00)
8	DETOUR PHASING PLAN (STA. 297+00 TO STA. 316+00)
9	DETOUR ROAD TRAFFIC SIGN PLAN
10	CONSTRUCTION & DETOUR SIGN LAYOUT & SUMMARY
11 - 13	PAVEMENT MARKERS & SIGNING LAYOUT
14 - 17	CROSS SECTIONS
18 - 28	STANDARD DETAILS

STATE OF HAWAII

DEPARTMENT OF TRANSPORTATION

HIGHWAYS DIVISION

"AS - BUILT"

PLANS FOR


MAMALAHOA HIGHWAY RESURFACING

WAIMEA TO KAMAKOA BRIDGE NO. 1

PROJ. NO. RS-0190(7)

DISTRICT OF SOUTH KOHALA




ISLAND OF HAWAII

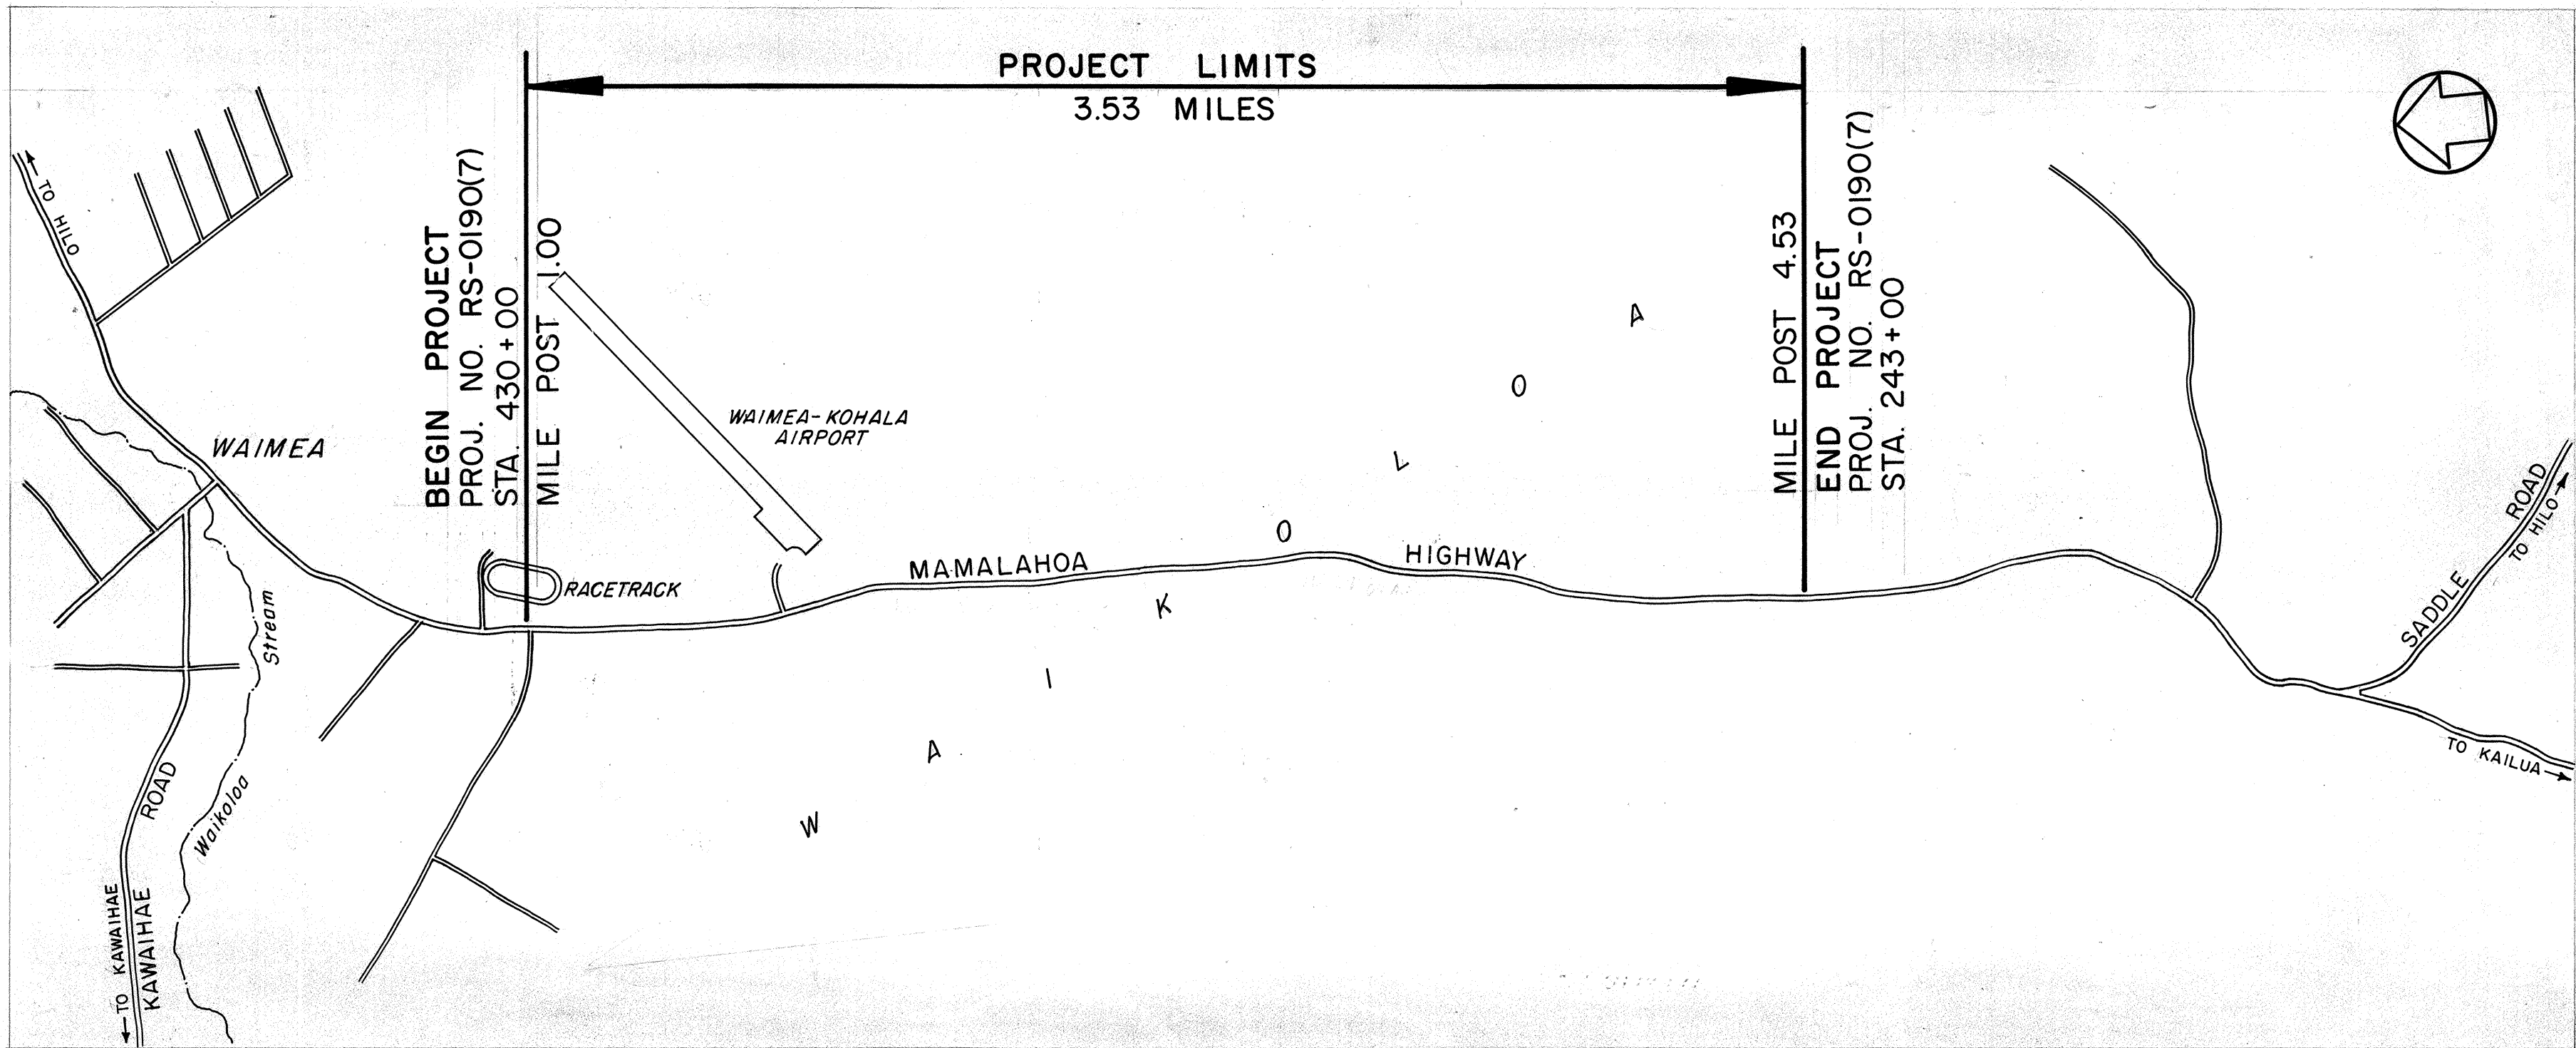

LAYOUT OF PROJECT

SCALE: 1" = 2000'

FED. ROAD DIST. NO.	STATE	PROJ. NO.	FISCAL YEAR	SHEET NO.	TOTAL SHEETS
HAWAII	HAW.	RS-0190(7)	1986	1	28

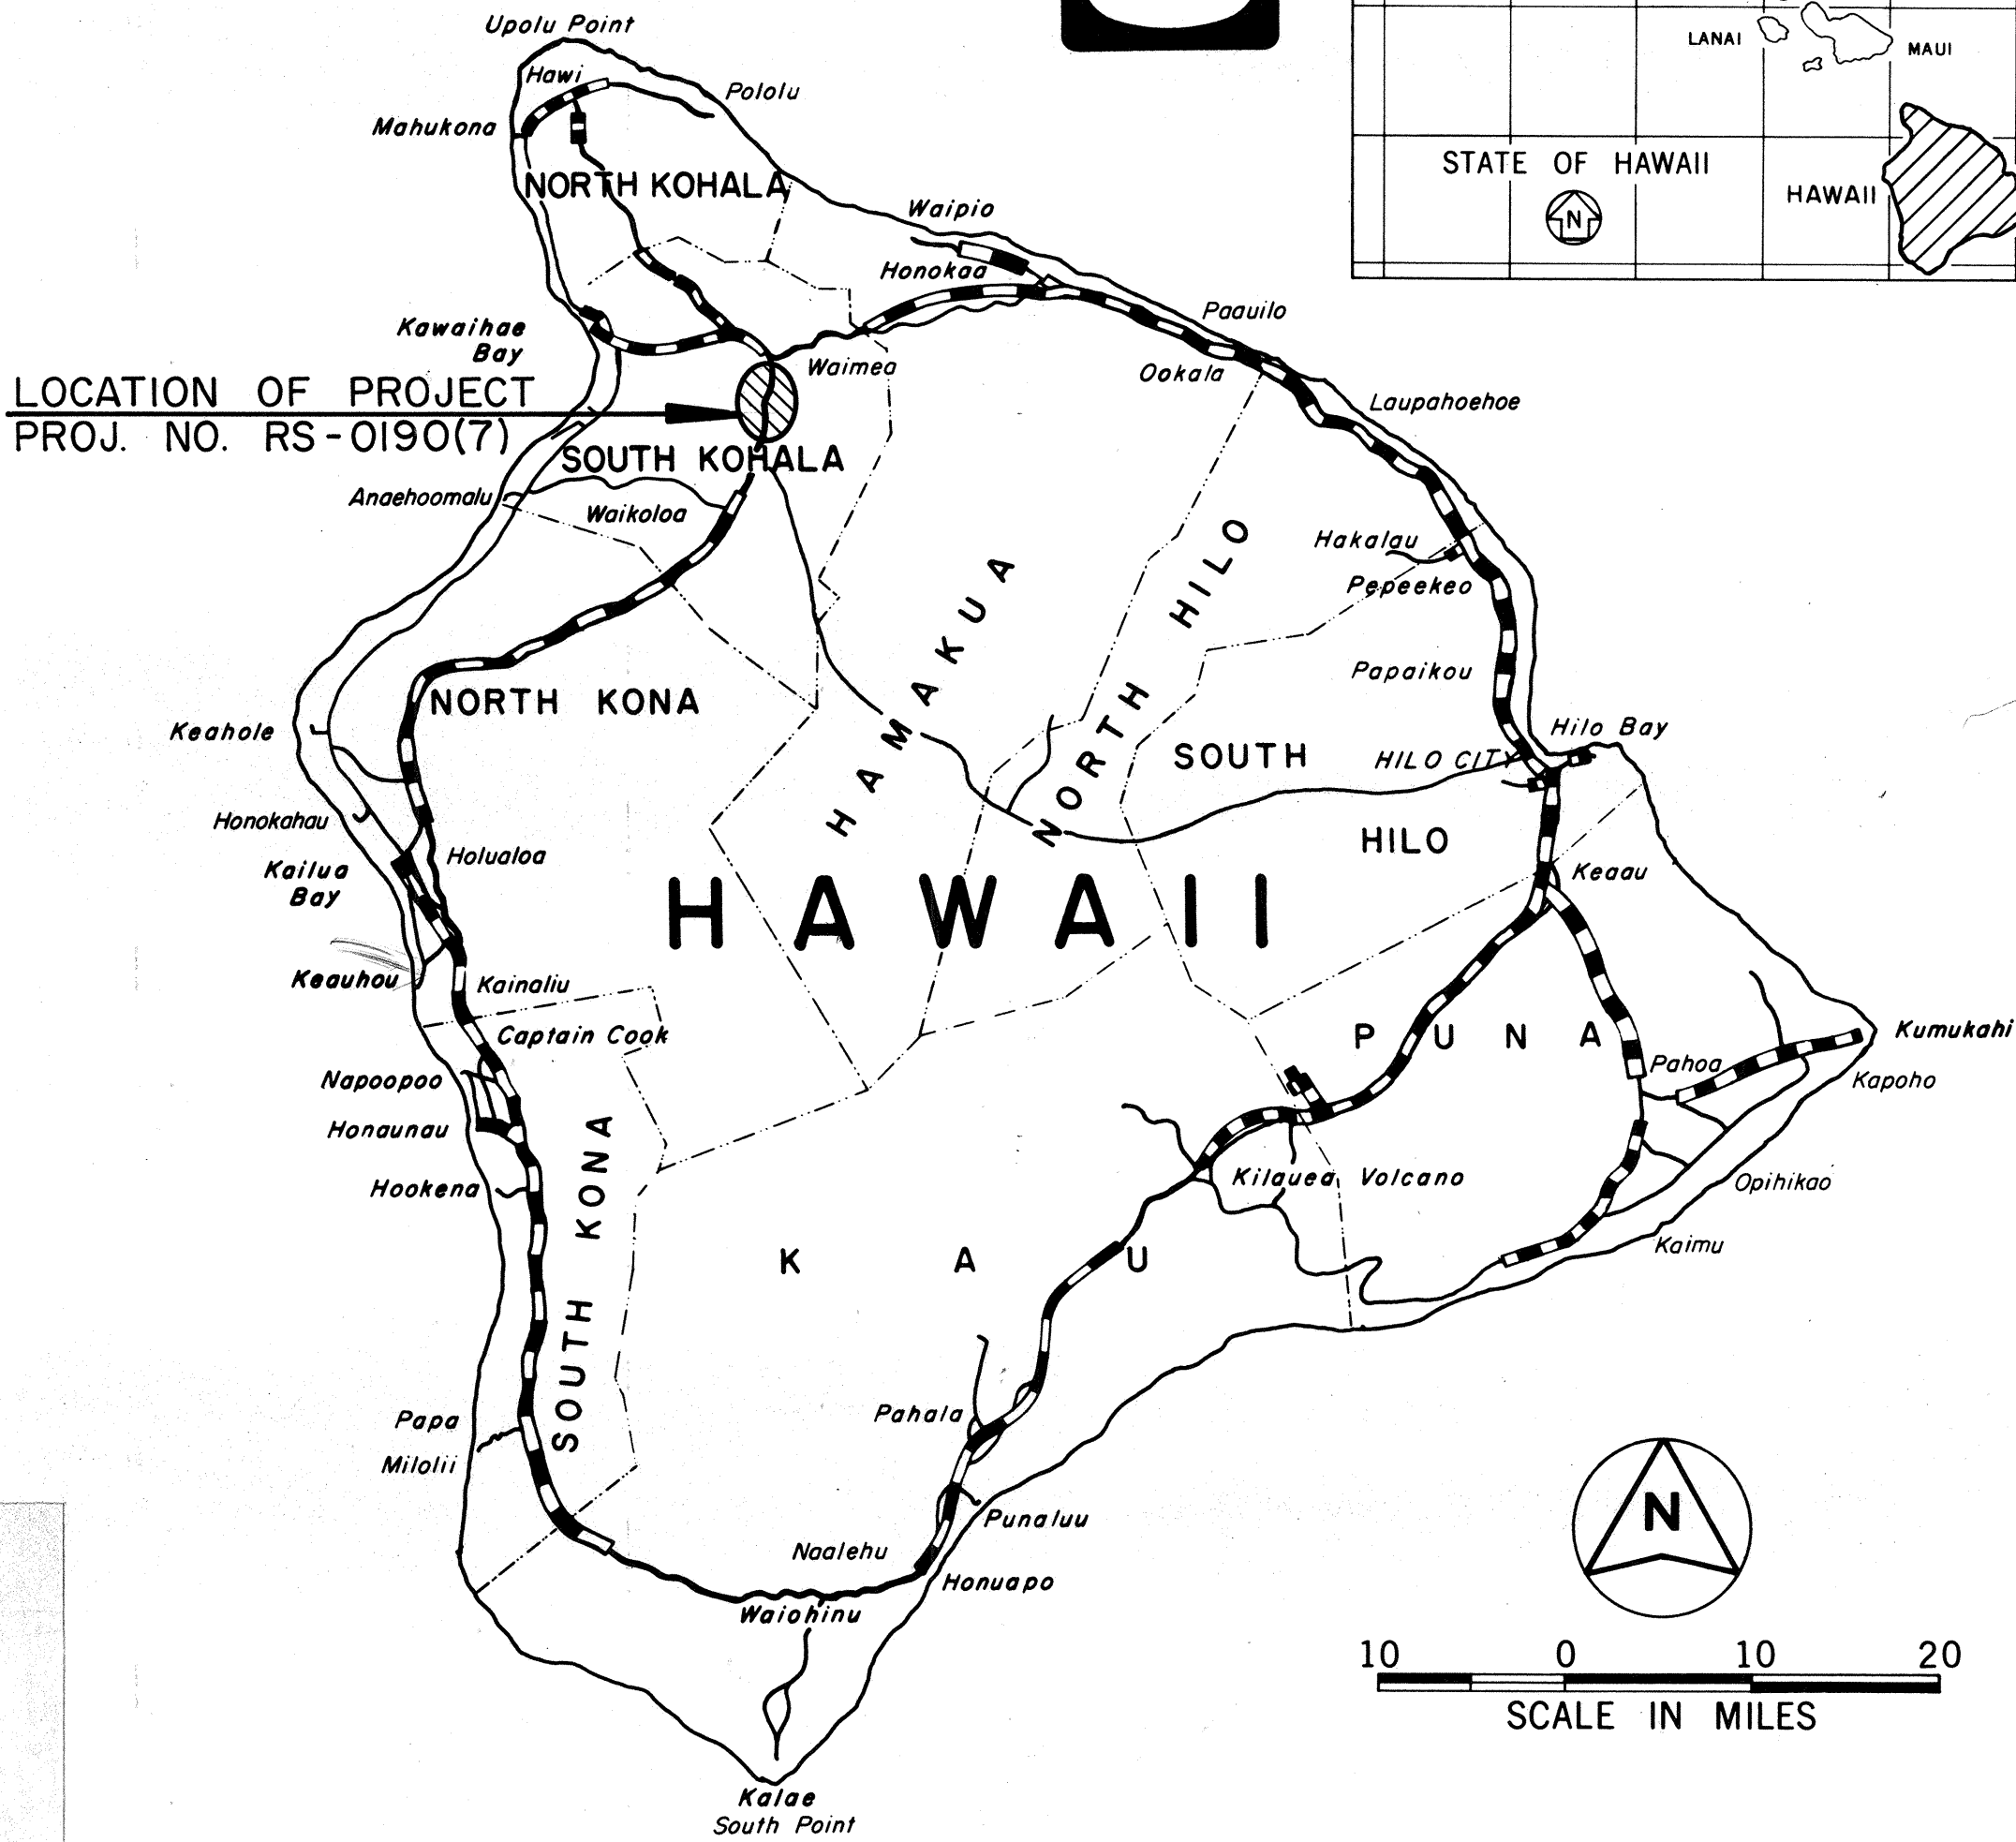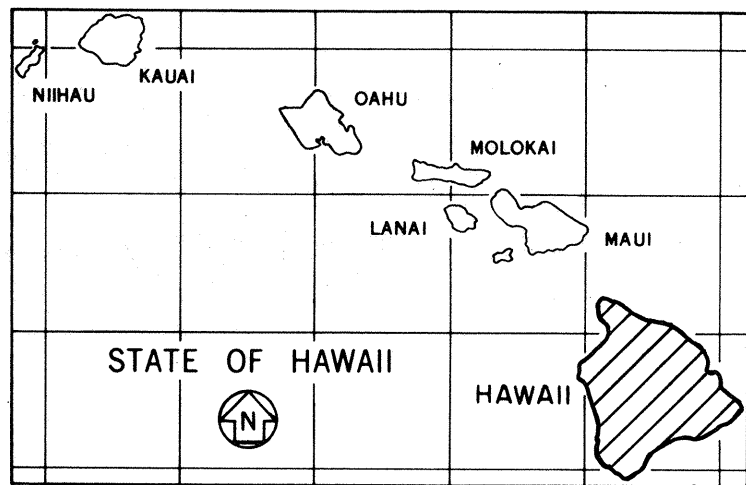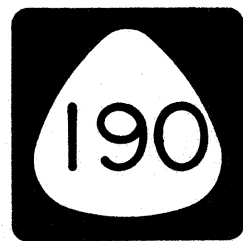

FEDERAL AID PROJECTS PREVIOUSLY CONSTRUCTED OR UNDER CONSTRUCTION

CHANGES MADE DURING CONSTRUCTION HAVE BEEN INCORPORATED ON THESE PLANS EXCEPT CHANGES IN THE ORIGINAL THEORETICAL QUANTITIES. FOR ACTUAL QUANTITIES, REFER TO PROJECT LEDGER AND/OR COMPUTATION BOOK.

Howard Hapone

RESIDENT ENGINEER

Sept. 15, 1986

DATE

DEPARTMENT OF TRANSPORTATION STATE OF HAWAII	
APPROVED <i>[Signature]</i> DIR. OF TRANSPORTATION	DATE 5/22/86

HWY - H

DESIGNED BY

A. Yamaguchi

548-7534

5/20/86

DATE

P. S. & E. BY

PHONE