

INDEX TO DRAWINGS	
SHEET NO.	DESCRIPTION
1	TITLE SHEET
3,4	TYPICAL SECTIONS AND DETAILS
5-9	ROADWAY PLANS
10-16	PLAN & PROFILE, M.P. 8.41-4.53
17-25	ROADWAY ALIGNMENT PLANS
①26-28	MISC. ROADWAY PLANS & DETAILS
29-32	DETOUR AND CONSTRUCTION SIGNING & DETAILS
33,34	DRAINAGE PLANS & DETAILS
②35-40	TRAFFIC SIGN PLAN, PAVEMENT MARKERS & DETAILS
③42-56	CROSS SECTIONS
2	STANDARD PLANS SUMMARY

① 28 S-1
 ② C.O. ADD 39 S-1
 ③ 43 S-1, 44 S-1, 44 S-2, 45 S-1, 45 S-2, 55 S-1, 55 S-2, 56 S-1, 56 S-2, 56 S-3, 56 S-4, 56 S-5, 56 S-6.
 THESE ARE SUPPLEMENT SHEETS TO CONTRACT PLANS.
 NEW PLAN SHT. TOTAL = 71 SHTS.

HAWAII DISTRICT
 DESIGNED BY A. TAKESHITA 548-7537 APRIL, 1987
 P. S. & E. BY PHONE DATE

STATE OF HAWAII

DEPARTMENT OF TRANSPORTATION

HIGHWAYS DIVISION

"AS-BUILT"

PLANS FOR


MAMALAHOA HIGHWAY RESURFACING

KEAMUKU TO VICINITY OF KAMAKOA BRIDGE NO. 1


FEDERAL AID PROJECT NO. RS-0190(8)

DISTRICT OF SOUTH KOHALA

ISLAND OF HAWAII


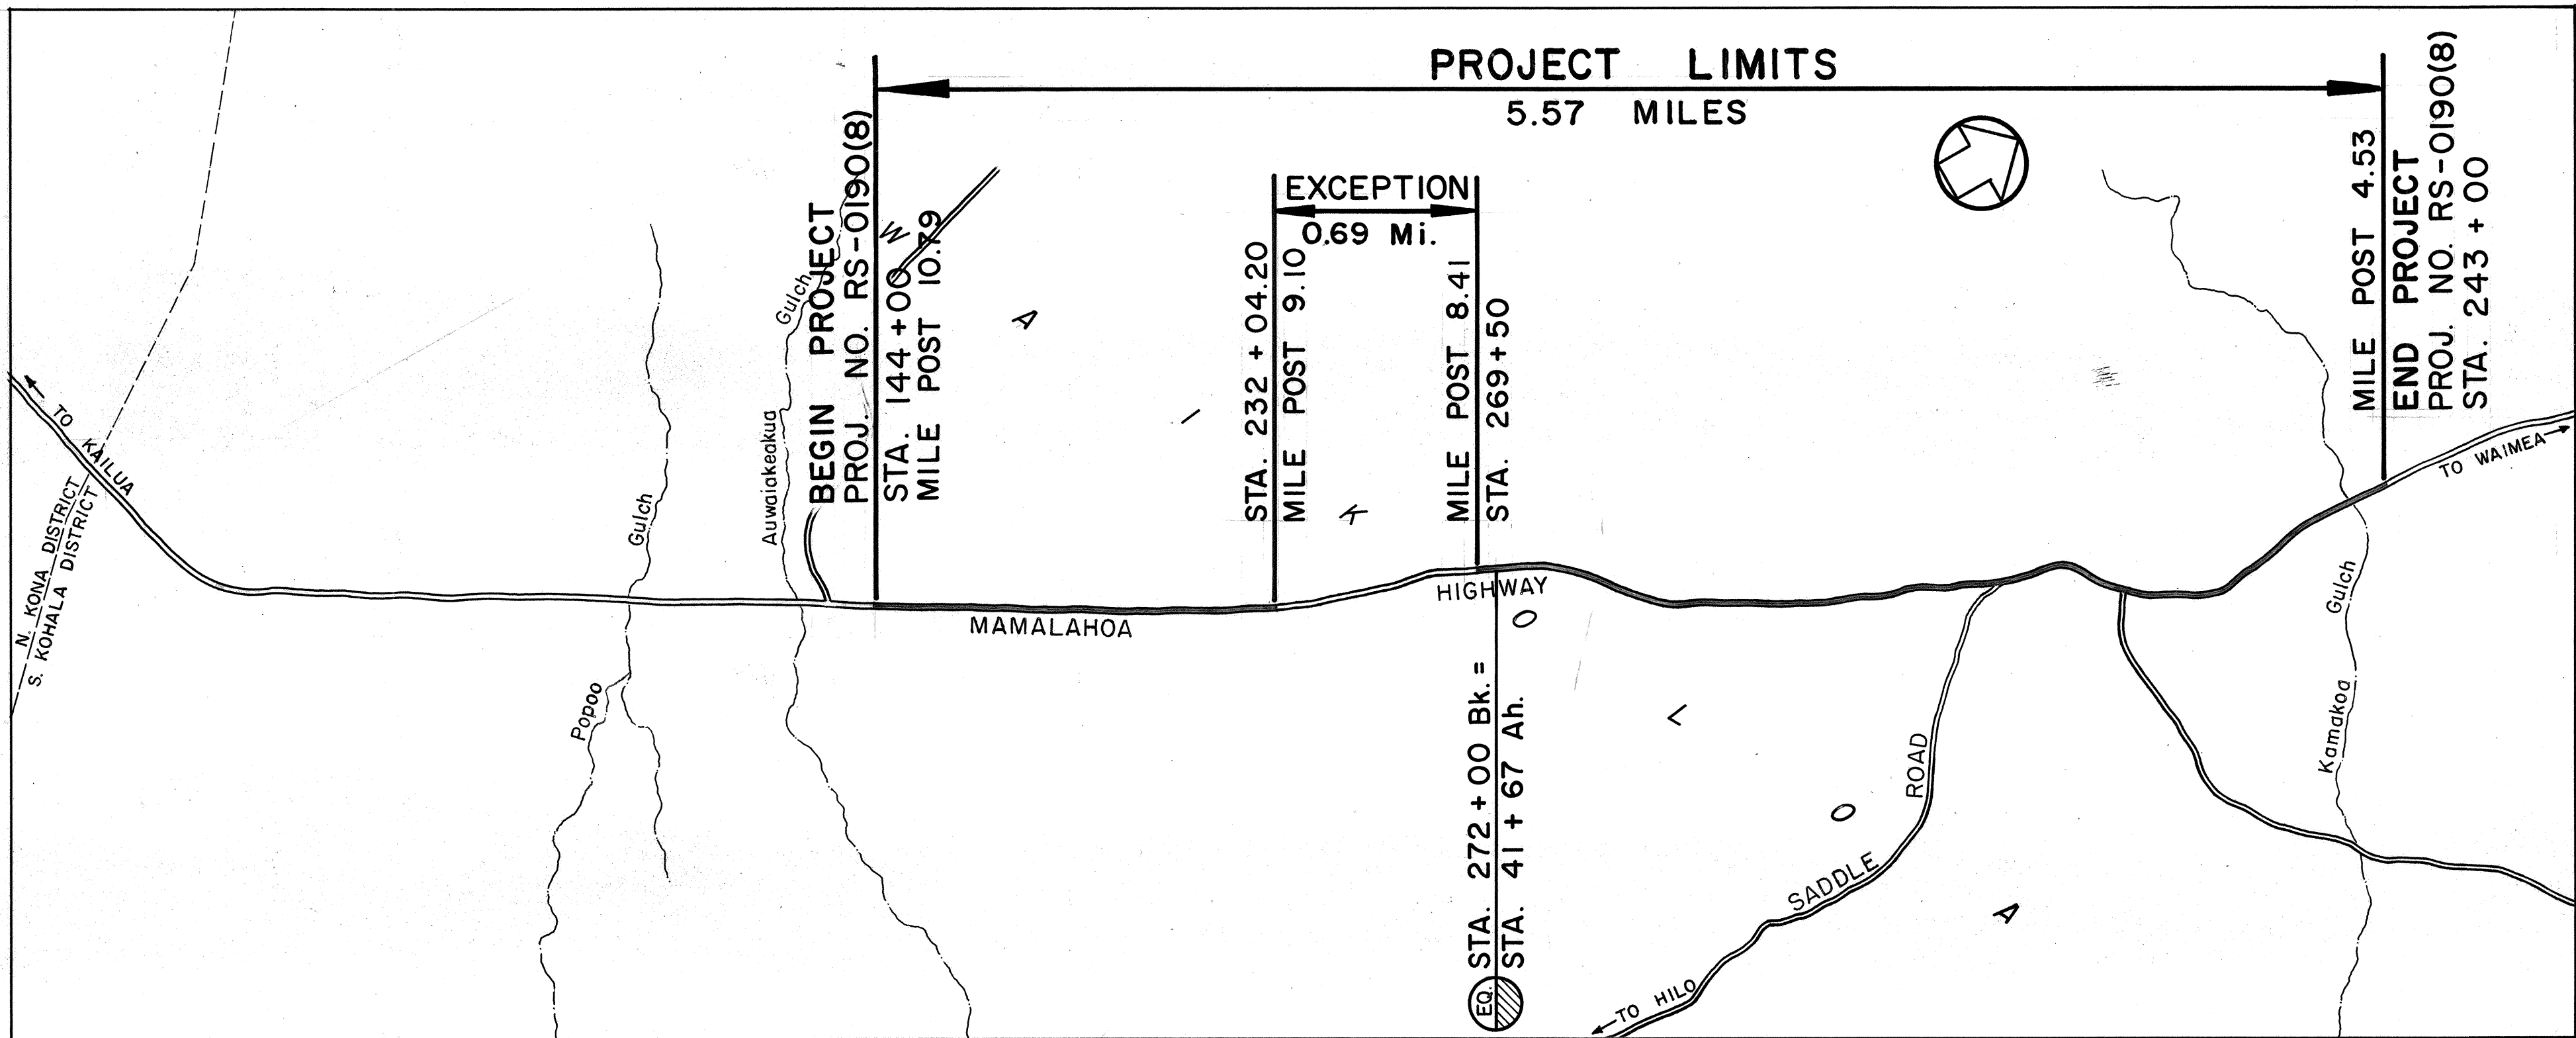


LAYOUT OF PROJECT

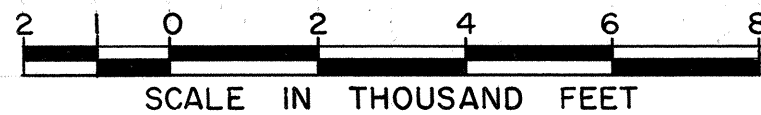


GROSS LENGTH 6.26 Mi.
 EXCEPTION 0.69 Mi.
 NET LENGTH 5.57 Mi.

FED. ROAD DIST. NO.	STATE	FED. AID PROJ. NO.	FISCAL YEAR	SHEET NO.	TOTAL SHEETS
HAWAII	HAW.	RS-0190(8)	1987	1	56

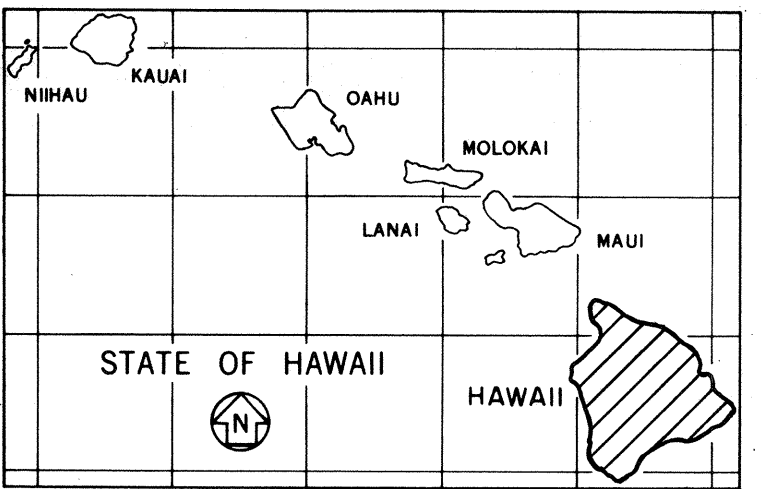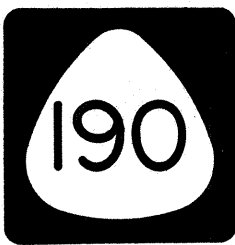

LOCATION OF PROJECT
PROJ. NO. RS-0190(8)

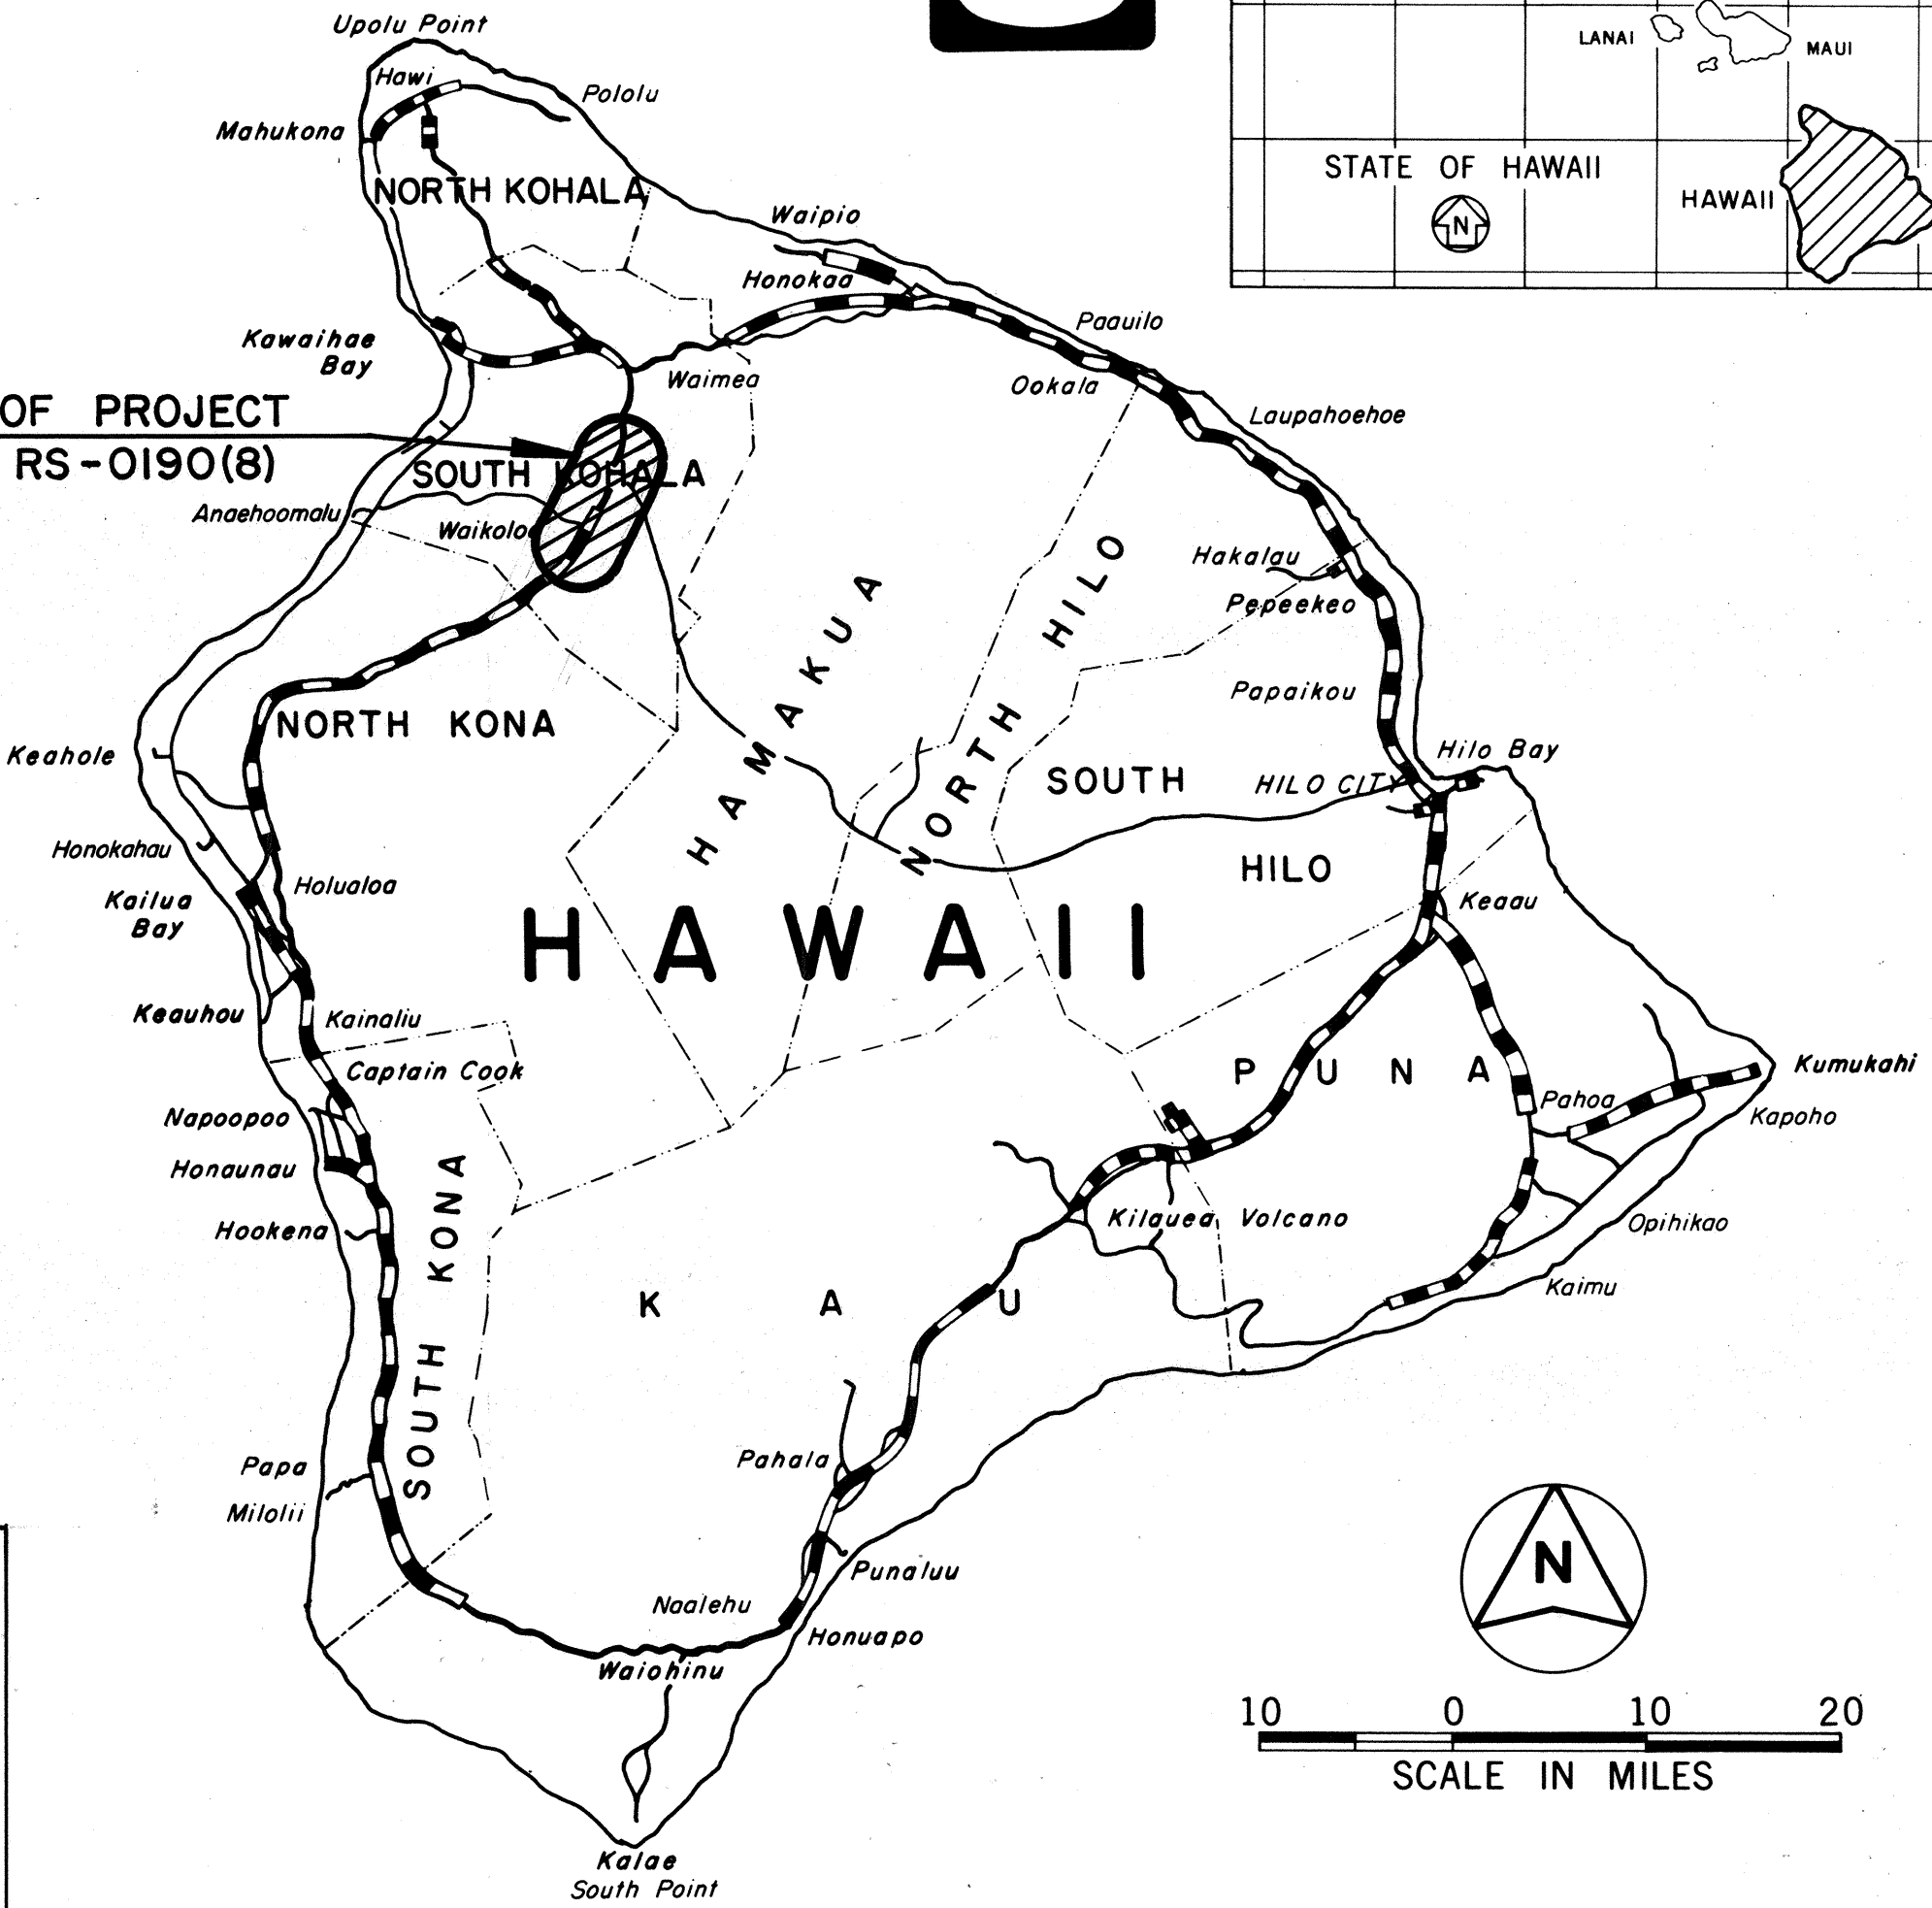

FEDERAL AID PROJECTS PREVIOUSLY CONSTRUCTED OR UNDER CONSTRUCTION

DESIGN CLASSIFICATION

CURRENT ADT (1987) 2000
 DESIGN ADT (1997) 2400
 DHV 240
 D 60/40
 T 11.0 %
 T₂₄ 10.5 %

CHANGES MADE DURING CONSTRUCTION HAVE BEEN INCORPORATED ON THESE PLANS EXCEPT CHANGES IN THE ORIGINAL THEORETICAL QUANTITIES. FOR ACTUAL QUANTITIES, REFER TO PROJECT LEDGER AND/OR COMPUTATION BOOK.

Roy Shioji
 RESIDENT ENGINEER

3/19/91
 DATE

DEPARTMENT OF TRANSPORTATION
STATE OF HAWAII

APPROVED:

[Signature]
 DIR. OF TRANSPORTATION 5/12/87
 DATE