


FED. ROAD DIST. NO.	STATE	PROJ. NO.	FISCAL YEAR	SHEET NO.	TOTAL SHEETS
HAWAII	HAW.	190C-01-89M	1989	7	7


PAVEMENT MARKER SCHEDULE						
EXIST. PROJ. No.	STATION		DESCRIPTION	TYPE		
	FROM	TO		DL	HL	J
FAP 10-A	457+60	466+90	NO PASSING-L PASSING-R	23	24	96
	466+90	468+00	PASSING-BOTH SIDES	3		8
	468+00	476+00	PASSING-L NO PASSING-R	20	20	80
	476+00	476+50	NO PASSING-BOTH SIDES	3		
	476+50	487+20	NO PASSING-L PASSING-R	27	26	104
	487+20	514+10	NO PASSING-BOTH SIDES	135		
	514+10	522+00	PASSING-L NO PASSING-R	20	19	76
	522+00	543+30	NO PASSING-BOTH SIDES	107		
	543+30	552+25	PASSING-L NO PASSING-R	22	22	88
	552+25	560+50	NO PASSING-L PASSING-R	21	21	84
	560+50	564+80	PASSING-BOTH SIDES	11		40
	564+80	574+00	PASSING-L NO PASSING-R	23	23	92
	574+00	606+60	NO PASSING-BOTH SIDES	163		
	606+60	615+45	NO PASSING-L PASSING-R	22	22	88
	615+45	619+75	PASSING-BOTH SIDES	11		40
FAP 10-B	619+75	628+95	PASSING-L NO PASSING-R	23	23	92
	628+95	653+50	NO PASSING-BOTH SIDES	123		
	653+50	662+25	NO PASSING-L PASSING-R	22	22	88
	662+25	665+35	PASSING-BOTH SIDES	8		28
	665+35	674+15	PASSING-L NO PASSING-R	22	22	88
	674+15	676+64.30	NO PASSING-BOTH SIDES	13		
TOTALS				822	244	1,092

RECONSTRUCTED & MONUMENT SCHEDULE		
Exist. PROJ. No.	ITEM No. 613.0100 NEW CENTERLINE MONUMENT STATION	Exist. DEPTH
FAP 10-A	P.C. 459+86.60	0.10'
	P.T. 460+86.60	0.21'
	P.O.T. 477+16	0.13'
	P.O.T. 495+29	0.10'
	P.O.T. 507+09	0.17'
	P.C. 531+66	0.15'
	P.T. 536+95.20	0.13'
	P.C. 551+09.70	0.17'
	P.T. 553+25.30	0.15'
	P.C. 581+48.90	0.17'
	P.T. 591+53.00 Bk.	0.10'
	591+63.80 Ah.	
	P.C. 603+33.70	0.10'
	P.T. 608+26.40 Bk.	0.10'
	608+33.70 Ah.	
FAP 10-B	P.C. 625+70.50	0.15'
	P.T. 640+56.30	0.21'
	P.C. 640+57.10	0.21'
TOTAL	642+00	0.21'
	P.T. 646+46.10	0.13'
	P.C. 672+60.50	0.21'
19 Each		

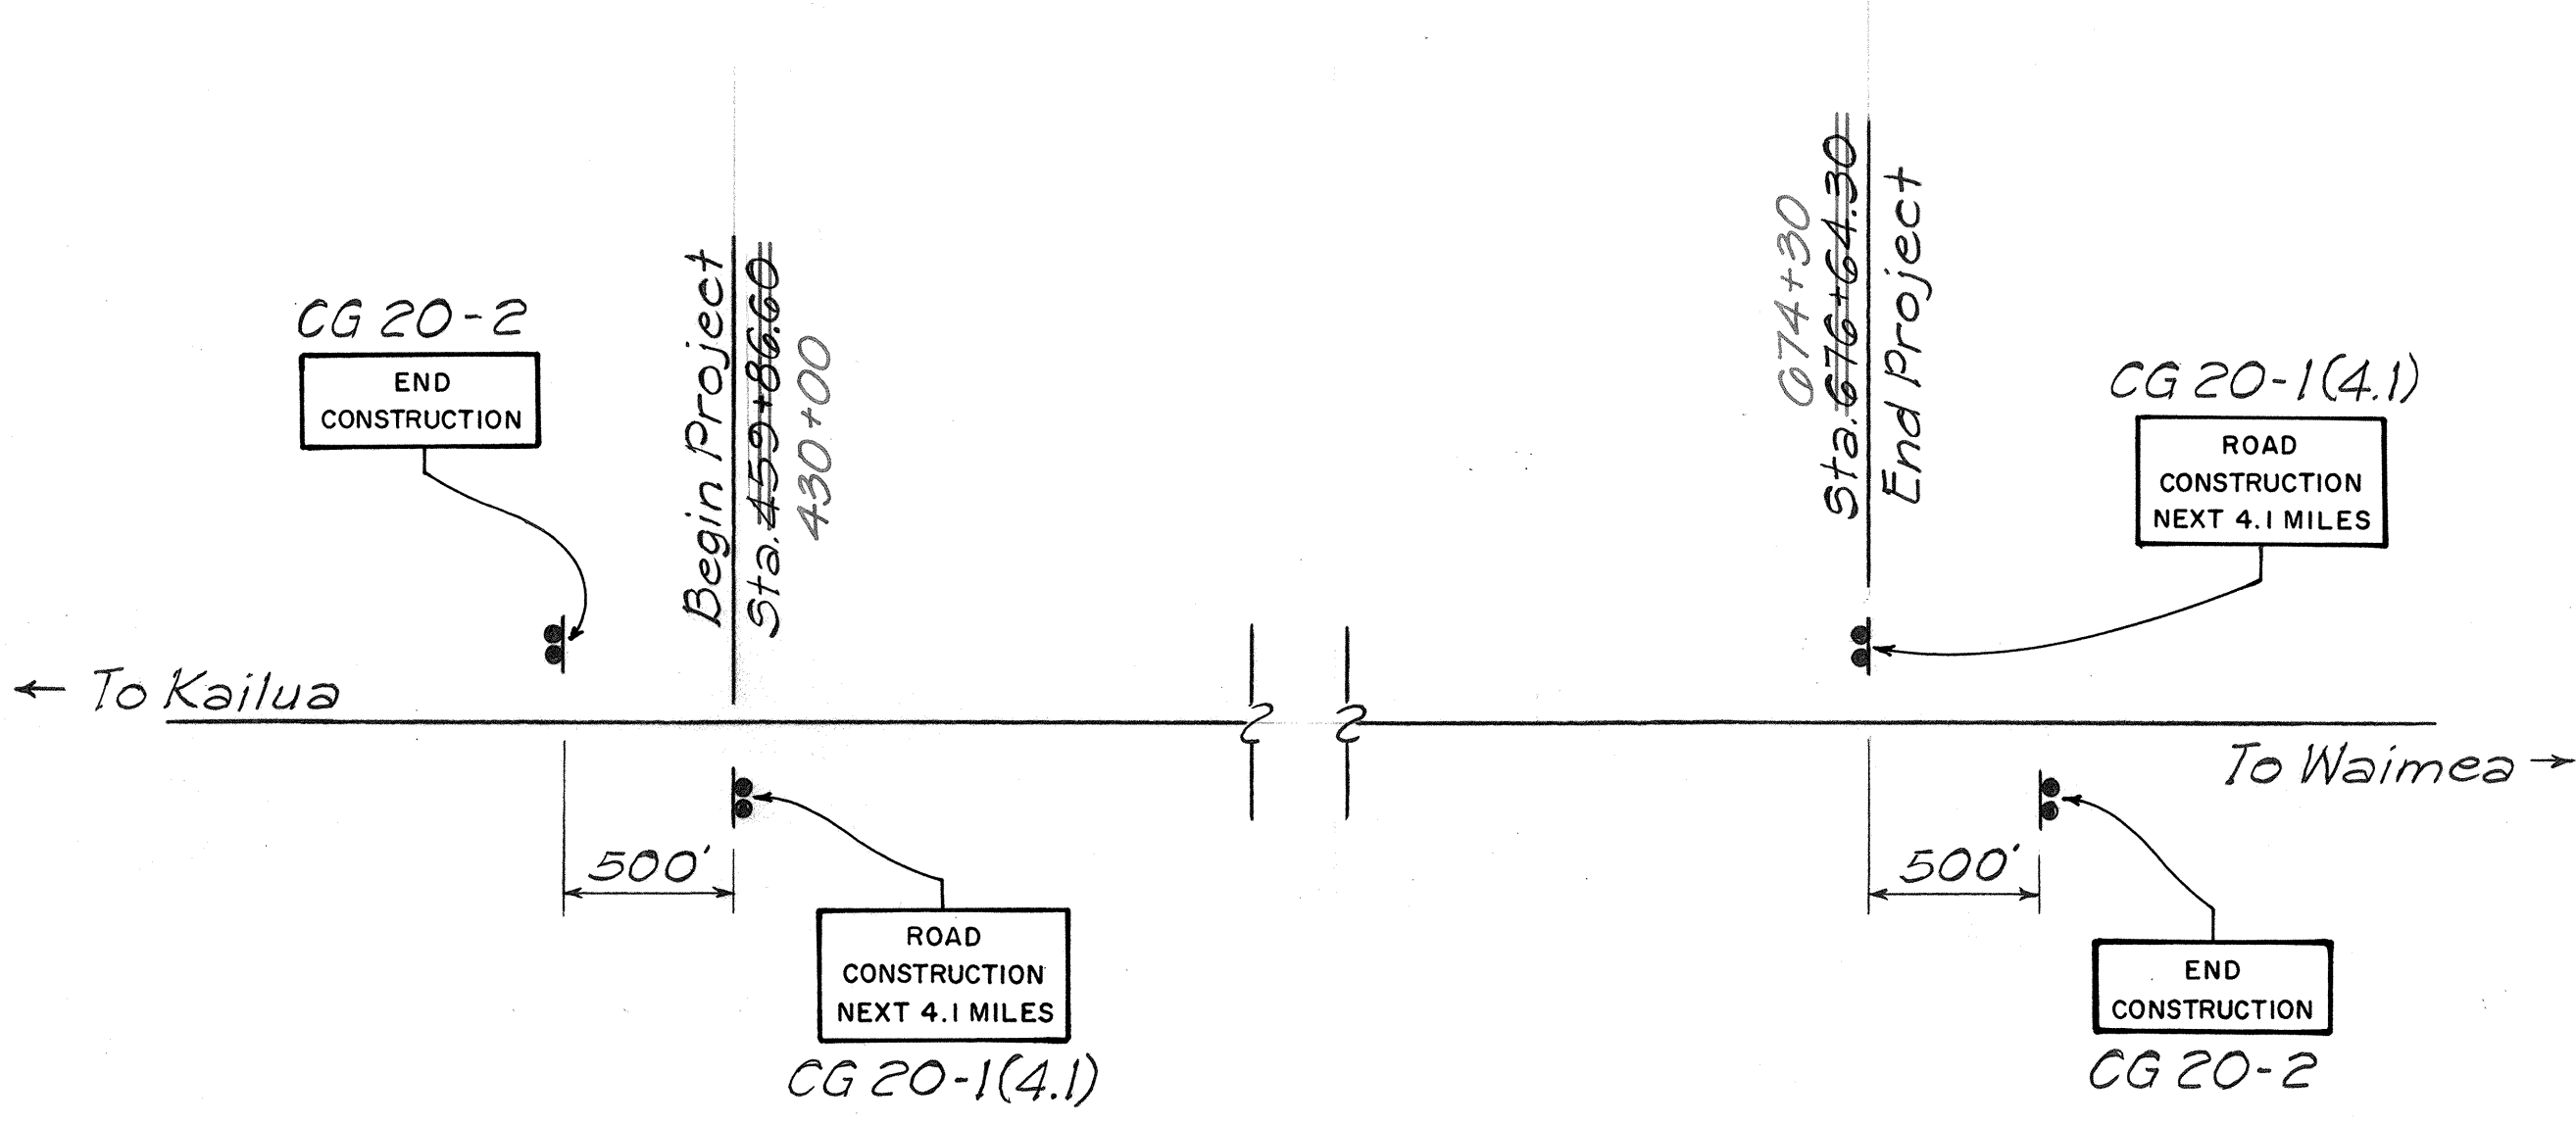

SIGN DETAIL
NOT TO SCALE

CONSTRUCTION SIGN SCHEDULE		
Exist. PROJ. No.	STATION	ITEM No. 621+7100
FAP 10-A	454+86.60 - Lt.	CG 20-2
	459+86.60 - Rt.	CG 20-1(4.1)
FAP 10-B	676+64.30 - Lt.	CG 20-1(4.1)
	681+64.30 - Rt.	CG 20-2
TOTAL		4 Each

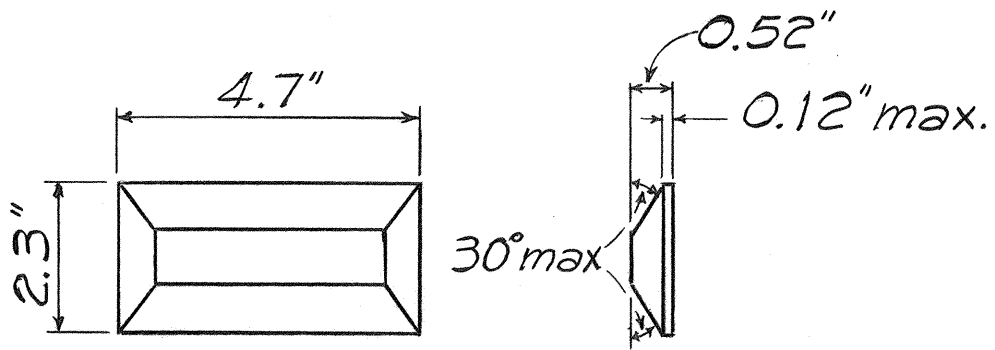

L SERIES PAVEMENT MARKER DETAIL
NOT TO SCALE

NOTE:
Details of Type "C", Type "D" and Type "H" Markers on Standard Plan TE-30 shall be deleted and replaced with Details of Type "CL", Type "DL" and Type "HL" Markers as shown on this Sheet. All references to Type "C", Type "D" and Type "H" Markers in the Plans shall mean Type "CL", Type "DL" and Type "HL" Markers.

TYPE "CL": Red-Clear Reflective Marker
TYPE "DL": Two-Way Yellow Reflective Marker
TYPE "HL": One-Way Yellow Reflective Marker

STATE OF HAWAII
DEPARTMENT OF TRANSPORTATION
HIGHWAYS DIVISION

CONSTRUCTION SIGN DETAIL,
SIGN & MISC. SCHEDULES

PUU ANAHULU
PROJ. No. 190C-01-89M

Scale: As Noted Date: Sept. 1988

SHEET No. 1 OF 1 SHEETS

DATE	____
DESIGNED BY	____
TRACED BY	____
NOTE BOOK	____
QUANTITIES BY	____
CHECKED BY	____
No.	____

ORIGINAL PLAN

NOTE BOOK

No.

SURVEY PLOTTED BY

DATE

DESIGNED BY

QUANTITIES BY

CHECKED BY

FED. ROAD DIST. NO.	STATE	FED. AID PROJ. NO.	FISCAL YEAR	SHEET NO.	TOTAL SHEETS
HAWAII	HAW.	1900-01-80M	1988	75-1	7

PAVEMENT MARKER SCHEDULE						
EXIST. PROJ.	STATION		DESCRIPTION	TYPE		
	FROM	TO		DL	HL	J
FAP 10-A	430+00	433+00	NO PASSING - BOTH SIDES	20		
	433+00	442+80	NO PASSING L - PASSING R	23	23	02
	442+80	447+50	PASSING - BOTH SIDES	12		44
	447+50	450+70	PASSING L - NO PASSING R	23	23	02
	450+70	457+00	NO PASSING - BOTH SIDES	5		
	457+00	460+00	NO PASSING L - PASSING R	23	23	02
	460+00	468+00	PASSING - BOTH SIDES	3		8
	468+00	470+00	PASSING L - NO PASSING R	20	20	80
	470+00	470+50	NO PASSING - BOTH SIDES	3		
	470+50	487+20	NO PASSING L - PASSING R	27	20	104
	487+20	514+00	NO PASSING - BOTH SIDES	130		
	514+00	522+00	PASSING L - NO PASSING R	20	10	70
	522+00	543+30	NO PASSING - BOTH SIDES	108		
	543+30	552+25	PASSING L - NO PASSING R	23	21	84
	552+25	560+50	NO PASSING L - PASSING R	21	20	80
	560+50	564+80	NO PASSING - BOTH SIDES	22		
	564+80	574+00	PASSING L - NO PASSING R	23	22	88
	574+00	600+00	NO PASSING - BOTH SIDES	104		
	600+00	615+45	NO PASSING L - PASSING R	22	22	88
	615+45	610+75	PASSING - BOTH SIDES	11		40
FAP 10-B	610+75	628+05	PASSING L - NO PASSING R	23	23	02
	628+05	653+50	NO PASSING - BOTH SIDES	124		
	653+50	662+25	NO PASSING L - PASSING R	22	22	88
	662+25	665+35	PASSING - BOTH SIDES	4		12
	665+35	673+00	PASSING L - NO PASSING R	23	23	02
	673+00	674+30	NO PASSING - BOTH SIDES	7		
		442+00	SIDE ROAD RT. (PUU LANI SUBDIVISION)	4		
TOTALS				016	287	1,252

Note: This tracing prepared during "As-Built" Posting.

STATE OF HAWAII
DEPARTMENT OF TRANSPORTATION
HIGHWAYS DIVISION

PAVEMENT MARKER
SCHEDULE

PUU ANAHULU
PROJ. No. 1900-01-80M

Scale: None Date: Sept, 1988

SHEET No. / OF / SHEETS