


FED. ROAD DIST. NO.	STATE	PROJ. NO.	FISCAL YEAR	SHEET NO.	TOTAL SHEETS
HAWAII	HAW.	190C-01-89M	1989	4	7

BEGIN OF PROJECT
STA. 430+00

MATCH LINE STA. 485+00

MATCH LINE STA. 515+00

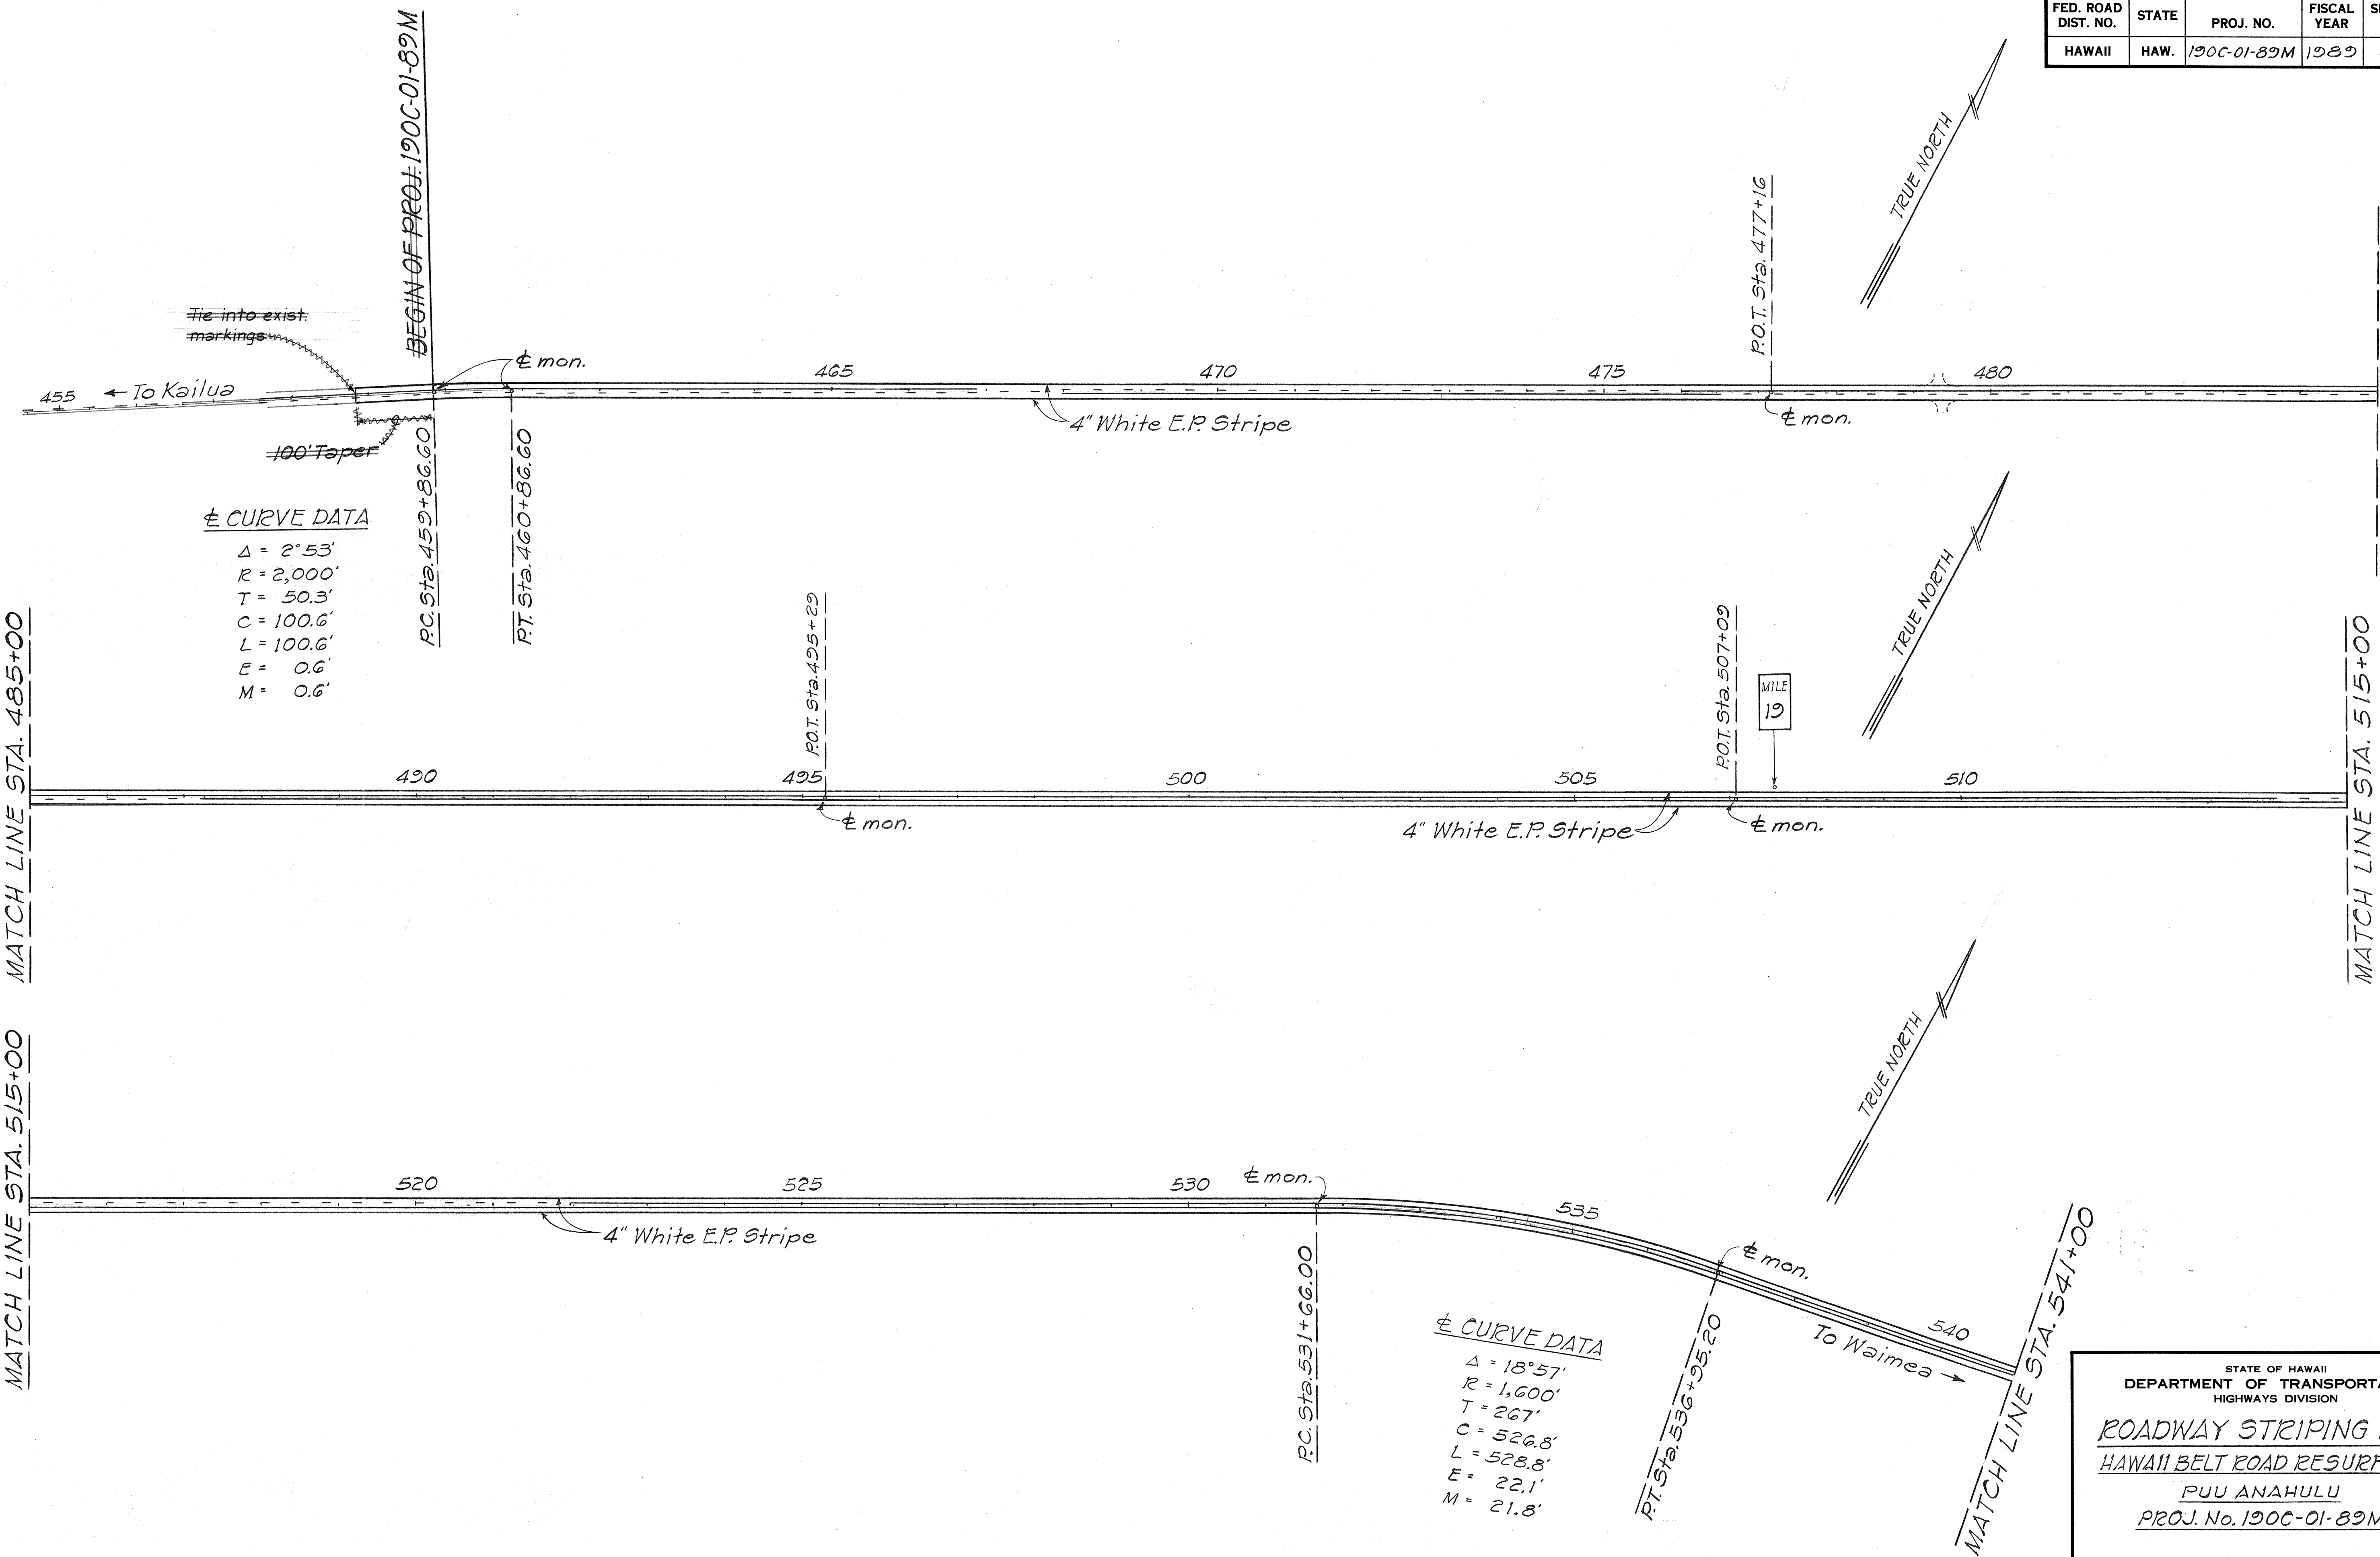

± CURVE DATA

$\Delta = 2^\circ 53'$
 $R = 2,000'$
 $T = 50.3'$
 $C = 100.6'$
 $L = 100.6'$
 $E = 0.6'$
 $M = 0.6'$

± CURVE DATA

$\Delta = 18^\circ 57'$
 $R = 1,600'$
 $T = 267'$
 $C = 526.8'$
 $L = 526.8'$
 $E = 22.1'$
 $M = 21.8'$

STATE OF HAWAII
 DEPARTMENT OF TRANSPORTATION
 HIGHWAYS DIVISION

ROADWAY STRIPING PLAN
HAWAII BELT ROAD RESURFACING


PUU ANAHULU
 PROJ. No. 190C-01-89M

Scale: 1" = 100' Date: Sept. 1988

SHEET No. 1 OF 3 SHEETS

ORIGINAL PLAN	DATE
DESIGNED BY	
QUANTITIES BY	
CHECKED BY	

FED. ROAD DIST. NO.	STATE	PROJ. NO.	FISCAL YEAR	SHEET NO.	TOTAL SHEETS
HAWAII	HAW.	190C-01-89M	1989	5	7

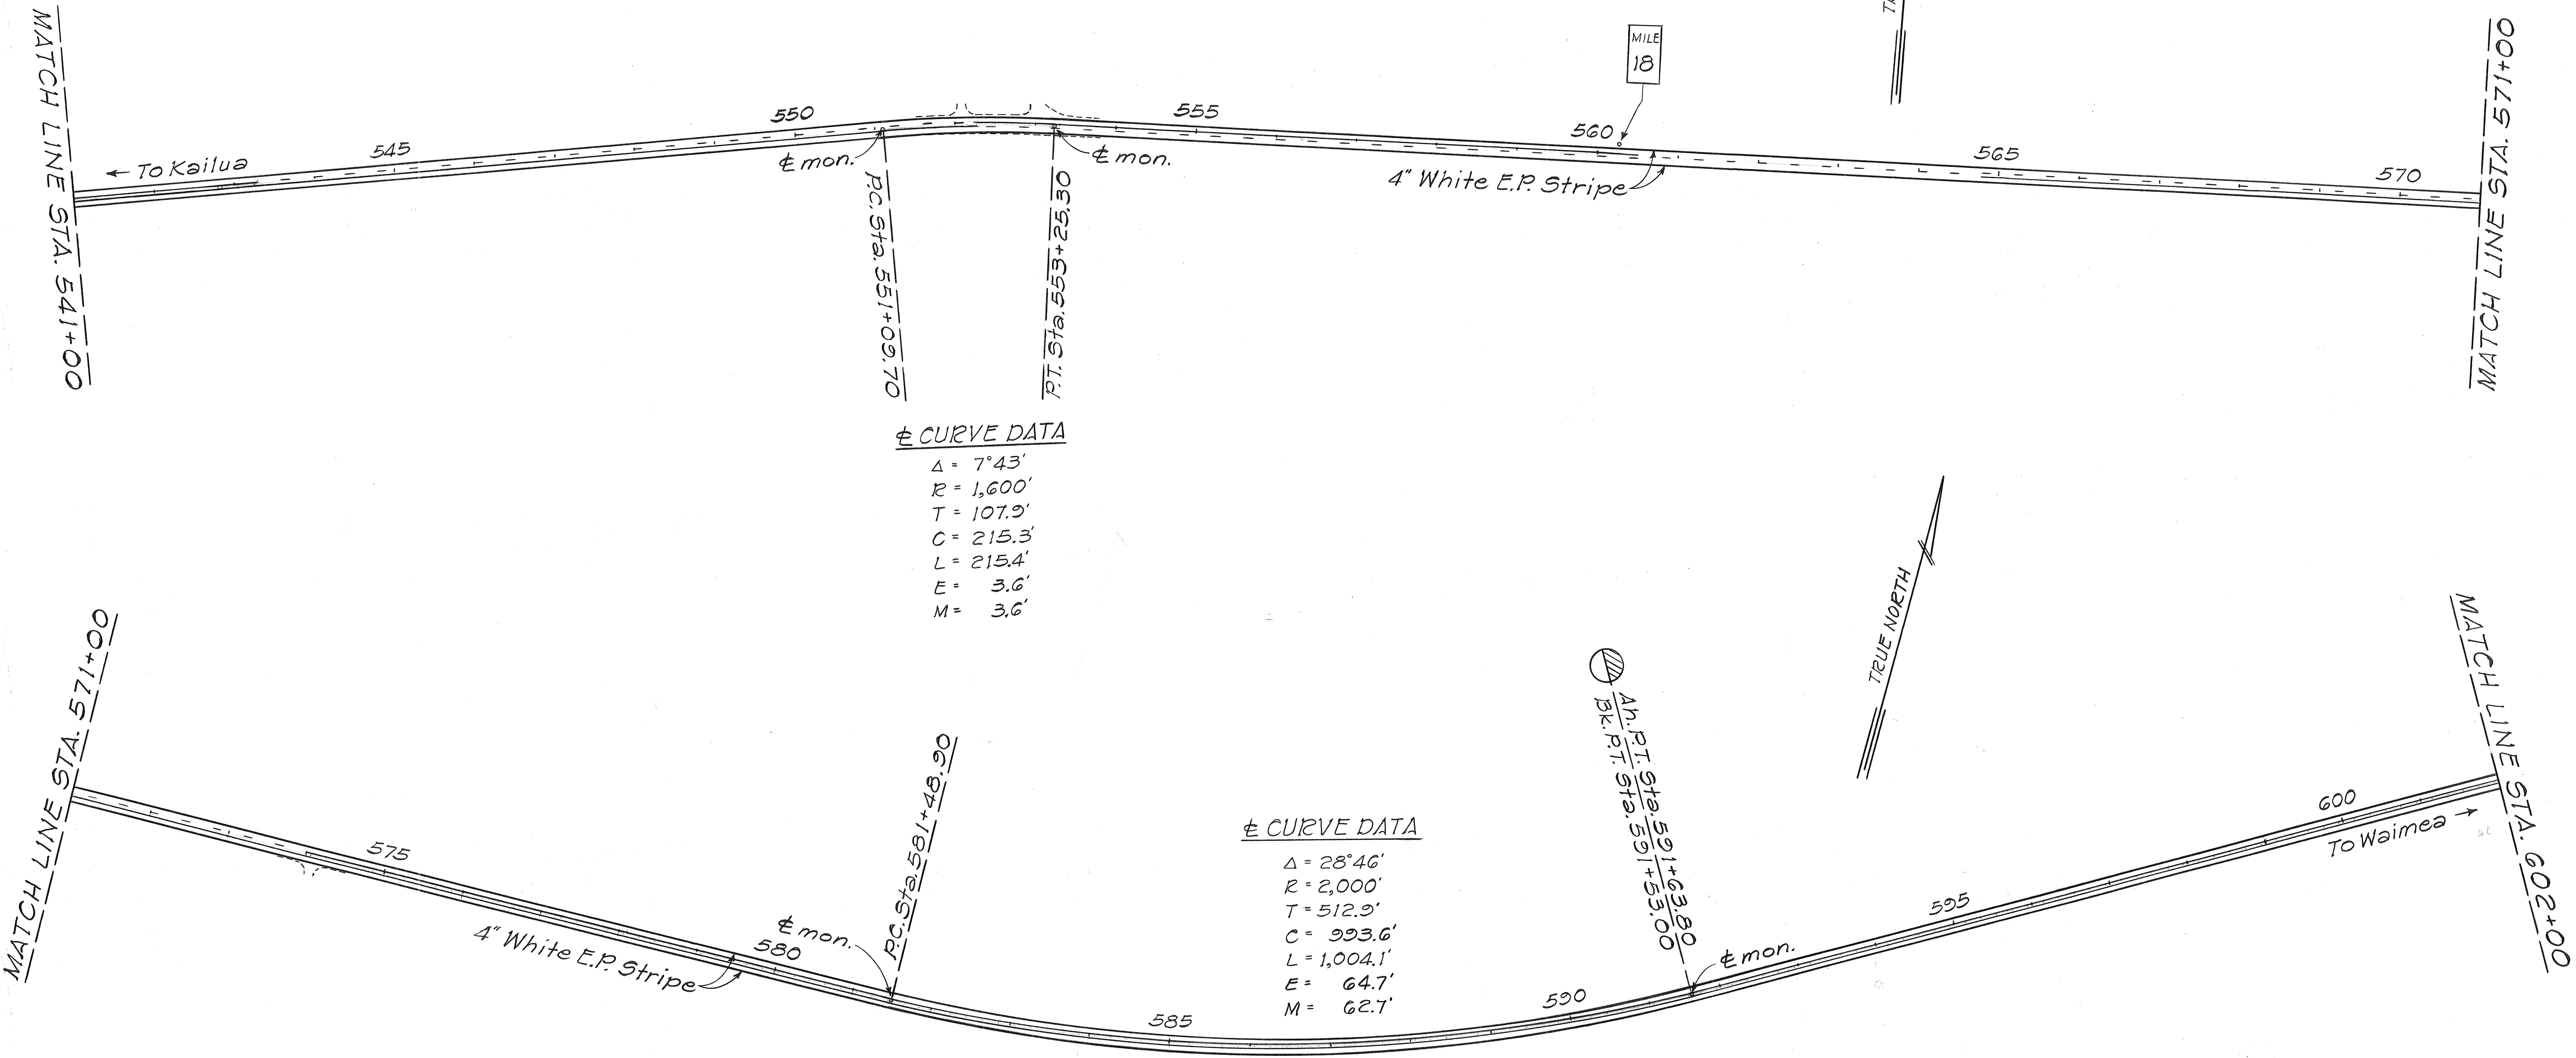

SURVEY PLOTTED BY	DATE
DRAWN BY	
DESIGNED BY	
QUANTITIES BY	
CHECKED BY	
NO.	

STATE OF HAWAII
DEPARTMENT OF TRANSPORTATION
HIGHWAYS DIVISION

ROADWAY STRIPING PLAN
HAWAII BELT ROAD RESURFACING
PUU ANAHULU
PROJ. No. 190C-01-89M

Scale: 1" = 100'
Date: Sept. 1988

SHEET NO. 2 OF 3 SHEETS

FED. ROAD DIST. NO.	STATE	PROJ. NO.	FISCAL YEAR	SHEET NO.	TOTAL SHEETS
HAWAII	HAW.	190C-01-89M	1989	6	7

DATE	____
SURVEY PLOTTED BY	____
DESIGNED BY	____
TRACED BY	____
NOTE BOOK	____
QUANTITIES BY	____
CHECKED BY	____
No.	____



STATE OF HAWAII
DEPARTMENT OF TRANSPORTATION
HIGHWAYS DIVISION

ROADWAY STRIPING PLAN
HAWAII BELT ROAD RESURFACING
PUU ANAHULU
PROJ. No. 190C-01-89M

Scale: 1" = 100' Date: Sept. 1988
SHEET No. 3 OF 3 SHEETS