
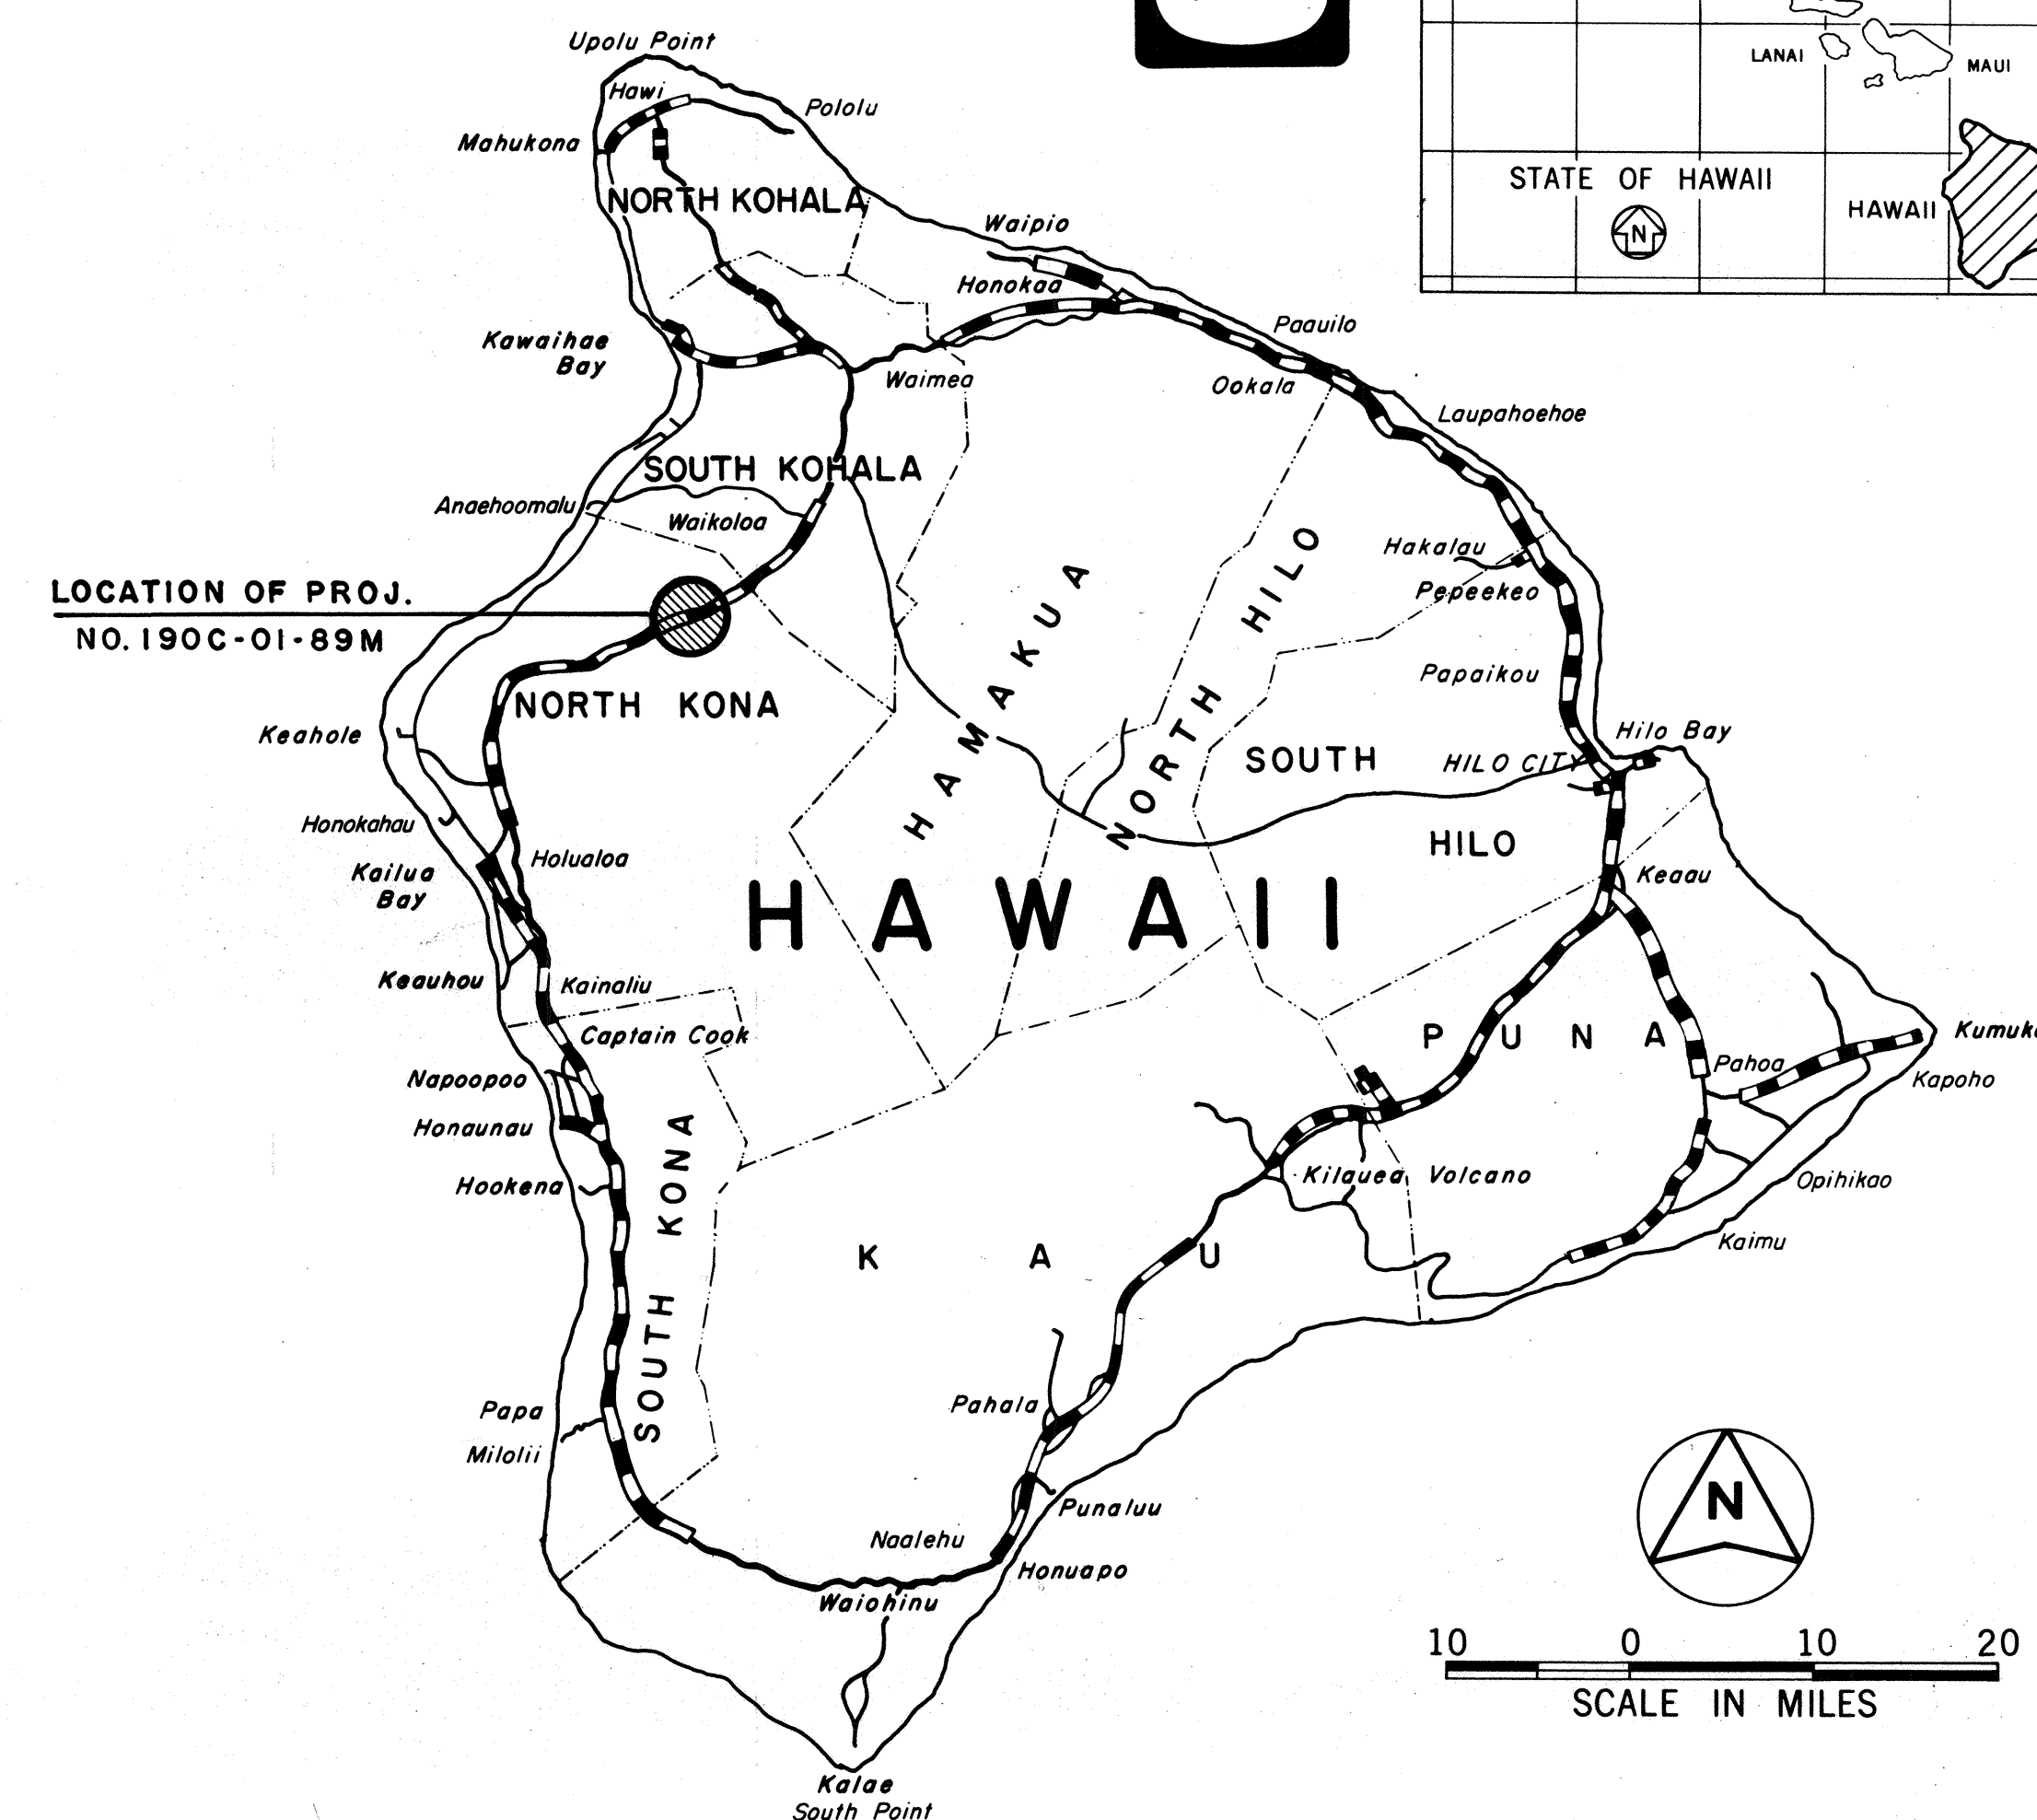
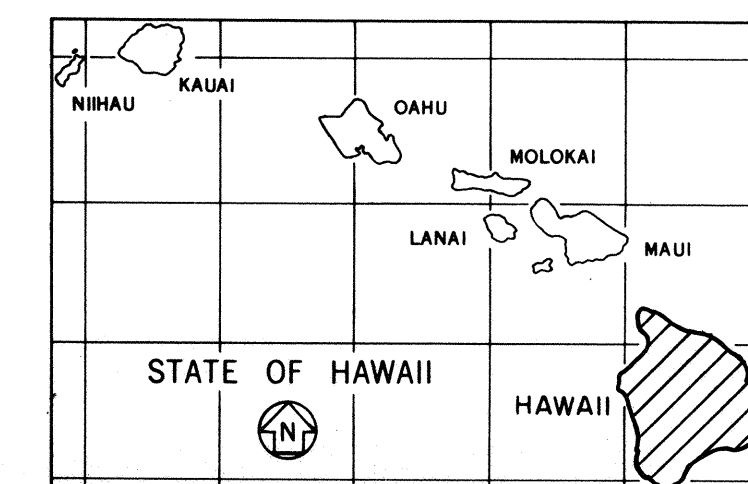


[illegible]

\*7S-1 IS A SUPPLEMENT SHEET  
TO THE CONTRACT PLANS.  
TOTAL = 8 SHEETS

STATE OF HAWAII  
DEPARTMENT OF TRANSPORTATION  
HIGHWAYS DIVISION  
HONOLULU, HAWAII  
"AS-BUILT"  
PLANS FOR  
HAWAII BELT ROAD RESURFACING  
PUU ANAHULU  
PROJECT NO. 190C-01-89M  
DISTRICT OF NORTH KONA  
ISLAND OF HAWAII

FED. ROAD DIST. NO.	STATE	PROJ. NO.	FISCAL YEAR	SHEET NO.	TOTAL SHEET
HAWAII	HAW.	190C-01-89M	1989	1	7

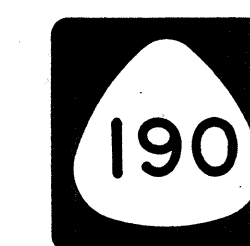

**—** FEDERAL AID PROJECTS PREVIOUSLY CONSTRUCTED  
OR UNDER CONSTRUCTION


CHANGES MADE DURING CONSTRUCTION HAVE BEEN INCORPORATED ON THESE PLANS EXCEPT CHANGES IN THE ORIGINAL THEORETICAL QUANTITIES. FOR ACTUAL QUANTITIES, REFER TO PROJECT LEDGER AND/OR COMPUTATION BOOK.

Robert G. W. Lefkowitz  
RESIDENT ENGINEER

5/22/89  
DATE

DEPARTMENT OF TRANSPORTATION  
STATE OF HAWAII

APPROVED: Edmund J. Brady 11/30/88  
DIR. OF TRANSPORTATION DATE

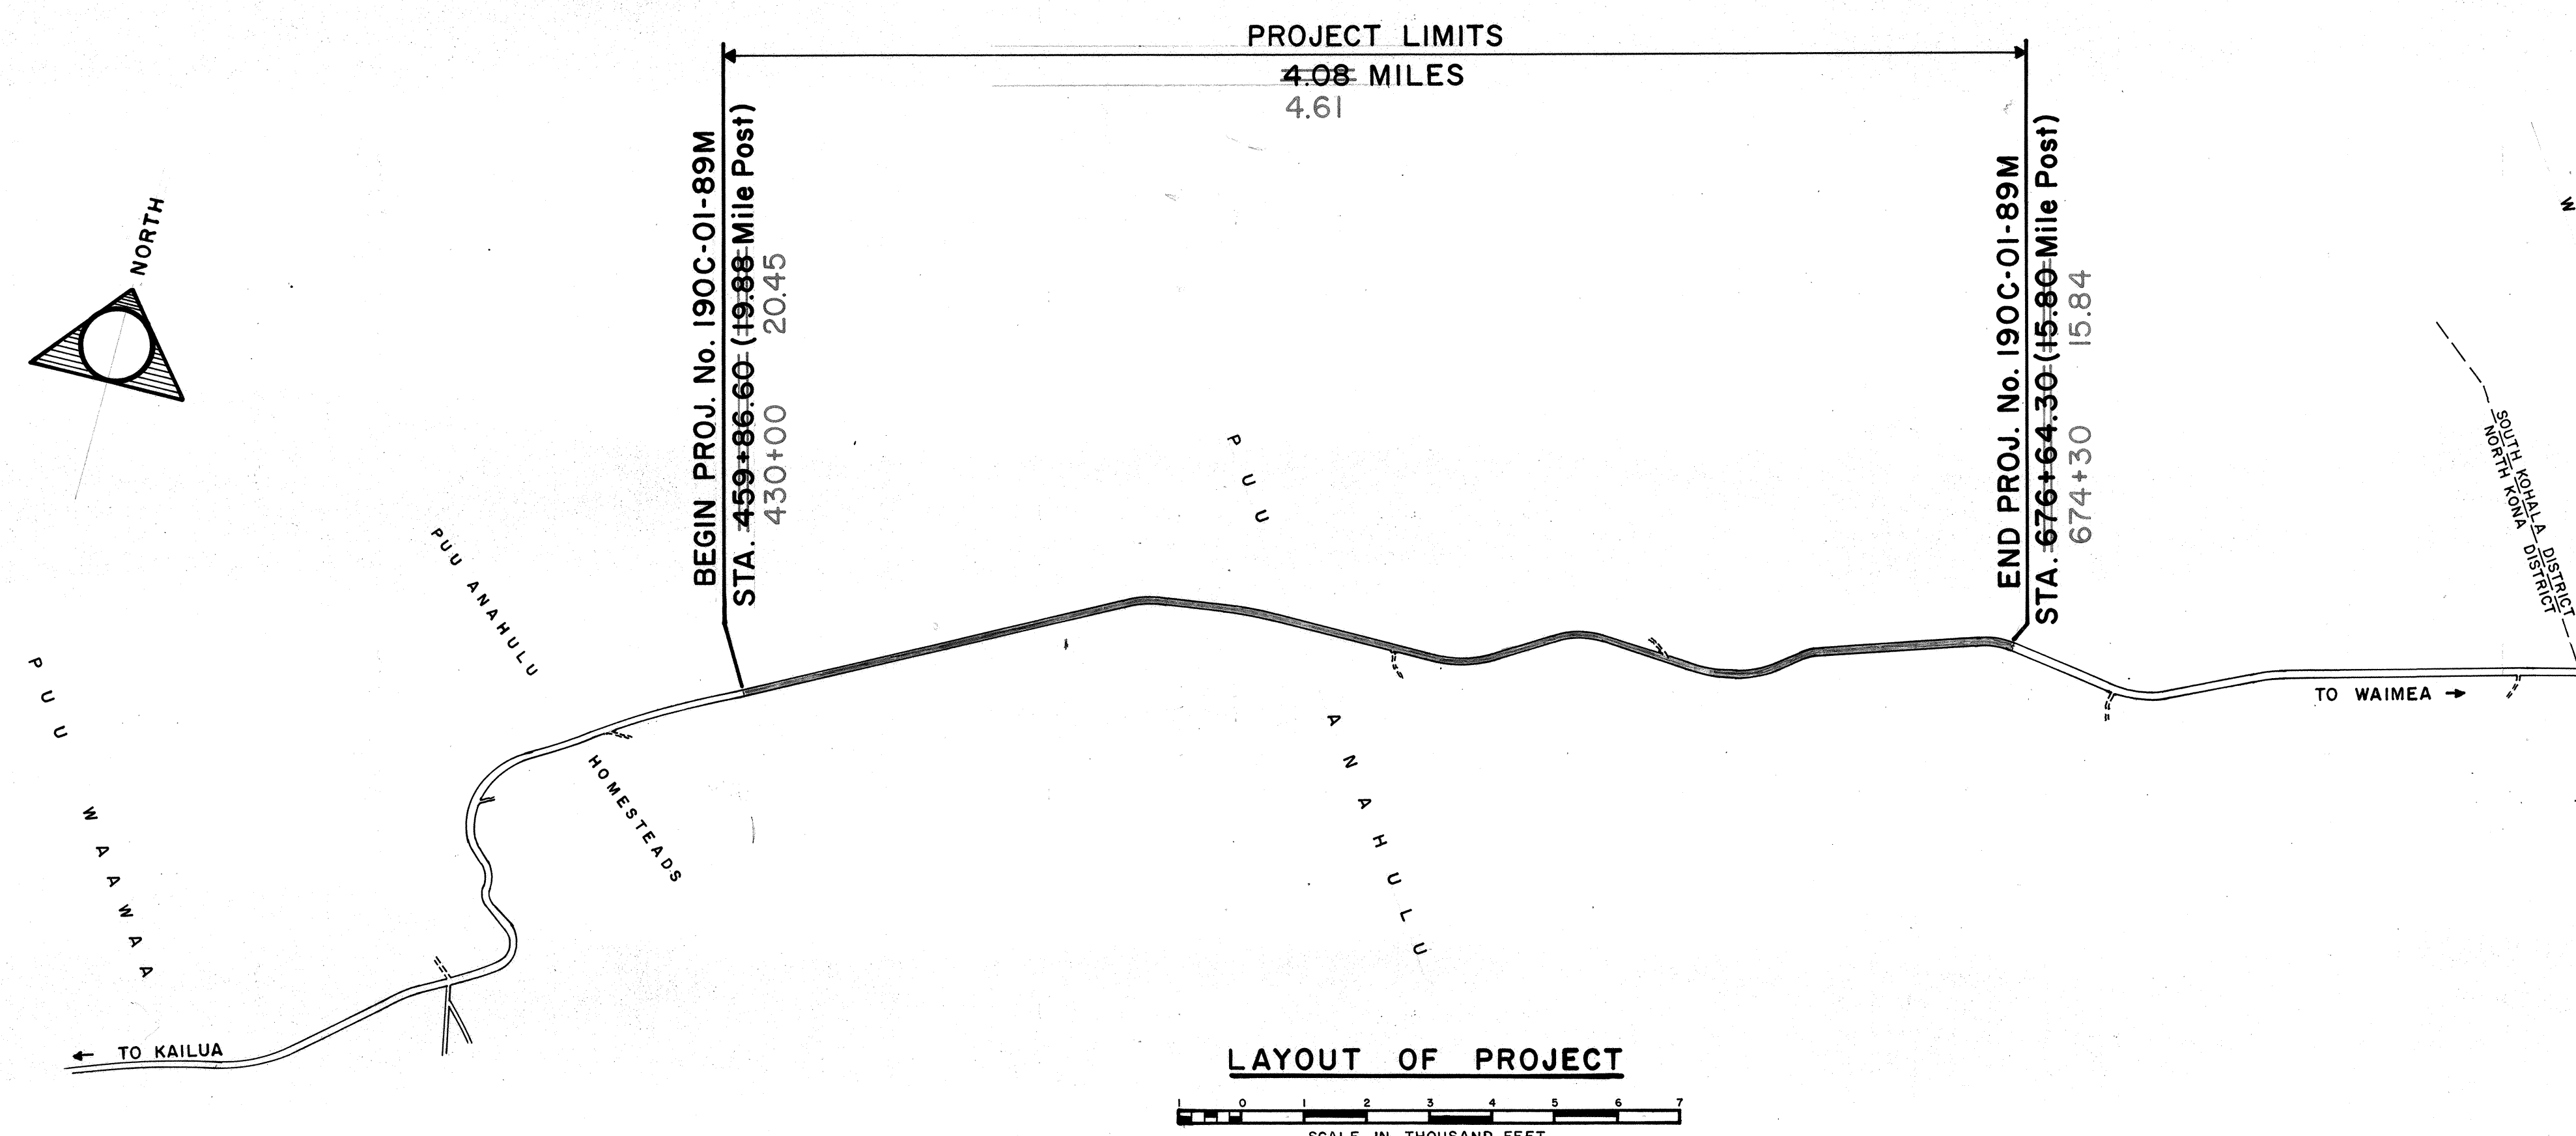

**HAWAII DISTRICT**  
DESIGNED BY **ALVIN TAKESHITA**  
P. S. & E. BY **548-7537**  
PHONE **OCT, 1988**  
DATE

**HAWAII DISTRICT**  
DESIGNED BY **ALVIN TAKESHITA**  
P. S. & E. BY **548-7537**  
PHONE **OCT, 1988**  
DATE