


FED. ROAD DIST. NO.	STATE	FED. AID PROJ. NO.	FISCAL YEAR	SHEET NO.	TOTAL SHEETS
HAWAII	HAW.	HES-0190(9)	1990	11	24

PAVEMENT MARKER SCHEDULE						
STATION		DESCRIPTION	TYPE			
FROM	TO		A	DL	HL	J
405+62	50+12					
		<del>Rumble Strip</del>	<del>64</del>			
<sup>62</sup> 405+ <del>80</del>	406+63.94 Bk. 8+81.13 Ah.	No Passing - Both Sides		5		
406+63.94 Bk. 8+81.13 Ah.	<sup>70</sup> 46+ <del>50</del>	No Passing - Both Sides		<del>195</del> <del>189</del>		
<sup>70</sup> 46+ <del>50</del>	<sup>50+13</sup> <del>49+50</del>	No Passing - L    Passing - R		11 <del>9</del>	9 <del>7</del>	36 <del>28</del>
TOTALS			0 <del>64</del>	<del>211</del> <del>203</del>	9 <del>7</del>	36 <del>28</del>
						216

NOTES

- Layout of pavement markers shall be done by the Contractor and approved by the Engineer prior to installation.
- ~~Pavement areas to be striped shall be broomed off by the Contractor prior to striping by the State. DELETE~~
- Existing pavement markers and striping not incorporated in the final traffic pattern shall be removed as directed by the Engineer. Costs shall be incidental to the various pavement marking items.
- Removal of existing striping shall be by mechanical means, such as sandblasting or grinding of pavement surface, or other method as approved by the Engineer. Burning off or painting over existing pavement striping shall not be allowed as methods for removing striping.
- Details of Type C, Type D, and Type H markers on Standard Plan Nos. TE-30, TE-31, and TE-32 shall be deleted and replaced with details of Type CL, Type DL and Type HL markers as shown on this sheet. All references to Type C, Type D and Type H markers in the plans shall mean Type CL, Type DL and Type HL markers.
- All pavement striping shall be as noted on the schedules or plans.
- Refer to Sheet Nos. 12 to 14 for detour pavement details and schedule.
- Reflector markers located behind guardrails shall be installed with steel posts. At all other locations, reflector markers with flexible delineator posts shall be installed.
- Final locations of all signs and reflector markers shall be approved by the Engineer prior to any installation work.

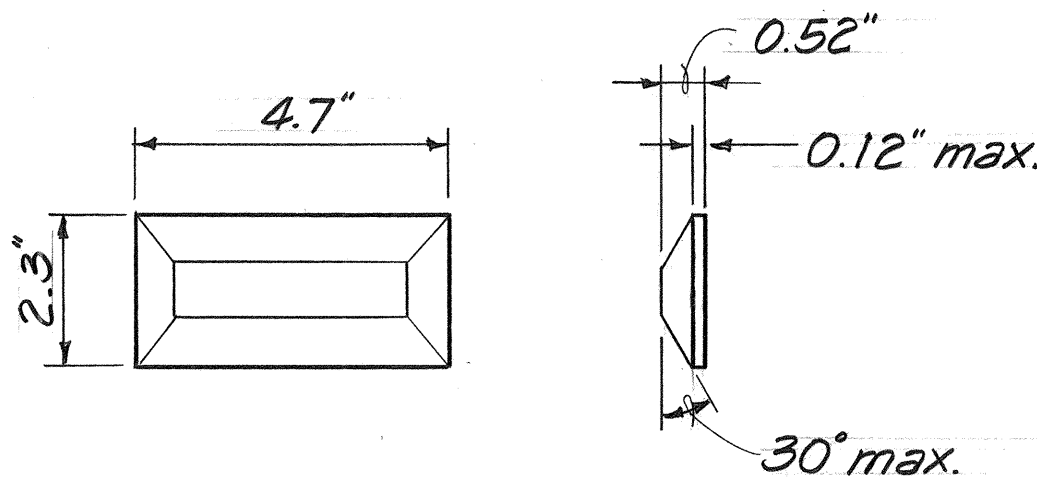

"L" SERIES  
PAVEMENT MARKER DETAIL  
Not to Scale

Type "CL": Red-Clear Reflective Marker.  
Type "DL": Two-Way Yellow Reflective Marker.  
Type "HL": One-Way Yellow Reflective Marker.

